
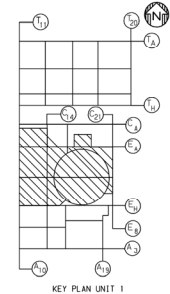


SECTION LOOKING NORTH

- LEGEND:**
- ELECTRIC HOIST
  - HAND HOIST WITH CEILING RING
  - ▲ HAND HOIST WITH FLOOR MOUNTED TRIPOD
  - MOBILE TRUCK CRANE
  - ▨ MONORAIL AND LOAD PATH AREA
  - ⊕ JIB CRANE AND LOAD PATH AREA

**SOUTHERN COMPANY SERVICES, INC.**  
 BIRMINGHAM, ALABAMA  
**GEORGIA POWER COMPANY**  
 ALVIN W. VOGTLE NUCLEAR PLANT  
 HEAVY LOAD HANDLING  
 CONTAINMENT INTERNAL  
 SECTION LOOKING NORTH

THIS DOCUMENT CONTAINS PROPRIETARY, CONFIDENTIAL, AND/OR TRADE SECRET INFORMATION OF THE SUBSIDIARIES OF THE SOUTHERN COMPANY OR OF THIRD PARTIES. IT IS INTENDED FOR USE ONLY BY EMPLOYEES OF, OR AUTHORIZED CONTRACTORS OF, THE SUBSIDIARIES OF THE SOUTHERN COMPANY. UNAUTHORIZED POSSESSION, USE, DISTRIBUTION, COPYING, DISSEMINATION, OR DISCLOSURE OF ANY PORTION HEREOF IS PROHIBITED.		3/28/81 LVL RHW CBH WFP DATE DR CHK APPV DTL		SCALE: NONE	DRAWING NO. 1X4DE508	REV. 0
ISSUED PER REQ 96-VAA054	REVISIONS			JOB NO. 10604	SIZE E 34X44	

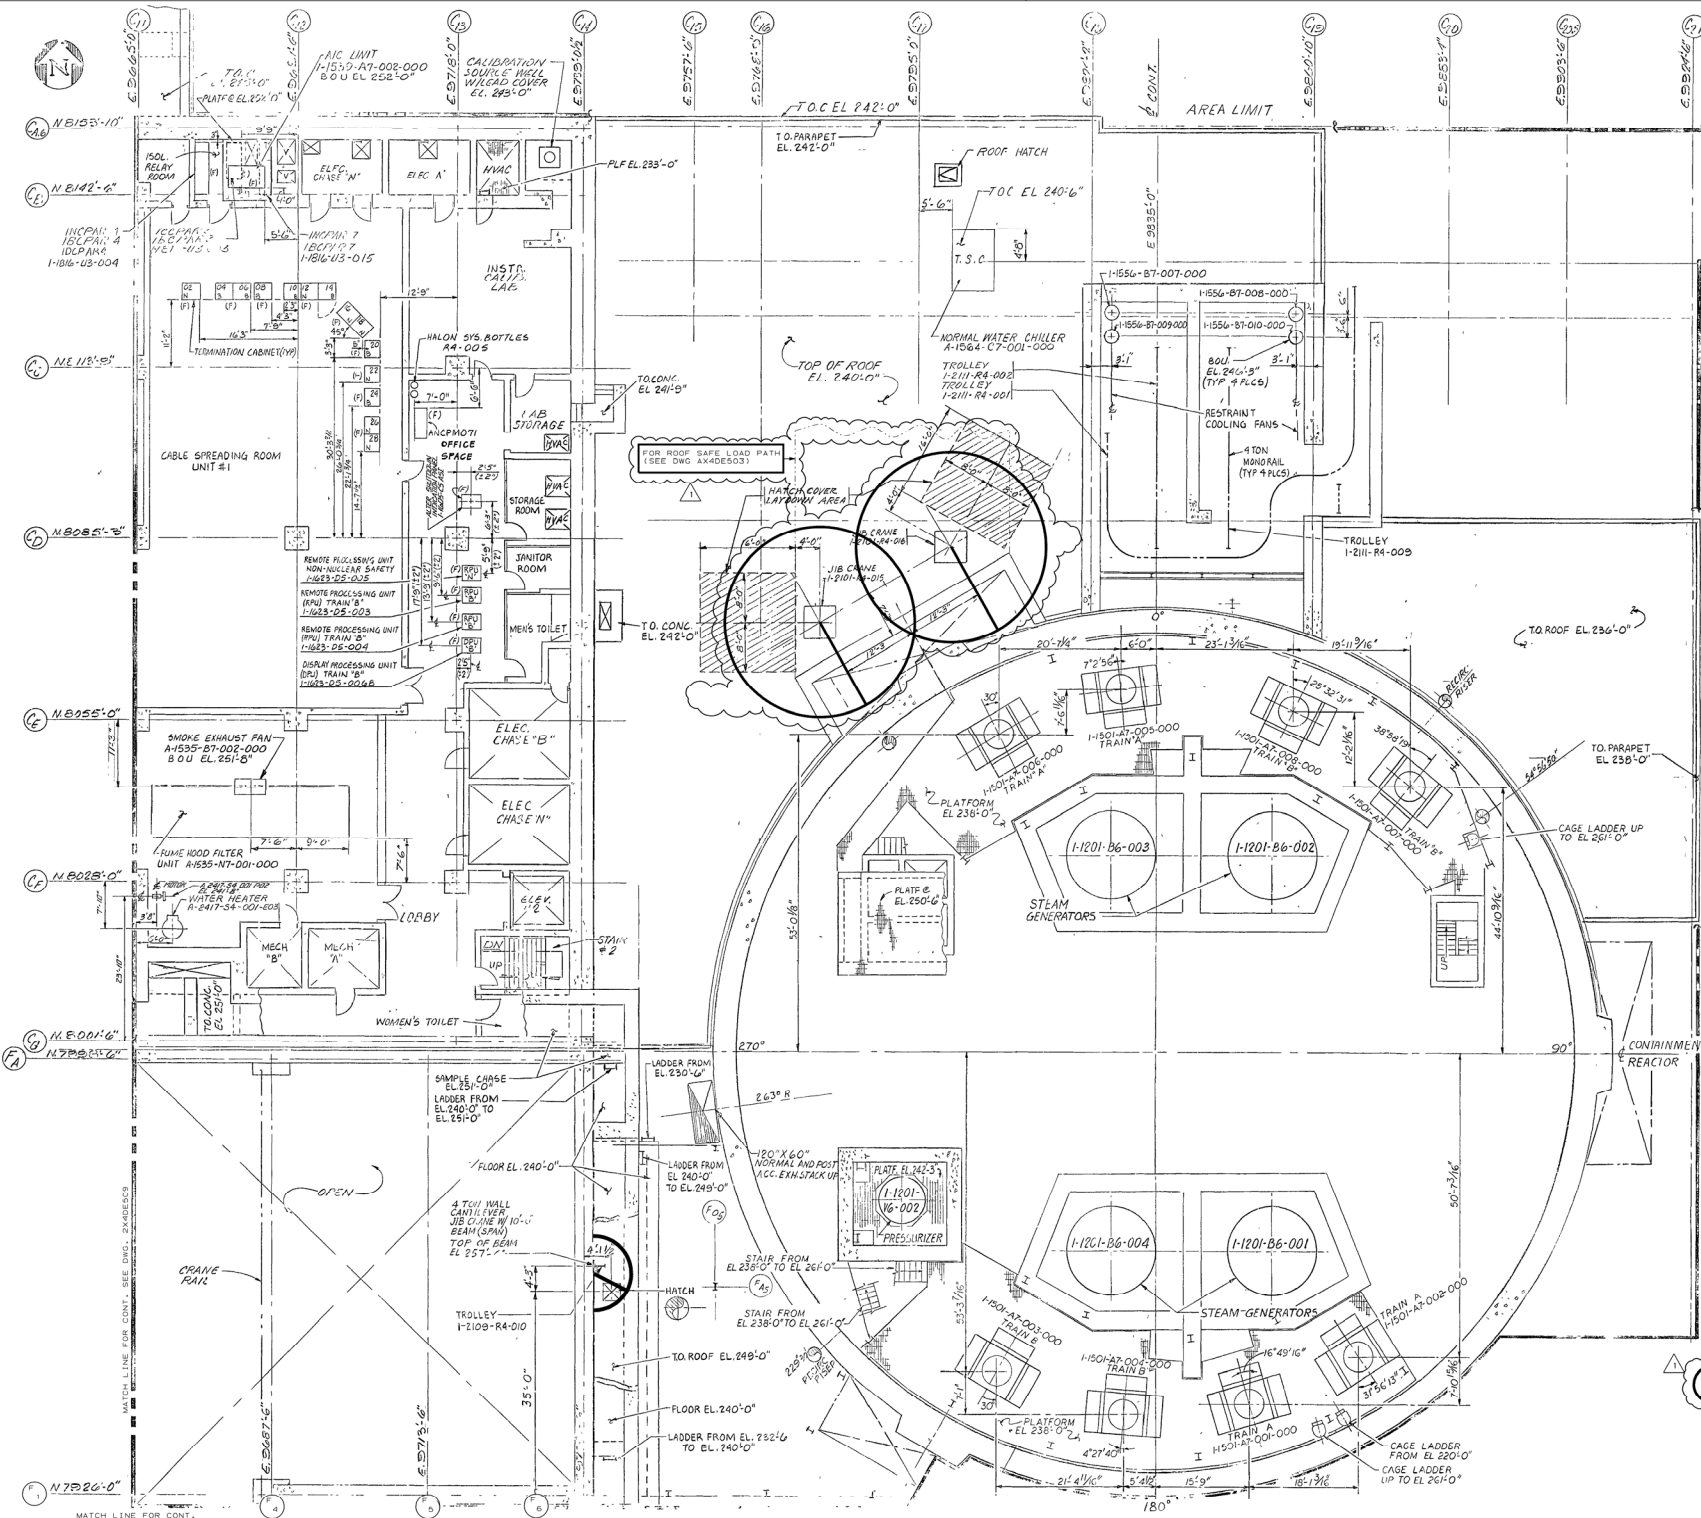

- LEGEND:**
- ELEC TRUCK
  - HAND HOIST WITH CEILING RING
  - HAND HOIST WITH FLOOR MOUNTED TRIPOD
  - MOBILE TRUCK CRANE
  - ▬ MONORAIL AND LOAD PATH AREA
  - JIB CRANE AND LOAD PATH AREA



**SOUTHERN COMPANY SERVICES, INC.**  
 BIRMINGHAM, ALABAMA

**GEORGIA POWER COMPANY**  
 ALVIN W. VOGLE NUCLEAR PLANT

HEAVY LOAD HANDLING  
 CONTAINMENT  
 CONTROL AND FUEL HANDLING BUILDING.  
 LEVEL 2 EL. 240'-0" (UNIT 1)

THIS DOCUMENT CONTAINS PROPRIETARY, CONFIDENTIAL, AND/OR TRADE SECRET INFORMATION OF THE SUBSIDIARIES OF THE SOUTHERN COMPANY OR OF THIRD PARTIES. IT IS INTENDED FOR USE ONLY BY EMPLOYEES OF, OR AUTHORIZED CONTRACTORS OF, THE SUBSIDIARIES OF THE SOUTHERN COMPANY. UNAUTHORIZED POSSESSION, USE, DISTRIBUTION, COPYING, DISSEMINATION, OR DISCLOSURE OF ANY PORTION HEREOF IS PROHIBITED.		INCORP. PER REA 99-VA0616 ISSUED PER REA 96VA005R REVISIONS		6-16-99 LVL PH JHD 7-28-99 LVL RHM CSH WFP DATE DR CHK APPV		SCALE: NONE JOB NO. 10604 SIZE E 34x44	DRAWING NO. 1X4DE509	REV. 1
--	--	---	--	---	--	--	-------------------------	-----------



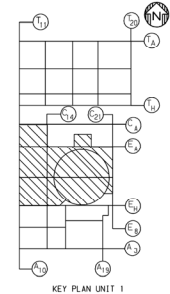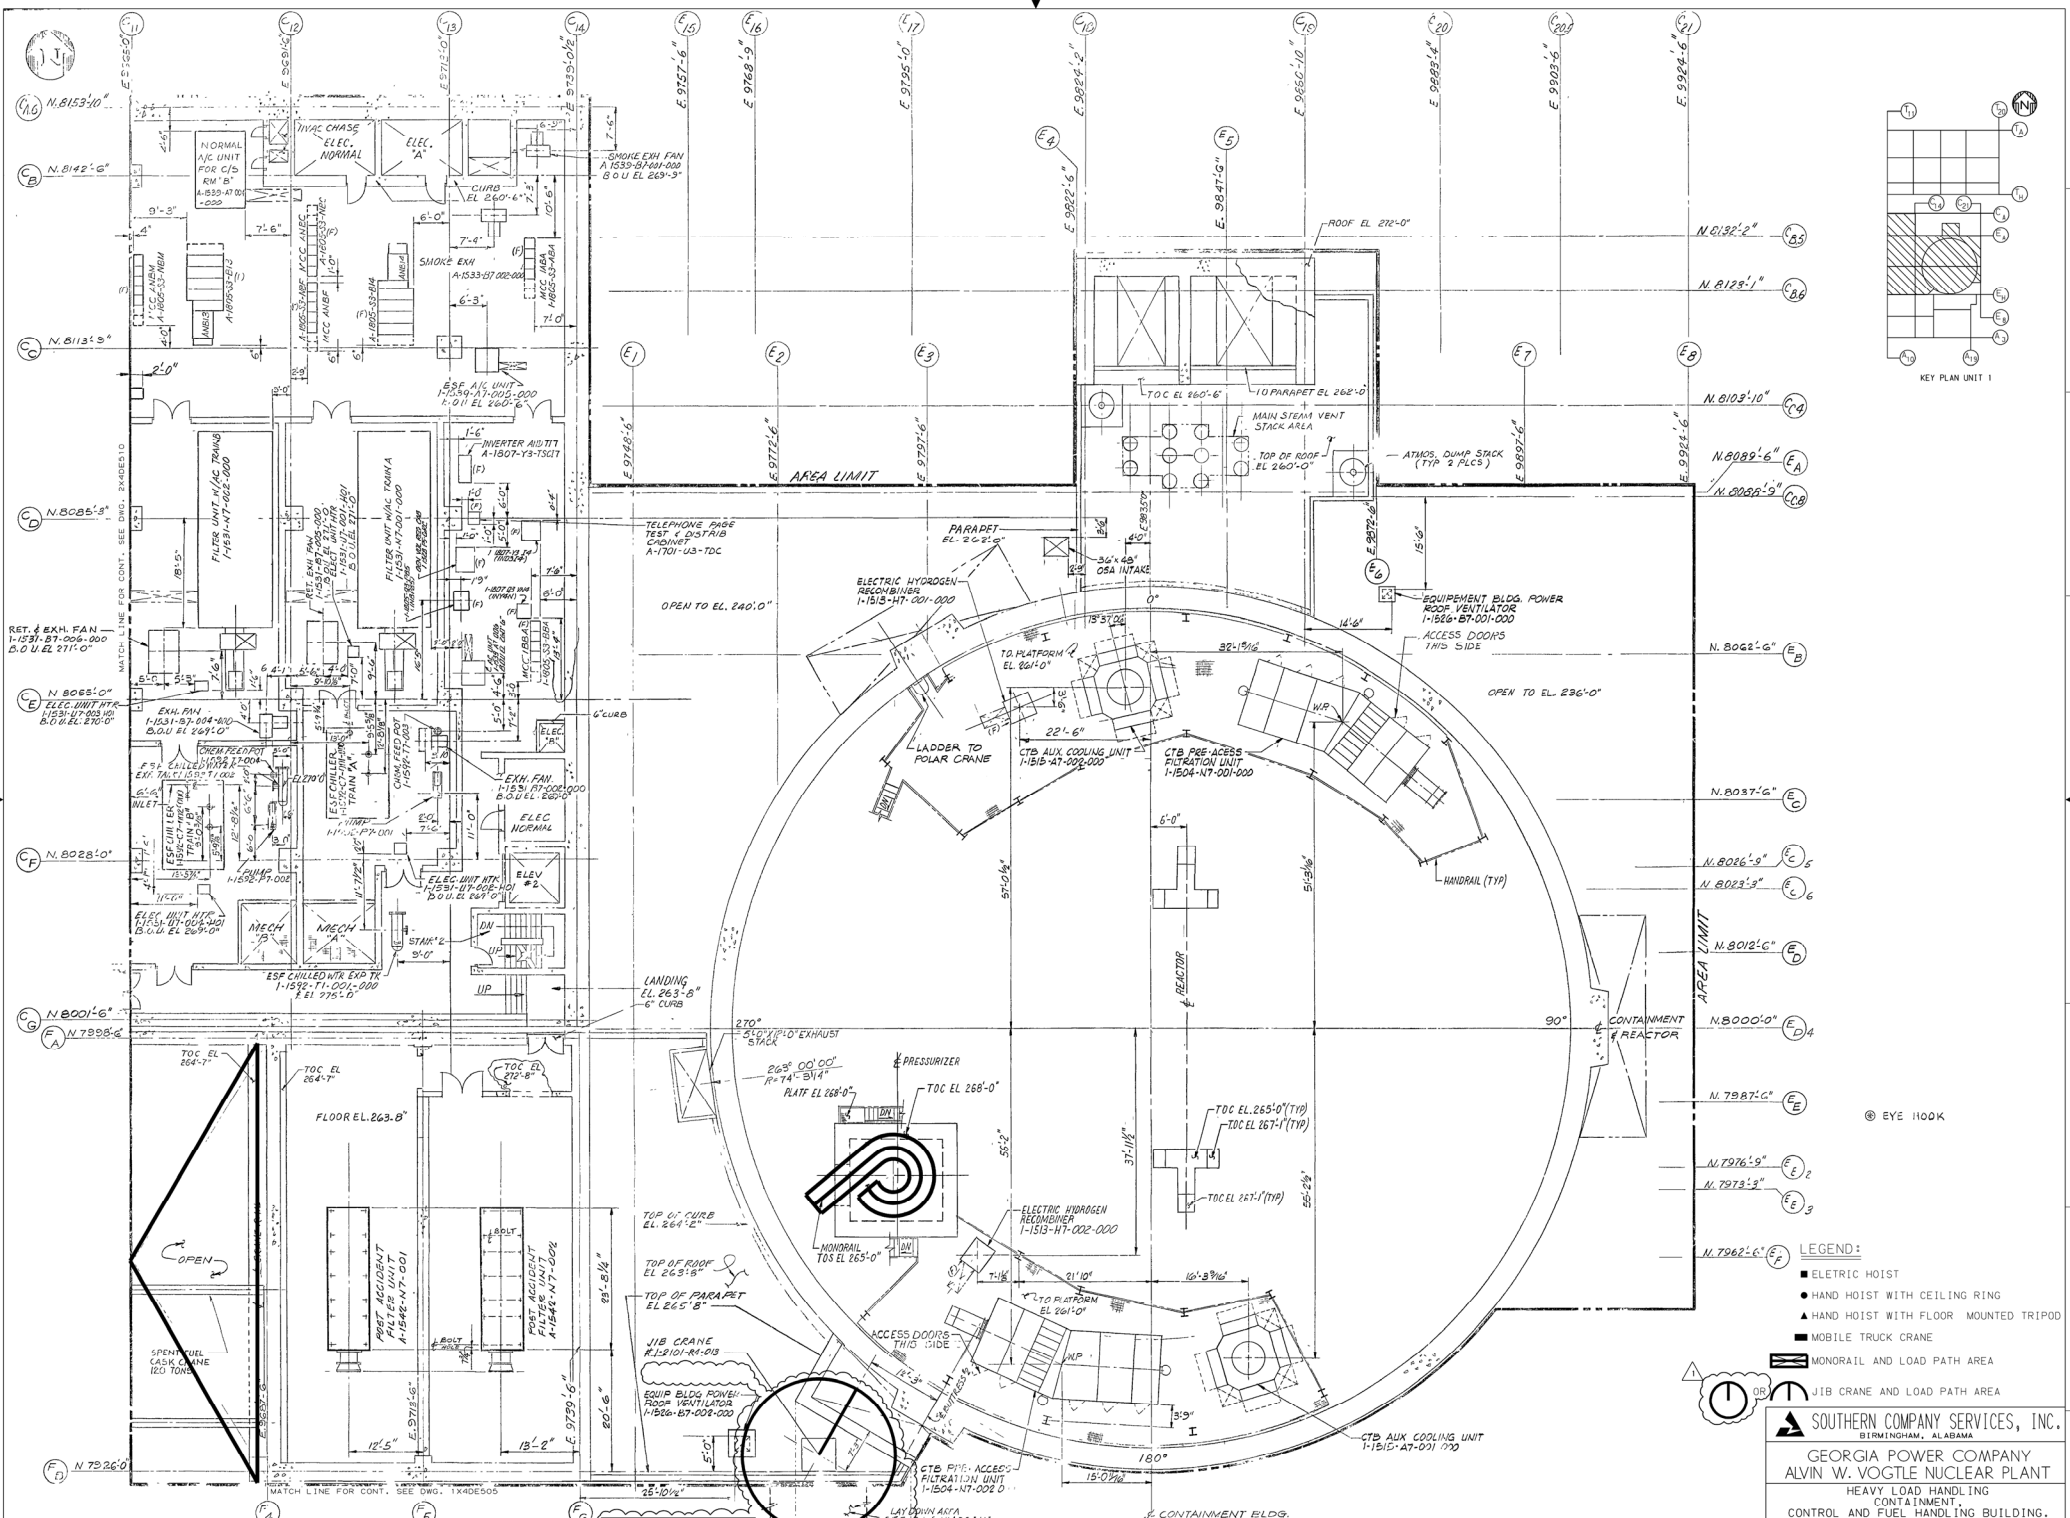

KEY PLAN UNIT 1

⊙ EYE HOOK

- LEGEND:**
- ELECTRIC HOIST
  - HAND HOIST WITH CEILING RING
  - ▲ HAND HOIST WITH FLOOR MOUNTED TRIPOD
  - MOBILE TRUCK CRANE
  - ▭ MONORAIL AND LOAD PATH AREA
  - ▭ JIB CRANE AND LOAD PATH AREA

**SOUTHERN COMPANY SERVICES, INC.**  
 BIRMINGHAM, ALABAMA


**GEORGIA POWER COMPANY**  
 ALVIN W. VOGTLE NUCLEAR PLANT

HEAVY LOAD HANDLING  
 CONTAINMENT  
 CONTROL AND FUEL HANDLING BUILDING.  
 LEVEL 3 EL. 260'-0" (UNIT 1)


SCALE:	NONE	DRAWING NO.	REV.
		1X4DE510	1

THIS DOCUMENT CONTAINS PROPRIETARY, CONFIDENTIAL, AND/OR TRADE SECRET INFORMATION OF THE SUBSIDIARIES OF THE SOUTHERN COMPANY OR OF THIRD PARTIES. IT IS INTENDED FOR USE ONLY BY EMPLOYEES OF, OR AUTHORIZED CONTRACTORS OF, THE SUBSIDIARIES OF THE SOUTHERN COMPANY. UNAUTHORIZED POSSESSION, USE, DISTRIBUTION, COPYING, DISSEMINATION, OR DISCLOSURE OF ANY PORTION HEREOF IS PROHIBITED.




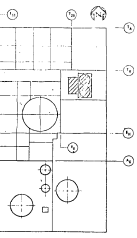


KEY PLAN UNIT 1

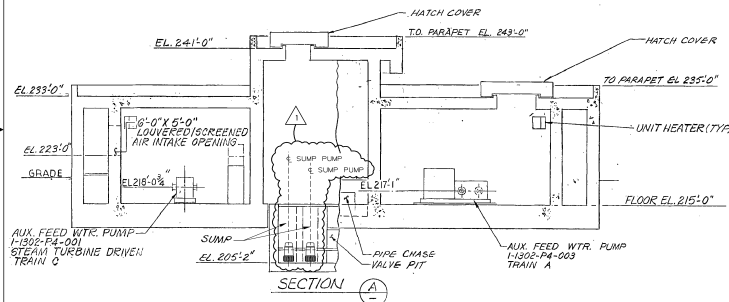

SECTION A-A

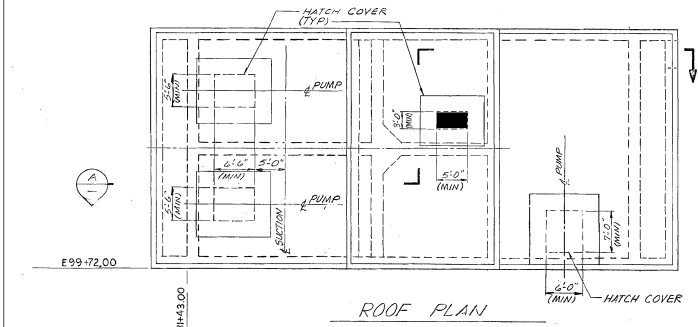

ROOF PLAN

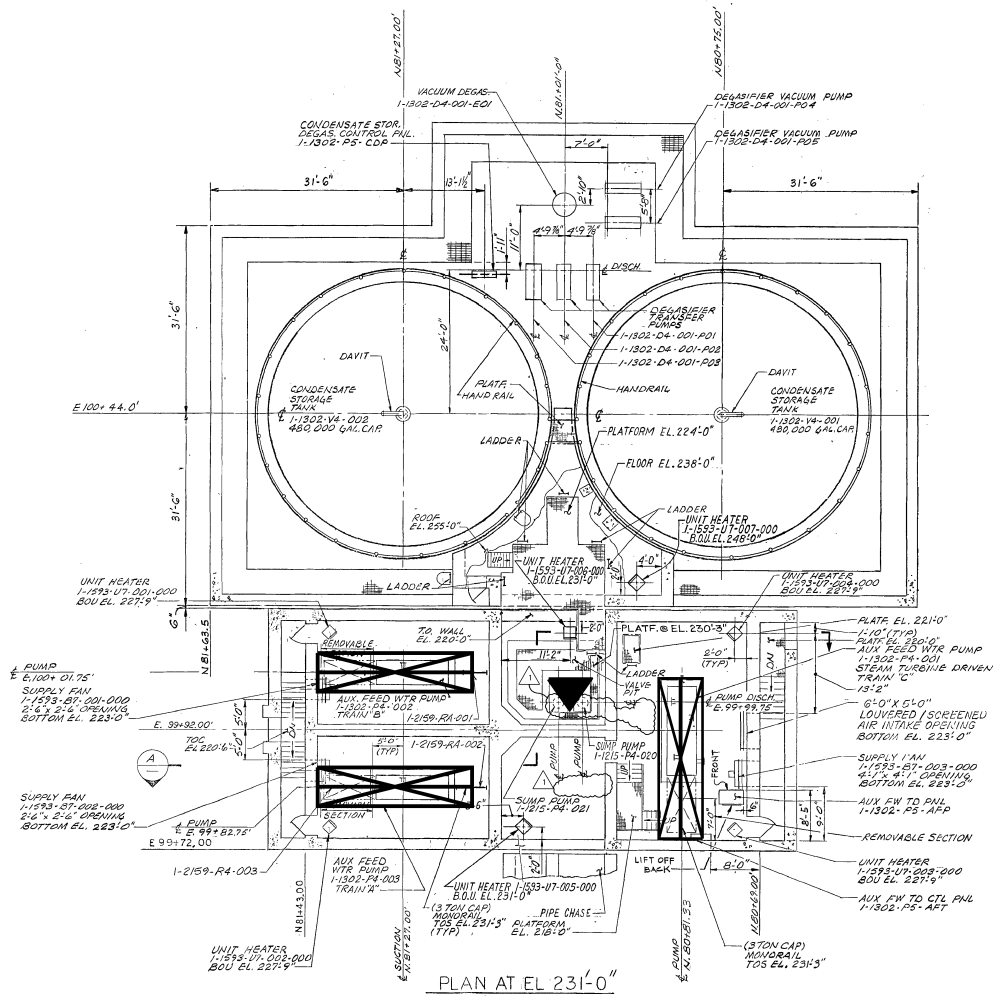

PLAN AT EL. 231'-0"


- LEGEND:**
- ELECTRIC HOIST
  - HAND HOIST WITH CEILING RING
  - ▲ HAND HOIST WITH FLOOR MOUNTED TRIPOD
  - MOBILE TRUCK CRANE
  - ▬ MONORAIL AND LOAD PATH AREA
  - JIB CRANE AND LOAD PATH AREA

THIS DOCUMENT CONTAINS PROPRIETARY, CONFIDENTIAL, AND/OR TRADE SECRET INFORMATION OF THE SUBSIDIARIES OF THE SOUTHERN COMPANY OR OF THIRD PARTIES. IT IS INTENDED FOR USE ONLY BY EMPLOYEES OF, OR AUTHORIZED CONTRACTORS OF, THE SUBSIDIARIES OF THE SOUTHERN COMPANY. UNAUTHORIZED POSSESSION, USE, DISTRIBUTION, COPYING, DISSEMINATION, OR DISCLOSURE OF ANY PORTION HEREOF IS PROHIBITED.				INCORPORATED PER DCP 97-VAN0063 ISSUED FOR CONSTRUCTION REVISIONS				01/10/03 ELC GLB MWD SEE WORKFLOW FOR SIGNATURES DATE: 08/14/03 CHK: APPV: DTL				SCALE: NONE	DRAWING NO. 1X4DE512	REV. 1
--	--	--	--	---	--	--	--	--	--	--	--	-------------	----------------------	--------



**SOUTHERN COMPANY SERVICES, INC.**  
 BIRMINGHAM, ALABAMA

**GEORGIA POWER COMPANY**  
 ALVIN W. VOGTLE NUCLEAR PLANT

HEAVY LOAD HANDLING  
 AUX. FEEDWATER  
 PUMP HOUSE AND CONDENSATE STORAGE TANK

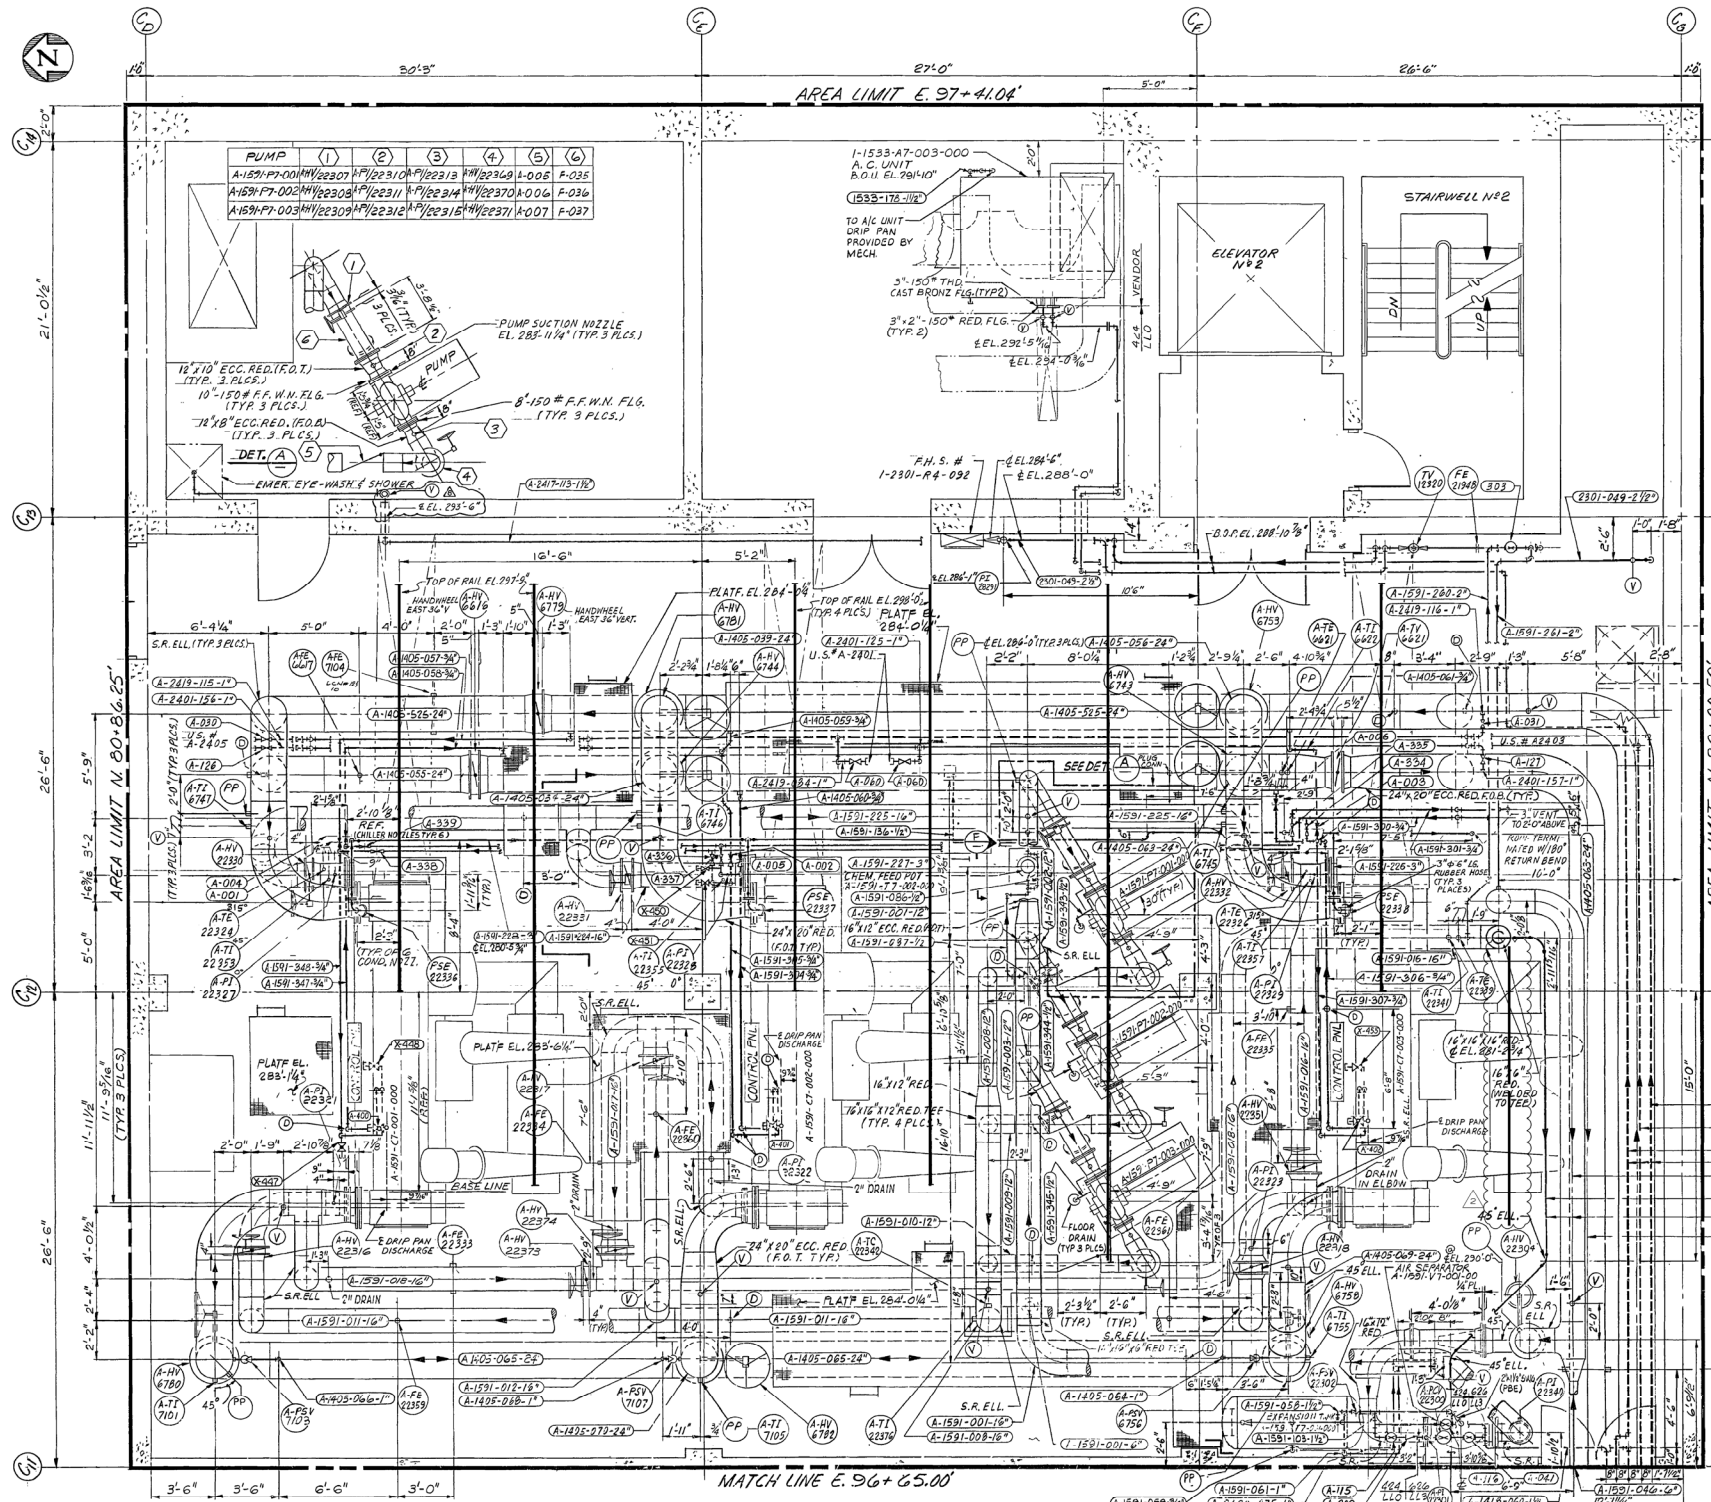

PUMP	1	2	3	4	5	6
A-1591-P7-001	M/22307	M/22310	M/22313	M/22369	L-005	F-035
A-1591-P7-002	M/22308	M/22311	M/22314	M/22370	A-006	F-036
A-1591-P7-003	M/22309	M/22312	M/22315	M/22371	K-007	F-037

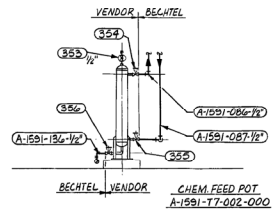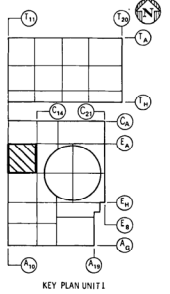


- LEGEND:**
- ELECTRIC HOIST
  - HAND HOIST WITH CEILING RING
  - ▲ HAND HOIST WITH FLOOR MOUNTED TRIPOD
  - MOBILE TRUCK CRANE
  - ▬ MONORAIL AND LOAD PATH AREA
  - JIB CRANE AND LOAD PATH AREA

- A-2415-030-17
- A-2401-081-116
- A-2417-113-172
- A-1591-040-160
- A-1591-024-6
- A-1591-293-4
- A-1591-290-10

**SOUTHERN COMPANY SERVICES, INC.**  
 GEORGIA POWER COMPANY  
 ALVIN W. VOGTE NUCLEAR PLANT  
 HEAVY LOAD HANDLING CONTROL BUILDING  
 PIPING AREA 2B LEVEL 4  
 EL. 280'-0" AND ABOVE

SCALE: NONE	DRAWING NO. 1X4DE513	REV. 2
JOB NO. 10604	DATE: 8/22/88	BY: RCR
8/22/88	CHK: APPV	DTL

THIS DOCUMENT CONTAINS PROPRIETARY, CONFIDENTIAL, AND/OR TRADE SECRET INFORMATION OF THE SUBSIDIARIES OF THE SOUTHERN COMPANY OR OF THIRD PARTIES. IT IS INTENDED FOR USE ONLY BY EMPLOYEES OF, OR AUTHORIZED CONTRACTORS OF, THE SUBSIDIARIES OF THE SOUTHERN COMPANY. UNAUTHORIZED POSSESSION, USE, DISTRIBUTION, COPYING, DISSEMINATION, OR DISCLOSURE OF ANY PORTION HEREOF IS PROHIBITED.

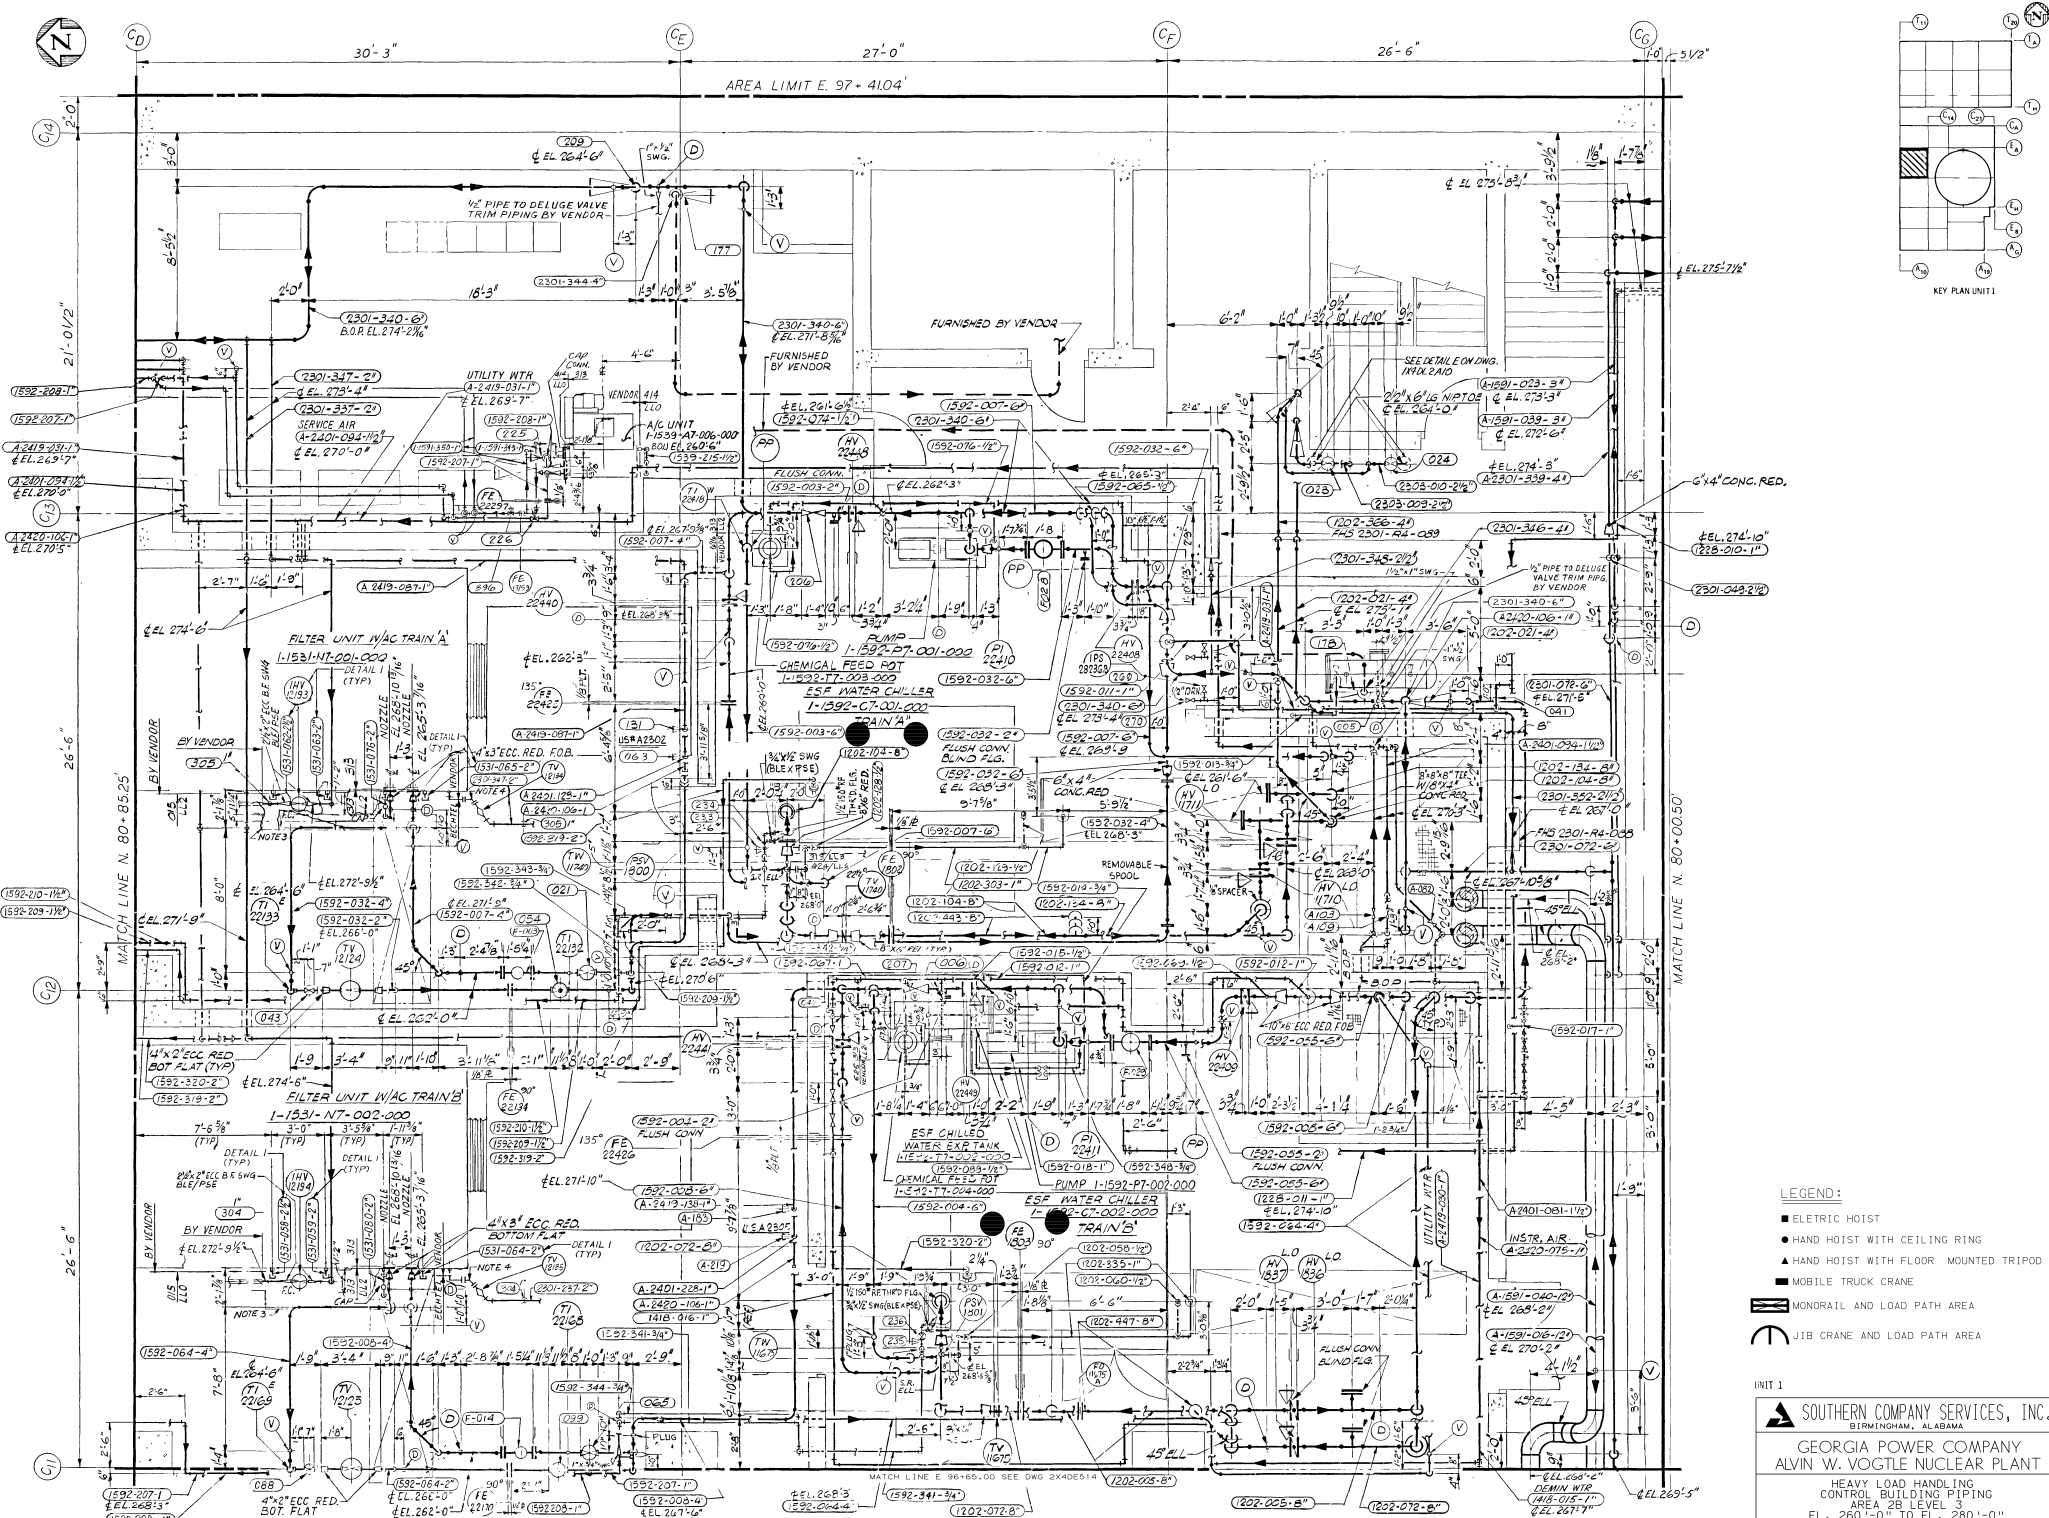

- LEGEND:**
- ELECTRIC HOIST
  - HAND HOIST WITH CEILING RING
  - ▲ HAND HOIST WITH FLOOR MOUNTED TRIPD
  - ▬ MOBILE TRUCK CRANE
  - ▬ MONORAIL AND LOAD PATH AREA
  - ⊖ JIB CRANE AND LOAD PATH AREA

UNIT 1




**SOUTHERN COMPANY SERVICES, INC.**  
 BIRMINGHAM, ALABAMA

**GEORGIA POWER COMPANY**  
**ALVIN W. VOGTLE NUCLEAR PLANT**

HEAVY LOAD HANDLING  
 CONTROL BUILDING PIPING  
 AREA 2B LEVEL 3  
 EL. 260'-0" TO EL. 280'-0"

SCALE:	NONE	DRAWING NO.:	REV.:
ISSUED PER REG 96-YA054	7/8-11 ELC RDM CBH WFP	1X4DE514	0
NO. 1	DATE: DR CHK APPV DTL	JOB NO. 10604	SIZE E 34X44
NO. 2	NO. 3	NO. 4	NO. 5

THIS DOCUMENT CONTAINS PROPRIETARY, CONFIDENTIAL, AND/OR TRADE SECRET INFORMATION OF THE SUBSIDIARIES OF THE SOUTHERN COMPANY OR OF THIRD PARTIES. IT IS INTENDED FOR USE ONLY BY EMPLOYEES OF, OR AUTHORIZED CONTRACTORS OF, THE SUBSIDIARIES OF THE SOUTHERN COMPANY. UNAUTHORIZED POSSESSION, USE, DISTRIBUTION, COPYING, DISSEMINATION, OR DISCLOSURE OF ANY PORTION HEREOF IS PROHIBITED.

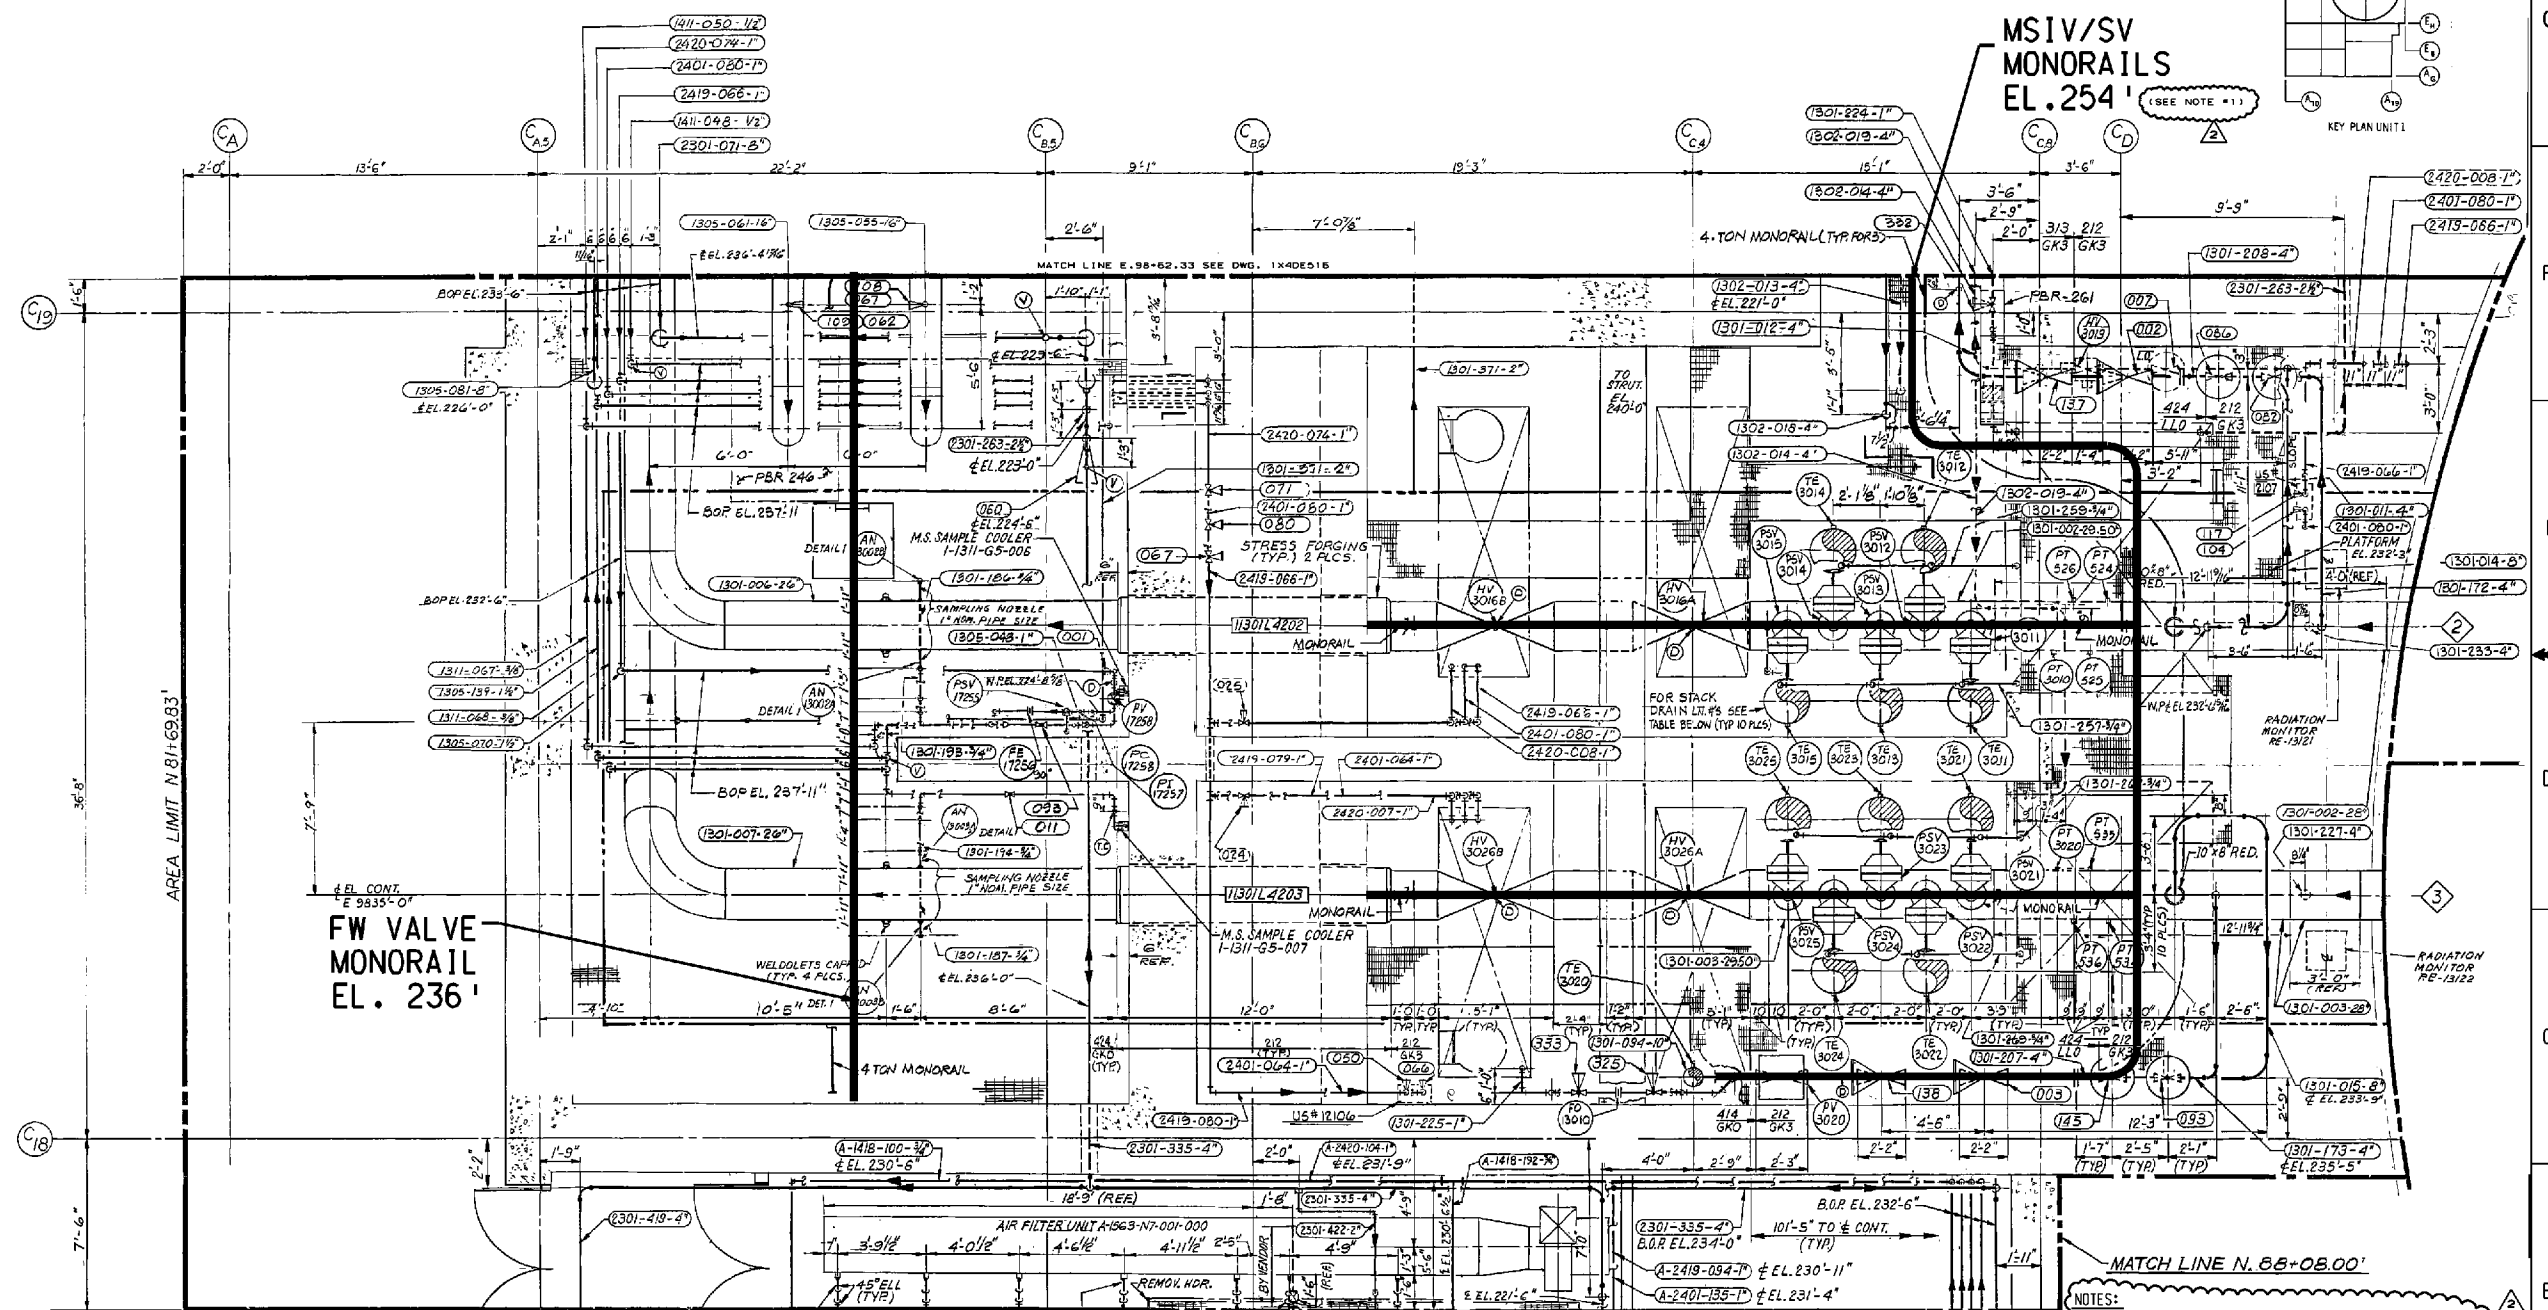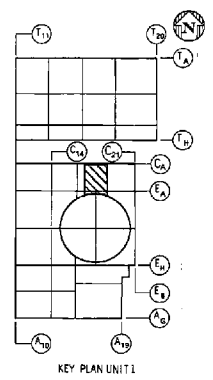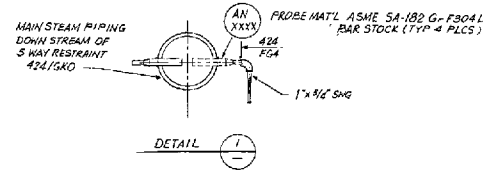

AREA LIMIT N 81+69.03'

NOTES:  
 1. THE MSIV/SV MONORAIL WITH TROLLEY 1-1211-R4-001 MAY BE USED FOR LIFTING THE ACTUATOR OF ATMOSPHERIC RELIEF VALVE 1P1-3020 OVER THE MAIN STEAM LINES UPSTREAM OF MSIV. DURING PLANT OPERATION WITHOUT DOUBLE RIGGING, THE HOIST, THE SLING CONFIGURATION, AND THE CROSBY SHACKLE USED IN THE ACTUATOR LIFT SHALL HAVE A MINIMUM WORKING LOAD LIMIT OF TWO TONS.

- LEGEND:
- ELECTRIC HOIST
  - HAND HOIST WITH CEILING RING
  - ▲ HAND HOIST WITH FLOOR MOUNTED TRIPOD
  - MOBILE TRUCK CRANE
  - ▬ MONORAIL AND LOAD PATH AREA
  - ▬ JIB CRANE AND LOAD PATH AREA



**SOUTHERN COMPANY SERVICES, INC.**  
 BIRMINGHAM, ALABAMA

**GEORGIA POWER COMPANY**  
 ALVIN W. VOGTLE NUCLEAR PLANT

HEAVY LOAD HANDLING  
 NORTH MAIN STEAM VALVE ROOM  
 PIPING AREA 2E LEVEL 1  
 EL. 220'-0" AND ABOVE

THIS DOCUMENT CONTAINS PROPRIETARY, CONFIDENTIAL, AND/OR TRADE SECRET INFORMATION OF THE SUBSIDIARIES OF THE SOUTHERN COMPANY OR OF THIRD PARTIES. IT IS INTENDED FOR USE ONLY BY EMPLOYEES OF, OR AUTHORIZED CONTRACTORS OF, THE SUBSIDIARIES OF THE SOUTHERN COMPANY. UNAUTHORIZED POSSESSION, USE, DISTRIBUTION, COPYING, DISSEMINATION, OR DISCLOSURE OF ANY PORTION HEREOF IS PROHIBITED.

SCALE: NONE	DRAWING NO. 1X4DE515	REV. 2
JOB NO. 10604		

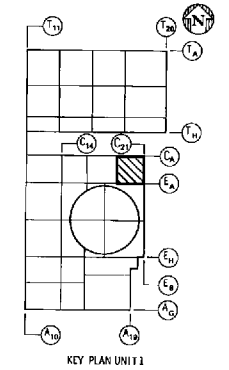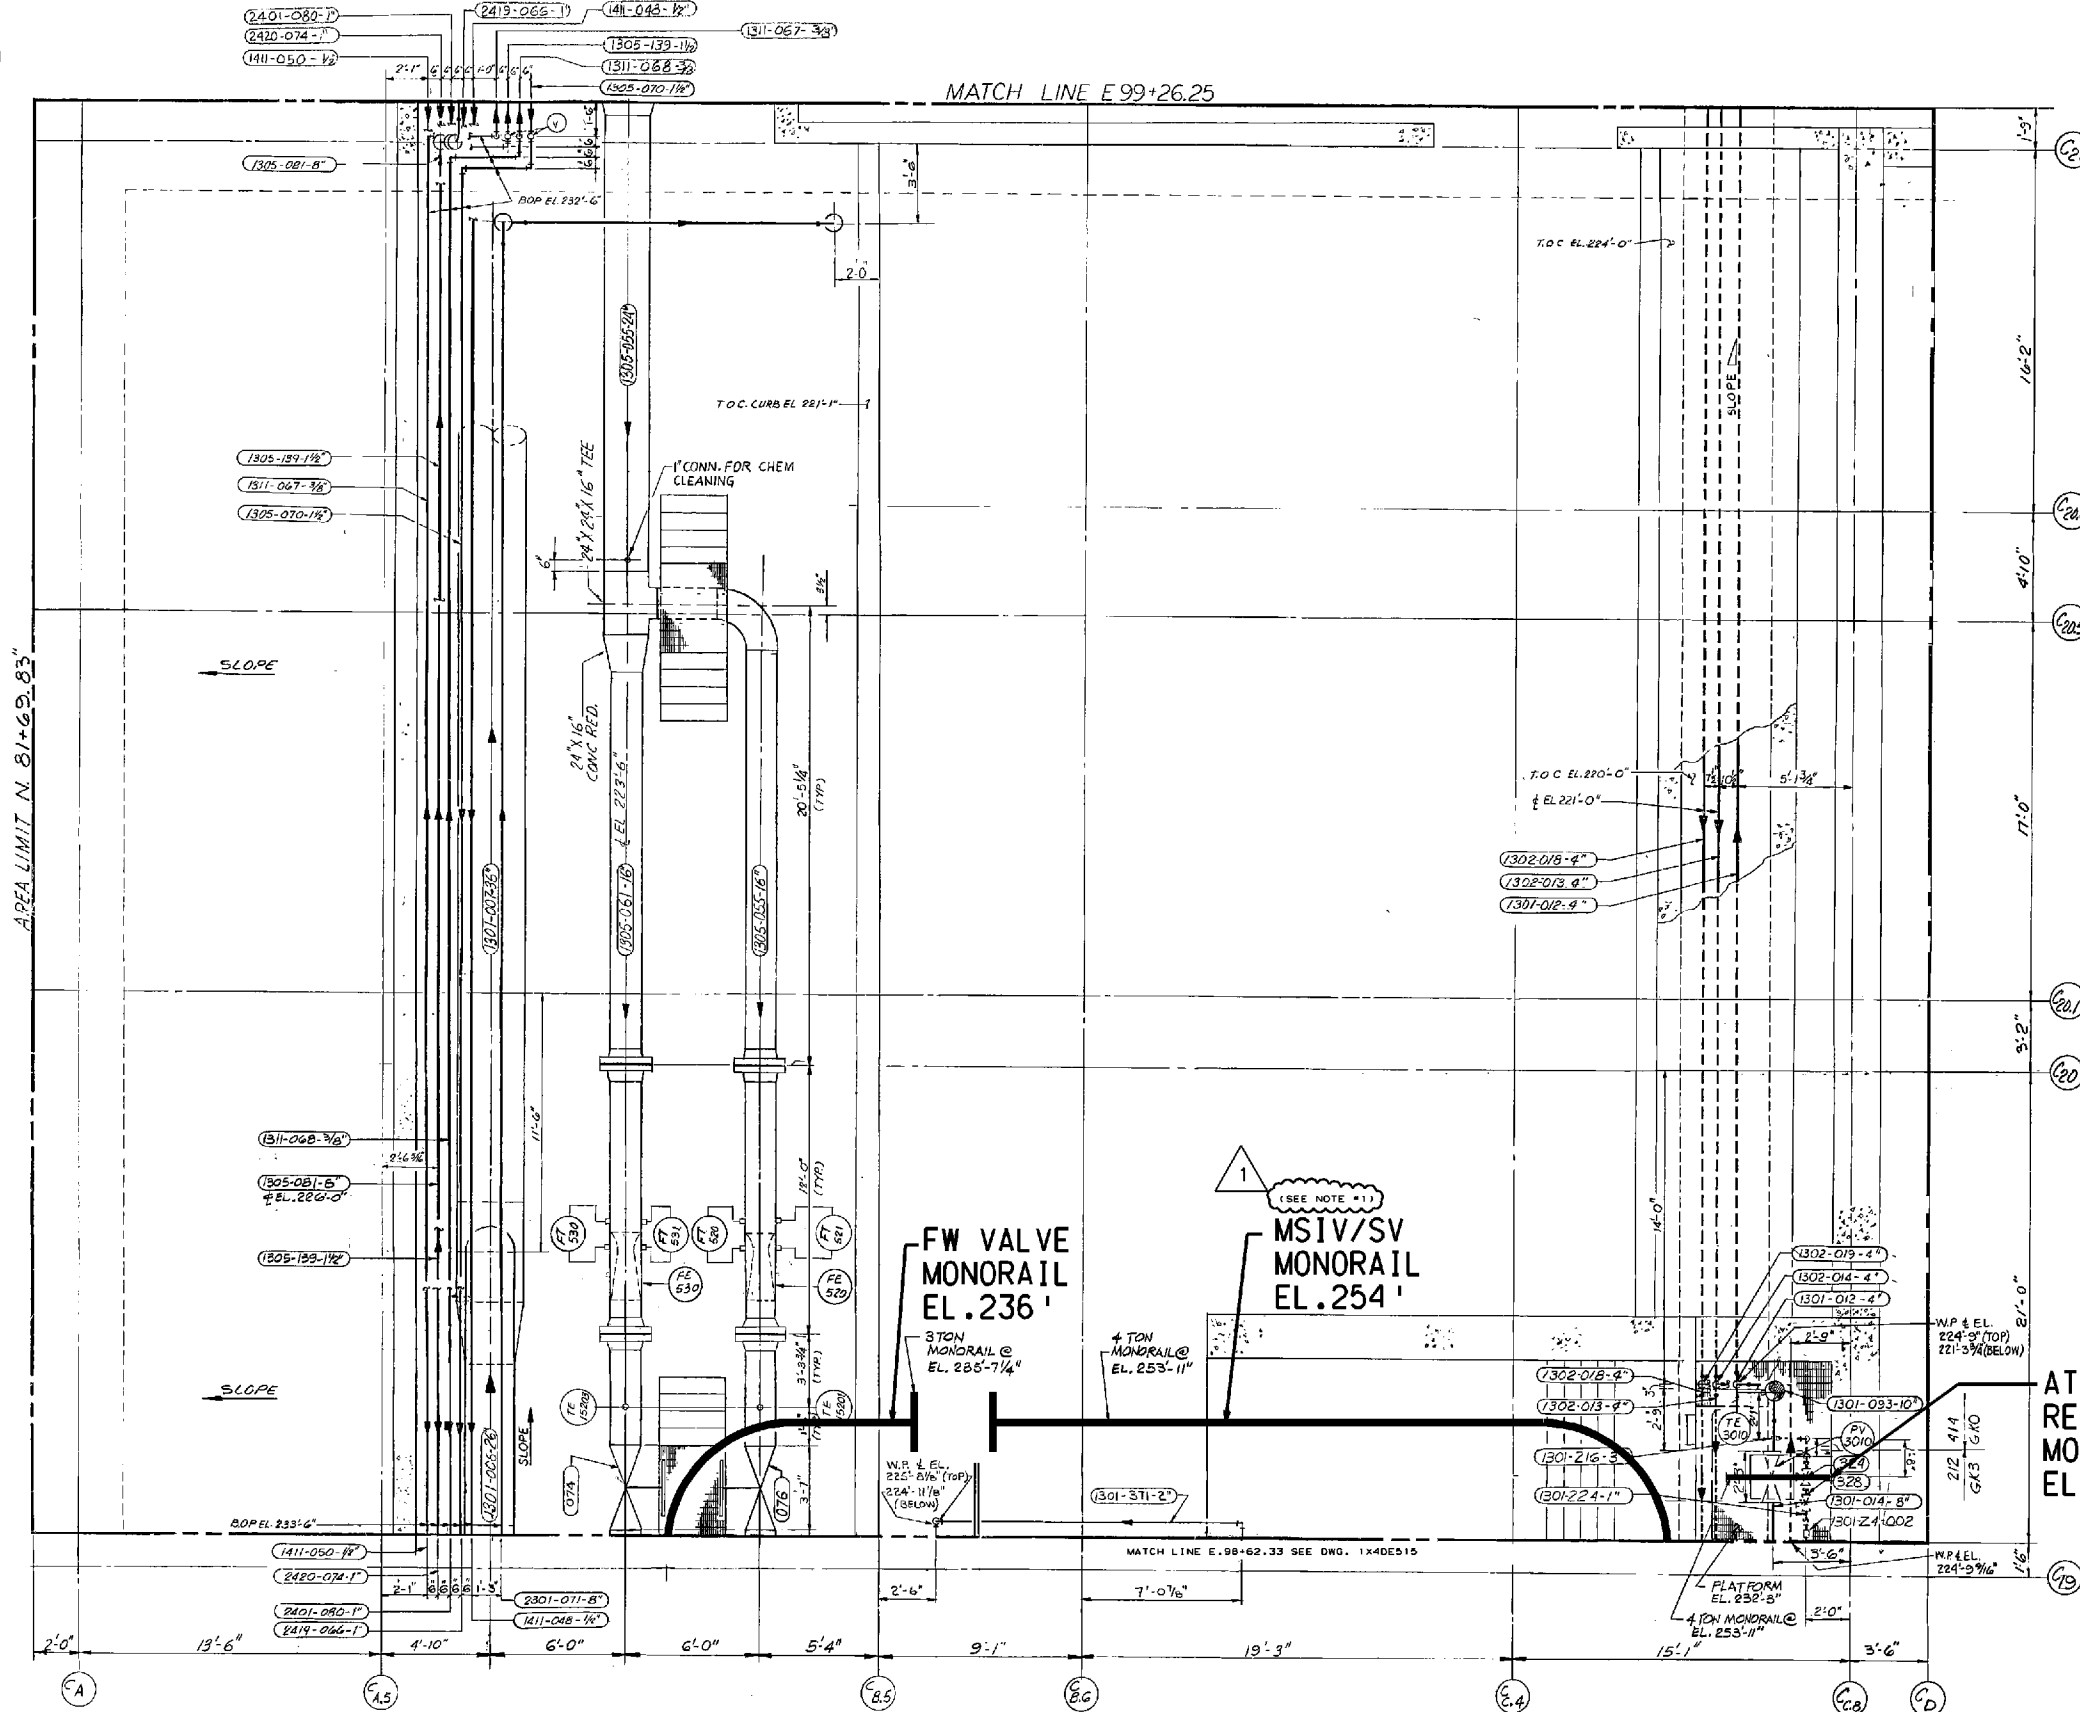

**ATMOSPHERIC RELIEF VALVE MONORAIL EL. 254'**

- LEGEND:**
- ELECTRIC HOIST
  - HAND HOIST WITH CEILING RING
  - ▲ HAND HOIST WITH FLOOR MOUNTED TRIPOD
  - ▣ MOBILE TRUCK CRANE
  - ▭ MONORAIL AND LOAD PATH AREA
  - ⌒ JIB CRANE AND LOAD PATH AREA

**NOTES:**

1. THE MSIV/SV MONORAIL WITH TROLLEY I-1211-R4-0001 MAY BE USED FOR LIFTING THE ACTUATOR OF ATMOSPHERIC RELIEF VALVE 1PW-5020 OVER THE MAIN STEAM LINES UPSTREAM OF MSIV, DURING PLANT OPERATIONS, WITHOUT DOUBLE RIGGING. THE HOIST, THE SLING CONFIGURATION, AND THE CROSBY SHACKLE USED IN THE ACTUATOR LIFT SHALL HAVE A MINIMUM WORKING LOAD LIMIT OF TWO TONS.


**SOUTHERN COMPANY SERVICES, INC.**  
BIRMINGHAM, ALABAMA

**GEORGIA POWER COMPANY**  
**ALVIN W. VOGTLE NUCLEAR PLANT**


HEAVY LOAD HANDLING  
CONTROL BUILDING PIPING  
AREA 2F LEVEL 1  
EL. 220'-0" AND ABOVE

THIS DOCUMENT CONTAINS PROPRIETARY, CONFIDENTIAL, AND/OR TRADE SECRET INFORMATION OF THE SUBSIDIARIES OF THE SOUTHERN COMPANY OR OF THIRD PARTIES. IT IS INTENDED FOR USE ONLY BY EMPLOYEES OF, OR AUTHORIZED CONTRACTORS OF, THE SUBSIDIARIES OF THE SOUTHERN COMPANY. UNAUTHORIZED POSSESSION, USE, DISTRIBUTION, COPYING, DISSEMINATION, OR DISCLOSURE OF ANY PORTION HEREOF IS PROHIBITED.	INCORP. PER ABN 51635 REVISONS	3-20-03 LRP HAB ASK DATE DR CHK APPV DTL	JOB NO. 10604	SCALE: NONE DRAWING NO. 1X4DE516 REV. 1
--	-----------------------------------	---	---------------	---



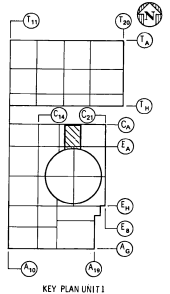

### FW ISOLATION VALVE MONORAIL EL. 218'-0"

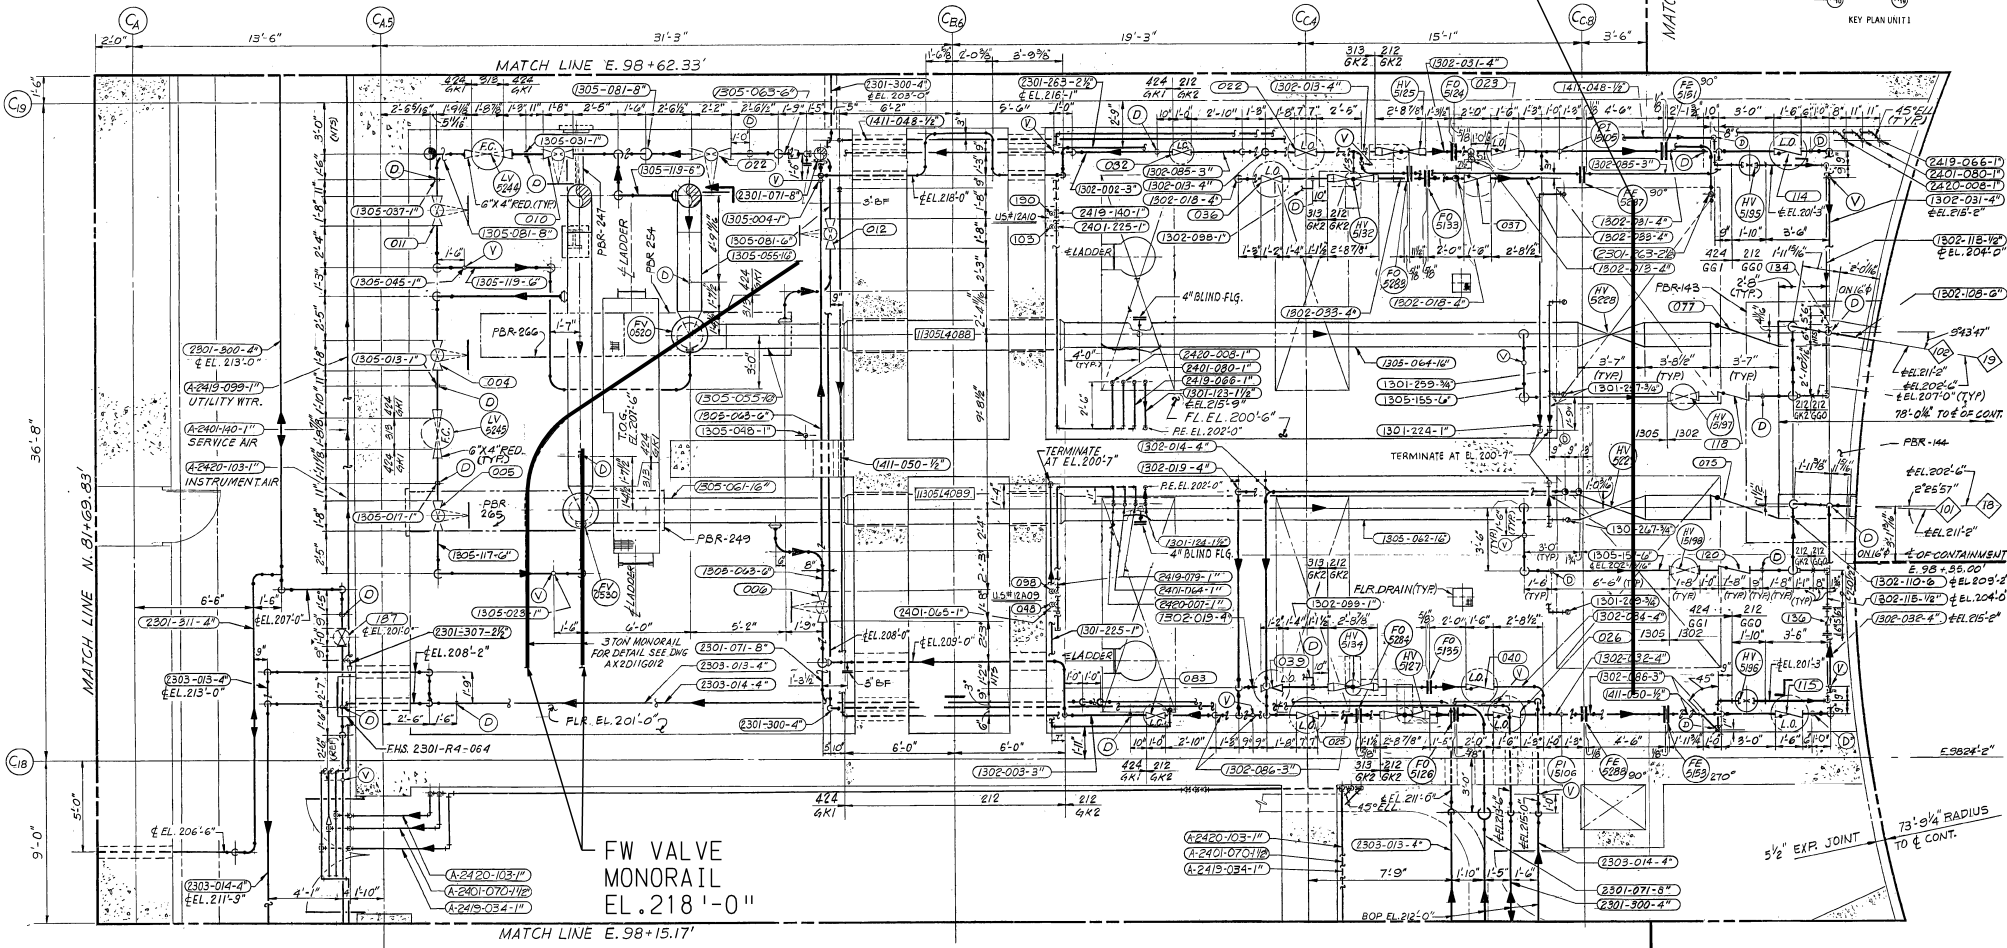

- LEGEND:**
- ELECTRIC HOIST
  - HAND HOIST WITH CEILING RING
  - ▲ HAND HOIST WITH FLOOR MOUNTED TRIPOD
  - MOBILE TRUCK CRANE
  - ▭ MONORAIL AND LOAD PATH AREA
  - ⌒ JIB CRANE AND LOAD PATH AREA


**SOUTHERN COMPANY SERVICES, INC.**  
BIRMINGHAM, ALABAMA

**GEORGIA POWER COMPANY**  
ALVIN W. VOGTLE NUCLEAR PLANT

HEAVY LOAD HANDLING  
NORTH FEEDWATER VALVE  
ROOM PIPING AREA 2E LEVEL A  
EL. 200'-0" TO EL. 220'-0"

THIS DOCUMENT CONTAINS PROPRIETARY, CONFIDENTIAL, AND/OR TRADE SECRET INFORMATION OF THE SUBSIDIARIES OF THE SOUTHERN COMPANY OR OF THEIR PARTIES. IT IS INTENDED FOR USE ONLY BY EMPLOYEES OF, OR AUTHORIZED CONTRACTORS OF, THE SUBSIDIARIES OF THE SOUTHERN COMPANY. UNAUTHORIZED POSSESSION, USE, DISTRIBUTION, COPYING, DISSEMINATION, OR DISCLOSURE OF ANY PORTION HEREOF IS PROHIBITED.			SCALE: NONE	DRAWING NO. 1X4DE517	REV. 0
ISSUED PER REQ 96-YA054	3/8-N ELC RWH CBH WFP	DATE DR CHK APPV DTL	JOB NO.10604	1X4DE517	0
NO. 1	REVISONS	SIZE E 34X44			



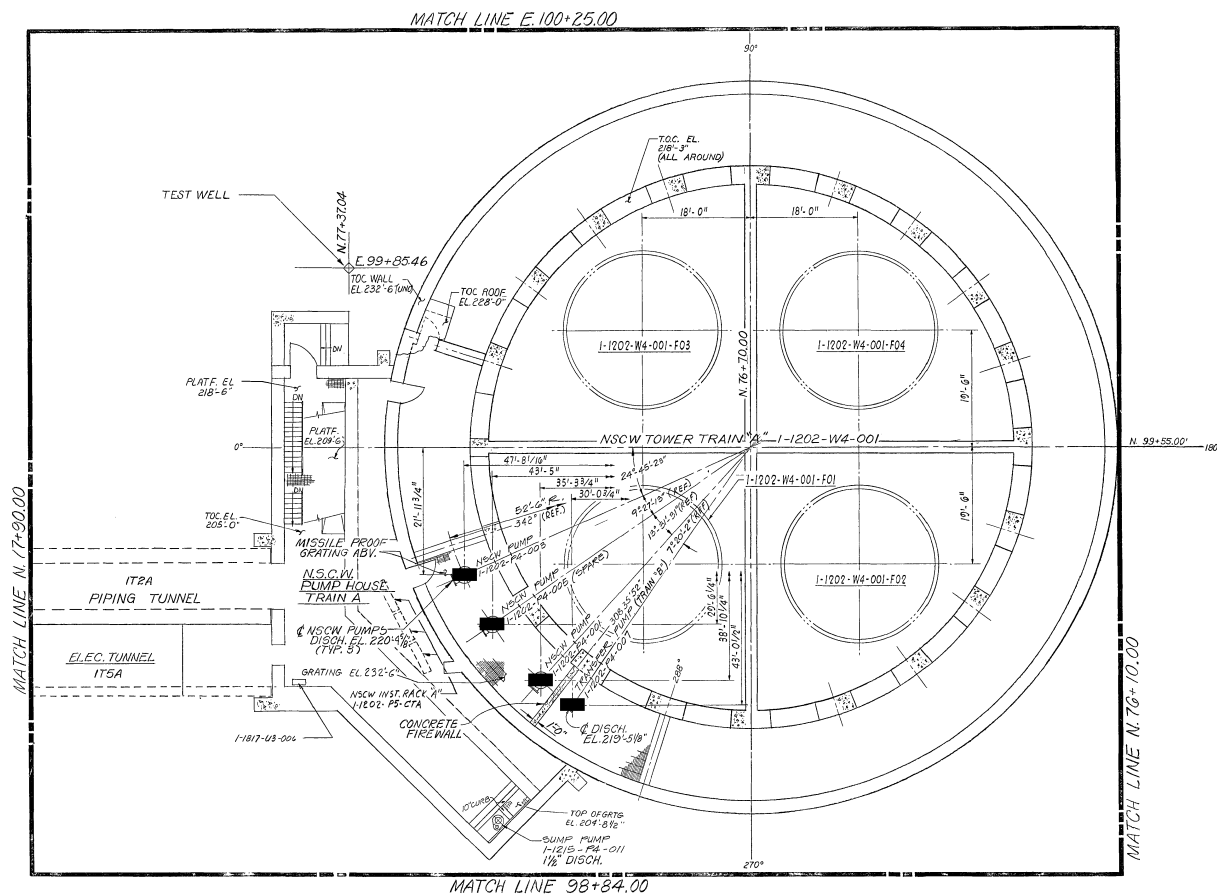


- LEGEND:**
- ELECTRIC HOIST
  - HAND HOIST WITH CEILING RING
  - ▲ HAND HOIST WITH FLOOR MOUNTED TRIPOD
  - MOBILE TRUCK CRANE
  - ▨ MONORAIL AND LOAD PATH AREA
  - ⌢ JIB CRANE AND LOAD PATH AREA

**SOUTHERN COMPANY SERVICES, INC.**  
 BIRMINGHAM, ALABAMA

**GEORGIA POWER COMPANY**  
 ALVIN W. VOGTLE NUCLEAR PLANT

**HEAVY LOAD HANDLING**  
 TRAIN A  
 NUCLEAR SERVICE COOLING WATER TOWER  
 LEVEL 1, EL. 220'-0" (UNIT 1)

THIS DOCUMENT CONTAINS PROPRIETARY, CONFIDENTIAL, AND/OR TRADE SECRET INFORMATION OF THE SUBSIDIARIES OF THE SOUTHERN COMPANY OR OF THIRD PARTIES. IT IS INTENDED FOR USE ONLY BY EMPLOYEES OF, OR AUTHORIZED CONTRACTORS OF, THE SUBSIDIARIES OF THE SOUTHERN COMPANY. UNAUTHORIZED POSSESSION, USE, DISTRIBUTION, COPYING, DISSEMINATION, OR DISCLOSURE OF ANY PORTION HEREOF IS PROHIBITED.		ISSUED PER REQ 96-VAA054	3/28/98	JLH	FRW	CBH	WFP
NO.	REVISIONS	DATE	DR	CHK	APPV	DTL	
SCALE: NONE		DRAWING NO.		REV.			
JOB NO. 10604		1X40E518		0			
SIZE E 34X44							

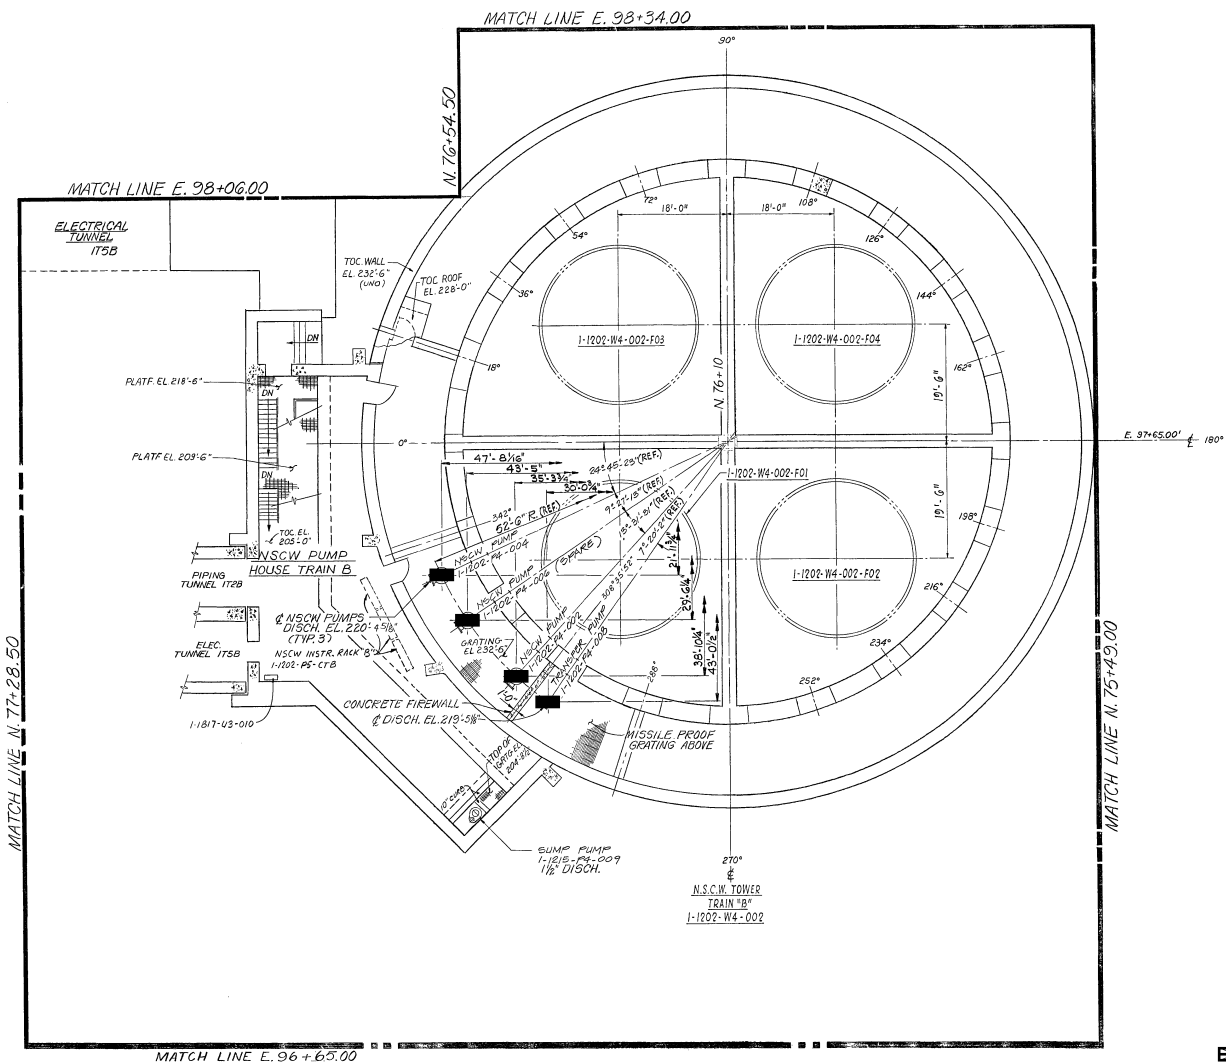

- LEGEND:**
- ELECTRIC HOIST
  - HAND HOIST WITH CEILING RING
  - ▲ HAND HOIST WITH FLOOR MOUNTED TRIPOD
  - MOBILE TRUCK CRANE
  - ▭ MONORAIL AND LOAD PATH AREA
  - ⌒ JIB CRANE AND LOAD PATH AREA

**SOUTHERN COMPANY SERVICES, INC.**  
 BIRMINGHAM, ALABAMA

**GEORGIA POWER COMPANY**  
 ALVIN W. VOGTLE NUCLEAR PLANT

**HEAVY LOAD HANDLING**  
 TRAIN B  
 NUCLEAR SERVICE COOLING WATER TOWER  
 LEVEL 1 EL. 220'-0" (UNIT 1)

NO.	ISSUED PER REQ 96-YA0084	3/28/98	JLH	RWB	CBH	WFP
	REVISIONS	DATE	DR	CHK	APPV	DTL
SCALE: NONE						
DRAWING NO.						REV.
JOB NO. 10604						1X4DE519
SIZE E 34X44						0

THIS DOCUMENT CONTAINS PROPRIETARY, CONFIDENTIAL, AND/OR TRADE SECRET INFORMATION OF THE SUBSIDIARIES OF THE SOUTHERN COMPANY OR OF THIRD PARTIES. IT IS INTENDED FOR USE ONLY BY EMPLOYEES OF, OR AUTHORIZED CONTRACTORS OF, THE SUBSIDIARIES OF THE SOUTHERN COMPANY. UNAUTHORIZED POSSESSION, USE, DISTRIBUTION, COPYING, DISSEMINATION, OR DISCLOSURE OF ANY PORTION HEREOF IS PROHIBITED.
















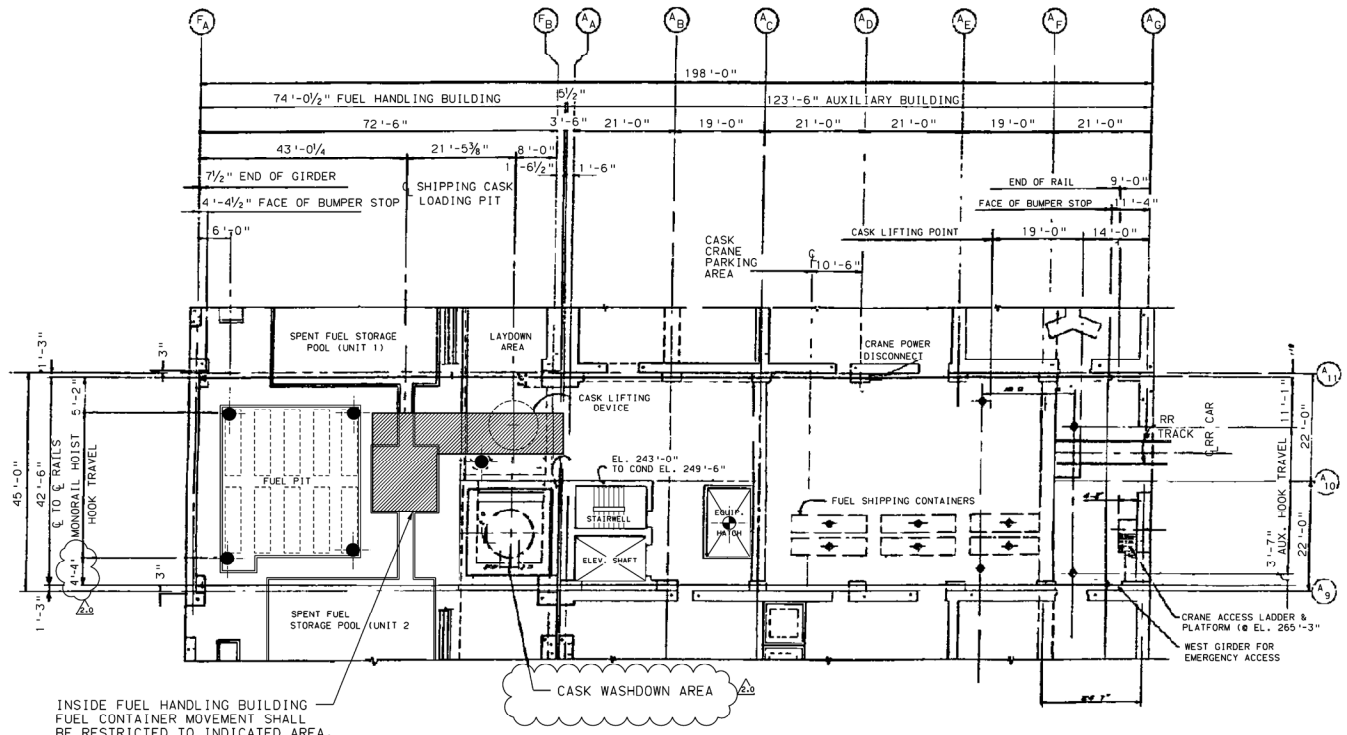

INSIDE FUEL HANDLING BUILDING  
FUEL CONTAINER MOVEMENT SHALL  
BE RESTRICTED TO INDICATED AREA.

- LEGEND
- LIMIT OF MAIN HOOK TRAVEL WITH OVER 15 TON LOAD
  - MAIN HOOK LIFTING POINT
  - AUXILIARY TROLLEY LIFTING POINT
  - MONORAIL LIFT POINT

THIS DOCUMENT CONTAINS PROPRIETARY, CONFIDENTIAL, AND/OR TRADE SECRET INFORMATION OF THE SUBSIDIARIES OF THE SOUTHERN COMPANY OR OF THIRD PARTIES. IT IS INTENDED FOR USE ONLY BY EMPLOYEES OF, OR AUTHORIZED CONTRACTORS OF, THE SUBSIDIARIES OF THE SOUTHERN COMPANY. UNAUTHORIZED POSSESSION, USE, DISTRIBUTION, COPYING, DISSEMINATION, OR DISCLOSURE OF ANY PORTION HEREOF IS PROHIBITED.

NO.	REVISED PER AIN SMC1423TAN25, VER. 2.0	11/20/16	HL	JMM	JMR
VER.	2.0	DATE	DR	CHK	APPV

**SOUTHERN COMPANY SERVICES, INC.**  
BIRMINGHAM, ALABAMA

**GEORGIA POWER COMPANY**  
ALVIN W. VOGTLE NUCLEAR PLANT

SAFE LOAD PATH FOR MOVEMENT OF  
FUEL CONTAINERS UTILIZING SPENT  
FUEL CASK BRIDGE CRANE A-2109-R4-001

SCALE: NONE	DRAWING NO.	VER.
JOB NO. 10604	1X4DE603	2.0

8

7

6

5

4

3

2

1

H

G

F

E

D

C

B

A

SIZE E 3444




THIS DOCUMENT CONTAINS PROPRIETARY, CONFIDENTIAL, AND/OR TRADE SECRET INFORMATION OF THE SOUTHERN COMPANY OR OF THIRD PARTIES. IT IS INTENDED FOR USE ONLY BY EMPLOYEES OF, OR AUTHORIZED CONTRACTORS OF, THE SOUTHERN COMPANY. UNAUTHORIZED POSSESSION, USE, DISTRIBUTION, COPYING, DISSEMINATION, OR DISCLOSURE OF ANY PORTION HEREOF IS PROHIBITED.

NOTES: (UNIT 1 ONLY)  
 1. LIFTS IN THE MEZZANINE AREA OVER THE SEAL INJECTION FILTER PITS, R-B151 OR R-B152, WHEN CONCRETE PLUGS ARE NOT INSTALLED SHALL BE LIMITED TO THE EQUIPMENT REQUIRED TO PERFORM CARTRIDGE FILTER ELEMENT REPLACEMENTS (I.E. WORKING SHIELD PLUG, CENTRAL PLUG, AND TRANSFER CASK).

LEGEND

THE LOAD IN THIS AREA SHALL NOT BE LIFTED HIGHER THAN 3 FEET (AS MEASURED FROM SLAB TO BOTTOM OF LOAD).

THE LOAD HEIGHT IN THIS AREA IS NOT LIMITED.

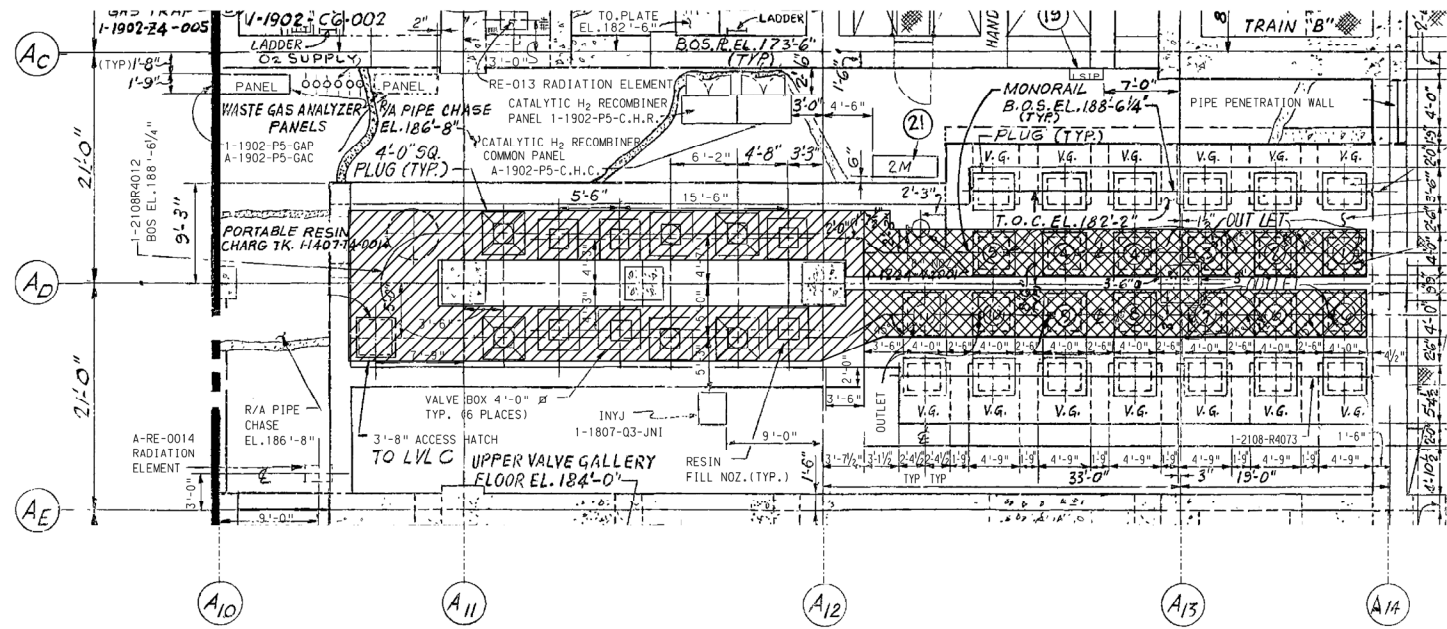

1.0


NOTE: UNIT 1 SHOWN. UNIT 2 IS A MIRROR IMAGE.

**SOUTHERN COMPANY SERVICES, INC.**  
 BIRMINGHAM, ALABAMA  
**GEORGIA POWER COMPANY**  
 ALVIN W. VOGTLE NUCLEAR PLANT

SAFE LOAD PATH FOR BACKFLUSHABLE  
 FILTER MONORAIL  
 AUXILIARY BUILDING  
 LEVEL B MONORAIL 2108-R4-012

NO.	VERSIONS	DATE	DR	CHK	APPV	TSL	CYN	JLO	09/19/14	1.0
SCALE: NONE      DRAWING NO. 1X4DE605      VER. 1.0 JOB NO. 10604										


THIS DOCUMENT CONTAINS PROPRIETARY, CONFIDENTIAL, AND/OR TRADE SECRET INFORMATION OF THE SOUTHERN COMPANY OR ITS SUBSIDIARIES OF THE SOUTHERN COMPANY OR OF THIRD PARTIES. IT IS INTENDED FOR USE ONLY BY EMPLOYEES OF, OR AUTHORIZED CONTRACTORS OF, THE SOUTHERN COMPANY. UNAUTHORIZED POSSESSION, USE, DISTRIBUTION, COPYING, DISSEMINATION, OR DISCLOSURE OF ANY PORTION HEREOF IS PROHIBITED.

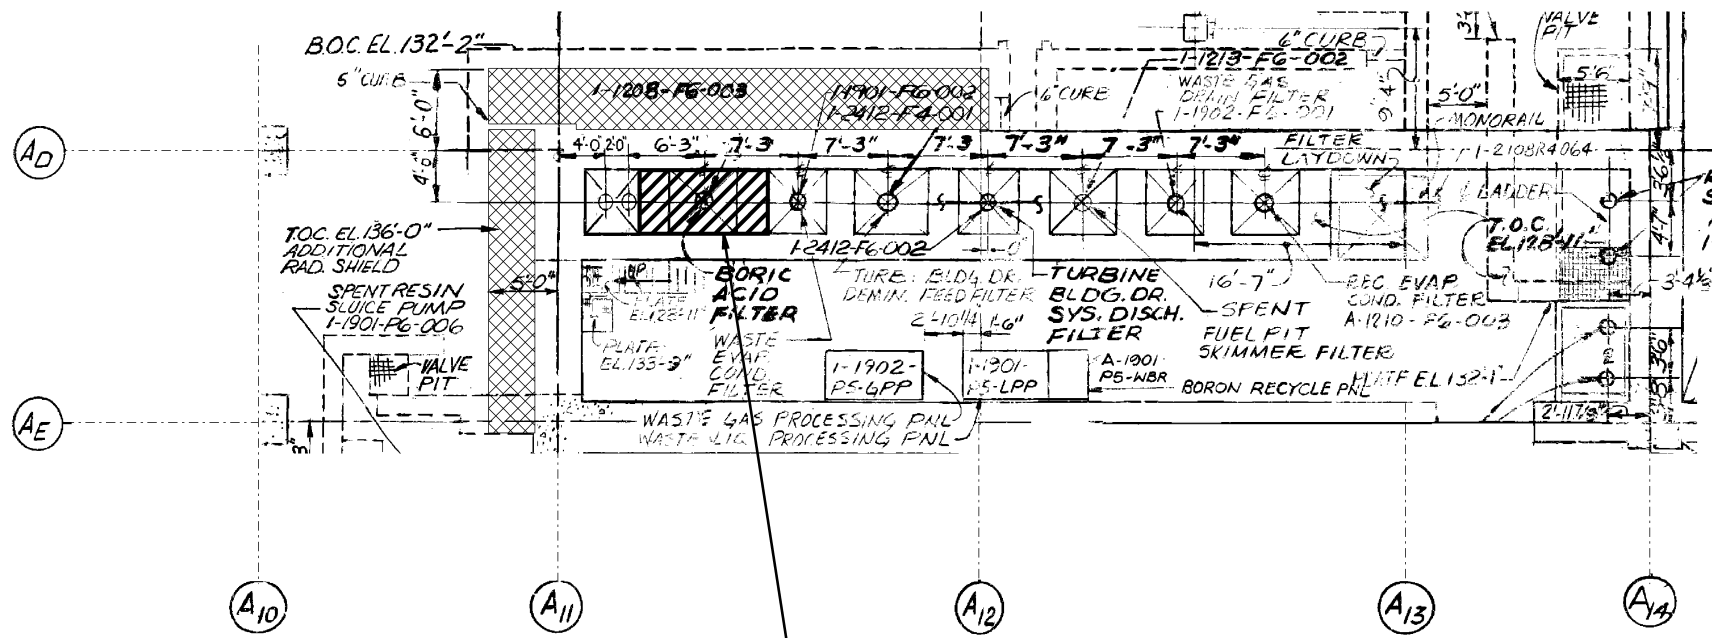




IN THE INDICATED AREA THE LOAD SHALL NOT BE LIFTED HIGHER THAN 1 FOOT (AS MEASURED FROM SLAB TO BOTTOM OF LOAD)

SOUTHERN COMPANY SERVICES, INC. BIRMINGHAM, ALABAMA		
GEORGIA POWER COMPANY ALVIN W. VOGTLE NUCLEAR PLANT		
SAFE LOAD PATH FOR CARTRIDGE FILTER MONORAIL AUXILIARY BUILDING LEVEL D MONORAIL 2108-R4-064 (UNIT 1)		

<table border="1"> <tr> <td>△</td> <td></td> <td></td> <td></td> <td></td> <td></td> <td></td> </tr> <tr> <td>△</td> <td>REVISED PER REA 96-VAA054</td> <td>10-1-98</td> <td>GS</td> <td>RBH</td> <td>CBH</td> <td></td> </tr> <tr> <td>△</td> <td>ISSUED PER REA 96-VAA054</td> <td></td> <td></td> <td></td> <td></td> <td></td> </tr> <tr> <td>NO.</td> <td>REVISIONS</td> <td>DATE</td> <td>DR</td> <td>CHK</td> <td>APPV</td> <td>DTL</td> </tr> </table>	△							△	REVISED PER REA 96-VAA054	10-1-98	GS	RBH	CBH		△	ISSUED PER REA 96-VAA054						NO.	REVISIONS	DATE	DR	CHK	APPV	DTL	SCALE: NONE JOB NO. 10604	DRAWING NO. 1X4DE606	REV. 1
△																															
△	REVISED PER REA 96-VAA054	10-1-98	GS	RBH	CBH																										
△	ISSUED PER REA 96-VAA054																														
NO.	REVISIONS	DATE	DR	CHK	APPV	DTL																									

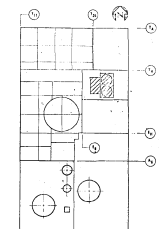

KEY PLAN UNIT 1

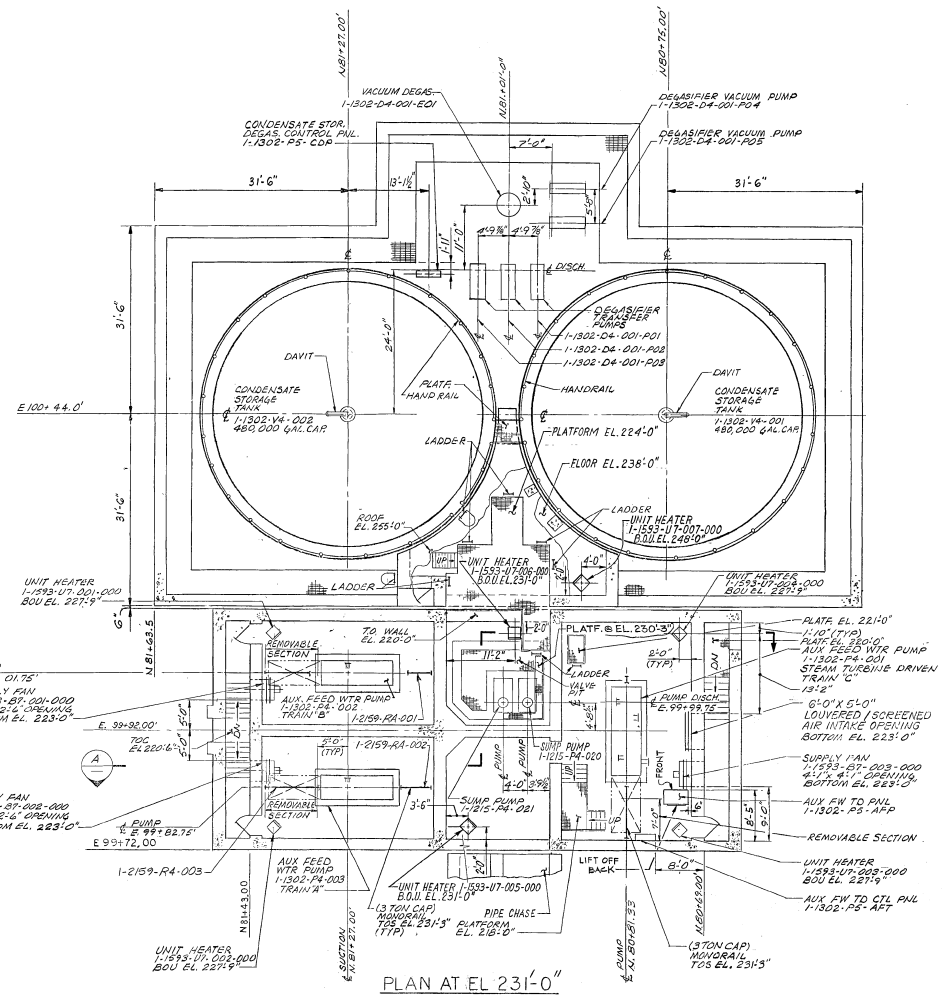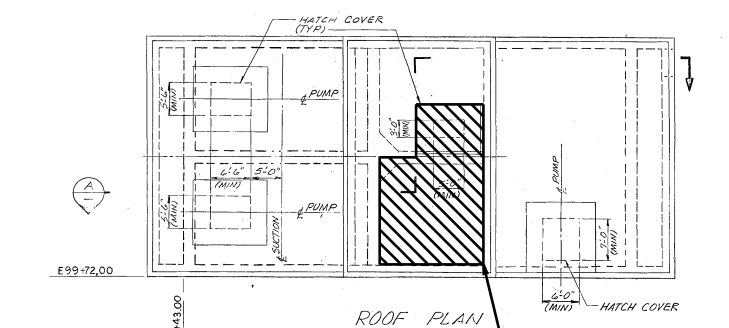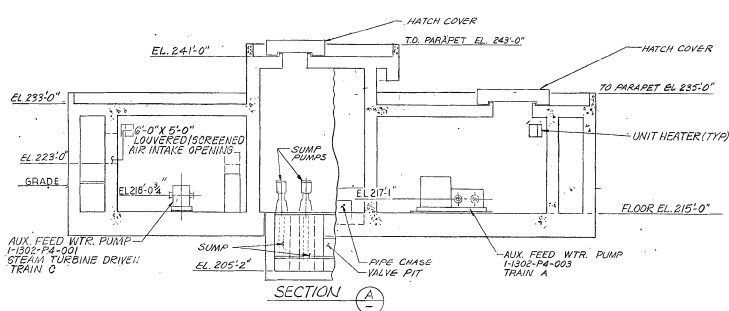

THE LOAD SHALL BE LIFTED ONLY IN THE INDICATED AREA AND SHALL NOT BE LIFTED HIGHER THAN 2 FT. (AS MEASURED FROM THE SLAB TO THE BOTTOM OF THE LOAD).


NOTE: UNIT 1 SHOWN. UNIT 2 IS A MIRROR IMAGE.

SOUTHERN COMPANY SERVICES, INC. BIRMINGHAM, ALABAMA  
GEORGIA POWER COMPANY ALVIN W. VOGTLE NUCLEAR PLANT  
SAFE LOAD PATH FOR AUXILIARY FEEDWATER PUMPHOUSE SUMP PUMP HATCHES


THIS DOCUMENT CONTAINS PROPRIETARY, CONFIDENTIAL, AND/OR TRADE SECRET INFORMATION OF THE SUBSIDIARIES OF THE SOUTHERN COMPANY OR OF THIRD PARTIES. IT IS INTENDED FOR USE ONLY BY EMPLOYEES OF, OR AUTHORIZED CONTRACTORS OF, THE SUBSIDIARIES OF THE SOUTHERN COMPANY. UNAUTHORIZED POSSESSION, USE, DISTRIBUTION, COPYING, DISSEMINATION, OR DISCLOSURE OF ANY PORTION HEREOF IS PROHIBITED.

ISSUED PER REQ 96-YA064	3/8/88	SRM	RDW	CBH	WFP
NO.	DATE	DR	CHK	APPV	DTL
REVISIONS					
SCALE: NONE	DRAWING NO. 1X4DE607		REV. 0		
JOB NO. 10604	SIZE E 34X44		CAD NAME 1X4DE600		




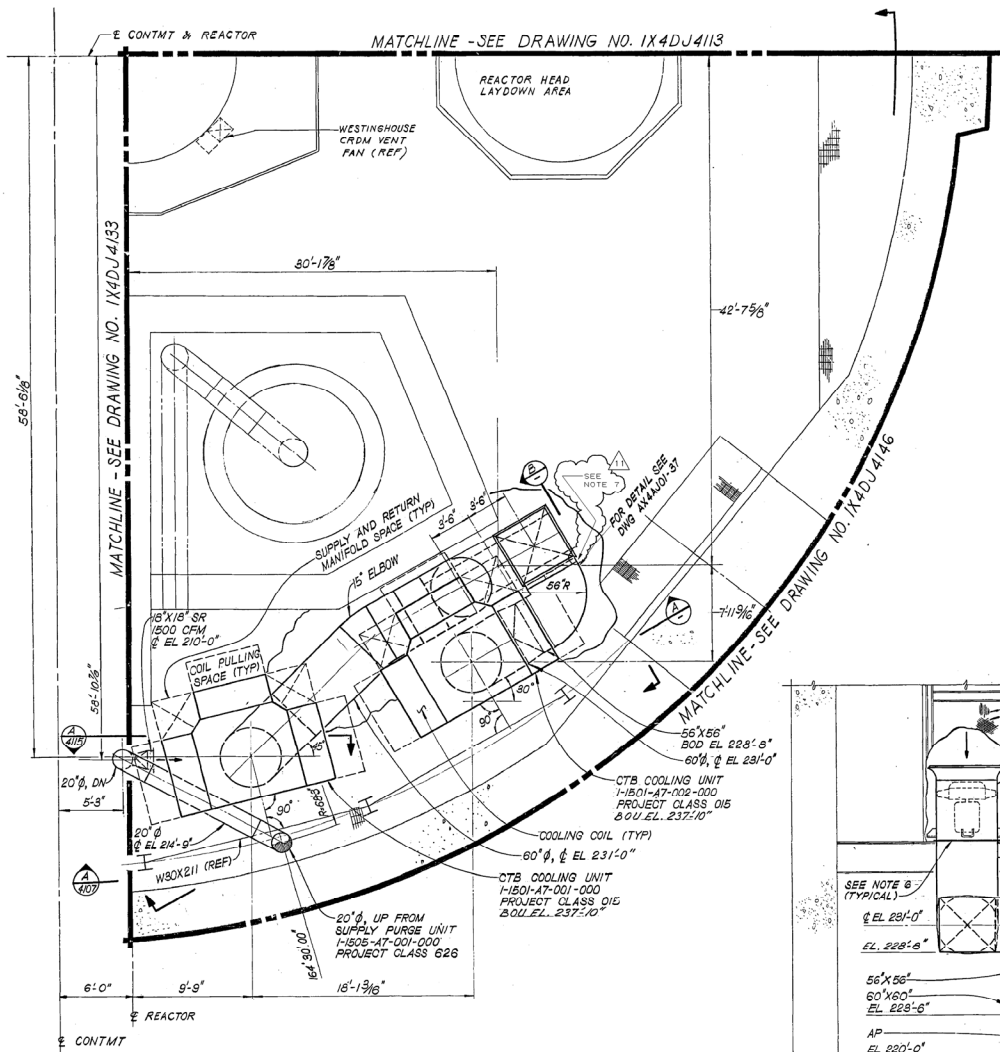


PLAN - EL. 210'-0" TO 238'-0"  
SCALE: 1/4" = 1'-0"

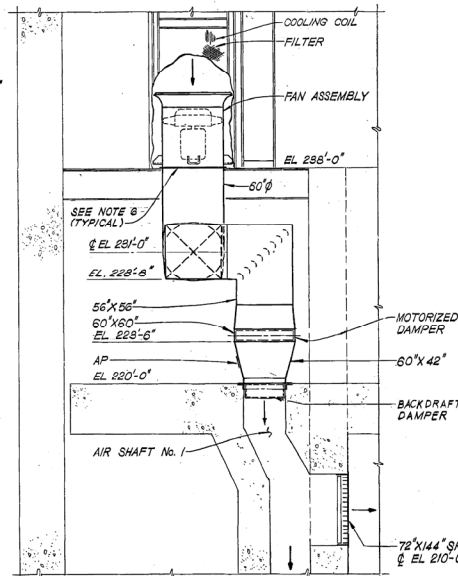

SECTION A-A  
SCALE: 1/4" = 1'-0"

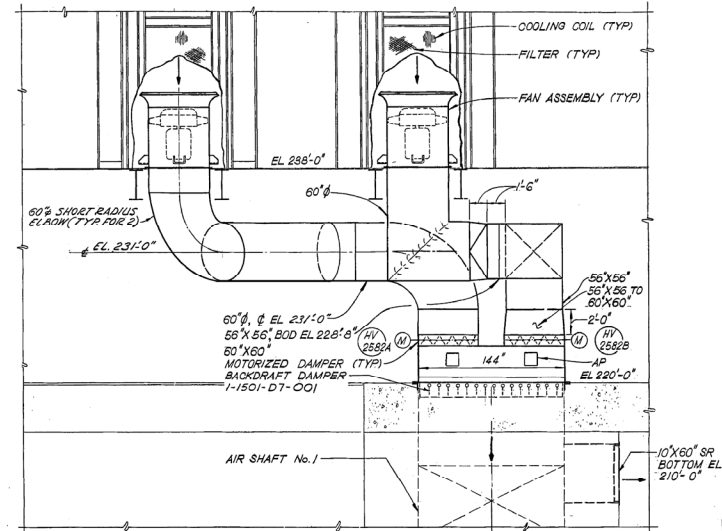

SECTION B-B  
SCALE: 1/4" = 1'-0"

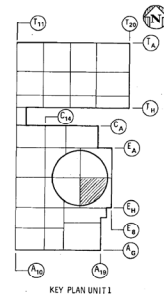

KEY PLAN UNIT

NOTES:

1. FOR GENERAL NOTES AND LEGEND SEE DWG AX4DJ0001 AND AX4DJ0002.
2. FOR AREA ABOVE SEE DWG 1X4DJ4102.
3. FOR AREA BELOW SEE DWG 1X4DJ4105.
4. ALL DUCTWORK SHOWN IS PROJECT CLASS O15 UNLESS OTHERWISE NOTED.
5. FOR FLOW TRANSMITTERS LOCATIONS SEE CONTROL BLDG. DRAWING 1X4DJ4111
6. DUCTWORK SHALL BE BOLTED TO THE BOTTOM OF SYSTEM 1-1501-AT-001-000 & 002-000 UNITS, BOLT PATTERN TO CONFORM TO DWG AX2D6T001 REQUIREMENTS.
7. SEE MDC 97-V110059 FOR TURNING VANE GAUGE AND CERTIFIED DETAILS.

REFERENCE DRAWINGS

PEID	1X402 212, 213 & 251
CIVIL	1X2248402
STRUCTURAL	1X2248402, F113
ARCHITECTURAL	
PIPING	1X4DL4A02, A03
PLUMBING	
ELECTRICAL	1X3DK813, K514
DUCT SUPPORT	

ACTIVITY PACKAGE NO. 412101116A

**SOUTHERN COMPANY SERVICES, INC.**  
 BIRMINGHAM, ALABAMA


**GEORGIA POWER COMPANY**  
 ALVIN W. VOGTLE NUCLEAR PLANT

CONTAINMENT BLDG  
 AREA 4A LEVEL 1  
 PLAN EL. 210'-0" TO 238'-0"


THIS DOCUMENT CONTAINS PROPRIETARY, CONFIDENTIAL, AND/OR TRADE SECRET INFORMATION OF THE SUBSIDIARIES OF THE SOUTHERN COMPANY OR ITS THIRD PARTIES. IT IS INTENDED FOR THE USE ONLY BY EMPLOYEES OF, OR AUTHORIZED CONTRACTORS OF, THE SUBSIDIARIES OF THE SOUTHERN COMPANY. UNAUTHORIZED POSSESSION, USE, DISTRIBUTION, COPYING, DISSEMINATION, OR DISCLOSURE OF ANY PORTION HEREOF IS PROHIBITED.

NO.	REV.	DATE	BY	CHK	APPV	DTL
1						
2						
3						
4						
5						


SCALE: NONE	DRAWING NO. 1X4DJ4103	REV. 11
JOB NO. 10604		

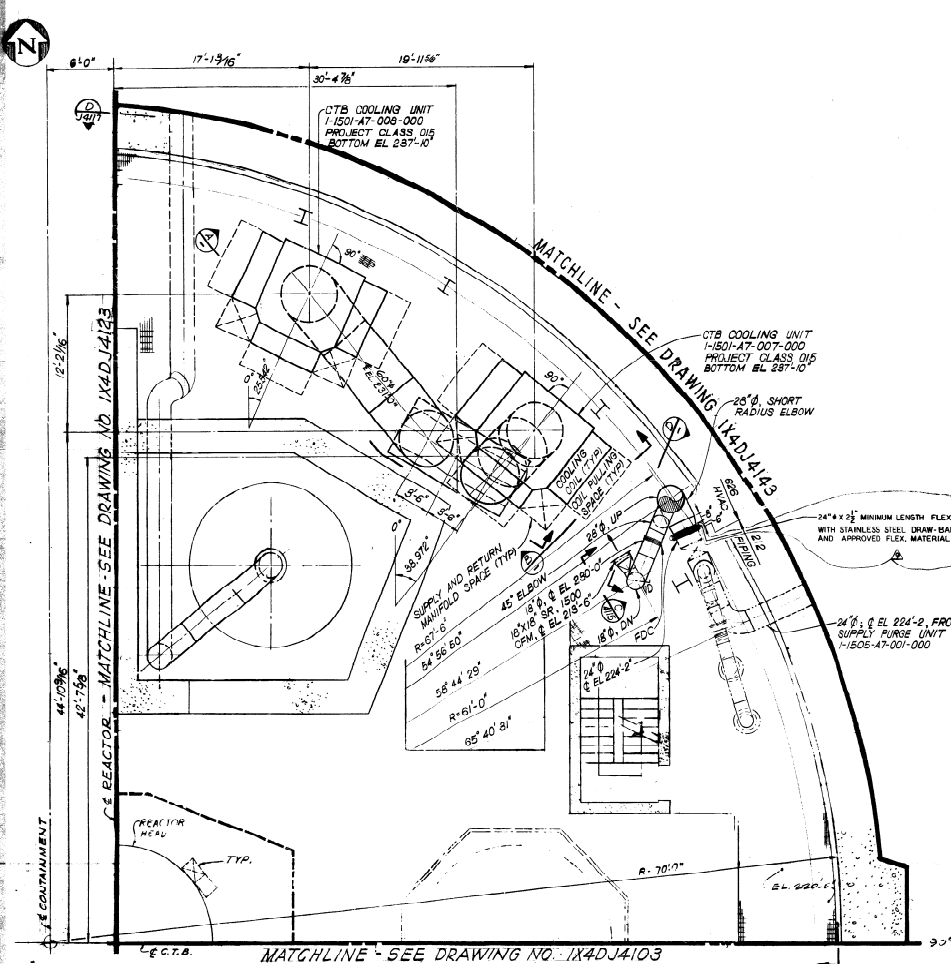


PLAN EL 210'-0" TO 238'-0"  
SCALE 1/4" = 1'-0"

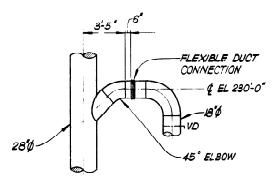


SECTION C  
SCALE 1/4" = 1'-0"

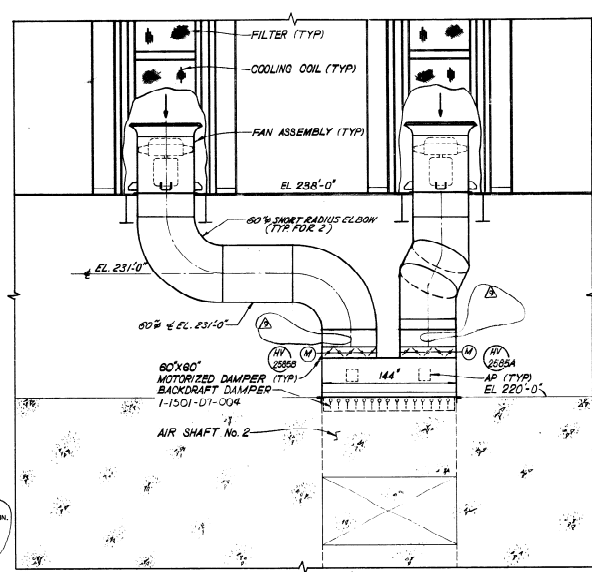

SECTION A  
SCALE 1/4" = 1'-0"

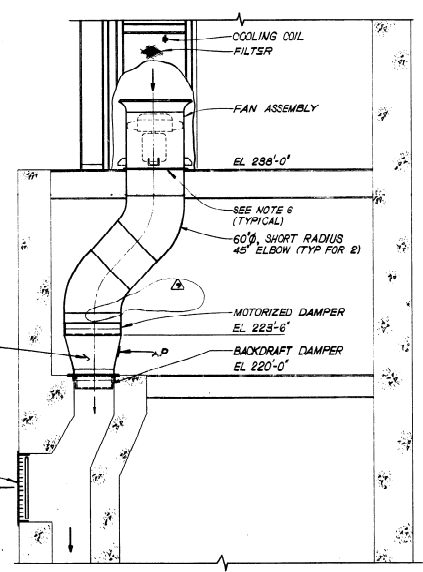

SECTION B  
SCALE 1/4" = 1'-0"

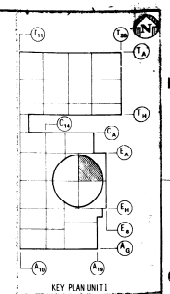

- NOTES:**
- 1 FOR GENERAL NOTES AND LEGEND SEE DWG IX4DJ0001 AND IX4DJ0002.
  - 2 FOR AREA ABOVE SEE DWG IX4DJ4112
  - 3 FOR AREA BELOW SEE DWG IX4DJ4115
  - 4 ALL DUCTWORK SHOWN IS PROJECT CLASS OIS UNLESS OTHERWISE NOTED.
  - 5 FOR FLOW TRANSMITTER LOCATION SEE CONTROL BLDG DRAWING IX4DJ0103.
  - 6 DUCTWORK SHALL BE BOLTED TO THE BOTTOM OF SYSTEM 1-1501-A7-007-000 & 008-000 UNITS, BOLT PATTERN TO CONFORM TO DWG IX30K5003 & 5.3 REQUIREMENTS.

- REFERENCE DRAWINGS**
- PI&ID IX4DB212, 213, 251 & 215-1
  - CIVIL IX2D4840/2
  - STRUCTURAL IX2D48F1/4
  - ARCHITECTURAL
  - PIPING IX4DLB02, B03
  - PLUMBING IX4DH4103
  - ELECTRICAL IX30K5003 & 5.3
  - DUCT SUPPORT

412018067A  
ACTIVITY PACKAGE NO. 412011164  
LOS ANGELES

**BECHTEL**

**GEORGIA POWER COMPANY**  
ALVIN W. VOGTLE NUCLEAR PLANT


CONT. PENT BLDG  
AREL. 4B LEVEL 1  
PLAN EL. 210'-0" TO 238'-0"

SCALE 1/4" = 1'-0" DRAWING NO. 11X4DJ4115 REV. 3


JOB NO. 9510

NO.	DATE	BY	CHK.	APP.	REVISIONS	DATE	BY	CHK.	APP.	REVISIONS
1	11/14/84	JCH	JCH	JCH	ISSUED FOR CONSTRUCTION					
2					REVISED DUCTWORK					
3					PURGE SUPPLY DUCT REVISED					




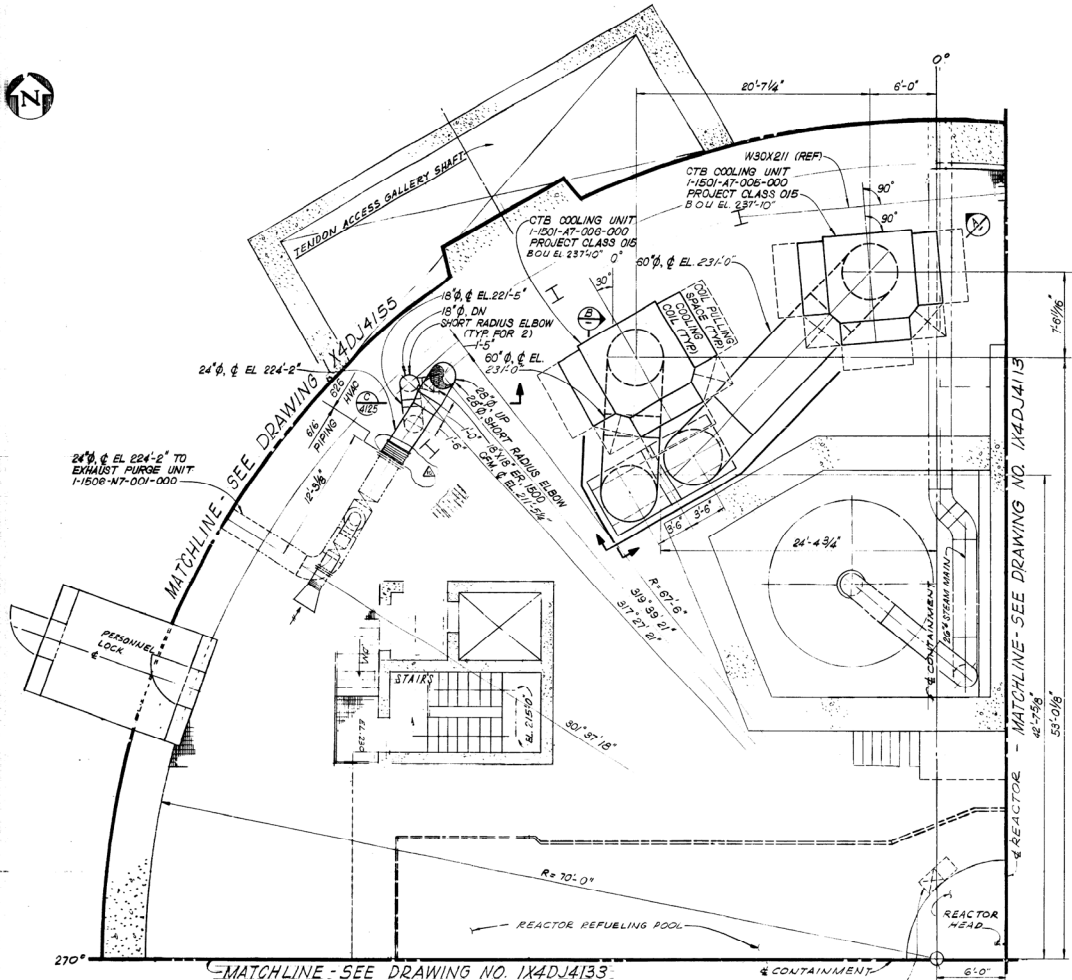


PLAN EL 210'-0" TO 238'-0"  
SCALE: 1/4" = 1'-0"

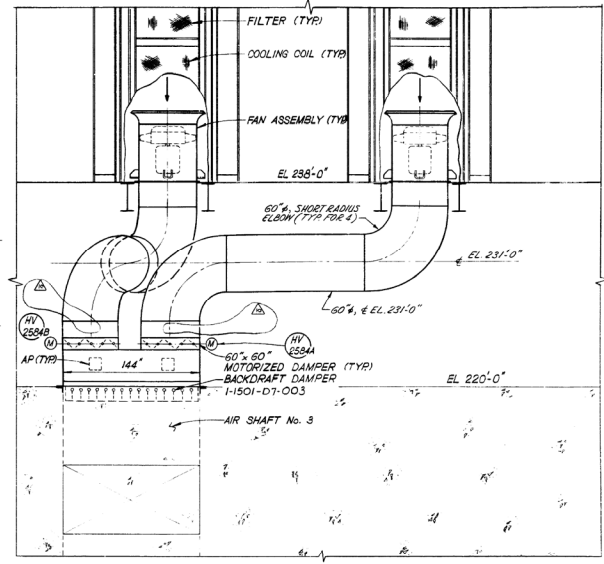

SECTION (A)  
SCALE: 1/2" = 1'-0"

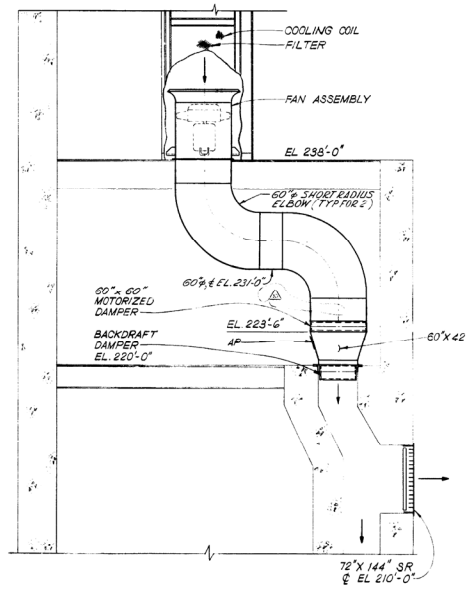

SECTION (B)  
SCALE: 1/2" = 1'-0"

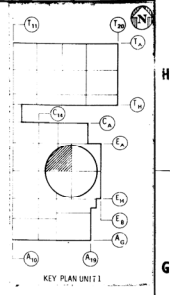

- NOTES:
- FOR GENERAL NOTES AND LEGEND SEE DWG AX4DJ001 AND AX4DJ002.
  - FOR AREA ABOVE SEE DWG 1X4DJ112.
  - FOR AREA BELOW SEE DWG 1X4DJ112.
  - ALL DUSTWORK SHOWN IS PROJECT CLASS D15 UNLESS OTHERWISE NOTED.
  - FOR FLOW TRANSMITTER LOCATION SEE CONTROL BLDG DWG 1X4D2111.
  - DUCTWORK SHALL BE BOLTED TO THE BOTTOM OF THE COOLING UNITS 11501-AT-008-000 AND 11501-AT-006-000. WATERS TO CONFORM TO DRAWING AX2067001 REQUIREMENTS.

- REFERENCE DRAWINGS
- PAID CIVIL: 1X4DB212, 215 & 221
  - STRUCTURAL: 1X2D48414
  - ARCHITECTURAL: 1X2D48F114
  - PIPEFITING: 1X4DL4002, 008
  - PLUMBING: 1X4DH1103
  - ELECTRICAL: 1X3DK803 & 812
  - ELECTRICAL: 1X2D48W204 & 211





4121018057A  
ACTIVITY PACKAGE NO. 41210111105A

 <b>BECHTEL</b> LOS ANGELES	<b>GEORGIA POWER COMPANY</b>	
	<b>ALVIN W. VOGLE NUCLEAR PLANT</b>	
CONTAINMENT BLDG AP, 1 <sup>st</sup> AC LEVEL, 1 PLAN EL. 239'-0" TO 238'-0"		

NO.	INCORP.	DATE	DR.	CHK.	DM.	REV.	BY	CHK.	NO.	DESCRIPTION
1	INCORP. MFCRB-14225, MFCRB-1552 & MFCRB-1655	5/28/68	DR.	CHK.	DM.	1	NT	NT	1	INCORP. DCN # 9 (C-PCRB-18-625)
2	INCORP. DCN # 9 (C-PCRB-18-625)	5/28/68	DR.	CHK.	DM.	1	NT	NT	1	INCORP. DCN # 3 (REVISED MOTOR COOLING UNITS)
3	INCORP. DCN # 7 (S)	5/28/68	DR.	CHK.	DM.	1	NT	NT	1	INCORP. DCN # 3 (REVISED MOTOR COOLING UNITS)
4	INCORP. DCN # 7 (S)	5/28/68	DR.	CHK.	DM.	1	NT	NT	1	INCORP. DCN # 3 (REVISED MOTOR COOLING UNITS)

SCALE AS NOTED	DRAWING NO.	REV.
JOB NO. 9510	1X4DJ123	10

ISOILING RULES

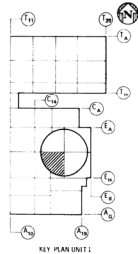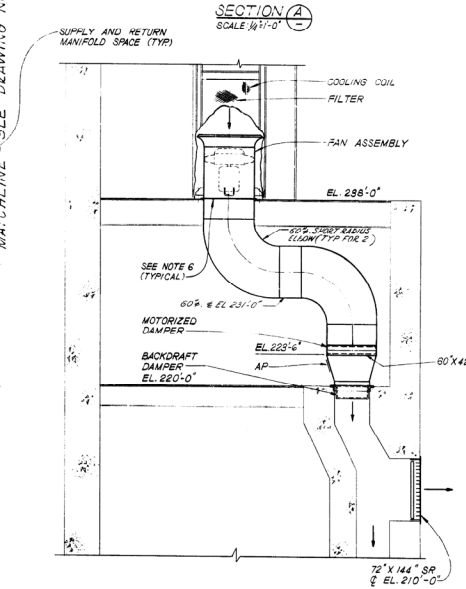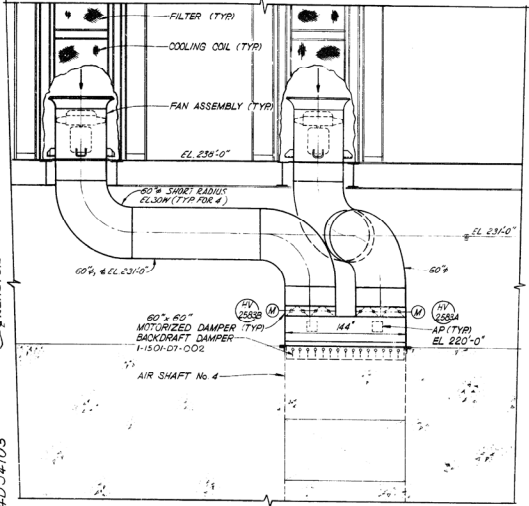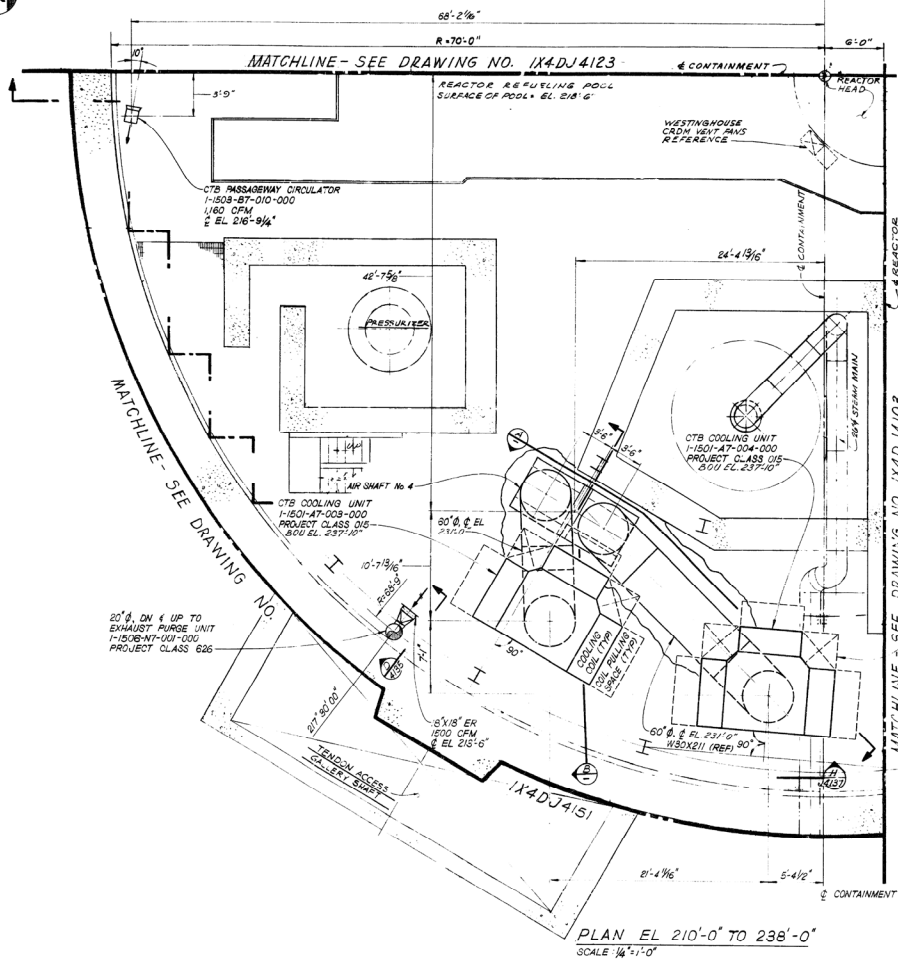

**NOTES:**

- FOR GENERAL NOTES AND LEGEND SEE DWG AX40J001 AND AX40J002
- FOR AREA ABOVE SEE DWG IX4DJ4132
- FOR AREA BELOW SEE DWG IX4DJ4135
- ALL DUCTWORK SHOWN IS PROJECT CLASS 015 UNLESS OTHERWISE NOTED
- FLOW TRANSMITTER LOCATION, SEE CONTROL LOG, DRAWING IX4DJ2103
- DUCTWORK SHALL BE BOLTED TO THE BOTTOM OF SYSTEM I-1501-A7-003-000 & 004-000 UNITS. BOLT PATTERN TO CONFORM TO DWG AX40J67001 REQUIREMENTS.

REFERENCE DRAWINGS



- PAID: IX4DB6/E, 219 & 251
- CIVIL: IX2D48/AD/B
- STRUCTURAL: IX2D48/1/E, 211/3
- ARCHITECTURAL: IX4DL4002, D03
- PIPING: IX4DL4002, D03
- PLUMBING: IX4DL4002, D03
- ELECTRICAL: IX4DL4002, D03
- DUCT SUPPLY: IX4DL4002, D03

412/1018067A  
ACTIVITY PACKAGE NO. 412/101116A

**BECHTEL**  
LOS ANGELES  
**GEORGIA POWER COMPANY**  
ALVIN W. VOGTLE NUCLEAR PLANT

CONTAINMENT BLDG  
AREA 4D LEVEL 1  
PLAN EL. 210'-0" TO 238'-0"

NO.	REVISIONS	DATE	DR.	CHK.	APP.	DATE	DR.	CHK.	APP.	NO.	REVISIONS	DATE	DR.	CHK.	APP.	NO.	REVISIONS	DATE	DR.	CHK.	APP.	NO.	REVISIONS	DATE	DR.	CHK.	APP.	NO.	REVISIONS	DATE	DR.	CHK.	APP.
1	ISSUED FOR CONSTRUCTION	11/14/68	...	...	...	11/14/68	...	...	...	1	ISSUED FOR CONSTRUCTION	11/14/68	...	...	...	1	ISSUED FOR CONSTRUCTION	11/14/68	...	...	...	1	ISSUED FOR CONSTRUCTION	11/14/68	...	...	...	1	ISSUED FOR CONSTRUCTION	11/14/68	...	...	...

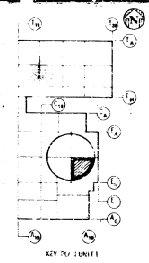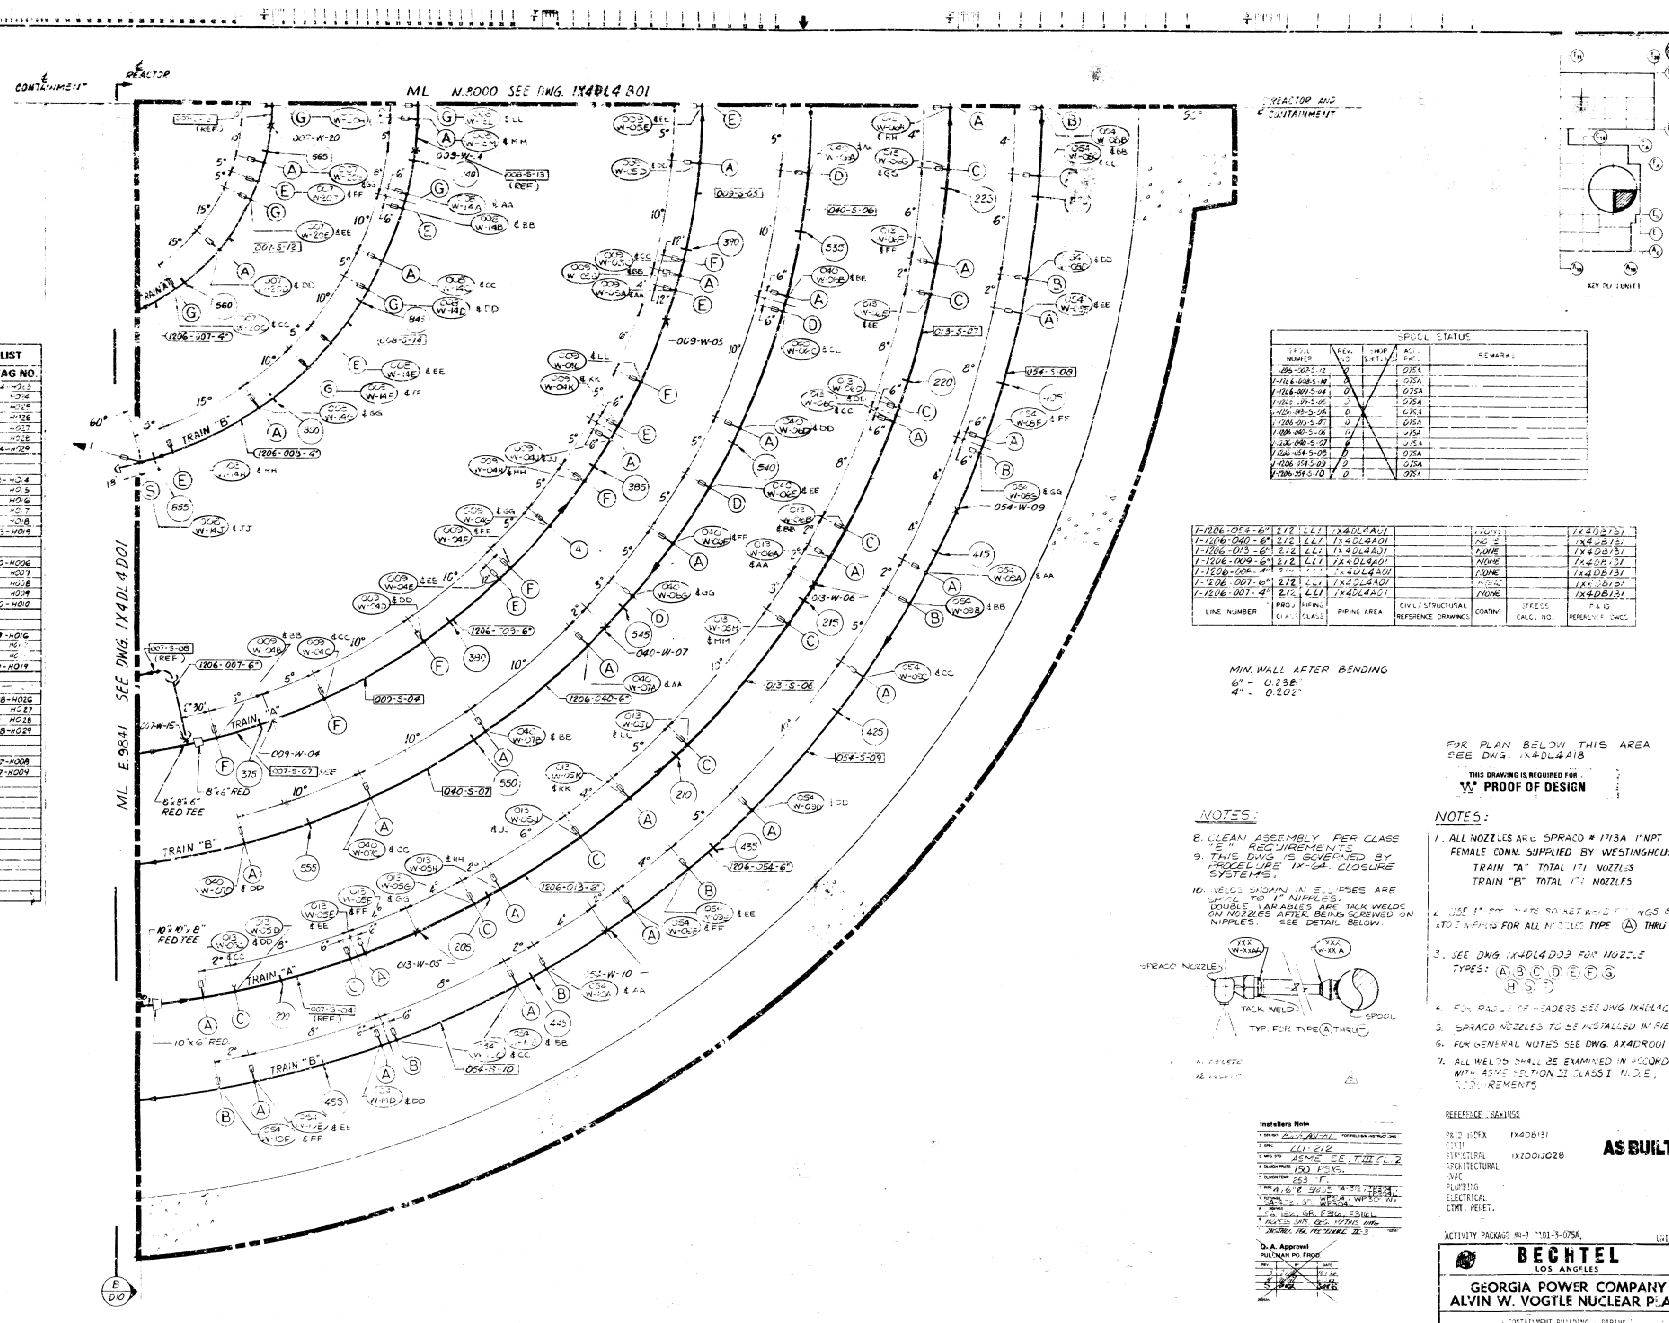

PIPE SUPPORT LIST	
PIPE SUPPORT TAG NO.	
195	VI-106-024-W02
205	VI-106-024-W03
415	VI-106-024-W04
425	VI-106-024-W05
435	VI-106-024-W06
445	VI-106-024-W07
455	VI-106-024-W08
200	VI-106-024-W09
209	VI-106-024-W10
217	VI-106-024-W11
225	VI-106-024-W12
335	VI-106-024-W13
338	VI-106-024-W14
342	VI-106-024-W15
349	VI-106-024-W16
350	VI-106-024-W17
352	VI-106-024-W18
353	VI-106-024-W19
190	VI-106-024-W20
189	VI-106-024-W21
187	VI-106-024-W22
186	VI-106-024-W23
240	VI-106-024-W24
242	VI-106-024-W25
243	VI-106-024-W26
244	VI-106-024-W27
245	VI-106-024-W28
246	VI-106-024-W29
247	VI-106-024-W30
248	VI-106-024-W31
249	VI-106-024-W32
250	VI-106-024-W33
251	VI-106-024-W34
252	VI-106-024-W35

SPOOL STATUS			REMARKS
PIPE NO.	WELD	PIPE	
1050-S-01	D		
1050-S-02	D		
1050-S-03	D		
1050-S-04	D		
1050-S-05	D		
1050-S-06	D		
1050-S-07	D		
1050-S-08	D		
1050-S-09	D		
1050-S-10	D		
1050-S-11	D		
1050-S-12	D		


LINE NUMBER	CLAS	PIPE AREA	REF. DRAWING	ORIGIN	DATE
1050-S-01					
1050-S-02					
1050-S-03					
1050-S-04					
1050-S-05					
1050-S-06					
1050-S-07					
1050-S-08					
1050-S-09					
1050-S-10					
1050-S-11					
1050-S-12					

MIN. WALL AFTER BENDING  
 6" - 0.136"  
 4" - 0.202"

FOR PLAN BELOW THIS AREA  
 SEE DWG. 1X4DL4 B18  
 THIS DRAWING IS REQUIRED FOR  
**PROOF OF DESIGN**

**NOTES:**

- 8. CLEAN ASSEMBLY PER CLASS 2 E REQUIREMENTS.
- 9. THIS DWG IS GOVERNED BY PIPELINE N-Closure SYSTEMS.
- 10. NEDS DOWN N-CLOSURE ARE TO BE DOUBLE WELDED AND WACK WELDS ON NOZZLES AFTER BEING SCREWED ON NIPPLES. SEE DETAIL BELOW.

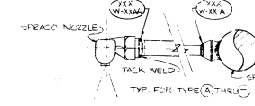

**NOTES:**

- 1. ALL NOZZLES ARE SPRACO # 113A 1/2" FEMALE CONN. SUPPLIED BY WESTINGHOUSE. TRAIN "A" TOTAL 171 NOZZLES. TRAIN "B" TOTAL 171 NOZZLES.
- 2. USE 1/2" WACK WELDS FOR ALL NIPPLE TYPE (A) THRU (C).
- 3. SEE DWG 1X4DL4 B03 FOR NOZZLE TYPES: (A) (B) (C) (D) (E) (F) (G) (H) (I) (J) (K) (L) (M) (N) (O) (P) (Q) (R) (S) (T) (U) (V) (W) (X) (Y) (Z) (AA) (AB) (AC) (AD) (AE) (AF) (AG) (AH) (AI) (AJ) (AK) (AL) (AM) (AN) (AO) (AP) (AQ) (AR) (AS) (AT) (AU) (AV) (AW) (AX) (AY) (AZ) (BA) (BB) (BC) (BD) (BE) (BF) (BG) (BH) (BI) (BJ) (BK) (BL) (BM) (BN) (BO) (BP) (BQ) (BR) (BS) (BT) (BU) (BV) (BW) (BX) (BY) (BZ) (CA) (CB) (CC) (CD) (CE) (CF) (CG) (CH) (CI) (CJ) (CK) (CL) (CM) (CN) (CO) (CP) (CQ) (CR) (CS) (CT) (CU) (CV) (CW) (CX) (CY) (CZ) (DA) (DB) (DC) (DD) (DE) (DF) (DG) (DH) (DI) (DJ) (DK) (DL) (DM) (DN) (DO) (DP) (DQ) (DR) (DS) (DT) (DU) (DV) (DW) (DX) (DY) (DZ) (EA) (EB) (EC) (ED) (EE) (EF) (EG) (EH) (EI) (EJ) (EK) (EL) (EM) (EN) (EO) (EP) (EQ) (ER) (ES) (ET) (EU) (EV) (EW) (EX) (EY) (EZ) (FA) (FB) (FC) (FD) (FE) (FF) (FG) (FH) (FI) (FJ) (FK) (FL) (FM) (FN) (FO) (FP) (FQ) (FR) (FS) (FT) (FU) (FV) (FW) (FX) (FY) (FZ) (GA) (GB) (GC) (GD) (GE) (GF) (GG) (GH) (GI) (GJ) (GK) (GL) (GM) (GN) (GO) (GP) (GQ) (GR) (GS) (GT) (GU) (GV) (GW) (GX) (GY) (GZ) (HA) (HB) (HC) (HD) (HE) (HF) (HG) (HH) (HI) (HJ) (HK) (HL) (HM) (HN) (HO) (HP) (HQ) (HR) (HS) (HT) (HU) (HV) (HW) (HX) (HY) (HZ) (IA) (IB) (IC) (ID) (IE) (IF) (IG) (IH) (II) (IJ) (IK) (IL) (IM) (IN) (IO) (IP) (IQ) (IR) (IS) (IT) (IU) (IV) (IW) (IX) (IY) (IZ) (JA) (JB) (JC) (JD) (JE) (JF) (JG) (JH) (JI) (JJ) (JK) (JL) (JM) (JN) (JO) (JP) (JQ) (JR) (JS) (JT) (JU) (JV) (JW) (JX) (JY) (JZ) (KA) (KB) (KC) (KD) (KE) (KF) (KG) (KH) (KI) (KJ) (KK) (KL) (KM) (KN) (KO) (KP) (KQ) (KR) (KS) (KT) (KU) (KV) (KW) (KX) (KY) (KZ) (LA) (LB) (LC) (LD) (LE) (LF) (LG) (LH) (LI) (LJ) (LK) (LL) (LM) (LN) (LO) (LP) (LQ) (LR) (LS) (LT) (LU) (LV) (LW) (LX) (LY) (LZ) (MA) (MB) (MC) (MD) (ME) (MF) (MG) (MH) (MI) (MJ) (MK) (ML) (MN) (MO) (MP) (MQ) (MR) (MS) (MT) (MU) (MV) (MW) (MX) (MY) (MZ) (NA) (NB) (NC) (ND) (NE) (NF) (NG) (NH) (NI) (NJ) (NK) (NL) (NM) (NO) (NP) (NQ) (NR) (NS) (NT) (NU) (NV) (NW) (NX) (NY) (NZ) (OA) (OB) (OC) (OD) (OE) (OF) (OG) (OH) (OI) (OJ) (OK) (OL) (OM) (ON) (OO) (OP) (OQ) (OR) (OS) (OT) (OU) (OV) (OW) (OX) (OY) (OZ) (PA) (PB) (PC) (PD) (PE) (PF) (PG) (PH) (PI) (PJ) (PK) (PL) (PM) (PN) (PO) (PP) (PQ) (PR) (PS) (PT) (PU) (PV) (PW) (PX) (PY) (PZ) (QA) (QB) (QC) (QD) (QE) (QF) (QG) (QH) (QI) (QJ) (QK) (QL) (QM) (QN) (QO) (QP) (QQ) (QR) (QS) (QT) (QU) (QV) (QW) (QX) (QY) (QZ) (RA) (RB) (RC) (RD) (RE) (RF) (RG) (RH) (RI) (RJ) (RK) (RL) (RM) (RN) (RO) (RP) (RQ) (RR) (RS) (RT) (RU) (RV) (RW) (RX) (RY) (RZ) (SA) (SB) (SC) (SD) (SE) (SF) (SG) (SH) (SI) (SJ) (SK) (SL) (SM) (SN) (SO) (SP) (SQ) (SR) (SS) (ST) (SU) (SV) (SW) (SX) (SY) (SZ) (TA) (TB) (TC) (TD) (TE) (TF) (TG) (TH) (TI) (TJ) (TK) (TL) (TM) (TN) (TO) (TP) (TQ) (TR) (TS) (TT) (TU) (TV) (TW) (TX) (TY) (TZ) (UA) (UB) (UC) (UD) (UE) (UF) (UG) (UH) (UI) (UJ) (UK) (UL) (UM) (UN) (UO) (UP) (UQ) (UR) (US) (UT) (UU) (UV) (UW) (UX) (UY) (UZ) (VA) (VB) (VC) (VD) (VE) (VF) (VG) (VH) (VI) (VJ) (VK) (VL) (VM) (VN) (VO) (VP) (VQ) (VR) (VS) (VT) (VU) (VV) (VW) (VX) (VY) (VZ) (WA) (WB) (WC) (WD) (WE) (WF) (WG) (WH) (WI) (WJ) (WK) (WL) (WM) (WN) (WO) (WP) (WQ) (WR) (WS) (WT) (WU) (WV) (WW) (WX) (WY) (WZ) (XA) (XB) (XC) (XD) (XE) (XF) (XG) (XH) (XI) (XJ) (XK) (XL) (XM) (XN) (XO) (XP) (XQ) (XR) (XS) (XT) (XU) (XV) (XW) (XX) (XY) (XZ) (YA) (YB) (YC) (YD) (YE) (YF) (YG) (YH) (YI) (YJ) (YK) (YL) (YM) (YN) (YO) (YP) (YQ) (YR) (YS) (YT) (YU) (YV) (YW) (YX) (YY) (YZ) (ZA) (ZB) (ZC) (ZD) (ZE) (ZF) (ZG) (ZH) (ZI) (ZJ) (ZK) (ZL) (ZM) (ZN) (ZO) (ZP) (ZQ) (ZR) (ZS) (ZT) (ZU) (ZV) (ZW) (ZX) (ZY) (ZZ)

REFERENCE DESIGNS

1050-S-01	1050-S-02
1050-S-03	1050-S-04
1050-S-05	1050-S-06
1050-S-07	1050-S-08
1050-S-09	1050-S-10
1050-S-11	1050-S-12





**AS BUILT**

**BECHTEL**  
 LOS ANGELES  
**GEORGIA POWER COMPANY**  
 ALVIN W. VOGLE NUCLEAR PLANT  
 CONTAINMENT BUILDING - PIPING  
 AREA 43 - LEVELS 4 & 5  
 PLAN - ELEV. 217' 8" ABOVE

NO.	DATE	DR.	CHK.	SUPV.	LOGS	CHK.	P.E.	SCALE	NO.	DATE	DR.	CHK.	SUPV.	LOGS	CHK.	P.E.	SCALE	NO.	

THIS DRAWING IS THE PROPERTY OF BECHTEL. IT IS TO BE USED ONLY FOR THE PROJECT AND SITE SPECIFICALLY IDENTIFIED. IT IS NOT TO BE REPRODUCED OR TRANSMITTED IN ANY FORM OR BY ANY MEANS, ELECTRONIC OR MECHANICAL, INCLUDING PHOTOCOPYING, RECORDING, OR BY ANY INFORMATION STORAGE AND RETRIEVAL SYSTEM, WITHOUT THE WRITTEN PERMISSION OF BECHTEL. THE USER ASSUMES ALL LIABILITY FOR THE USE OF THIS DRAWING. BECHTEL ASSUMES NO LIABILITY FOR THE USE OF THIS DRAWING.





Table with columns: PENETRATION NO., LINE NO., NOM. PIPE SIZE, PIPE SPEC., SYSTEM DESCRIPTION, TYPE, WALKWAY, INSPECTION, NORM. OPERATING, MAX. DESIGN, PIPE O.D., PIPE I.D., WALL THK., MATERIAL (A.S.M.E. SPEC. NO.), PENETRATION DIMENSIONS (INCHES), PENETRATION ASSEMBLY DIMENSIONS (INCHES), ELEVATION, MECH. DWG. NO., MECH. DWG. NO., RADIUS "R", and PENETRATION NO. Rows include various systems like CONTAINMENT HYDROGEN MONITOR, LOOP ACCUMULATOR, and BULK GASES SUPPLY SYSTEM.

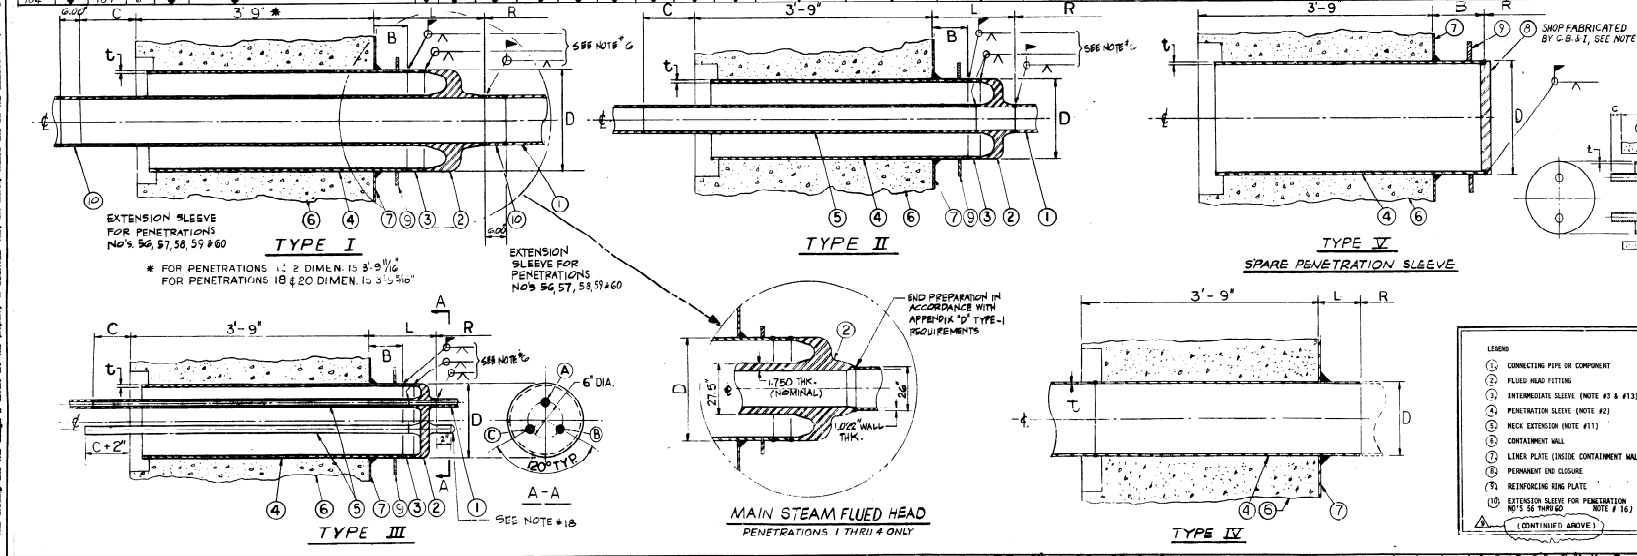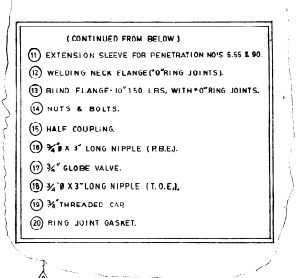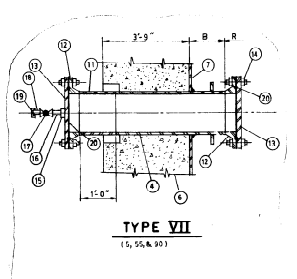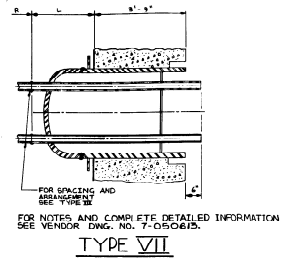

Legend table for diagram components:

1	CONNECTING PIPE OR COMPONENT
2	FLUED HEAD FITTING
3	INTERMEDIATE SLEEVE (NOTE #3 & #13)
4	PENETRATION SLEEVE (NOTE #2)
5	NECK EXTENSION (NOTE #11)
6	CONTAINMENT WALL
7	LINER PLATE (INSIDE CONTAINMENT WALL)
8	PERMANENT END CLOSURE
9	REINFORCING RING PLATE
10	EXTENSION SLEEVE FOR PENETRATION NO'S 55 THROUGH 60
11	EXTENSION SLEEVE FOR PENETRATION NO'S 56, 57, 58, 59, 60

Technical specifications and company information including: 'THIS DRAWING IS REQUIRED FOR PROOF OF DESIGN', 'BECHTEL LOS ANGELES', 'GEORGIA POWER COMPANY ALVIN V. VOGTLE NUCLEAR PLANT', 'CONTAINMENT BLDG. UNIT 1', 'CONTAINMENT WALL PIPING PENETRATION DESIGN LIST', and a legend for notes and references.

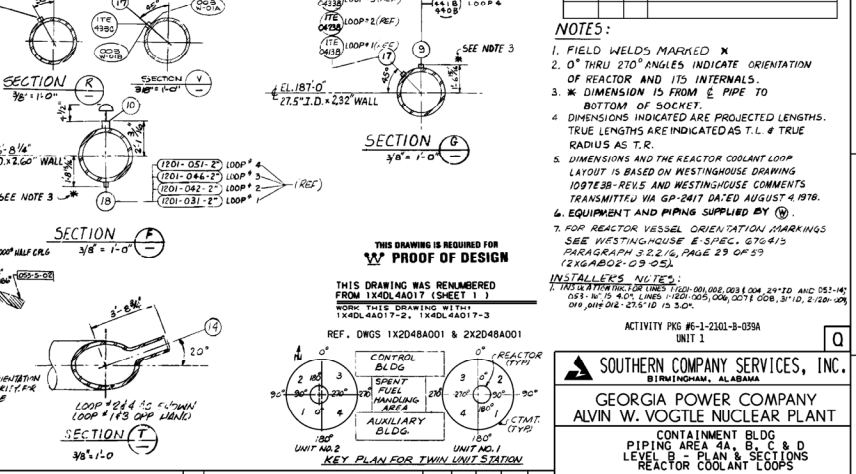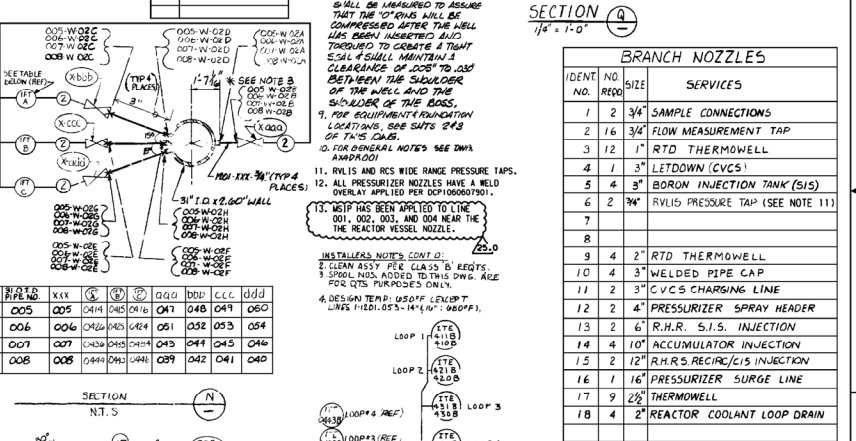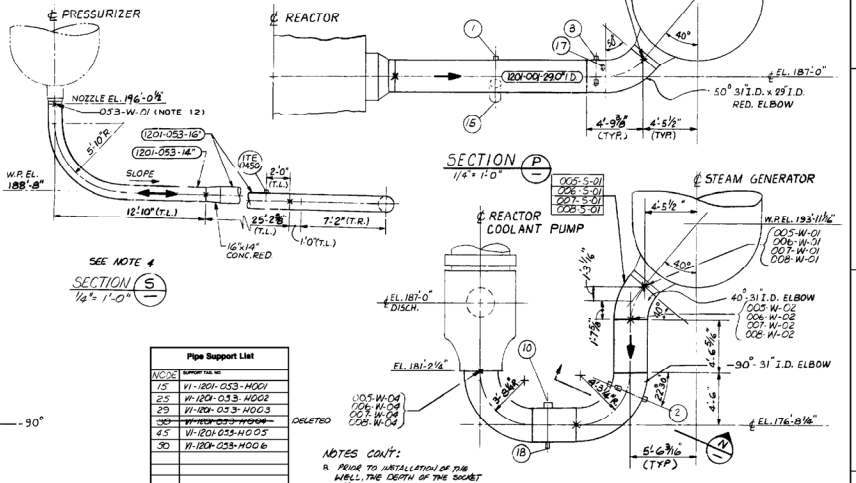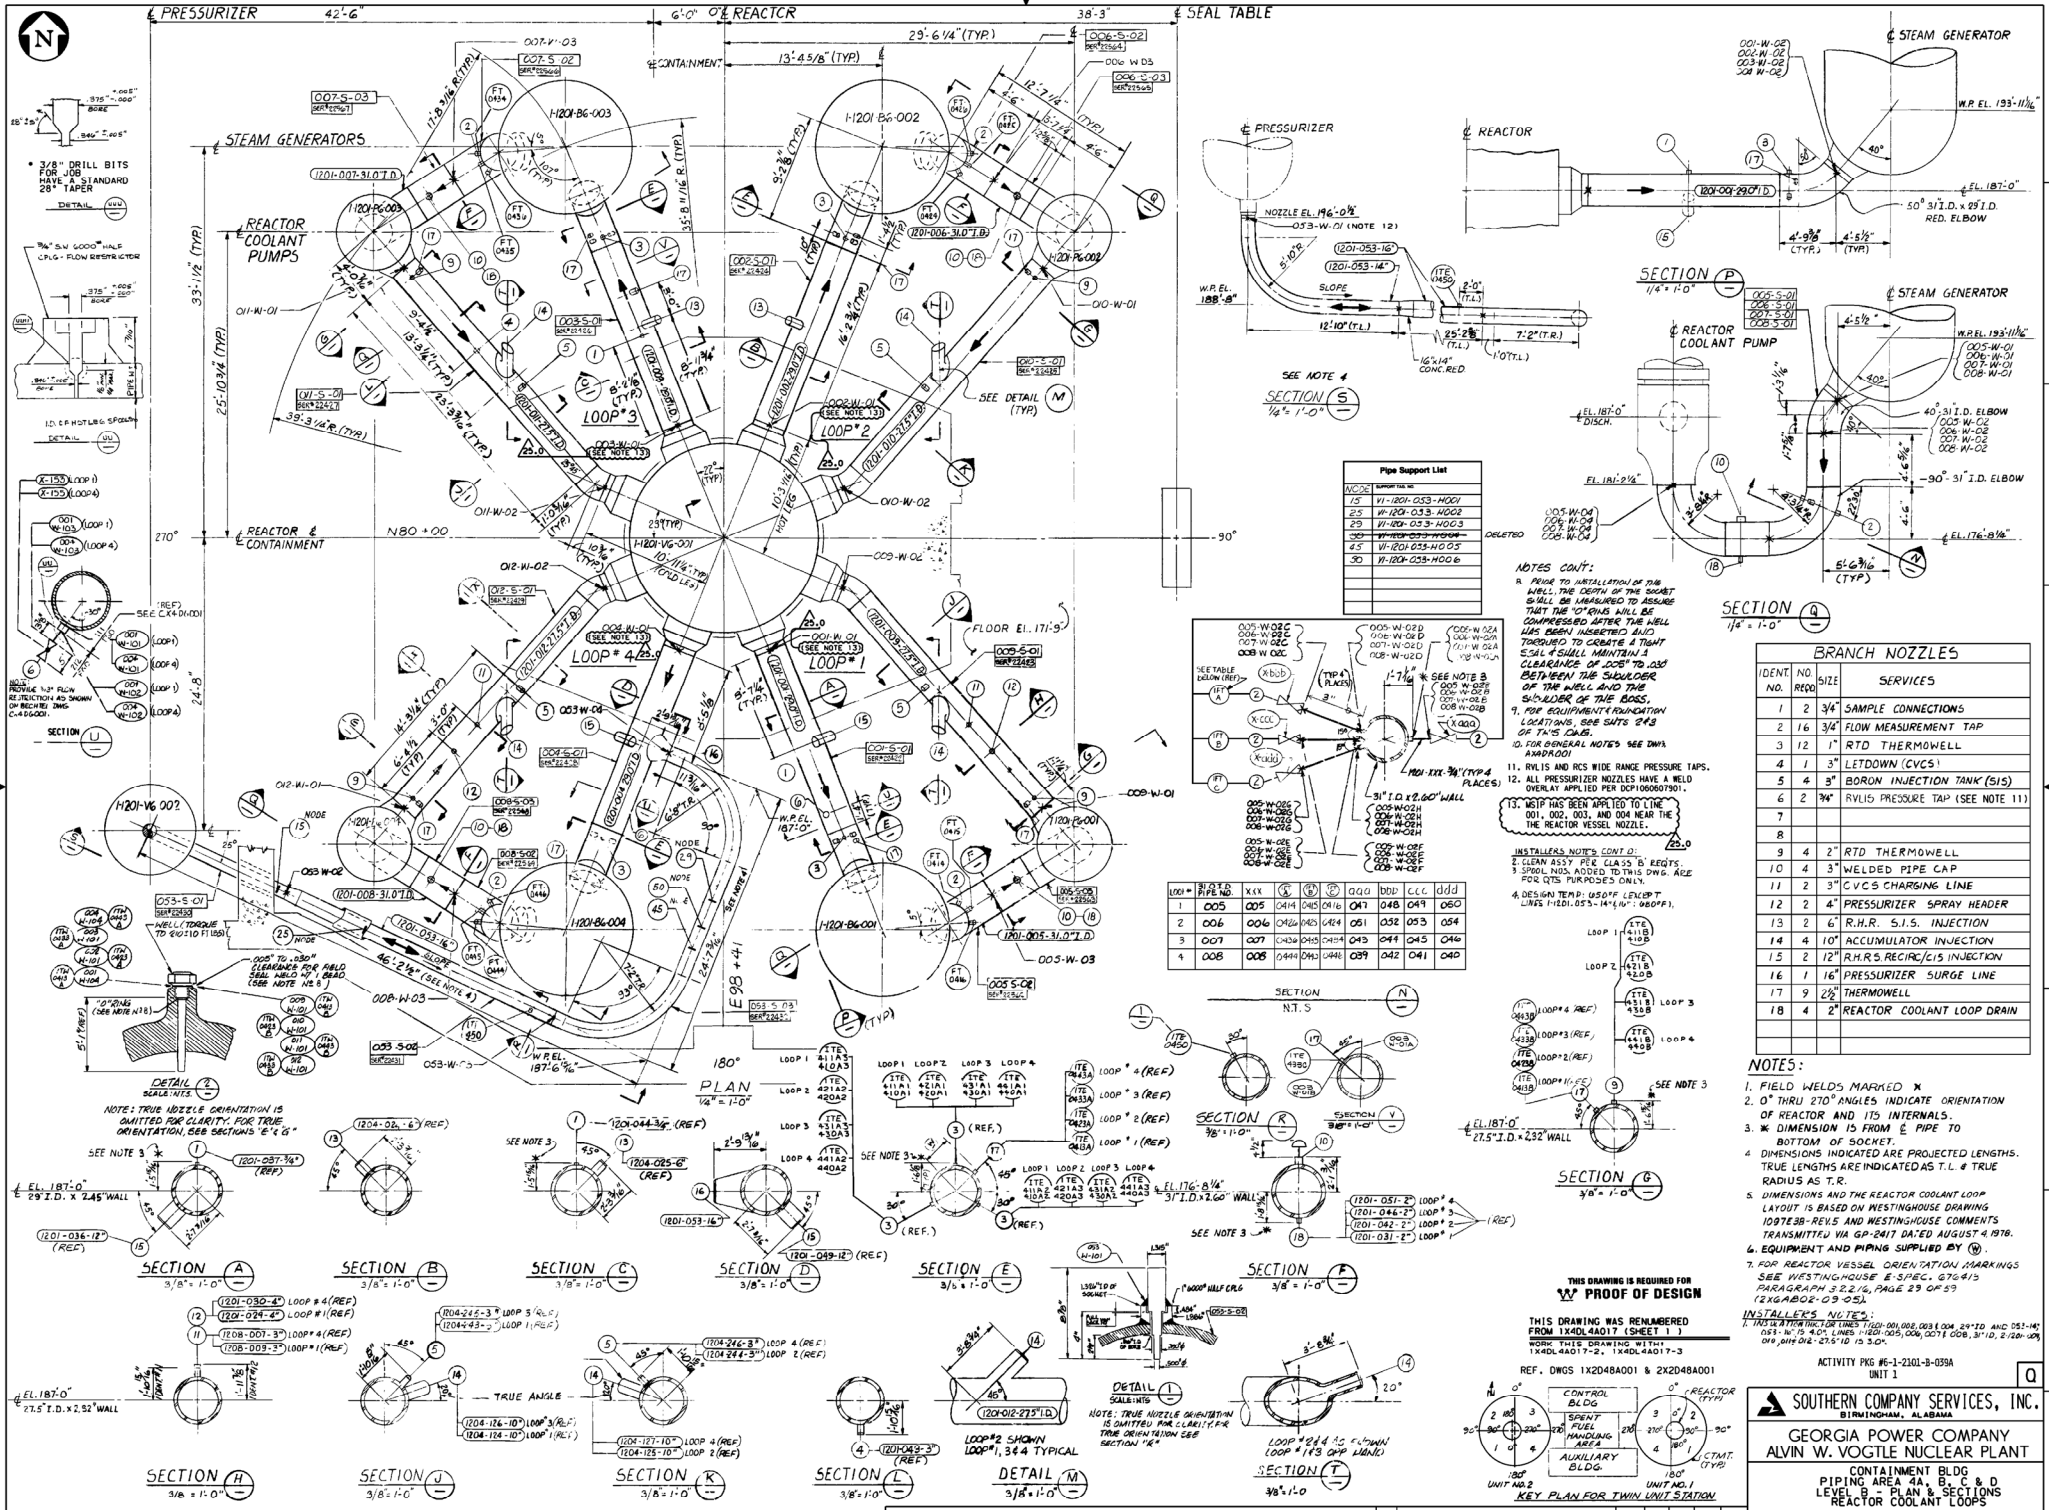

**Pipe Support List**

NO.	NOZZLE
15	VI-1201-033-H001
25	VI-1201-033-H002
29	VI-1201-033-H003
30	VI-1201-033-H005
30	VI-1201-033-H006

- NOTES CONT:**
8. PRIOR TO INSTALLATION OF THE WELL THE DEPTH OF THE SOCKET SHALL BE MEASURED TO ASSURE THAT THE JOINTS WILL BE COMPRESSED AFTER THE WELL HAS BEEN INSERTED AND TO CREATE A TIGHT SEAL. A SMALL MAINTAIN A CLEARANCE OF .005" TO .020" BETWEEN THE SHOULDER OF THE WELL AND THE SHOULDER OF THE BOSS.
  9. FOR EQUIPMENT FOUNDATION LOCATIONS, SEE SITS 248 OR 245 CASE.
  10. FOR GENERAL NOTES SEE DWG. A44001.
  11. RVLIS AND RCS WIDE RANGE PRESSURE TAPS.
  12. ALL PRESSURIZER NOZZLES HAVE A WELD OVERLAY APPLIED PER D070000007.
  13. WSP HAS BEEN APPLIED TO LINE 001, 002, 003, AND 004 NEAR THE REACTOR VESSEL NOZZLE.
- INSTALLER'S NOTE CONT. D:**
1. CLEAN ASSY PER CLASS B REGS
  2. SPECIAL WELD ADDED TO THIS DWG. AGE FOR QTS PURPOSES ONLY.
  3. DESIGN TEMP: USOFF ELERTB LINES 11201-033-14-16-17-2000(F).

**BRANCH NOZZLES**

IDENT NO.	NO. REQD.	SIZE	SERVICES
1	2	3/4"	SAMPLE CONNECTIONS
2	16	3/4"	FLD MEASUREMENT TAP
3	12	1"	RTD THERMOWELL
4	1	3"	LETDOWN (CVCS)
5	4	3"	BORON INJECTION TANK (SIS)
6	2	3/4"	RVLIS PRESSURE TAP (SEE NOTE 11)
7			
8			
9	4	2"	RTD THERMOWELL
10	4	3"	WELDED PIPE CAP
11	2	3"	CVCS CHARGING LINE
12	2	4"	PRESSURIZER SPRAY HEADER
13	2	6"	R.H.R. S.I.S. INJECTION
14	4	10"	ACCUMULATOR INJECTION
15	2	12"	R.H.R.S. REACTOR/EIS INJECTION
16	1	16"	PRESSURIZER SURGE LINE
17	9	2 1/2"	THERMOWELL
18	4	2"	REACTOR COOLANT LOOP DRAIN

- NOTES:**
1. FIELD WELDS MARKED X
  2. 0° THRU 270° ANGLES INDICATE ORIENTATION OF REACTOR AND ITS INTERNALS.
  3. W DIMENSIONS ARE 15 FROM E OF PIPE TO BOTTOM OF SOCKET.
  4. DIMENSIONS INDICATED ARE PROJECTED LENGTHS. TRUE LENGTHS ARE INDICATED AS T.L. & TRUE RADIUS AS T.R.
  5. DIMENSIONS AND THE REACTOR COOLANT LOOP LAYOUT IS BASED ON WESTINGHOUSE DRAWINGS 1007038-REVIS AND WESTINGHOUSE COMMENTS TRANSMITTED VIA GP-2417 DATED AUGUST 4, 1976.
  6. EQUIPMENT AND PIPING SUPPLIED BY (M).
  7. FOR REACTOR VESSEL ORIENTATION MARKINGS SEE WESTINGHOUSE E-SPEC. 070415 100406000-3 P.2-12, PAGE 29 OF 59 (2X4802-03-05)
  8. INSTALLER'S NOTES:
  9. THIS DRAWING CONTAINS THE FOLLOWING: 001, 002, 003, 999, 1000.


PLAN DIM. FROM REF. DWG. 1X4DL4A17

REACTOR COOLANT PUMP CASING ELEV. & LOC.						
STA	PLAN	LOOP 1	LOOP 2	LOOP 3	LOOP 4	
A	N/A	189-7.4500	189-7.4500	189-7.4500	189-7.4500	
A1	N/A	189-7.4500	189-7.4500	189-7.4500	189-7.4500	
B	N/A	189-7.4600	189-7.5144	189-7.7732	189-7.8002	
B1	N/A	189-6.9590	189-7.0032	189-7.1740	189-6.9042	
C	N/A	189-7.4490	189-7.5540	189-7.0340	189-7.3012	
C1	N/A	189-6.9390	189-7.0439	189-7.1290	189-6.7902	
NORTH		25.8274	-25.9010	+25.9190	+25.9074	
SOUTH						
EAST		28.5016	-25.4936	+26.4811	-29.5016	
WEST						
AZ		48-42-41	48-42-04	48-39-55	48-42-11	
FIELD BOOK		SC-40	SC-38	SC-36	SC-41	








+ NORTH / EAST FROM C R.V.  
- SOUTH / WEST FROM C R.V.

STEAM GENERATOR ELEV., LOC. PLUM.						
STA	PLAN	LOOP 1	LOOP 2	LOOP 3	LOOP 4	
A	N/A	195-6.0920	195-4.9442	195-6.0987	195-6.1277	
X	N/A	195-6.0992	195-4.9768	195-6.0956	195-6.0990	
Y	N/A	195-6.0992	195-4.9156	195-6.0956	195-4.7342	
Z	N/A	195-4.8432	195-4.8276	195-4.8238	195-4.5390	
W	N/A	195-4.8462	195-4.9106	195-4.8138	195-4.5450	
NORTH		33.125	-33.0512	+33.0143	-33.0817	
SOUTH						
EAST		13.3854	+13.5252	+13.4044	-13.4814	
WEST						
NORTH		0	-13/16"	+ 1/8"	0	
SOUTH						
EAST		0	0	-7/16"	-7/16"	
WEST						
AZ		22-00-11	197-44-41	22-09-42	937-30-37	
FIELD BOOK		SC-40	SC-38	SC-36	SC-38	

+ NORTH / EAST FROM C R.V.  
- SOUTH / WEST FROM C R.V.

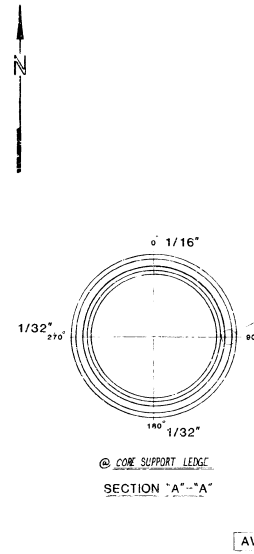


ELEVATIONS	
0	- 192 - 11.062
90	- 192 - 11.059
180	- 192 - 11.053
270	- 192 - 11.050
AVG. PLAN	- 152 - 11.0126

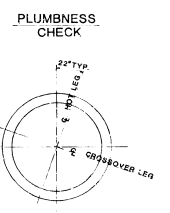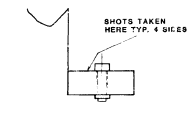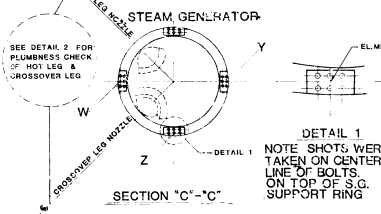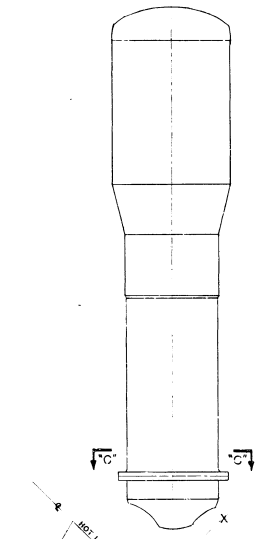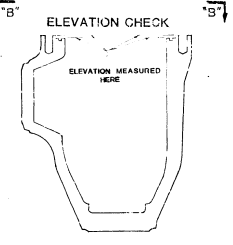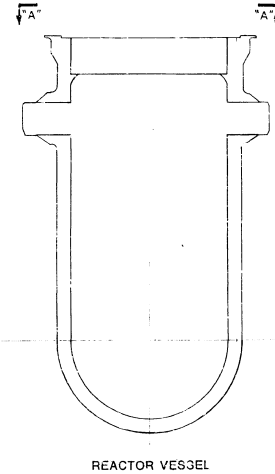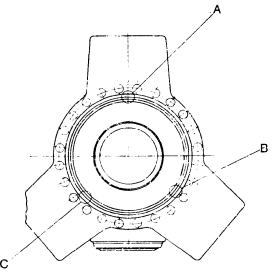

PLUMBNESS		
STA.	TOP	BOTTOM
"A"	4"	4 1/8"
"B"	4"	4 1/8"
ERROR WEST 1/8" SOUTH 1/8"		

PLAN	195 - 11.4998"
0"	195 - 11.5920"
90"	195 - 11.6350"
180"	195 - 11.6016"
270"	195 - 11.5302"

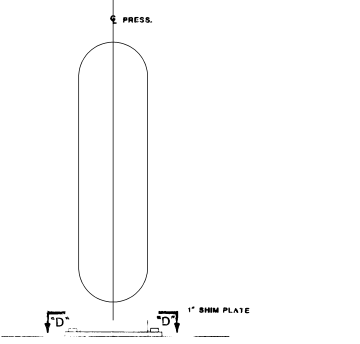

NOTES: 1) DETAIL 2 IS TYPICAL FOR ALL FOUR (4) STEAM GENERATOR  
2) DETAIL 3 IS TYPICAL FOR ALL FOUR (4) REACTOR COOLANT PUMP CASING

THIS DRAWING WAS RENUMBERED FROM 1X4DL4A017 (SHEET 2) WORK THIS DRAWING WITH PART 17-3



**SOUTHERN COMPANY SERVICES, INC.**  
BIRMINGHAM, ALABAMA

**GEORGIA POWER COMPANY**  
ALVIN W. VOGTLE NUCLEAR PLANT

CONTAINMENT BLDG  
PIPING AREA 4A, B, C & D  
LEVEL B - PLAN & SECTIONS  
REACTOR COOLANT LOOPS

NO.	REVISIONS	DATE	DR	CHK	APPV	DTL
1	INCORP PER ABN 38665	4-25-83	DFV	LRP	ASK	-
2						
3						



SCALE: NTS  
DRAWING NO. 1X4DL4A017-2  
JOB NO. 10604  
REV. 22

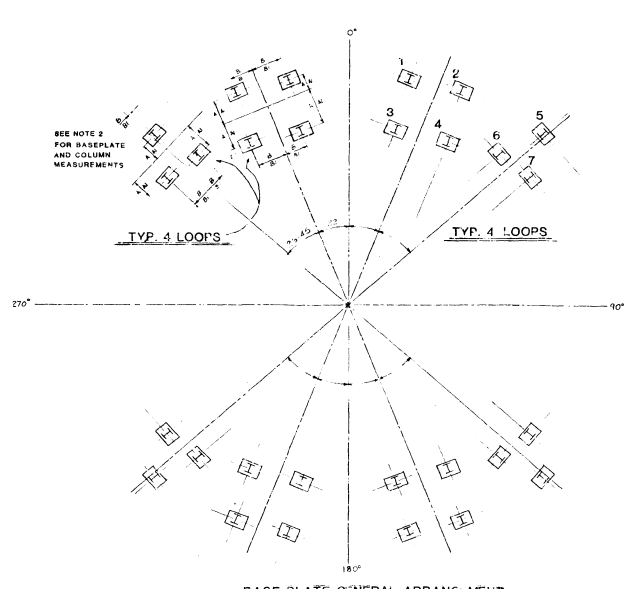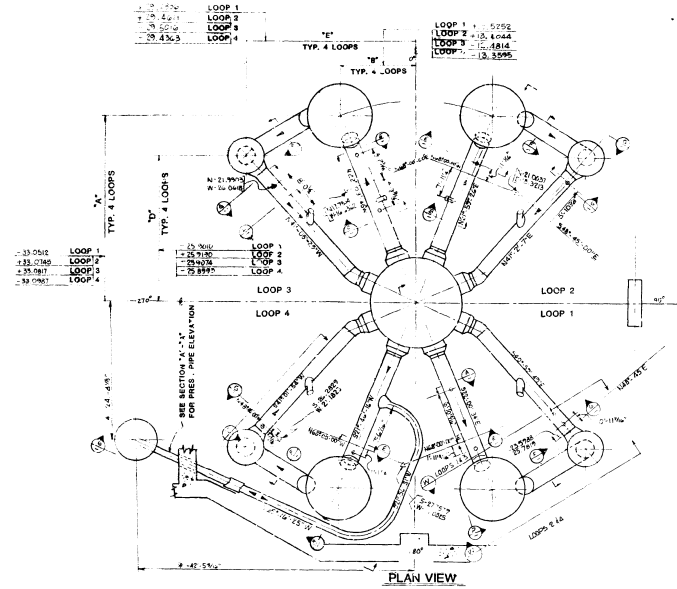

BASE PLATE GENERAL ARRANGEMENT  
FOR BASE PLATE DETAILS SEE DWGS 1185F12 & 1187F36

BASE PLATES LOCATION & EL.									
LOOP#	PLATE#	ACTUAL A'	PLAN A'	ACTUAL B'	PLAN B'	ACTUAL EL.	PLAN EL.	FIELD BOOK	
1	1	3'-0 1/2"	3'-0"	3'-0"	3'-0"	172.8400	172.8887	SC4-40	
1	2	3'-0 1/2"	3'-0"	3'-0"	3'-0"	172.8333			
1	3	3'-0 1/2"	3'-0"	3'-0"	3'-0"	172.8333			
1	4	3'-0 1/2"	3'-0"	3'-0"	3'-0"	172.8443			
1	5	3'-0 1/2"	3'-0"	3'-0"	3'-0"	172.8333			
1	6	3'-0 1/2"	3'-0"	3'-0"	3'-0"	172.8733			
1	7	3'-0 1/2"	3'-0"	3'-0"	3'-0"	172.8733			
1	8	3'-0 1/2"	3'-0"	3'-0"	3'-0"	172.8733			
2	1	3'-0 1/2"	3'-0"	3'-0"	3'-0"	172.8400		SC1-38	
2	2	3'-0 1/2"	3'-0"	3'-0"	3'-0"	172.8400			
2	3	3'-0 1/2"	3'-0"	3'-0"	3'-0"	172.8400			
2	4	3'-0 1/2"	3'-0"	3'-0"	3'-0"	172.8400			
2	5	3'-0 1/2"	3'-0"	3'-0"	3'-0"	172.8400			
2	6	3'-0 1/2"	3'-0"	3'-0"	3'-0"	172.8400			
2	7	3'-0 1/2"	3'-0"	3'-0"	3'-0"	172.8400			
2	8	3'-0 1/2"	3'-0"	3'-0"	3'-0"	172.8400			
3	1	3'-0 1/2"	3'-0"	3'-0"	3'-0"	172.8400			
3	2	3'-0 1/2"	3'-0"	3'-0"	3'-0"	172.8400			
3	3	3'-0 1/2"	3'-0"	3'-0"	3'-0"	172.8400			
3	4	3'-0 1/2"	3'-0"	3'-0"	3'-0"	172.8400			
3	5	3'-0 1/2"	3'-0"	3'-0"	3'-0"	172.8400			
3	6	3'-0 1/2"	3'-0"	3'-0"	3'-0"	172.8400			
3	7	3'-0 1/2"	3'-0"	3'-0"	3'-0"	172.8400			
3	8	3'-0 1/2"	3'-0"	3'-0"	3'-0"	172.8400			
4	1	3'-0 1/2"	3'-0"	3'-0"	3'-0"	172.8400		SC4-41	
4	2	3'-0 1/2"	3'-0"	3'-0"	3'-0"	172.8400			
4	3	3'-0 1/2"	3'-0"	3'-0"	3'-0"	172.8400			
4	4	3'-0 1/2"	3'-0"	3'-0"	3'-0"	172.8400			
4	5	3'-0 1/2"	3'-0"	3'-0"	3'-0"	172.8400			
4	6	3'-0 1/2"	3'-0"	3'-0"	3'-0"	172.8400			
4	7	3'-0 1/2"	3'-0"	3'-0"	3'-0"	172.8400			
4	8	3'-0 1/2"	3'-0"	3'-0"	3'-0"	172.8400			

SUPPORT COL'S - LOCATION & PLUMBNESS									
LOOP#	COL#	ACTUAL A1	PLAN A1	ACTUAL B1	PLAN B1	ACT. ELEV.	PLAN. ELEV.	FIELD BOOK	
1	1	3'-0 1/2"	3'-0"	3'-0"	3'-0"	172.8400	172.8887	SC4-40	
1	2	3'-0 1/2"	3'-0"	3'-0"	3'-0"	172.8333			
1	3	3'-0 1/2"	3'-0"	3'-0"	3'-0"	172.8333			
1	4	3'-0 1/2"	3'-0"	3'-0"	3'-0"	172.8443			
1	5	3'-0 1/2"	3'-0"	3'-0"	3'-0"	172.8333			
1	6	3'-0 1/2"	3'-0"	3'-0"	3'-0"	172.8733			
1	7	3'-0 1/2"	3'-0"	3'-0"	3'-0"	172.8733			
1	8	3'-0 1/2"	3'-0"	3'-0"	3'-0"	172.8733			
2	1	3'-0 1/2"	3'-0"	3'-0"	3'-0"	172.8400		SC1-38	
2	2	3'-0 1/2"	3'-0"	3'-0"	3'-0"	172.8400			
2	3	3'-0 1/2"	3'-0"	3'-0"	3'-0"	172.8400			
2	4	3'-0 1/2"	3'-0"	3'-0"	3'-0"	172.8400			
2	5	3'-0 1/2"	3'-0"	3'-0"	3'-0"	172.8400			
2	6	3'-0 1/2"	3'-0"	3'-0"	3'-0"	172.8400			
2	7	3'-0 1/2"	3'-0"	3'-0"	3'-0"	172.8400			
2	8	3'-0 1/2"	3'-0"	3'-0"	3'-0"	172.8400			
3	1	3'-0 1/2"	3'-0"	3'-0"	3'-0"	172.8400			
3	2	3'-0 1/2"	3'-0"	3'-0"	3'-0"	172.8400			
3	3	3'-0 1/2"	3'-0"	3'-0"	3'-0"	172.8400			
3	4	3'-0 1/2"	3'-0"	3'-0"	3'-0"	172.8400			
3	5	3'-0 1/2"	3'-0"	3'-0"	3'-0"	172.8400			
3	6	3'-0 1/2"	3'-0"	3'-0"	3'-0"	172.8400			
3	7	3'-0 1/2"	3'-0"	3'-0"	3'-0"	172.8400			
3	8	3'-0 1/2"	3'-0"	3'-0"	3'-0"	172.8400			
4	1	3'-0 1/2"	3'-0"	3'-0"	3'-0"	172.8400		SC4-41	
4	2	3'-0 1/2"	3'-0"	3'-0"	3'-0"	172.8400			
4	3	3'-0 1/2"	3'-0"	3'-0"	3'-0"	172.8400			
4	4	3'-0 1/2"	3'-0"	3'-0"	3'-0"	172.8400			
4	5	3'-0 1/2"	3'-0"	3'-0"	3'-0"	172.8400			
4	6	3'-0 1/2"	3'-0"	3'-0"	3'-0"	172.8400			
4	7	3'-0 1/2"	3'-0"	3'-0"	3'-0"	172.8400			
4	8	3'-0 1/2"	3'-0"	3'-0"	3'-0"	172.8400			

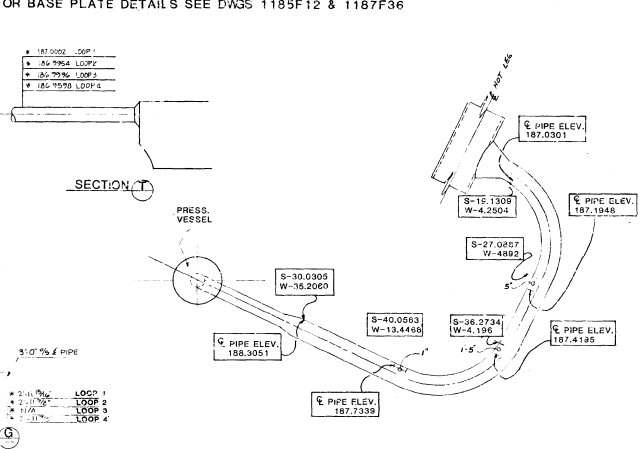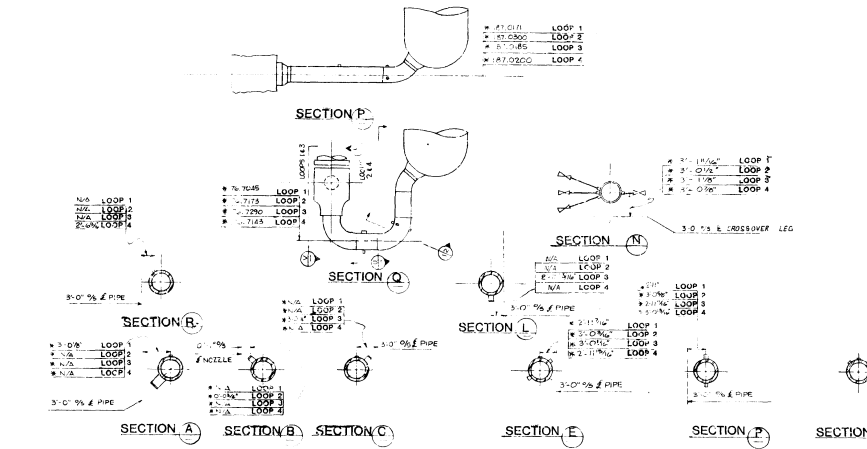

- NOTES:
1. DENOTES ABSOLUTE DIMENSION.
  2. A - MEASURED TO Q. BASE PLATE A1 - MEASURED TO Q. COL.
  3. ALL C L PIPE O.D.'S ARE FROM ACTUAL C L PIPE, NOT THEORETICAL.
  4. FROM VESSEL OR TOWARD VESSEL MEANS THE VESSEL THAT THE COLUMN'S ARE HOLDING UP.
  5. N/A - NOT APPLICABLE.
  6. O/S - OFF SET.

THIS DRAWING WAS RENUMBERED FROM 1X4DL4A017 (SHEET 3)  
WORK THIS DRAWING WITH 1X4DL4A017, 1X4DL4A018, 1X4DL4A019

**SOUTHERN COMPANY SERVICES, INC.**  
BIRMINGHAM, ALABAMA  
**GEORGIA POWER COMPANY**  
**ALVIN W. VOGTLE NUCLEAR PLANT**  
CONTAINMENT BLDG  
PIPING AREA 4A, B, C & D  
LEVEL B - PLAN & SECTIONS  
REACTOR COOLANT TANKS

NO.	INCORP PER ABN 38665	DATE	4-25-03	DFV	LRP	ASK	CHK	APPV	DTL	SCALE: NOTED	DRAWING NO.	REV.
	REVISIONS									JOB NO. 10604	1X4DL4A017-3	22
										SIZE E 30x44	LARGE BORE	CAD NAME 1X4DL4A017S

THIS DOCUMENT CONTAINS PROPRIETARY, CONFIDENTIAL, AND/OR TRADE SECRET INFORMATION OF THE SUBSIDIARIES OF THE SOUTHERN COMPANY OR OF THIRD PARTIES. IT IS INTENDED FOR USE ONLY BY EMPLOYEES OF, OR AUTHORIZED CONTRACTORS OF, THE SUBSIDIARIES OF THE SOUTHERN COMPANY. UNAUTHORIZED POSSESSION, USE, DISTRIBUTION, COPYING, DISSEMINATION, OR DISCLOSURE OF ANY PORTION HEREOF IS PROHIBITED.



SCALE: 3/8" = 1'-0"






PIPE SUPPORT LIST	
NODE	SUPP. TAG NO.
215	007-W-12
216	007-W-12
217	007-W-12
PIPE SUPPORT LIST	
NODE	SUPP. TAG NO.
231	007-W-12
232	007-W-12
233	007-W-12
234	007-W-12
235	007-W-12
236	007-W-12
237	007-W-12
238	007-W-12
239	007-W-12
240	007-W-12

SPOOL STATUS				
NO.	REV.	CHG.	ACT.	REMARKS
1206-007-04	1	02A		
1206-007-05	1	02A		
1206-007-06	1	02A		
1206-007-07	1	02A		
1206-007-08	1	02A		
1206-007-09	1	02A		
1206-007-10	1	02A		
1206-007-11	1	02A		
1206-007-12	1	02A		
1206-007-13	1	02A		
1206-007-14	1	02A		
1206-007-15	1	02A		
1206-007-16	1	02A		
1206-007-17	1	02A		
1206-007-18	1	02A		
1206-007-19	1	02A		
1206-007-20	1	02A		
1206-007-21	1	02A		
1206-007-22	1	02A		
1206-007-23	1	02A		
1206-007-24	1	02A		
1206-007-25	1	02A		

LINE NUMBER	CLASS	MARK	SPRING AREA	TYPE / FUNCTIONAL	REFERENCE DRAWING	COATING	DATE	EXTREME CASES
1206-007-01		1-12	L-L	1247-001	NONE		1247-001	
1206-007-02		1-12	L-L	1247-001	NONE		1247-001	
MIN. WALL AFTER BENDING  
 10" - 03/16"  
 8" - 02/16"  
 6" - 02/16"  
 4" - 02/16"  
 2" - 01/16"

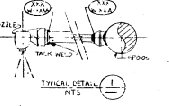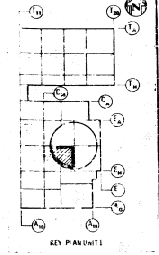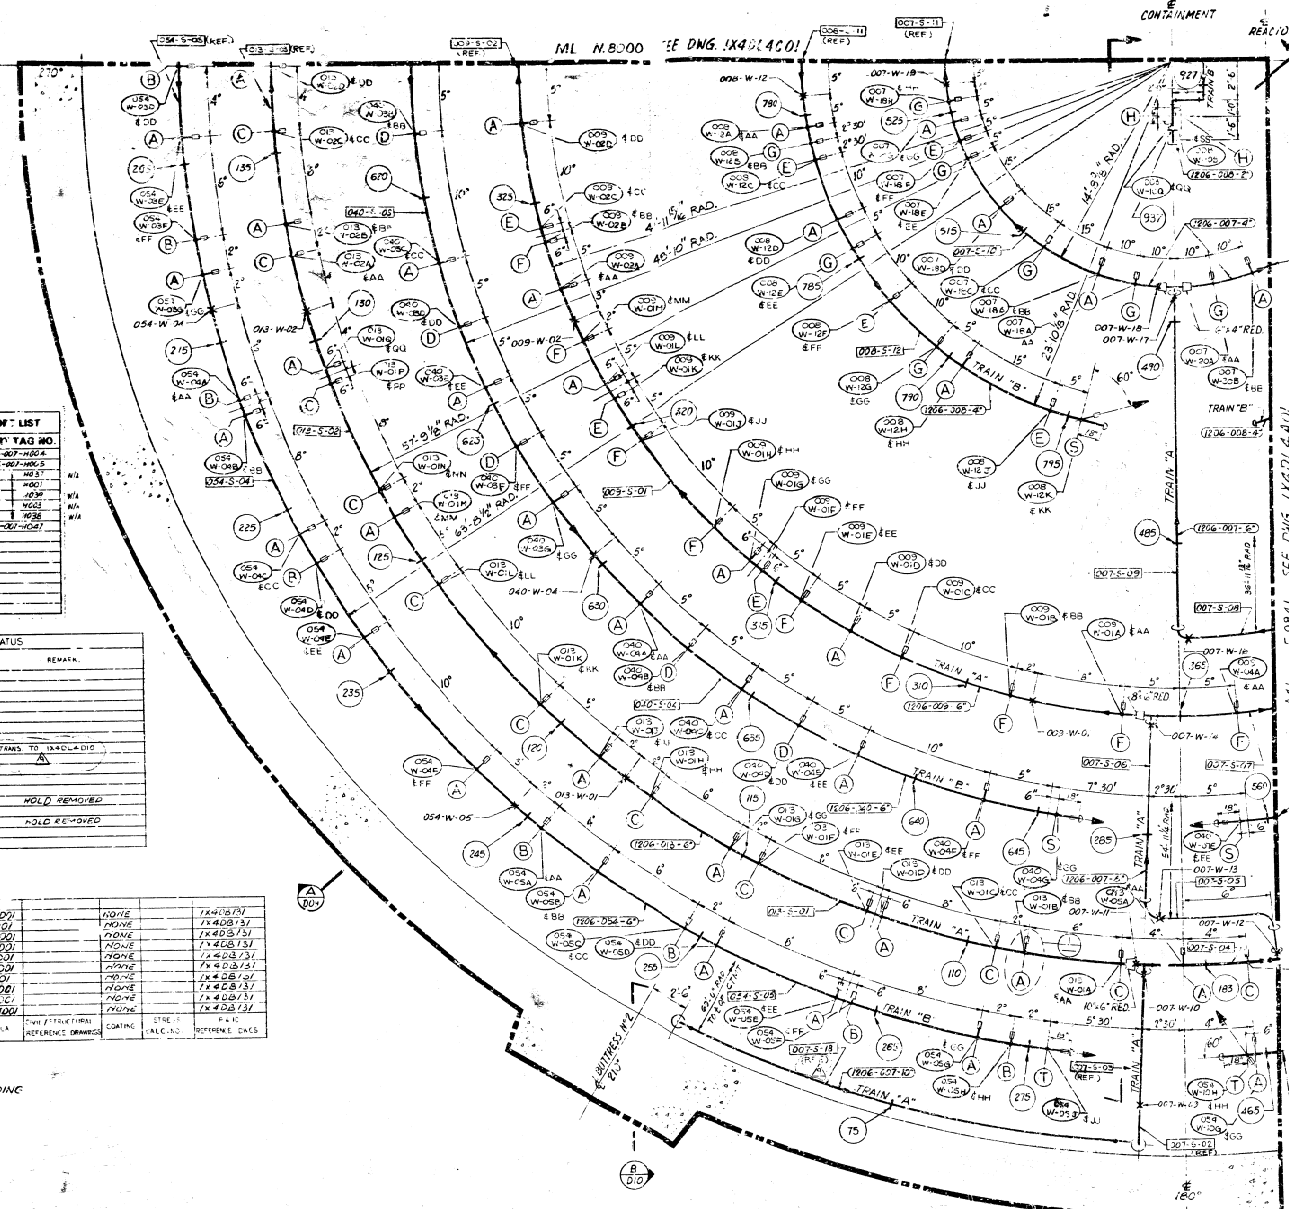

**AS BUILT**

45-DRAWING - 1206-008-2  
 1206-008-2 - SEE DWG. 1X4DL401  
 1206-008-3 - SEE DWG. 1X4DL401

THIS DRAWING IS REQUIRED FOR  
**W/ PROOF OF DESIGN**

FOR DETAIL & FIELD WELD NDS ON  
 LINE NO. 1206-008-2 SEE DWG. 1X4DL401  
 FOR NOTES - SEE DWG. 1X4DL401  
 FOR PLAN CHECK THIS AREA  
 SEE DWG. 1X4DL401

REFERENCE DIMENSIONS  
 P.D. - 1206-008-2  
 STRUCTURAL - 1206-008-2  
 MECHANICAL - 1206-008-2  
 PLUMBING - 1206-008-2  
 ELECTRICAL - 1206-008-2












DATE: 12/10/01  
**BECHTEL**  
 LOS ANGELES  
**GEORGIA POWER COMPANY**  
**ALVIN W. VOGTLE NUCLEAR PLANT**  
 CONTAINMENT BUILDING - PIPING  
 AREA NO. - LEVELS 4 & 5  
 PLAN - ELEV. 207'-0" & ABOVE

NO.	REVISIONS	DATE	DR.	CHK.	SUPV.	NO.	REVISIONS	DATE	DR.	CHK.	SUPV.	NO.	REVISIONS	DATE	DR.	CHK.	SUPV.	ENC. NO.	DATE	JOB NO. 941	DRAWING NO.	REV.	
1						1						2											
2						2						3											
3						3						4											
4						4						5											
5						5						6											
6						6						7											
7						7						8											



30X



This drawing and the design it covers are the property of BECTEL. They are hereby loaned and on the borrower's express agreement that they will not be reproduced, copied, loaned, sold, or used except in the limited way and under terms permitted by any written consent given by the lender to the borrower.

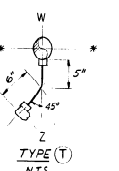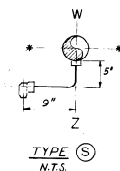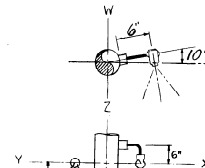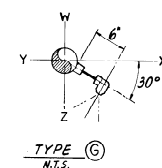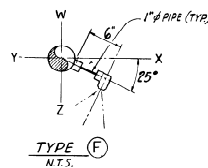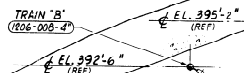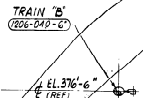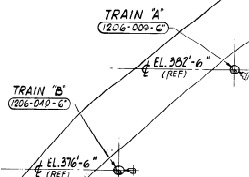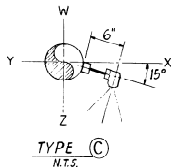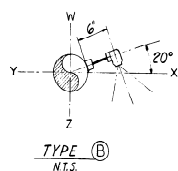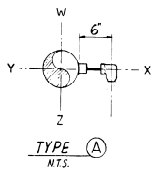

\* NOZZLE LOCATION TO X-Y AXIS IS INDICATED BY ARROW ON PLAN DWG'S.

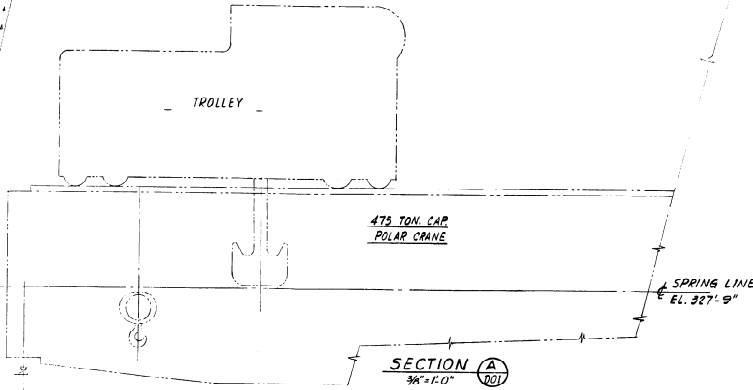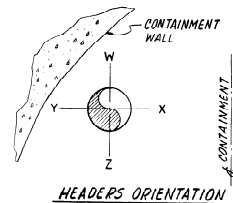

NO.	REVISIONS	DATE	DR.	CHK.	SUPV.	EGS	CHK.	PER.	SCALE	NO.	REVISIONS	DATE	DR.	CHK.	SUPV.	EGS	CHK.	PER.	SCALE	NO.	
1											1										
2											2										
3											3										
4											4										
5											5										
6											6										
7											7										
8											8										

THIS DRAWING IS REQUIRED FOR W PROOF OF DESIGN  
FOR NOTES SEE DWG. NO. IXADL4A01

ACTIVITY PACKAGE #1-1-2101-3-0754 UNIT 1

**BECTEL**  
LOS ANGELES

**GEORGIA POWER COMPANY**  
ALVIN W. VOGLE NUCLEAR PLANT

CONTAINMENT BUILDING - PIPING  
AREA A, B, C & D - LEVEL 5  
SECTION & DETAILS




SCALE: AS NOTED DRAWING NO. 1XADL4009 REV. 4

JOB NO. 9810

DATE: 11/22/72


SIZE: 11x14 LARGE BORE

G. A. APPROVAL  
FIELDMAN NO. 0000

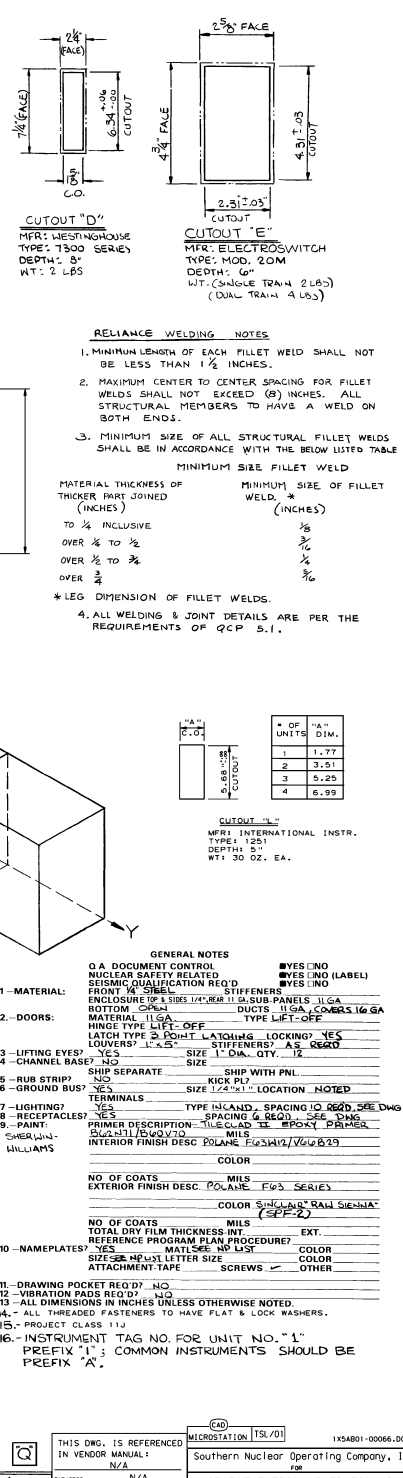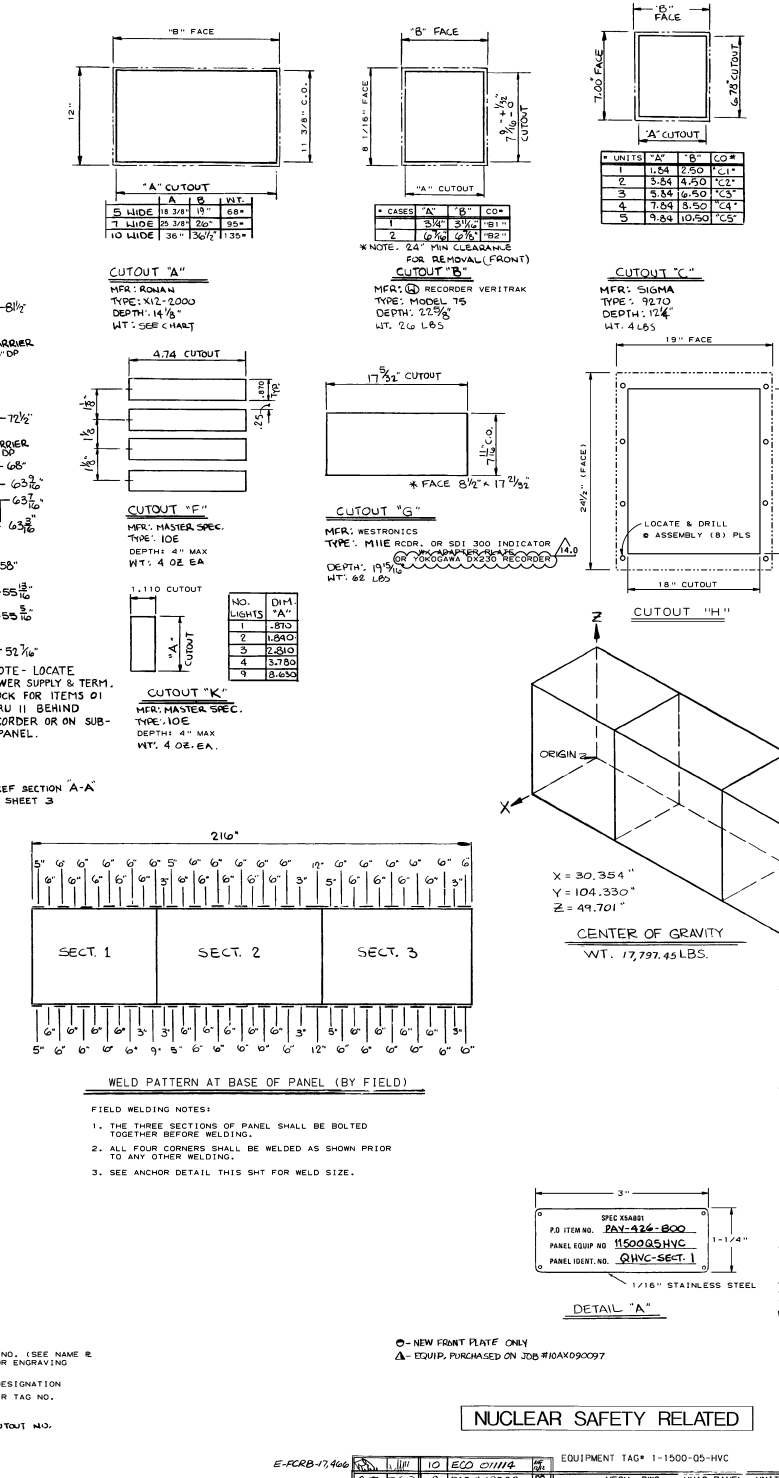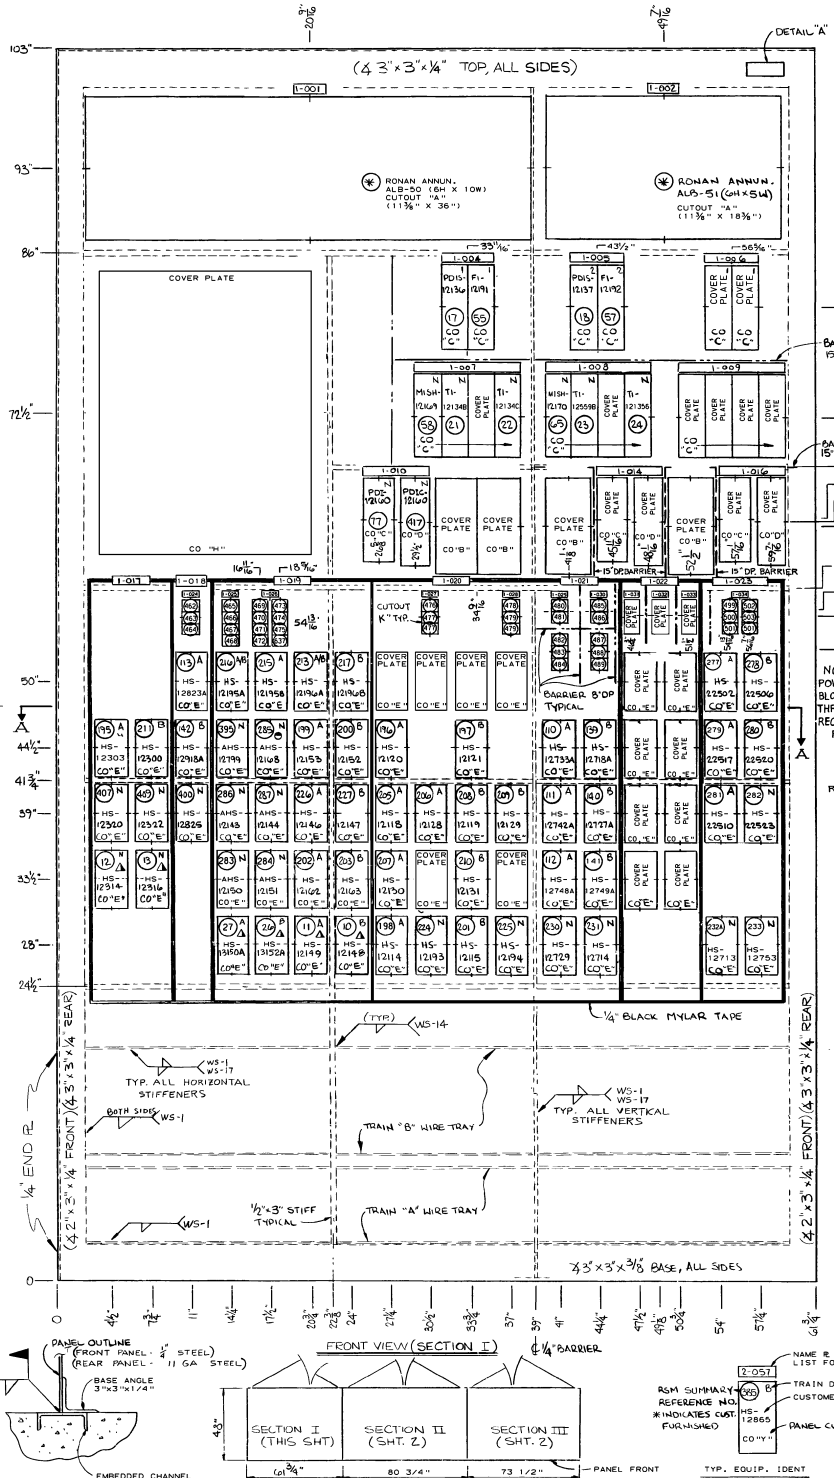


- ### RELIANCE WELDING NOTES
- MINIMUM LENGTH OF EACH FILLET WELD SHALL NOT BE LESS THAN 1 1/2 INCHES.
  - MAXIMUM CENTER TO CENTER SPACING FOR FILLET WELDS SHALL NOT EXCEED (8) INCHES. ALL STRUCTURAL MEMBERS TO HAVE A WELD ON BOTH ENDS.
  - MINIMUM SIZE OF ALL STRUCTURAL FILLET WELDS SHALL BE IN ACCORDANCE WITH THE BELOW LISTED TABLE
- | MATERIAL THICKNESS OF THICKER PART JOINED (INCHES) | MINIMUM SIZE OF FILLET WELD * (INCHES) |
|--|--|
| TO 1/4 INCLUSIVE                                   | 3/8                                    |
| OVER 1/4 TO 3/8                                    | 1/2                                    |
| OVER 3/8 TO 1/2                                    | 5/8                                    |
| OVER 1/2 TO 3/4                                    | 3/4                                    |
| OVER 3/4 TO 1                                      | 7/8                                    |
- \* LEG DIMENSION OF FILLET WELDS.  
 4. ALL WELDING & JOINT DETAILS ARE PER THE REQUIREMENTS OF QCP 5.1.


- NOTE - LOCATE POWER SUPPLY & TERM. BLOCK FOR ITEMS 01 THRU 11 BEHIND RECORDER OR ON SUB-PANEL.
- REF SECTION 'A-A' SHEET 3

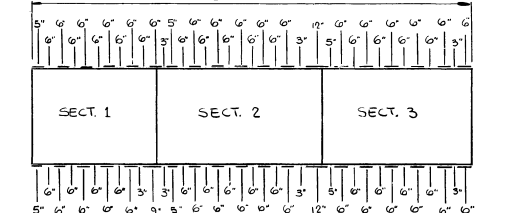

- ### WELD PATTERN AT BASE OF PANEL (BY FIELD)
- FIELD WELDING NOTES:
- THE THREE SECTIONS OF PANEL SHALL BE BOLTED TOGETHER BEFORE WELDING.
  - ALL FOUR CORNERS SHALL BE WELDED AS SHOWN PRIOR TO ANY OTHER WELDING.
  - SEE ANCHOR DETAIL THIS SHT FOR WELD SIZE.

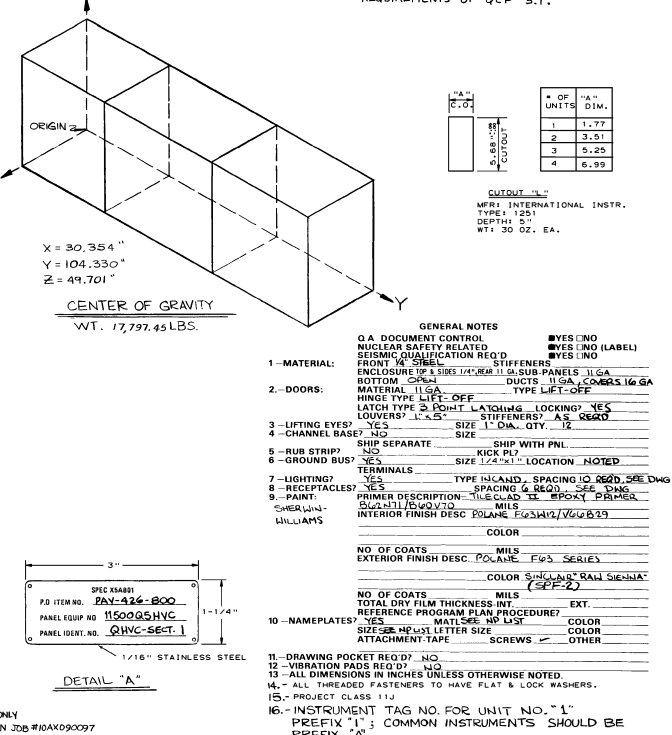

GENERAL NOTES		BY (SING)	DATE
0-A DOCUMENT CONTROL	NUCLEAR SAFETY RELATED	BYES (ING)	
1-MATERIAL:	FRONT 1/4\"/>		

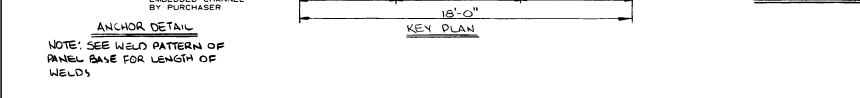



NOTE: SEE WELD PATTERN OF PANEL BASE FOR LENGTH OF WELDS

### NUCLEAR SAFETY RELATED

NO.	REV	DESCRIPTION	DATE	BY	CHKD	APPD
1	0	ISSUED FOR FABRICATION	11/05/10	JMR		
2	1	REVISED PER QCP 5.1	02/28/09	JMR		
3	2	REVISED PER QCP 5.1	02/28/09	JMR		

THIS DWG. IS REFERENCED IN VENDOR MANUAL:	N/A
FOR:	N/A
DATE:	N/A
REVISED BY:	SNC PER ABN 105252101J040.
BY:	CHKD APPR. TSL JMR

1X5AB01-00066.DWG  
 Southern Nuclear Operating Company, Inc.  
 VOGTE ELECTRIC GENERATING PLANT  
 UNIT NO. 1  
 MECH. DWG. HVAC PANEL  
 1-1500-05-HVC (SECTION 1)  
 VENDOR: RELIANCE ELEC. P.6-41 PAY-626  
 DRAWING NO. 1X5AB01-00066

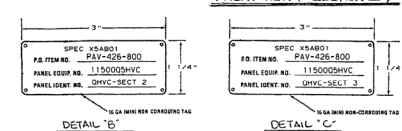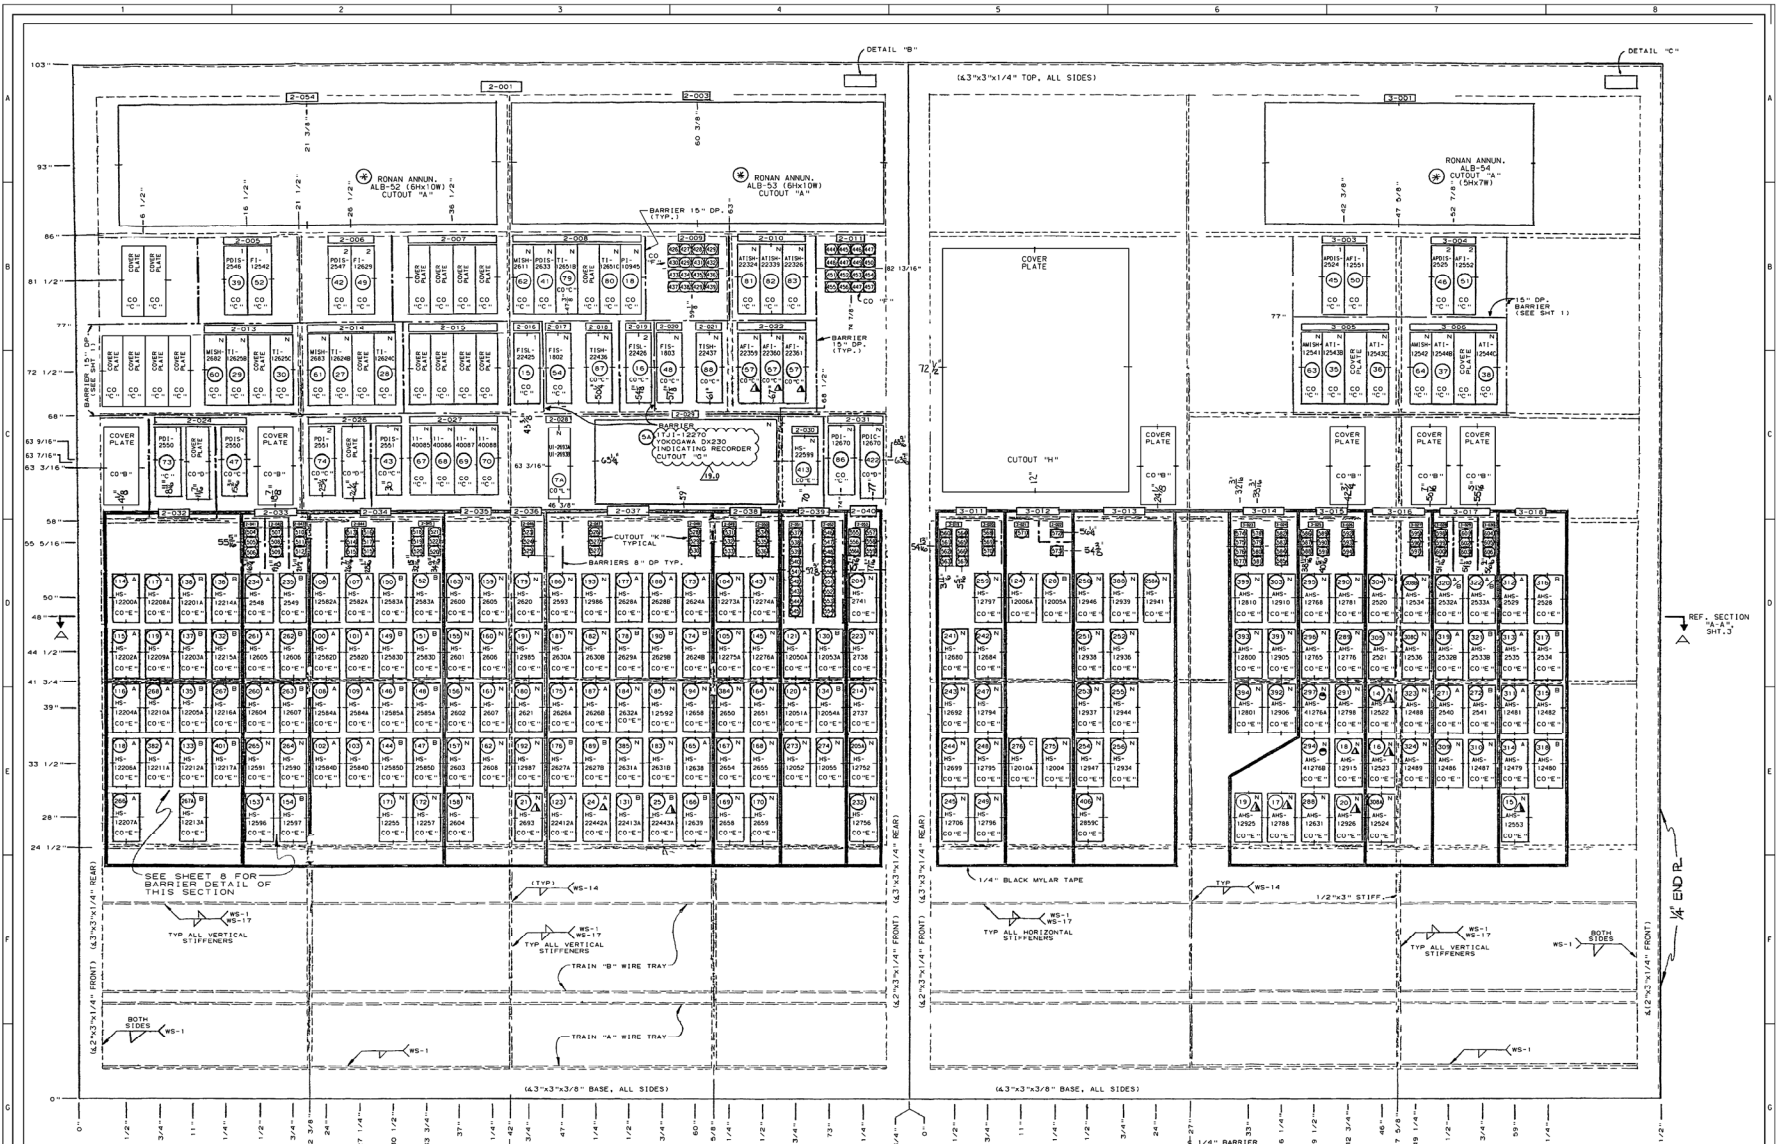

▲ EQUIP. PURCHASED ON JOB # 10A090097  
 ○ NEW FRONT PLATE ONLY

REVISIONS

NO.	DATE	DESCRIPTION
1	12/20/78	ISSUED FOR CONSTRUCTION
2	1/10/79	REVISED TO REFLECT CHANGES
3	2/15/79	REVISED TO REFLECT CHANGES
4	3/10/79	REVISED TO REFLECT CHANGES
5	4/15/79	REVISED TO REFLECT CHANGES
6	5/10/79	REVISED TO REFLECT CHANGES
7	6/15/79	REVISED TO REFLECT CHANGES
8	7/10/79	REVISED TO REFLECT CHANGES
9	8/15/79	REVISED TO REFLECT CHANGES
10	9/10/79	REVISED TO REFLECT CHANGES



**NUCLEAR SAFETY RELATED**

THIS Dwg. IS REFERENCED IN VENDOR MANUAL Southern Nuclear Operating Company, Inc. MICROSTATION [TSR/01] 1X5AB01-0007.DWG


MECH. DWG. - HVAC PANEL UNIT # 11500DHYVC  
 UNIT NO. 1

REVISIONS: DATE 01-28-09  
 REVISED BY SNC PER 4281 1002520101/04/1  
 VER. 1.0  
 E. J. S. JR. 11/18/78  
 RELIANCE CUSTOM CONTROLS ELECTRIC COMPANY  
 STONE MOUNTAIN, GEORGIA 30083

MECH. DWG. - HVAC PANEL UNIT NO. 1  
 1-1500-DHVC (SECTIONS 2 & 3)  
 P. 41 REV. 02  
 DRAWING NO. 1X5AB01-00067

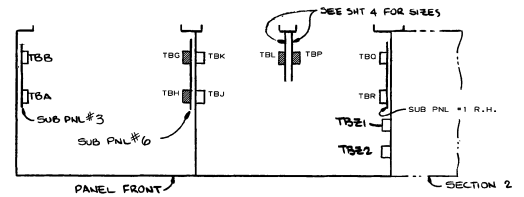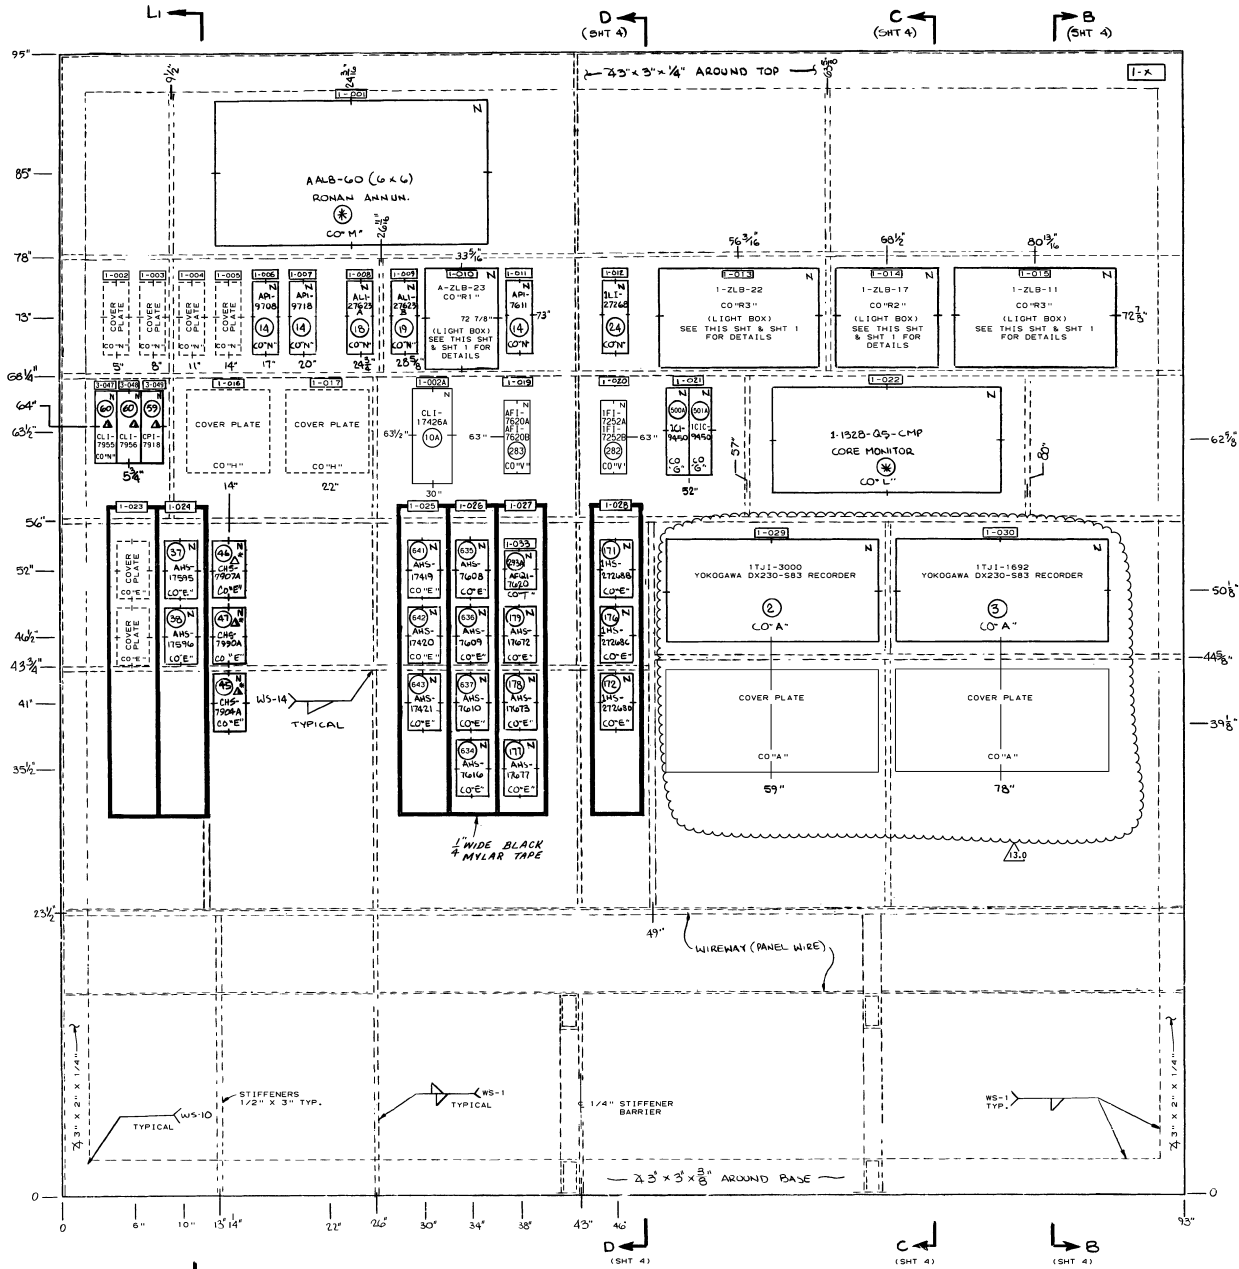

TOP VIEW TERMINAL BLOCK ARRANGEMENT  
(SEE SHT 11 FOR SUB PANEL DETAILS)

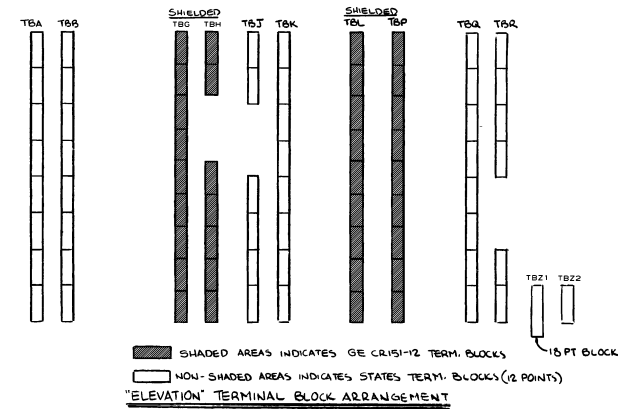

I-010 A-ZLB-23				I-013 1-ZLB-22			
579	578	576	578	563	564	565	566
601	576	578	578	569	570	571	572
603	576	578	578	573	574	575	576
605	576	578	578	575	576	577	578
576	578	578	578	579	580	581	582
576	578	578	578	583	584	585	586
576	578	578	578	587	588	589	590
576	578	578	578	591	592	593	594
576	578	578	578	595	596	597	598
576	578	578	578	599	600	601	602

I-014 1-ZLB-17				I-015 1-ZLB-11			
539	541	542	543	300	301	302	303
546	547	548	549	304	305	306	307
551	544	545	544	308	309	310	311
555	554	553	554	312	313	314	315
555	554	553	554	316	317	318	319
555	554	553	554	320	321	322	323
555	554	553	554	324	325	326	327
555	554	553	554	328	329	330	331
555	554	553	554	332	333	334	335
555	554	553	554	336	337	338	339
555	554	553	554	340	341	342	343
555	554	553	554	344	345	346	347
555	554	553	554	348	349	350	351
555	554	553	554	352	353	354	355
555	554	553	554	356	357	358	359
555	554	553	554	360	361	362	363

MASTER SPEC. LIGHTS ARRANGEMENT  
NOTES: NUMBER INSIDE SQUARE INDICATES RELIANCE'S ITEM NUMBER

\* REFER TO SUMMARY OF MATERIALS BM-10AX090097-A, BECHTEL LOG # 1X5AB01-1108

NUCLEAR SAFETY RELATED


REV	DATE	BY	DESCRIPTION
1	11/13/80	ECO 11530	ISSUE
2	11/12/80	ECO 01936	REVISED
3	11/11/80	ECO 12932	REVISED
4	11/11/80	ECO 12932	REVISED
5	11/11/80	ECO 12932	REVISED
6	11/11/80	ECO 12932	REVISED
7	11/11/80	ECO 12932	REVISED
8	11/11/80	ECO 12932	REVISED
9	11/11/80	ECO 12932	REVISED
10	11/11/80	ECO 12932	REVISED

MISCELLANEOUS SYSTEMS/EQUIPMENT  
PANEL(QPCP) SECTION 1, UNIT 1  
B. ALLEN  
32AX400924  
GEORGIA POWER CO.  
DATE 11/11/80  
APPROVAL

THIS DWG. IS REFERENCED IN VENDOR MANUAL 1 N/A  
MISCELLANEOUS SYSTEMS/EQUIPMENT PANEL(QPCP) SECTION 1, UNIT 1  
REVISION 13.0 DATE 08/18/09  
REVISED BY SNC PER ABN 1052592101J002.  
VER. 1.0  
BY CHE D. APPR. 1 APRR. 2  
TSL ELC JMR X

EQUIPMENT TAG NO: 1-1604-05-PCP

1X5AB01-00557-00N  
Southern Nuclear Operating Company, Inc.  
VOGTLE ELECTRIC GENERATING PLANT  
UNIT NO. 1  
MISCELLANEOUS SYSTEMS EQUIPMENT PANEL (QPCP) SECTION 1  
VENDOR: RELIANCE ELEC.  
DRAWING NO. 1X5AB01-00557



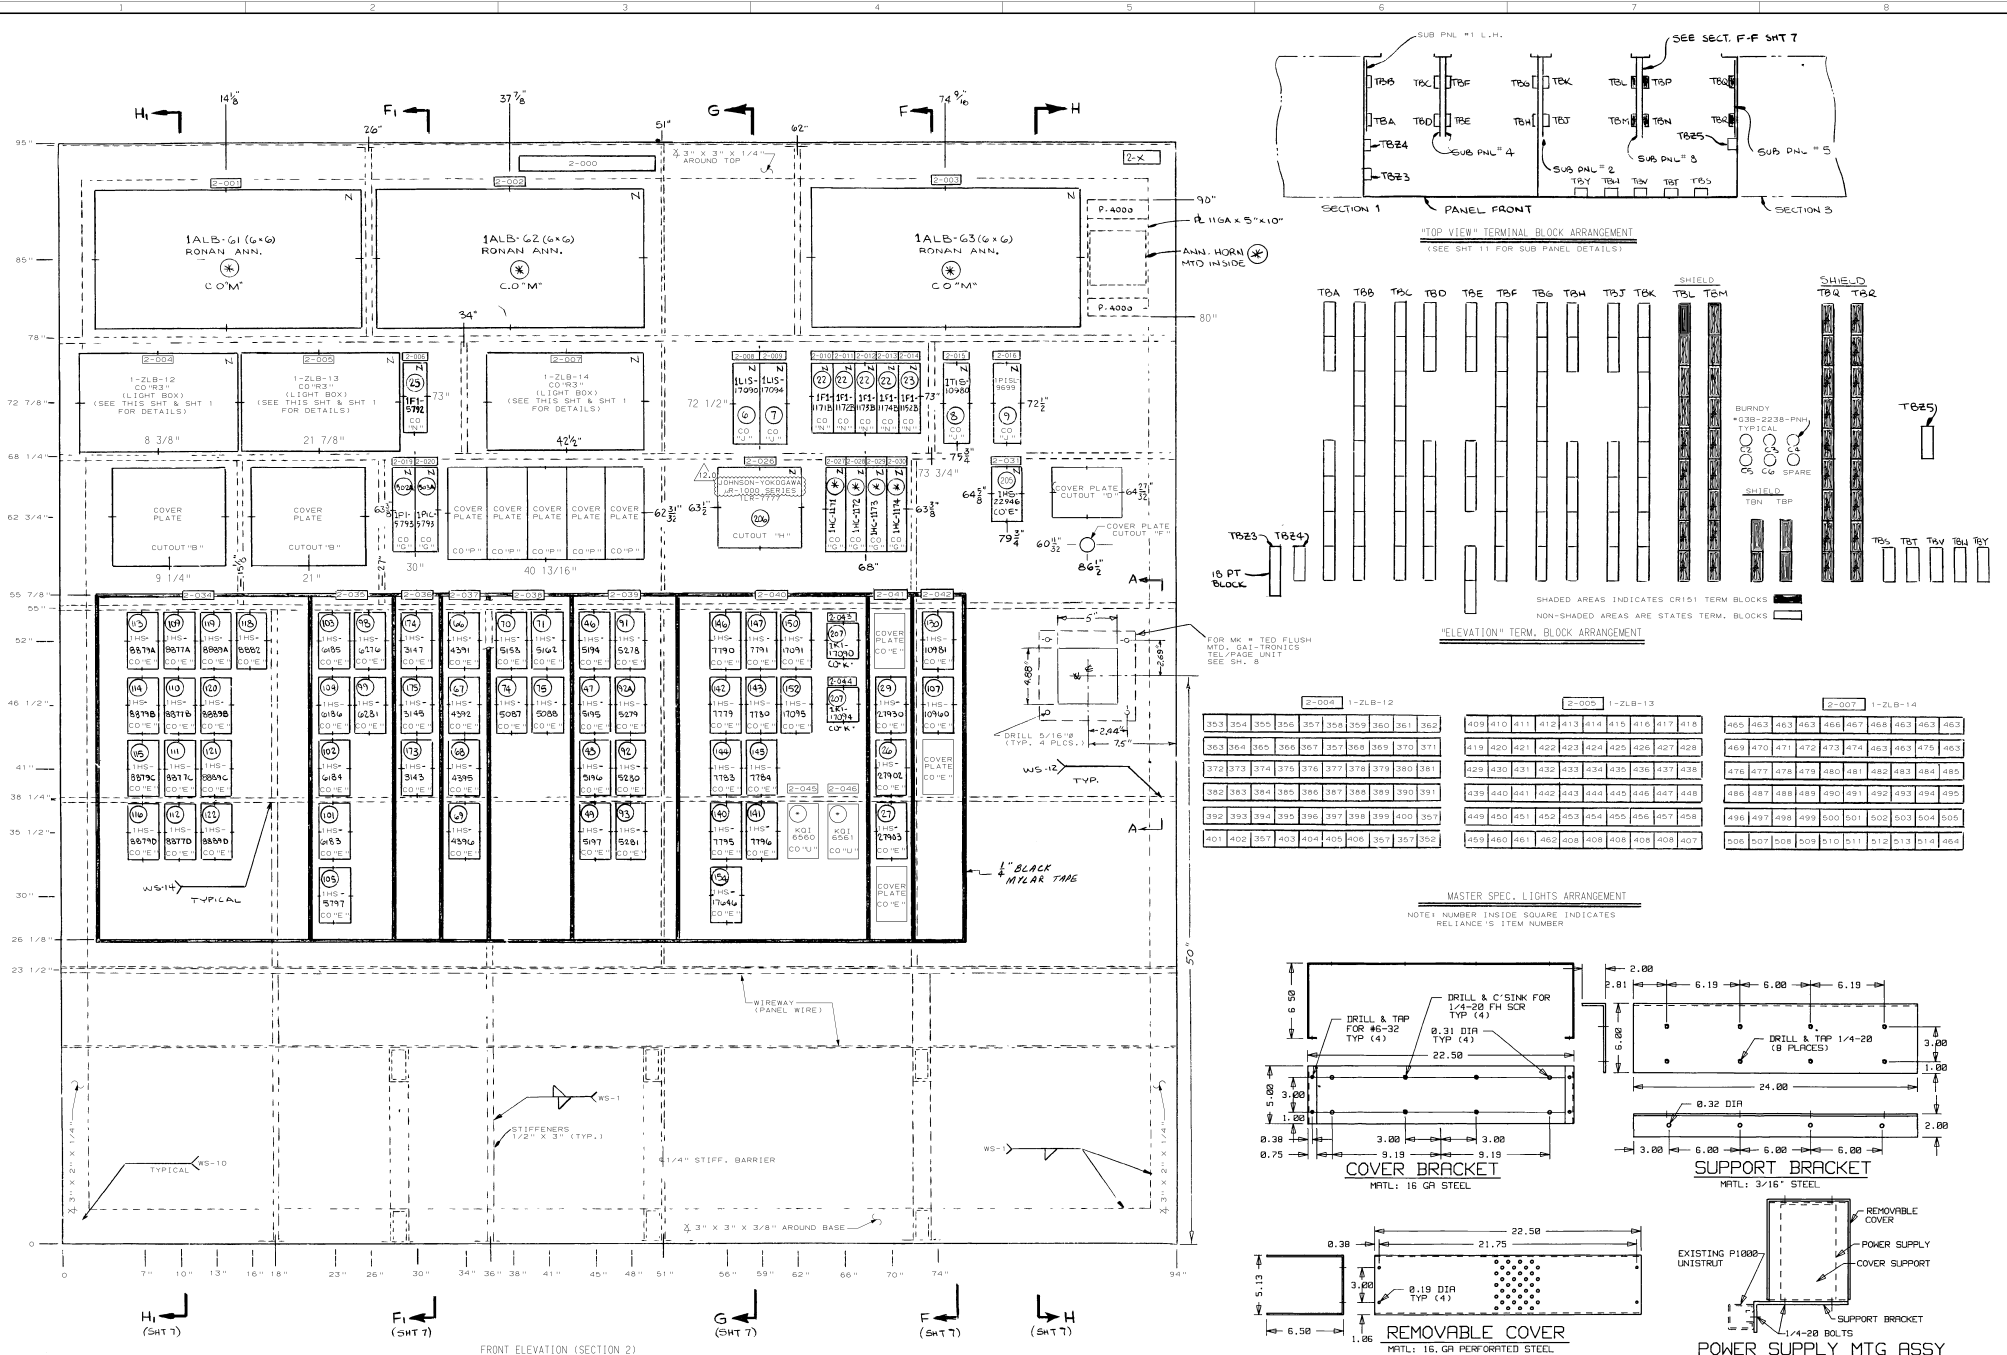


**NUCLEAR SAFETY RELATED**

REV	NO	DESCRIPTION	DATE
01	1	ISSUED FOR CONSTRUCTION	04/12/83
02	2	REVISED TO REFLECT CHANGES	05/15/83
03	3	REVISED TO REFLECT CHANGES	06/01/83
04	4	REVISED TO REFLECT CHANGES	06/15/83
05	5	REVISED TO REFLECT CHANGES	06/25/83
06	6	REVISED TO REFLECT CHANGES	07/10/83
07	7	REVISED TO REFLECT CHANGES	07/25/83
08	8	REVISED TO REFLECT CHANGES	08/10/83
09	9	REVISED TO REFLECT CHANGES	08/25/83
10	10	REVISED TO REFLECT CHANGES	09/10/83

THIS DWG. IS REFERENCED IN VENDOR MANUAL:	1X5AB01-00560-008
REVISION 12.0 DATE 3-14-07	
REVISION 11.0 DATE 3-14-07	
REVISION 10.0 DATE 3-14-07	
REVISION 9.0 DATE 3-14-07	
REVISION 8.0 DATE 3-14-07	
REVISION 7.0 DATE 3-14-07	
REVISION 6.0 DATE 3-14-07	
REVISION 5.0 DATE 3-14-07	
REVISION 4.0 DATE 3-14-07	
REVISION 3.0 DATE 3-14-07	
REVISION 2.0 DATE 3-14-07	
REVISION 1.0 DATE 3-14-07	

VENDOR: RELIANCE ELECTRIC  
 VENDOR PART NO.: 1X5AB01-00560  
 VENDOR NAME: RELIANCE ELECTRIC  
 VENDOR ADDRESS: 2150 N. 10TH ST., FAYETTEVILLE, NC 28404  
 VENDOR PHONE: 704/399-4400  
 VENDOR FAX: 704/399-4401  
 VENDOR WEBSITE: WWW.RELIANCEELECTRIC.COM

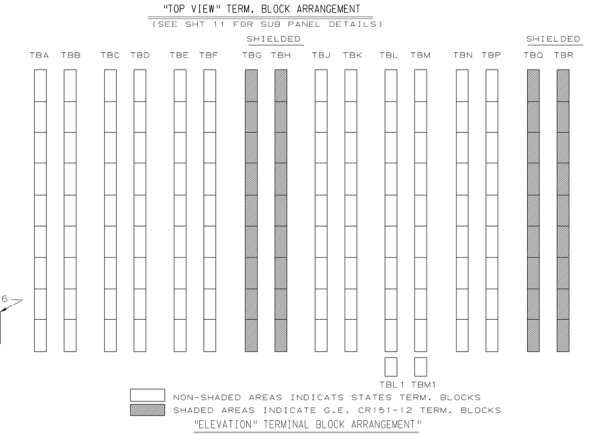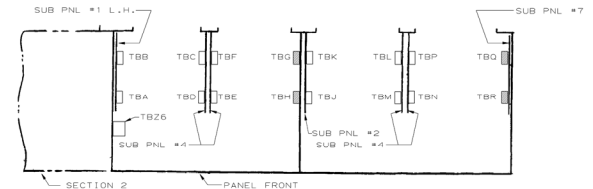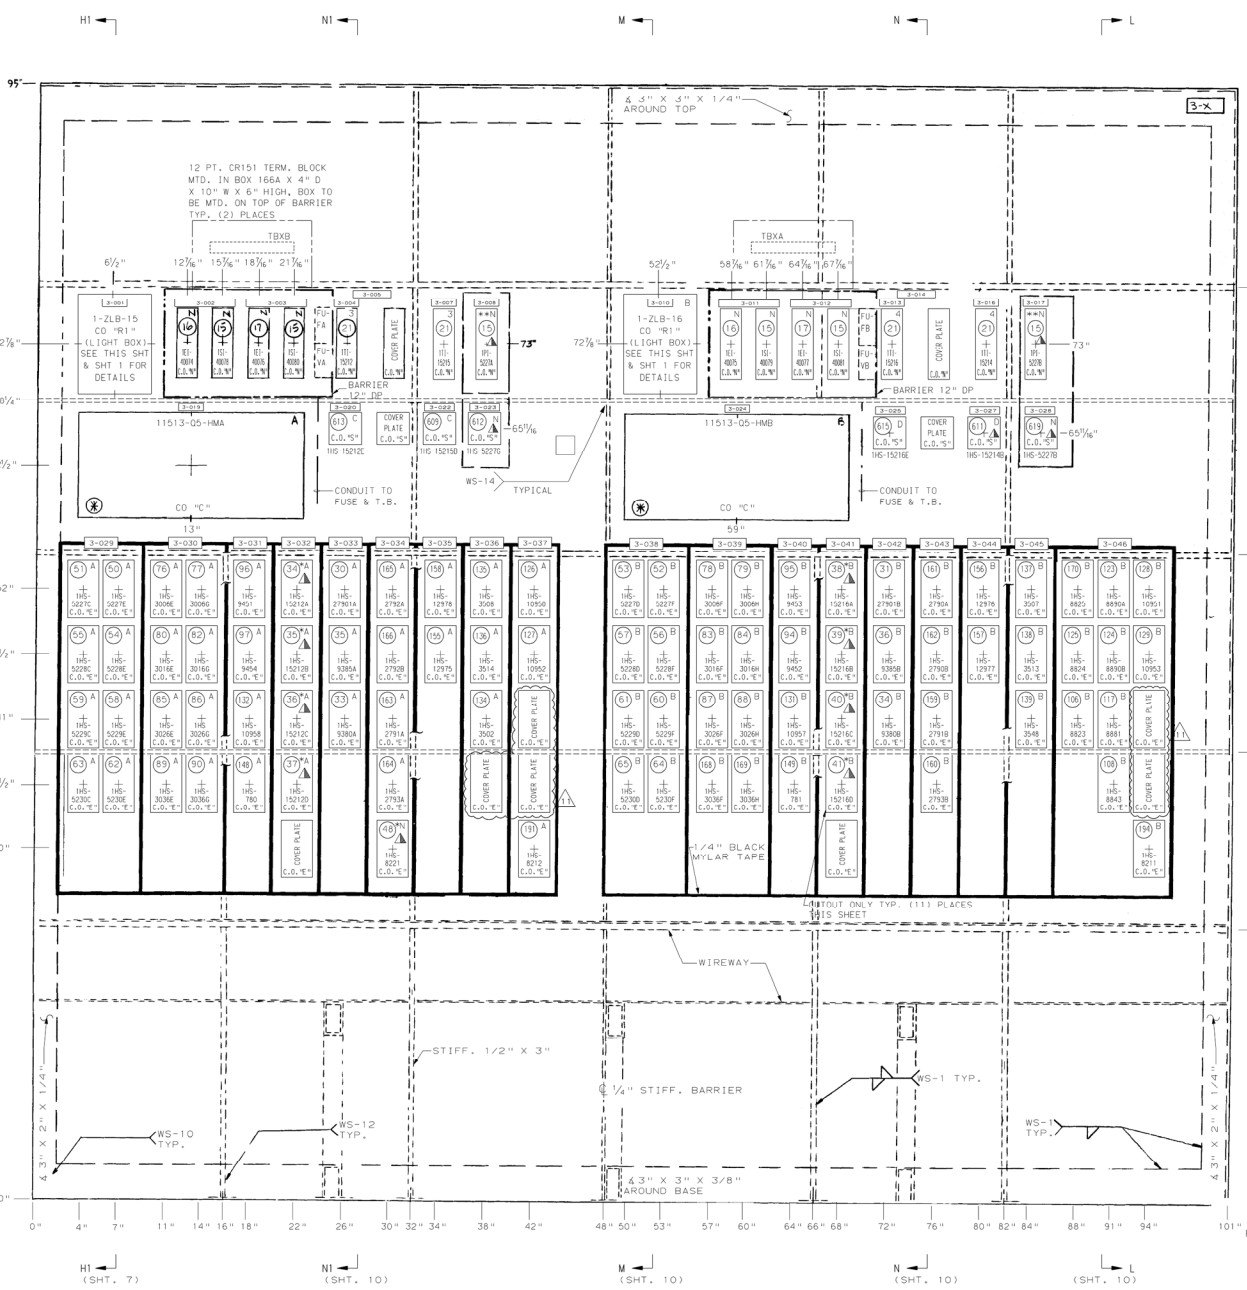


3-001 1-ZLB-15

517	518	519	520
521	516	516	516
522	523	516	516
524	525	526	527
516	516	516	516
516	516	516	515

3-010 1-ZLB-16

530	531	532	533
534	529	529	529
529	529	529	529
535	536	537	538
529	529	529	529
529	529	529	528

MASTER SPEC. LIGHTS ARRANGEMENT  
NOTE: NUMBER INSIDE SQUARE INDICATES RELIANCE'S ITEM NUMBER.

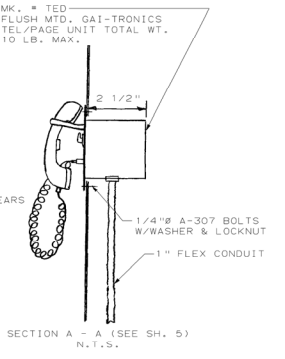

\* REFER TO SUMMARY OF MATERIALS BM-10X0097-A, BECHTEL LOG # 1X5AB01-1108  
\*\* REFER TO SUMMARY OF MATERIALS BM-10X0199-A, BECHTEL LOG # 1X5AB01-1136

▲ - EQUIPMENT PURCHASED ON JOB # 10AX090097

REV	DATE	BY	CHKD	APPV	DESCRIPTION
1	08/11/04	ECO	NO. 9941	15	MISCELLANEOUS SYSTEMS/EQUIPMENT
2	08/11/04	ECO	NO. 9941	15	PANEL (OPCP) SECTION 3, UNIT 1
3	08/11/04	ECO	NO. 9941	15	REVISED BY SDC
4	08/11/04	ECO	NO. 9941	15	REVISED BY SDC
NUCLEAR SAFETY RELATED

THIS DWG. IS REFERENCED IN VENDOR MANUAL:	MICROSTATION/LDT/DT	1X5AB01-00563.DGN
FAB/SECT:	N/A	Southern Nuclear Operating Company, Inc.
FIGURE:	N/A	VOGTLE ELECTRIC GENERATING PLANT UNIT NO. 1
REVISION 11 DATE 2/17/04	TITLE:	MISCELLANEOUS SYSTEMS/EQUIPMENT PANEL (OPCP) SECTION 3
REVISION 10 DATE 2/17/04	REVISION BY:	SNC PER BCP 01-V10021
SEE WORKFLOW FOR PREVIOUS REV. SOURCES:	BY:	CHW3 BVS11 80982
LDT WND DEW X	VENDOR:	RELIANCE ELECTRIC
DRWG NO.:	1X5AB01-00563	
DATE:	2/17/04	
SCALE:	1" = 1'-0"	

FUNCTION	SYMBOL	MEANING
AND		OUTPUT EXISTS ONLY WHEN ALL INPUTS ARE PRESENT.
OR		OUTPUT EXISTS ONLY WHEN ANY INPUT IS PRESENT.
NOT		OUTPUT EXISTS ONLY WHEN THE INPUT IS NOT PRESENT.
TIME DELAY (ON DELAY)		OUTPUT EXISTS AFTER A TIME DELAY WHEN THE INPUT IS CONTINUOUSLY PRESENT. OUTPUT CEASES WHEN THE INPUT IS NOT PRESENT.
TIMED DELAY (OFF DELAY)		OUTPUT EXISTS WHEN THE INPUT IS PRESENT AND CONTINUES TO EXIST FOR A TIME AFTER THE INPUT CEASES
OFF RETURN MEMORY		MEMORY OUTPUT EXISTS WHEN THE MEMORY INPUT IS PRESENT AND CONTINUES TO EXIST UNTIL THE RESET INPUT IS PRESENT, EXCEPT UPON INTERRUPTION OF POWER, MEMORY OUTPUT DISAPPEARS.
RETENTIVE MEMORY		MEMORY OUTPUT EXISTS WHEN THE MEMORY INPUT IS PRESENT AND CONTINUES TO EXIST (ALSO UPON INTERRUPTION OF POWER) UNTIL THE RESET INPUT IS PRESENT. RESET OUTPUT EXIST ONLY WHEN THE MEMORY OUTPUT IS NOT PRESENT.
COINCIDENCE MATRIX		OUTPUT EXISTS ONLY WHEN AT LEAST A OUT OF B INPUTS ARE PRESENT.
SPECIAL		A FUNCTION WHICH PRODUCES AN OUTPUT UNDER SPECIAL CONDITIONS STATED IN LR ADJACENT TO THE SYMBOL.
LIGHT		R-RED - OPERATING, FLOWING, OR INCREASING G-GREEN - NOT OPERATING, NOT FLOWING, OR DECREASING A-AMBER- ELECTRICAL OR MECHANICAL PROTECTION TRIP W-WHITE- MONITOR B-BLUE - MISCELLANEOUS
ANNUNCIATOR		INPUT TO ANNUNCIATOR
ANNUNCIATOR		COMMON INPUT TO ANNUNCIATOR
COMPUTER		INPUT TO COMPUTER
DEMARICATION LINES		DASHED LINES INDICATE OUTLINED AREAS OF LOGIC THAT ARE SUPPLIED BY A STATED VENDOR, OR AS NOTED
CROSS REFERENCE		CROSS REFERENCE TO ANOTHER LOGIC DRAWING

### GENERAL NOTES

1. PROCESS EQUIPMENT WILL CHANGE STATE WHEN A CHANGE IS INITIATED, AND WILL REMAIN IN THAT STATE UNTIL A CHANGE TO ANOTHER STATE IS INITIATED.
2. PROCESS EQUIPMENT WILL REMAIN IN, OR RETURN TO, THE ORIGINAL STATE AFTER A LOSS AND RESTORATION OF POWER, UNLESS OTHERWISE NOTED.
3. INHERENT EQUIPMENT INTERLOCKS, SUCH AS CIRCUIT BREAKER TRIP FREE AND REVERSING STARTER CROSS INTERLOCKS, ARE NOT SHOWN. EQUIPMENT CANNOT BE OPERATED WHEN PROTECTIVE INPUTS EXIST.
4. THE BLOCKING OF EQUIPMENT OPERATING CIRCUITS WHEN OVERLOAD OR GROUNDS OCCURS IS GENERALLY NOT SHOWN. SWITCHGEAR CIRCUITS WHICH USE LOCKOUT RELAYS FOR PROTECTIVE TRIPS AND ALL MCC CIRCUITS REQUIRE OPERATION OF A SWITCH AT THE SWITCHGEAR OR MCC TO RESET A PROTECTIVE TRIP.
5. IF A CIRCUIT BREAKER HAS BEEN TRIPPED ON BUS VOLTAGE FAILURE, IT WILL NOT RECLOSE ON BUS VOLTAGE RESTORATION.
6. THE TEST CONTROL SWITCHES AT THE SWITCHGEAR WHICH FUNCTION ONLY WHEN BREAKER IS IN THE TEST POSITION ARE NOT SHOWN. WHEN A CIRCUIT BREAKER IS IN THE TEST POSITION, REMOTE CONTROL IS CUT OFF.
7. FINAL INSTRUMENT SET POINTS ARE SHOWN ELSEWHERE. SET POINTS SHOWN ON SYSTEM CONTROL LOGIC DIAGRAMS ARE APPROXIMATE.
8. THE LOGIC TO SHOW THAT VALVE AND DAMPER POSITION LIGHTS ARE BOTH ON WHEN THE EQUIPMENT IS IN AN INTERMEDIATE POSITION IS NOT SHOWN.
9. MOTOR OPERATED VALVES GO TO FULLY OPEN OR FULLY CLOSED POSITION WITH MOMENTARY COMMAND UNLESS JOG PUSHBUTTON IS NOTED.
10. LIMIT AND TORQUE SWITCHES TO STOP VALVE AND DAMPER MOTOR ACTUATORS AT THE END OF TRAVEL ARE NOT SHOWN IN THE LOGIC. THE VALVE TYPE AND REQUIRED ACTIONS WILL BE NOTED ON THE DIAGRAM WHEN AVAILABLE.
11. THE HAND SWITCH FUNCTION ABBREVIATION WILL BE USED ON SYSTEM CONTROL LOGIC DIAGRAMS AS FOLLOWS:  
(M) - MAINTAINED CONTACT SWITCH  
(P) - MOMENTARY CONTACT SWITCH

SOUTHERN COMPANY SERVICES, INC. BIRMINGHAM, ALABAMA		
GEORGIA POWER COMPANY ALVIN W. VOGTLE NUCLEAR PLANT		
<b>CONTROL LOGIC DIAGRAM LEGEND</b>		
SCALE: NONE	DRAWING NO.	REV
JOB NO. 10604	1X5DN002-1	2

INC. ABN-20808.	6/2/95	CD	236	DNH																ENG MGR
REVISIONS	DATE	DR	CHK	APPV	DTL															
ISSUED FOR CONSTRUCTION																				DATE
NO.	REVISIONS	DATE	DR																	

SIZE B 11x17

This drawing and the design it covers are the property of BECHTEL. They are merely loaned and on the borrower's express agreement that they will not be re-produced, copied, loaned, exhibited, or used except in the limited way and private use permitted by any written consent given by the lender to the borrower.

SPECIAL NOTES

1. SELECTED ENGINEERED SAFETY FEATURE EQUIPMENTS REQUIRED FOR SHUTDOWN OF THE PLANT WILL HAVE TWO POINTS OF CONTROL, ONLY IF ONE OF THE POINTS IS IN THE CONTROL ROOM. A TRANSFER SWITCH ON THE SHUTDOWN PANEL SHALL DISABLE THE CONTROL ROOM POINT OF CONTROL WHEN THE TRANSFER SWITCH IS ON LOCAL POSITION. THIS CONDITION WILL BE ANNUNCIATED IN THE SHUTDOWN ROOM.
2. THE THERMAL OVERLOAD PROTECTION DEVICE OF SAFETY RELATED MOTOR OPERATED VALVE SHALL BE BYPASSED AND TEMPORARILY PLACED IN FORCE ONLY WHEN THE VALVE MOTOR IS UNDERGOING PERIODIC OR MAINTENANCE TESTING.

GENERAL NOTES (CONT)

14. THE BLOCKING OF AIR CIRCUIT BREAKER MANUAL STOP ACTIONS FROM THE CONTROL ROOM DURING ESP SEQUENCER OPERATION IS NOT SHOWN ON INDIVIDUAL LOGIC DIAGRAMS. REFER TO ELEMENTARY DIAGRAMS.

GENERAL NOTES (CONT.)

12. THE FOLLOWING SAFETY SIGNALS ABBREVIATIONS WILL BE USED ON SYSTEM CONTROL LOGIC DIAGRAMS.

- CI-A-A - CONTAINMENT ISOLATION-PHASE A-TRAIN A
- CI-A-B - CONTAINMENT ISOLATION-PHASE A-TRAIN B
- CI-B-A - CONTAINMENT ISOLATION-PHASE B-TRAIN A
- CI-B-B - CONTAINMENT ISOLATION-PHASE B-TRAIN B
- SI-A - SAFETY INJECTION SIGNAL-TRAIN A
- SI-B - SAFETY INJECTION SIGNAL-TRAIN B
- CVI-A - CONTAINMENT VENTILATION ISOLATION-TRAIN A
- CVI-B - CONTAINMENT VENTILATION ISOLATION-TRAIN B
- CRI-A - CONTROL ROOM ISOLATION-TRAIN A
- CRI-B - CONTROL ROOM ISOLATION-TRAIN B
- SLI-A - STEAM LINE ISOLATION-TRAIN A
- SLI-B - STEAM LINE ISOLATION-TRAIN B
- FI-A - FEEDWATER ISOLATION-TRAIN A
- FI-B - FEEDWATER ISOLATION-TRAIN B
- FHBI-A - FUEL HANDLING BUILDING ISOLATION TRAIN A
- FHBI-B - FUEL HANDLING BUILDING ISOLATION TRAIN B

13. THE FOLLOWING ABBREVIATIONS WILL BE USED FOR CONTROL BOARDS, PANELS AND STATIONS. OTHERS REFER TO CONTROL PANEL LIST.

- △ ~~MAIN CONTROL BOARD~~
- QHVC - HVAC PANEL
- QPCP - MISC. SYSTEMS EQUIPMENT PANEL
- △ QSPS - SYSTEMS STATUS MONITOR PANEL
- PAFP - AUX FD WTR SHUTDOWN PNL; PAFT - AUX FD WTR TURB PNL.
- PRP - TURBINE PLANT SAMPLING
- PSDA - SHUTDOWN PANEL TRAIN A; PSDB - SHUTDOWN PANEL TRAIN B
- PNSS - NUCLEAR SERVICE WATER SAMPLE PANEL
- PDG1 - DIESEL GEN. PANEL NO. 1; PDG2 - DIESEL GEN. PANEL NO. 2
- PNSP - NUCLEAR SAMPLING SYSTEM PANEL
- △ DNWP - WASTE HOLD-UP PANEL
- PAFT - AUX FDWTR TURB PNL
- △ STSN - TECHNICAL SUPPORT PNL
- △ L - LOCAL STATION
- ERF - EMERGENCY RESPONSE FACILITY

<b>BECHTEL</b> LOS ANGELES		
GEORGIA POWER COMPANY ALVIN W. VOGTLE NUCLEAR PLANT		
CONTROL LOGIC DIAGRAM		
LEGEND		
SCALE: NONE	DRAWING NO.	REV.
JOB NO. 9510	1X5DN002-2	1

NO.	REVISIONS	DATE	DR	CHK.	SUPV.	ENGL	EGS	CHF. E.	R.E.	Q.A.E.	ENG. MGR.
△											
△	REVISED SPECIAL NOTE 1 & GENERAL NOTE 13, 14	7-11-84	ETL	ALV							
△	ISSUED FOR CONSTRUCTION	1-4-79	NBD	FAL	MKK						


SIZE B 11 x 17

I CERTIFY THAT THE IMAGE CONTAINED ON THIS FRAME WAS MADE IN THE NORMAL AND REGULAR COURSE OF BUSINESS ON THE DATE STATED BELOW AND THAT IT IS AN ACCURATE REPRODUCTION OF THE DOCUMENT SUBMITTED TO MICROGRAPHICS.  
 DATE: 7-11-84 CAMERA OPERATOR: M. PAVLOFF SECTION SUPERVISOR:





This drawing and the design it covers are the property of BECHTEL. They are loaned, exhibited, or used except in the limited way and for the purpose permitted by any written consent given by the lender to the borrower.

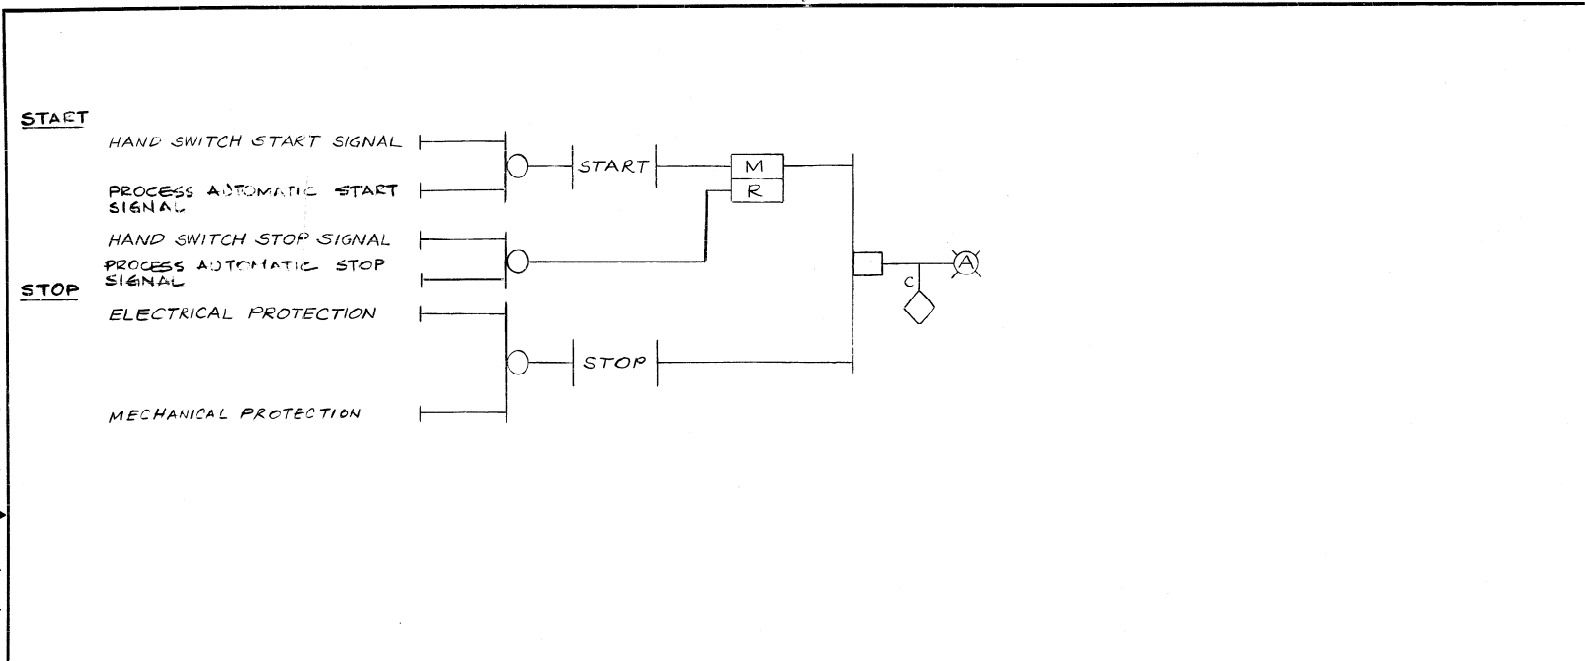

TYPICAL AUTOMATIC PROTECTION  
ALARM AND INDICATION

<b>BECHTEL</b> LOS ANGELES	
GEORGIA POWER COMPANY ALVIN W. VOGTLE NUCLEAR PLANT	
CONTROL LOGIC DIAGRAM TYPICAL	
SCALE: NONE	DRAWING NO. 1X5DN002-3
JOB NO. 9510	REV. 0

△												ENG. MGR.
△												
△	ISSUED FOR CONSTRUCTION	5/31/74	HL	FAL	PKV							DATE
NO.	REVISIONS	DATE	DR	CHK.	SUPV.		EGS	CHF. E.	P. E.	Q. A. E.		

BM 9510

SIZE B 11 x 17




I CERTIFY THAT THE IMAGE CONTAINED ON THIS FRAME WAS MADE IN THE NORMAL AND REGULAR COURSE OF BUSINESS, ON THE DATE STATED BELOW AND THAT IT IS AN ACCURATE REPRODUCTION OF THE DOCUMENT SUBMITTED TO MICROGRAPHICS.

DATE: 4-1-77  
 CAMERA OPERATOR: [Signature]  
 SECTION SUPERVISOR: [Signature]

I CERTIFY THAT THE IMAGE CONTAINED ON THIS FRAME WAS MADE IN THE NORMAL AND REGULAR COURSE OF BUSINESS, ON THE DATE STATED BELOW AND THAT IT IS AN ACCURATE REPRODUCTION OF THE DOCUMENT SUBMITTED TO MICROGRAPHICS  
 6-17-85  
 DATE: CAMERA OPERATOR SECTION SUPERVISOR

This drawing and the design it covers are the property of BECHTEL. They may not be reproduced, copied, loaned, exhibited, or used except in the limited way and places permitted by any written consent given by the holder of the document.

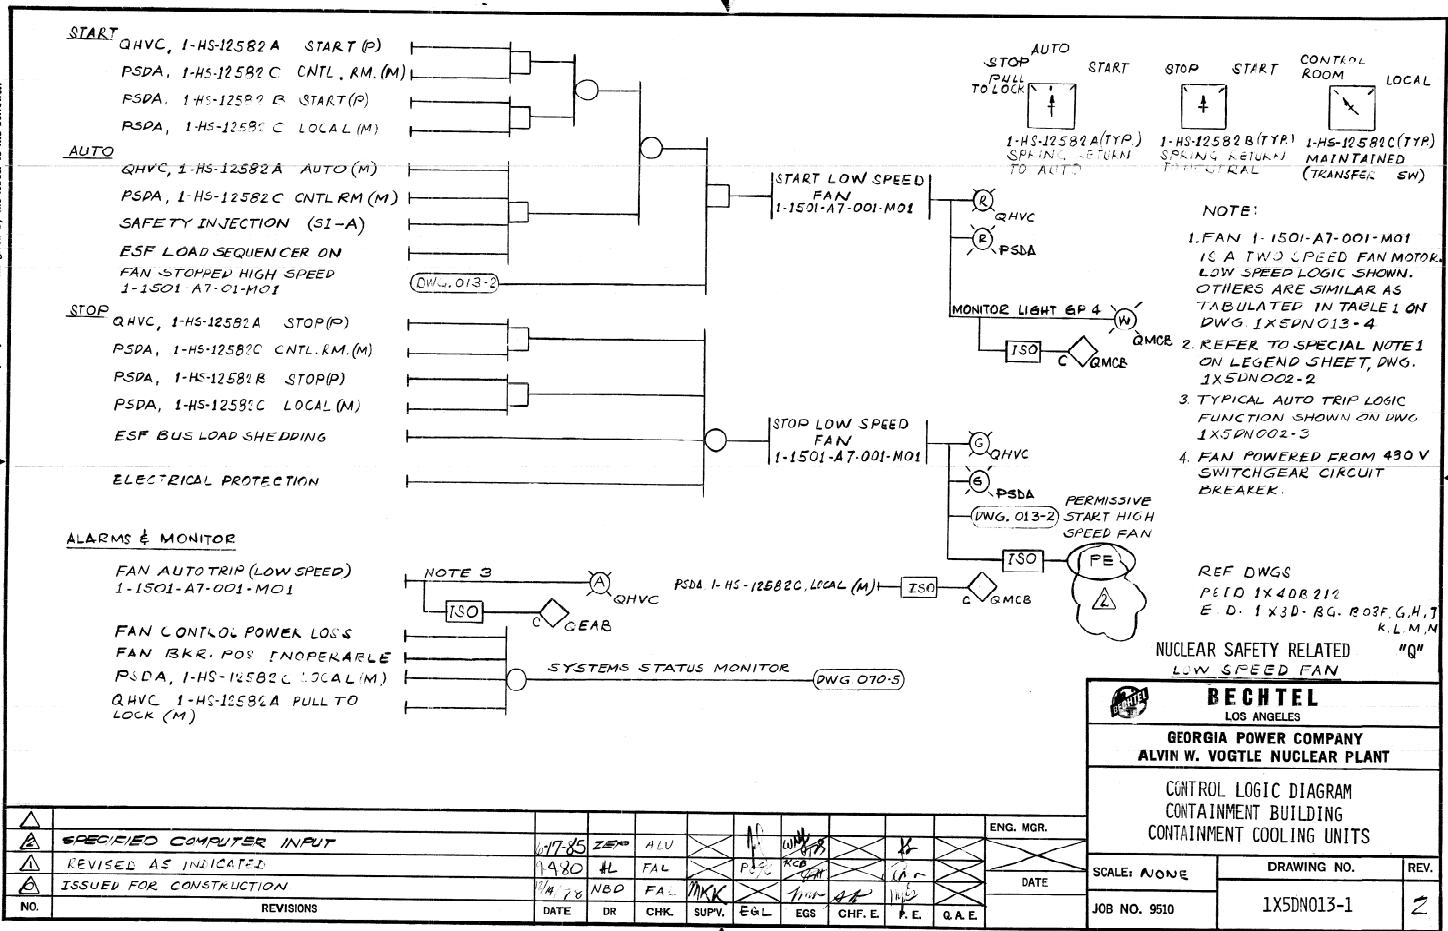


NO.	REVISIONS	DATE	DR	CHK.	SUPV.	E&L	EGS	CHF. E.	P. E.	G. A. E.	ENG. MGR.
△	SPECIFIED COMPUTER INPUT	1/7/85	ZEP	ALV							
△	REVISED AS INDICATED	1/9/80	HL	FAL							
△	ISSUED FOR CONSTRUCTION	1/14/78	NBD	FA							

**BECHTEL**  
 LOS ANGELES  
 GEORGIA POWER COMPANY  
 ALVIN W. VOGTLE NUCLEAR PLANT  
 CONTROL LOGIC DIAGRAM  
 CONTAINMENT BUILDING  
 CONTAINMENT COOLING UNITS

SCALE: NONE  
 JOB NO. 9510  
 DRAWING NO. 1X5DN013-1  
 REV. Z

SIZE B 11x17


I CERTIFY THAT THE IMAGE CONTAINED ON THIS FRAME WAS MADE IN THE NORMAL AND REGULAR COURSE OF BUSINESS, ON THE DATE STATED BELOW AND THAT IT IS AN ACCURATE REPRODUCTION OF THE DOCUMENT SUBMITTED TO MICROGRAPHICS  
 6-17-85  
 DATE: CAMERA OPERATOR SECTION SUPERVISOR

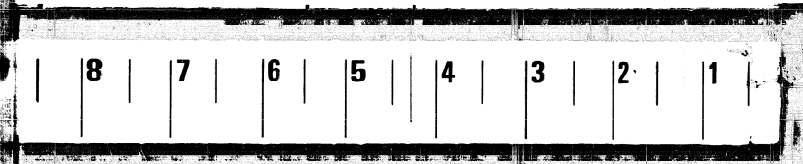

14.5X

I CERTIFY THAT THE IMAGE CONTAINED ON THIS FRAME WAS MADE IN THE NORMAL AND REGULAR COURSE OF BUSINESS, ON THE DATE STATED BELOW AND THAT IT IS AN ACCURATE REPRODUCTION OF THE DOCUMENT SUBMITTED TO MICROGRAPHICS  
 DATE: 6-17-85  
 CAMERA OPERATOR: [Signature]  
 SECTION SUPERVISOR: [Signature]

This drawing and the design it covers are the property of BECHTEL. They are to be used only for the project and in the limited way and private use permitted by any written consent given by the lender to the borrower.

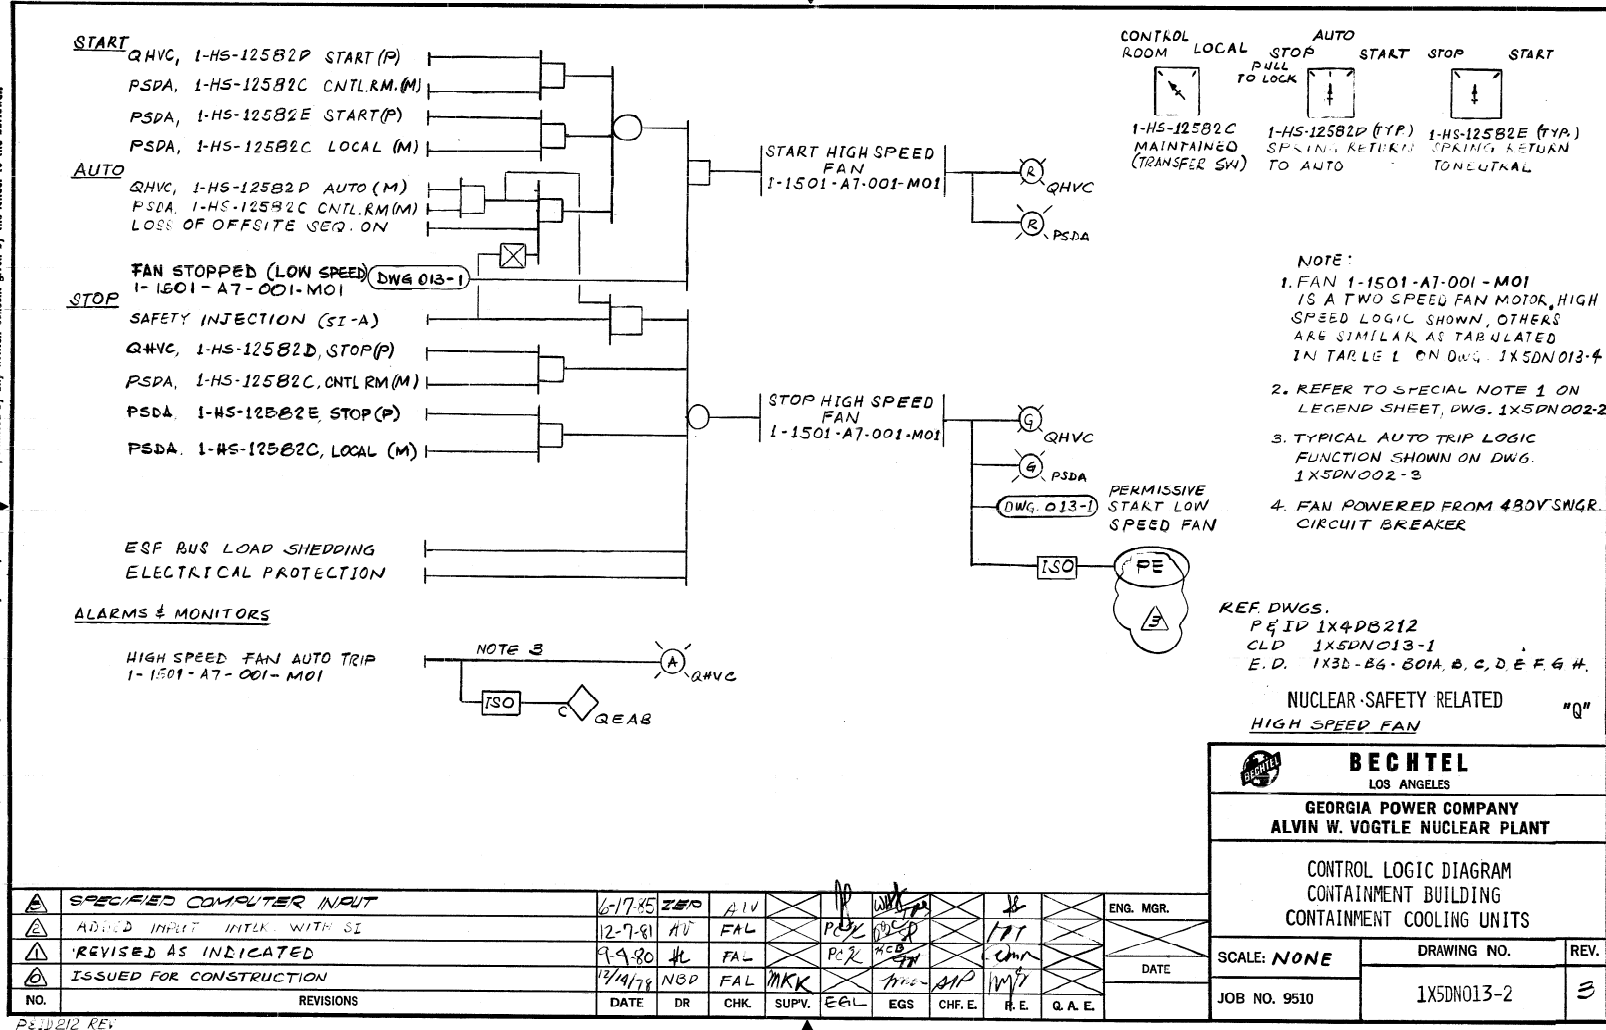

NO.	REVISIONS	DATE	DR	CHK	SUPV.	EGL	EGS	CHF. E.	R. E.	Q. A. E.	ENG. MGR.	DATE	SCALE: NONE	DRAWING NO.	REV.
1	SPECIFIED COMPUTER INPUT	6-17-85	ZBP	AV											
2	ADDED IMPACT INTLK WITH SI	12-7-81	AV	FAL											
3	REVISED AS INDICATED	9-9-80	HL	FAL											
4	ISSUED FOR CONSTRUCTION	12/14/78	NBP	FAL	MKK										

**BECHTEL**  
 LOS ANGELES  
**GEORGIA POWER COMPANY**  
**ALVIN W. VOGTLE NUCLEAR PLANT**

**CONTROL LOGIC DIAGRAM**  
**CONTAINMENT BUILDING**  
**CONTAINMENT COOLING UNITS**

SCALE: NONE      DRAWING NO. 1X5DN013-2      REV. 3

8 7 6 5 4 3 2 1


I CERTIFY THAT THE IMAGE CONTAINED ON THIS FRAME WAS MADE IN THE NORMAL AND REGULAR COURSE OF BUSINESS, ON THE DATE STATED BELOW AND THAT IT IS AN ACCURATE REPRODUCTION OF THE DOCUMENT SUBMITTED TO MICROGRAPHICS  
 DATE: 6-17-85  
 CAMERA OPERATOR: [Signature]  
 SECTION SUPERVISOR: [Signature]

SIZE B 11 x 17

14.5X

I CERTIFY THAT THE IMAGE CONTAINED ON THIS FRAME WAS MADE IN THE NORMAL AND REGULAR COURSE OF BUSINESS, ON THE DATE STATED BELOW AND THAT IT IS AN ACCURATE REPRODUCTION OF THE DOCUMENT SUBMITTED TO MICROGRAPHICS  
6-17-85  
DATE: CAMERA OPERATOR SECTION SUPERVISOR


This drawing and the design it covers are the property of BECHTEL. They are loaned and on the borrower's express agreement that they will not be re-produced, copied, loaned, exhibited, or used except in the limited way and private use permitted by any written consent given by the lender to the borrower.

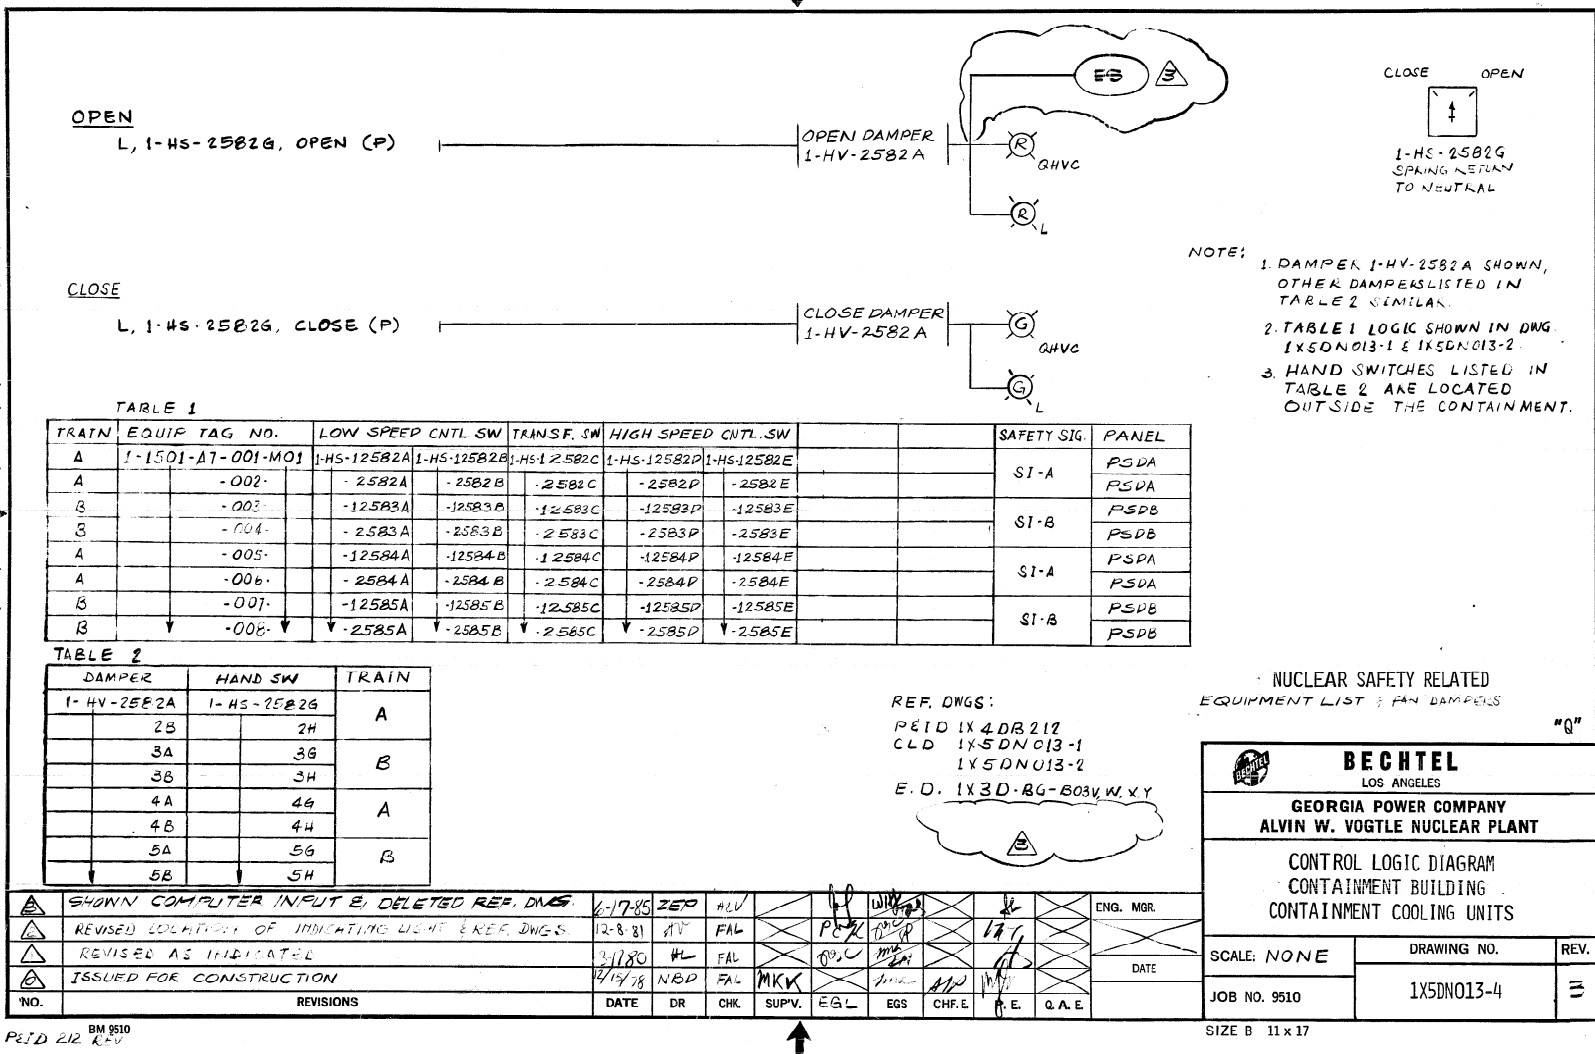

8 | 7 | 6 | 5 | 4 | 3 | 2 | 1

I CERTIFY THAT THE IMAGE CONTAINED ON THIS FRAME WAS MADE IN THE NORMAL AND REGULAR COURSE OF BUSINESS, ON THE DATE STATED BELOW AND THAT IT IS AN ACCURATE REPRODUCTION OF THE DOCUMENT SUBMITTED TO MICROGRAPHICS  
6-17-85  
DATE: CAMERA OPERATOR SECTION SUPERVISOR

This drawing and the design it covers are the property of BECHTEL. They are loaned and on the borrower's express agreement that they will not be reproduced, copied, issued, exhibited, or used except in the limited way and private use permitted by any written consent given by the lender to the borrower.

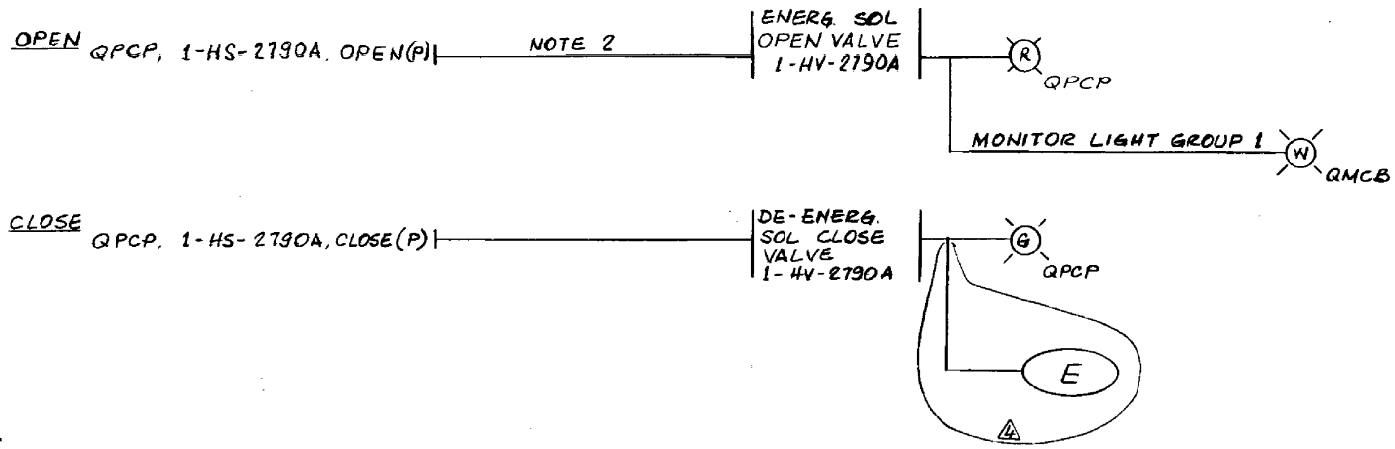

- NOTE:
1. VALVE 1-HV-2790A SHOWN, OTHER VALVE LISTED IN TABLE 1 SIMILAR.
  2. HAND SWITCH SHALL BE HELD ON OPEN POSITION UNTIL VALVE IS FULLY OPEN TO ALLOW CIRCUIT TO SEAL IN THROUGH VALVE POSITION SWITCH
  3. VALVE 1-HV-8221 IS A NON IE VALVE AND DOES NOT REQUIRE MONITOR LIGHT ON QMCB.

REF. DWGS:  
 PEID 1X4DB213-2  
 E.D 1X3D-BG-005B,E

TABLE 1

SERVICE	TRAIN	SOL VALVE	SWITCH
HYDROGEN SAMPLE INLET - IRC	B	1-HV-2790A	1-HS-2790A
INLET - IAC	B	-2790B	-2790B
INLET - ORC	A	-2791A	-2791A
INLET - ORC	B	-2791B	-2791B
INLET - IRC	A	-2792A	-2792A
INLET - IRC	A	-2792B	-2792B
OUTLET - ORC	A	-2793A	-2793A
OUTLET - ORC	B	-2793B	-2793B
INLET - ORC	NOTE 3	-8221	-8221

NUCLEAR SAFETY RELATED  
 CNMT HYDROGEN SAMPLING

**BECHTEL**  
 LOS ANGELES

**GEORGIA POWER COMPANY**  
 ALVIN W. VOGTLE NUCLEAR PLANT

**CONTROL LOGIC DIAGRAM**  
 CONTAINMENT AIR PURIFICATION  
 AND CLEAN-UP SYSTEM

SCALE: NONE	DRAWING NO.	REV.
JOB NO. 9510	1X5D015-11	4

ADDED SAMPLE VALVE FOR PASS HV-8221	9/9/82	AV	FAL		PCZ	PCZ		INT		ENG. MGR.
REVISED REF DWGS.	12-8-81	AT	FAL		PCZ	PCZ		INT		
DEGRADED VALVE 1-HV-8221 PER DON3; ADDED ERF INPUT	3-27-84	4LV	FAL		PCZ	PCZ		INT		
ISSUED FOR CONSTRUCTION	12/11/78	NBL	FAL	MKV						DATE
NO.	REVISIONS	DATE	DR	CHK.	SUPV.	EGL	EGS	CHF. E	P. E.	Q. A. E.

BM 9510  
 PEID 213-2 REV. 1


SCALE B 11x17

JSM

**14.5X**

I CERTIFY THAT THE IMAGE CONTAINED ON THIS FRAME WAS MADE IN THE NORMAL AND REGULAR COURSE OF BUSINESS, ON THE DATE STATED BELOW AND THAT IT IS AN ACCURATE REPRODUCTION OF THE DOCUMENT SUBMITTED TO MICROGRAPHICS  
 5/19/85 John J. [Signature]  
 DATE CAMERA OPERATOR SECTION SUPERVISOR

This drawing and the design it covers are the property of BECHTEL. They are loaned and on the borrower's express agreement that they will not be re-produced, copied, loaned, exhibited, or used except in the limited way and private use permitted by any written consent given by the lender to the borrower.

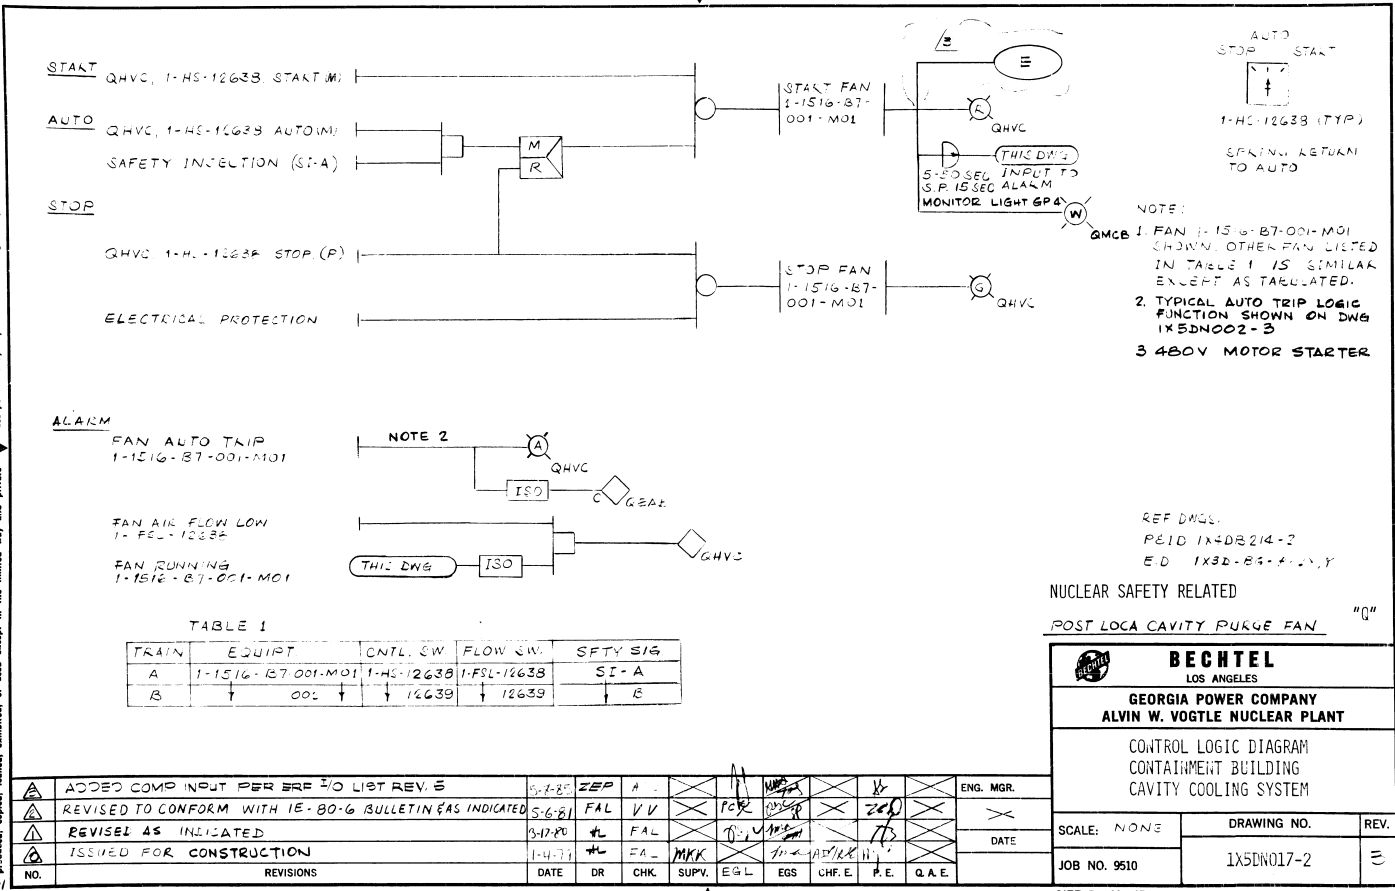


BM 9510 P&ID REV 3



8 | 7 | 6 | 5 | 4 | 3 | 2 | 1

I CERTIFY THAT THE IMAGE CONTAINED ON THIS FRAME WAS MADE IN THE NORMAL AND REGULAR COURSE OF BUSINESS, ON THE DATE STATED BELOW AND THAT IT IS AN ACCURATE REPRODUCTION OF THE DOCUMENT SUBMITTED TO MICROGRAPHICS  
 5/19/85 John J. [Signature]  
 DATE CAMERA OPERATOR SECTION SUPERVISOR

This drawing and this design it covers are the property of BECHTEL. They are being loaned and on the borrower's express agreement that they will not be reproduced, copied, loaned, exhibited, or used except in the limited way and private use permitted by any written consent given by the lender to the borrower.

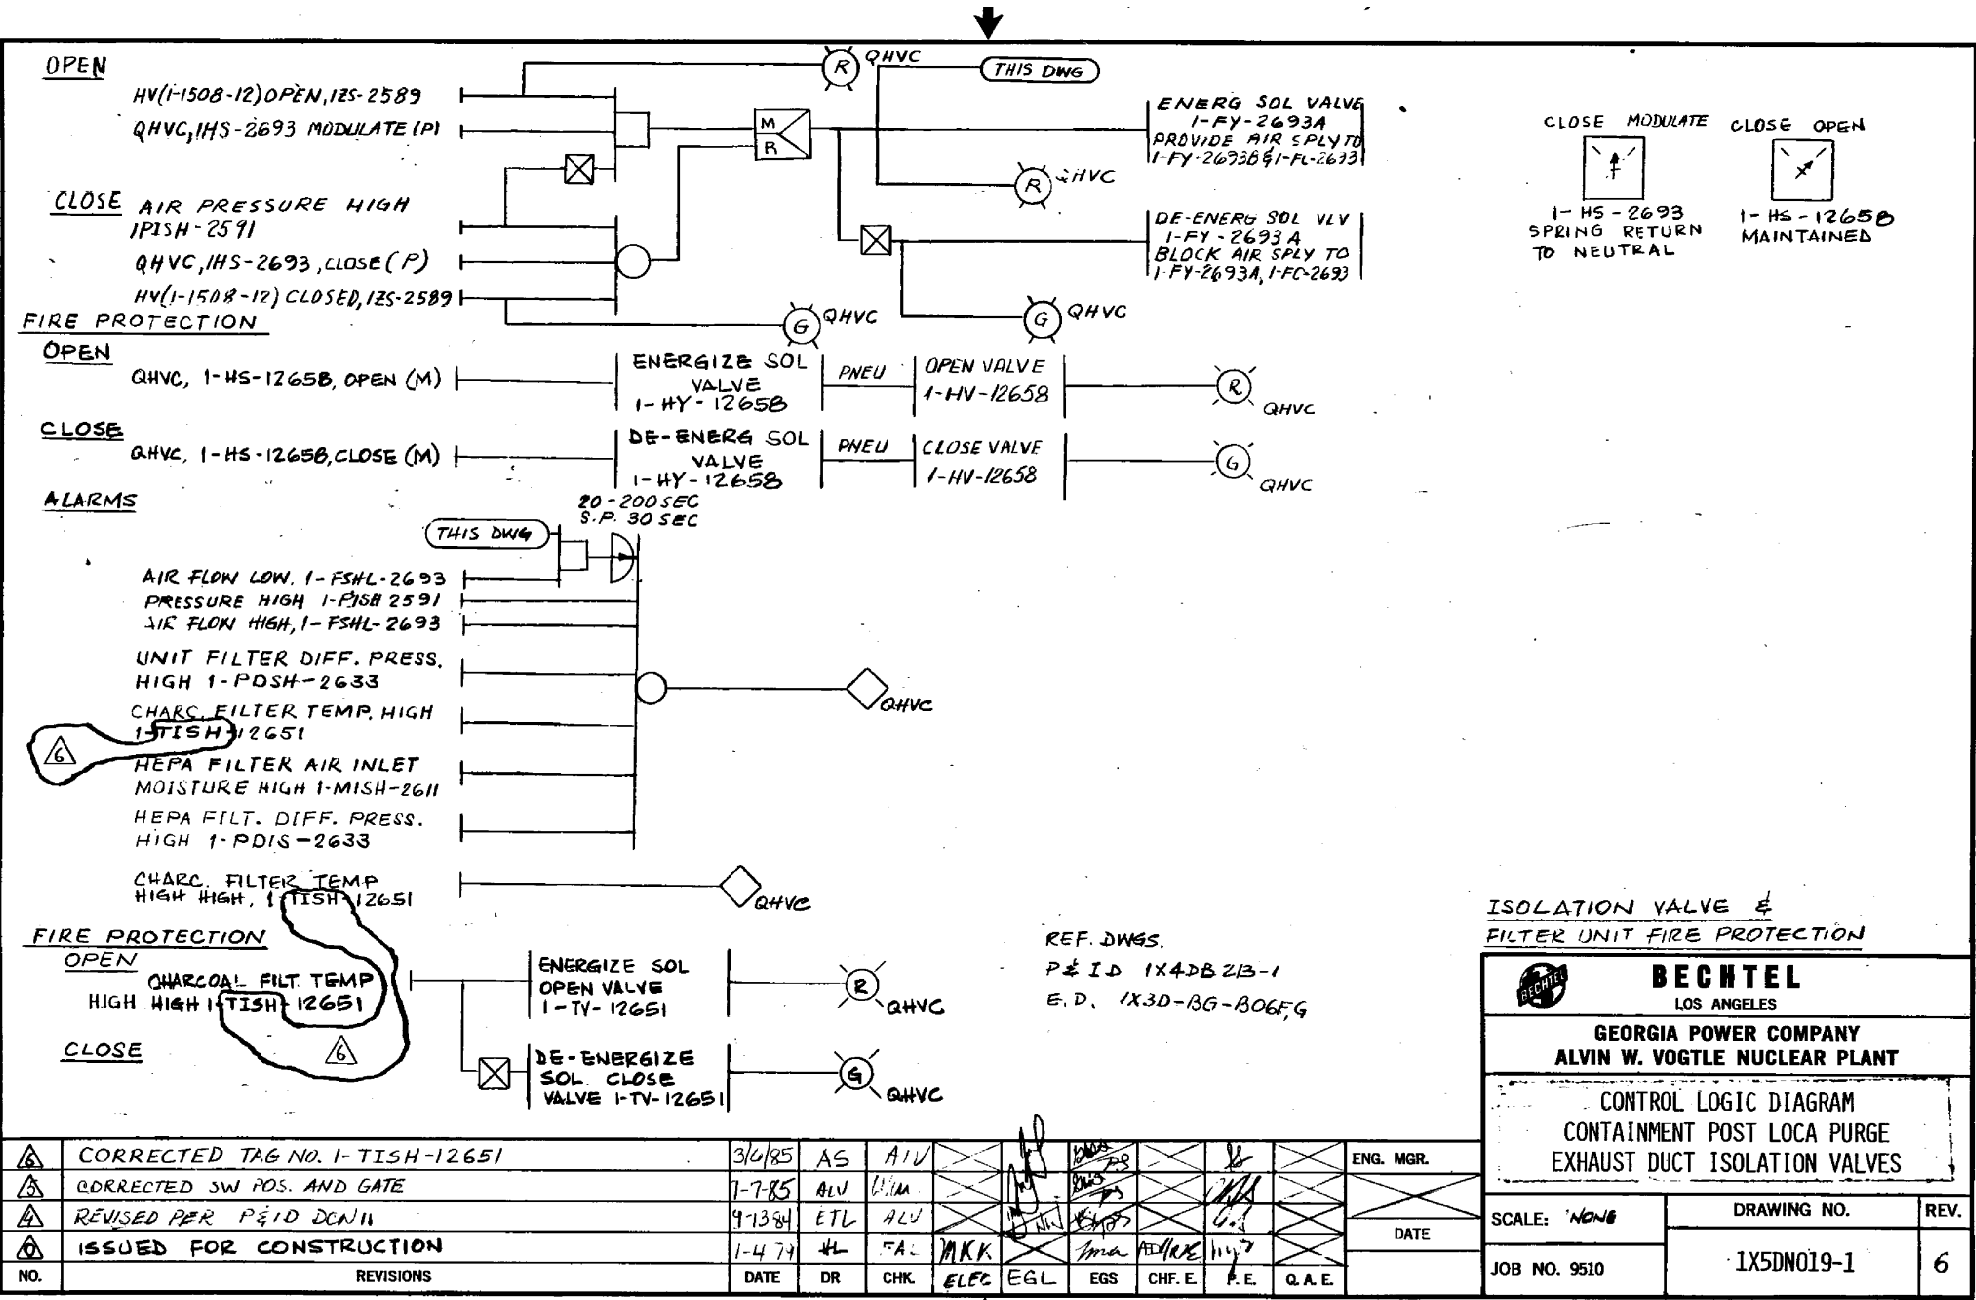


△	CORRECTED TAG NO. 1-TISH-12651	3/6/85	AS	AIV								ENG. MGR.
△	CORRECTED SW POS. AND GATE	7-7-85	ALV	DIM								
△	REVISED PER P&ID DCN 11	9-13-84	ETL	ALV								DATE
△	ISSUED FOR CONSTRUCTION	1-4-79	HL	FAL	MKK							
NO.	REVISIONS	DATE	DR	CHK	ELEG	EGL	EGS	CHF. E.	P. E.	Q. A. E.		

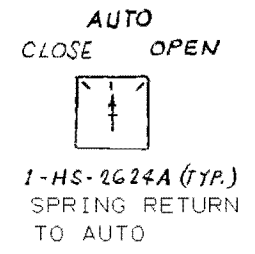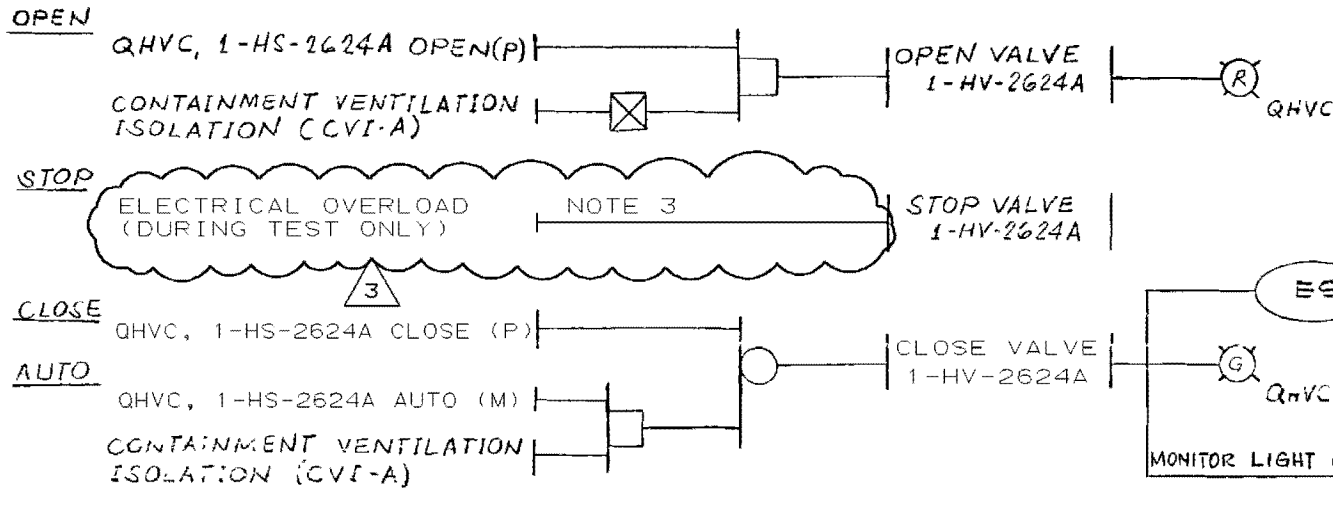

NOTE

1. VALVE 1-HV-2624A SHOWN. 1-HV-2624B SIMILAR.
2. VALVES LISTED IN TABLE 1 ARE BUTTERFLY VALVES.  
OPEN - LIMIT STOPPED  
CLOSE - LIMIT STOPPED
3. REFER TO SPECIAL NOTE 2 ON DWG 1X5DN002-2

VALVE NO.	TRAIN	SAFETY SIGNAL	SWITCH
1-HV-2624A	A	CVI-A	1-HS-2624A
↓ -2624B	B	CVI-B	↓ -2624B

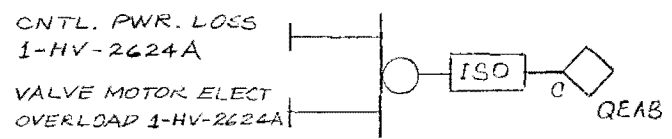

REF. DWGS.  
P & ID 1X4DB213-1  
E.D. 1X3D-BG-B04A,4B

NUCLEAR SAFETY RELATED "Q"  
INSIDE CONTAINMENT ISOL VALVES


**SOUTHERN COMPANY SERVICES, INC.**  
BIRMINGHAM, ALABAMA

GEORGIA POWER COMPANY  
ALVIN W. VOGTLE NUCLEAR PLANT

CONTROL LOGIC DIAGRAM  
CONTAINMENT POST LOCA  
PURGE EXHAUST DUCT  
ISOLATION VALVES

NO.	REVISIONS	DATE	DR	CHK	APPV	DTL	SCALE:	DRAWING NO.	REV
△							NONE	1X5DN019-2	3
△									
△	INCORPORATED PER DCP 95-V1N0035	12/5/97	CD	GLB	WFP				
△	ISSUED FOR CONSTRUCTION	SEE MICROFILM FOR		SIGNATURES					
							JOB NO. 10604		



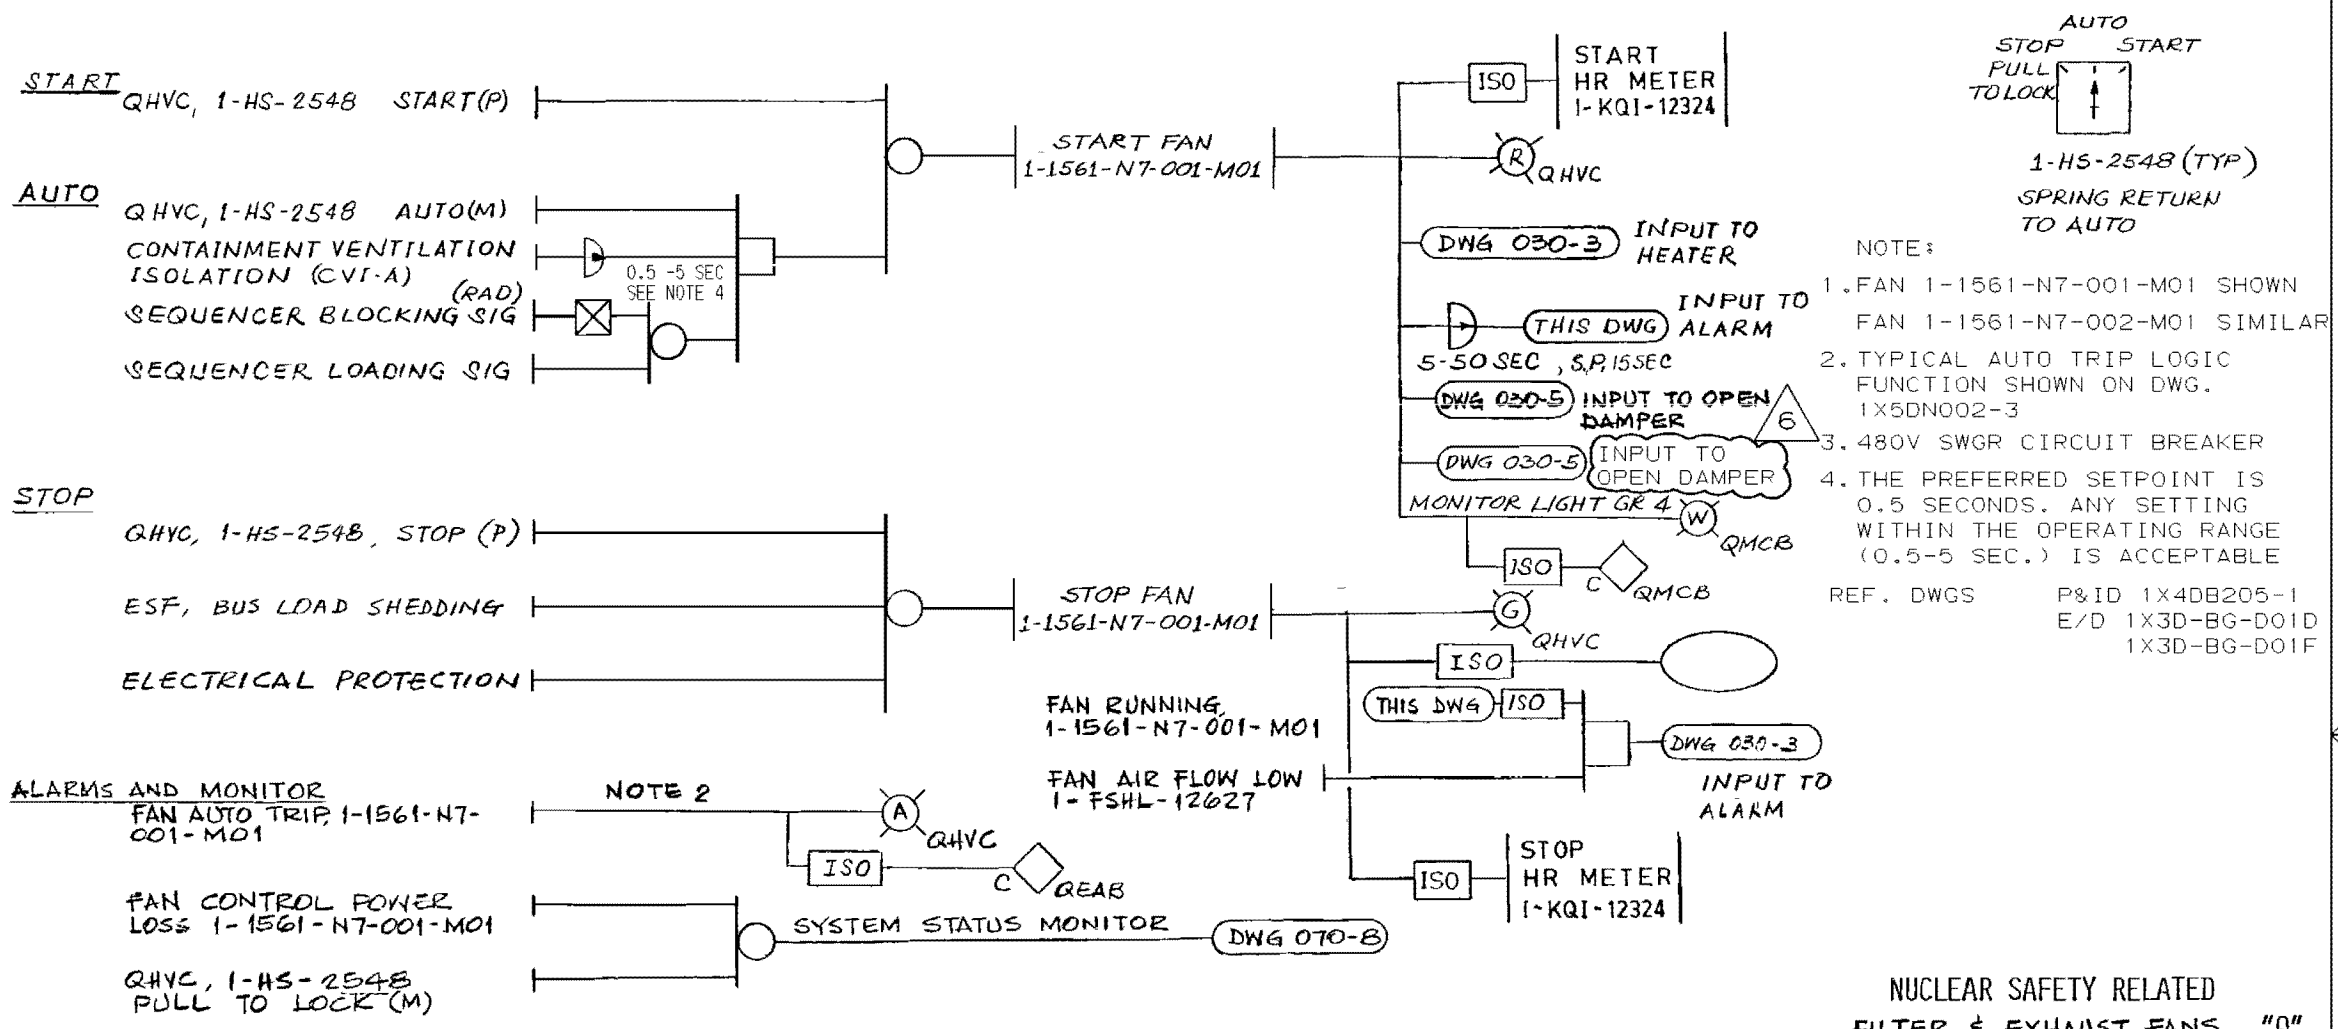

NUCLEAR SAFETY RELATED  
FILTER & EXHAUST FANS "Q"


TRAIN	FAN No	SWITCH	SFTY SIG	FLOW SW	HR METER
A	1-1561-N7-001-M01	1-HS-2548	CVI-A	1-FSHL-12627	1-KQI-12324
B	1-1561-N7-002-M01	1-HS-2548	B	1-FSHL-12627	1-KQI-12325

**SOUTHERN COMPANY SERVICES, INC.**  
BIRMINGHAM, ALABAMA  
**GEORGIA POWER COMPANY**  
ALVIN W. VOGTLE NUCLEAR PLANT


CONTROL LOGIC DIAGRAM  
PIPING PENETRATION ROOM  
FILTER AND EXHAUST UNITS

NO.	REVISIONS	DATE	DR	CHK	APPV	DTL	SCALE: NONE	DRAWING NO.	REV
△									
△									
△	INCORPORATED PER DCP 95-VAN0056	12-31-97	CD	WMW	EOG				
△	ISSUED FOR CONSTRUCTION	SEE MICROFILM FOR			SIGNATURES				
							JOB NO. 10604	1X5DN030-1	6


This drawing and the design it covers are the property of BECHTEL. They are loaned and on the borrower's express agreement that they will not be re-produced, copied, loaned, exhibited, or used except in the limited way and private use permitted by any written consent given by the lender to the borrower.

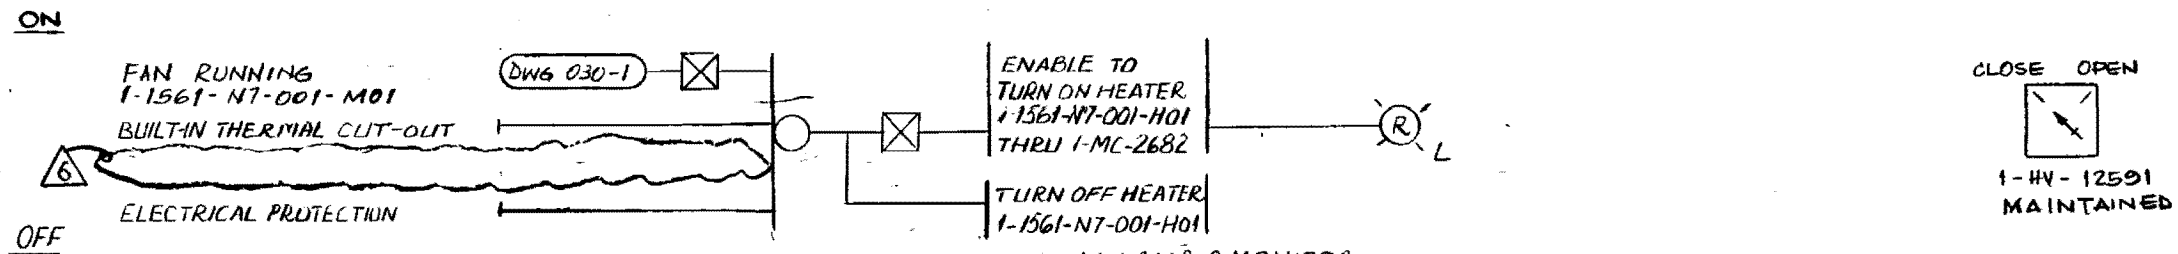

**FIRE PROTECTION**

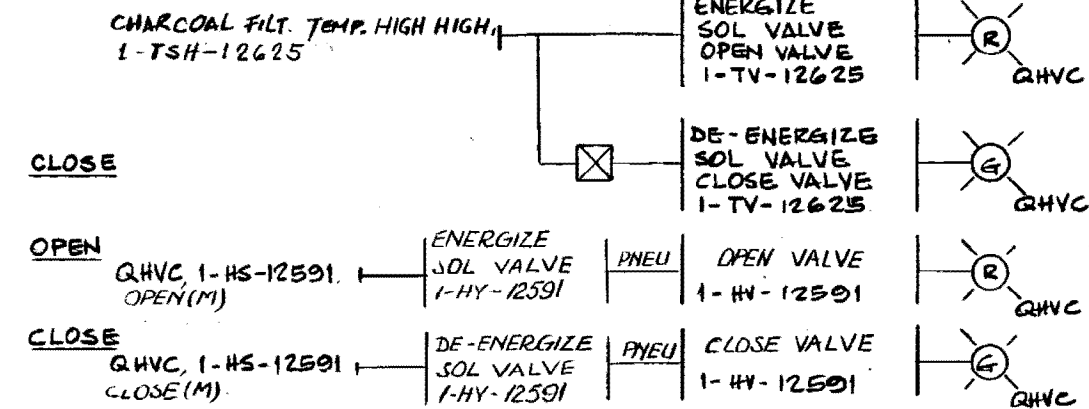

**ALARMS & MONITOR**

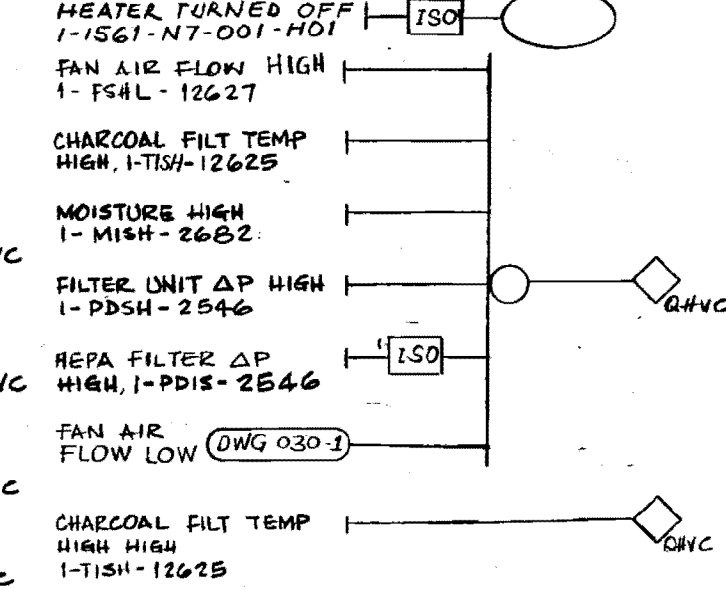

**NOTES**

1. HEATER 1-1561-N7-001-H01 SHOWN HEATER 1-1561-N7-002-H01 SIMILAR. REFER TO TABLE 2.
  2. FIRE PROTECTION WATER SYSTEM SOL VALVE 1-TV-12625 AND 1-HV-12591 SHOWN. OTHER SOLENOID VALVE LISTED IN TABLE 1 SIMILAR.
  3. HEATER SHALL TURN ON PROVIDED BUILT-IN PERMISSIVE IS SATISFIED AS SHOWN
  4. NON-IE EQUIPMENT
- REF DWGS  
P & ID 1X4DB 205-1  
E. D. 1X3D-86-DOIC, 1E, 4G, 4H

**TABLE 1**

FILT UNIT NO.	SOL VLV	TEMP SW	SOL VLV (NOTE 4)	HAND SW (NOTE 4)	MOIST SW	FLOW SW	UNIT ΔP SW	HEPA ΔP SW
1-1561-N7-001-000	1-TV-12625	1-TISH-12625	1-HV-12591	1-HS-12591	1-MISH-2682	1-FSHL-12627	1-PDSH-2546	1-PDIS-2546
002	4	4	0	0	3	8	7	7

**TABLE 2**

TRAIN	HEATER NO	FAN RUNNING	MOIST. CNTL
A	1-1561-N7-001-H01	1-1561-N7-001-M01	1-MC-2682
B	002-H01	002-M01	3

NUCLEAR SAFETY-RELATED!

ELECTRIC HEATING COIL

"Q"

**BECHTEL**  
LOS ANGELES

**GEORGIA POWER COMPANY**  
**ALVIN W. VOGTLE NUCLEAR PLANT**

**CONTROL LOGIC DIAGRAM**



**PIPING PENETRATION ROOM**  
**FILTER AND EXHAUST UNITS**

SCALE: NONE	DRAWING NO.	REV.
JOB NO. 9510	(1X5DN030-3)	6


NO.	REVISIONS	DATE	DR	CHK.	SUPV.	EGL	EGS	CHF. E.	P. E.	Q. A. E.	ENG. MGR.
1	DELETED FLOW SW. INPUT PER VIP AX44A101-400-6	2/1/87	ALV	ALG							
2	ADDED HTR LIGHT PER DGN #22 ON P&ID	5-2-85	ZEP	ALV							
3	CORRECTED TAG NO AND PRESENTATION OF HTR ACTUATION	10/16/84	ALV	N/100							
4	ISSUED FOR CONSTRUCTION	3/7/79	HE	FAL	MXK						

MND

This drawing and the design it covers are the property of BECHTEL. They are merely loaned and on the borrower's express agreement that they will not be re-produced, copied, loaned, exhibited, or used except in the limited way and private use permitted by any written consent given by the lender to the borrower.

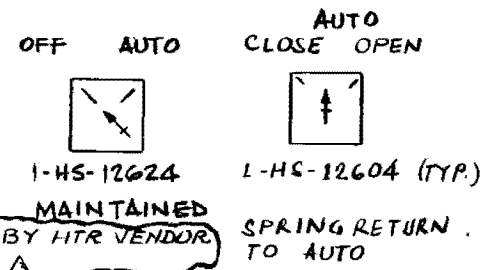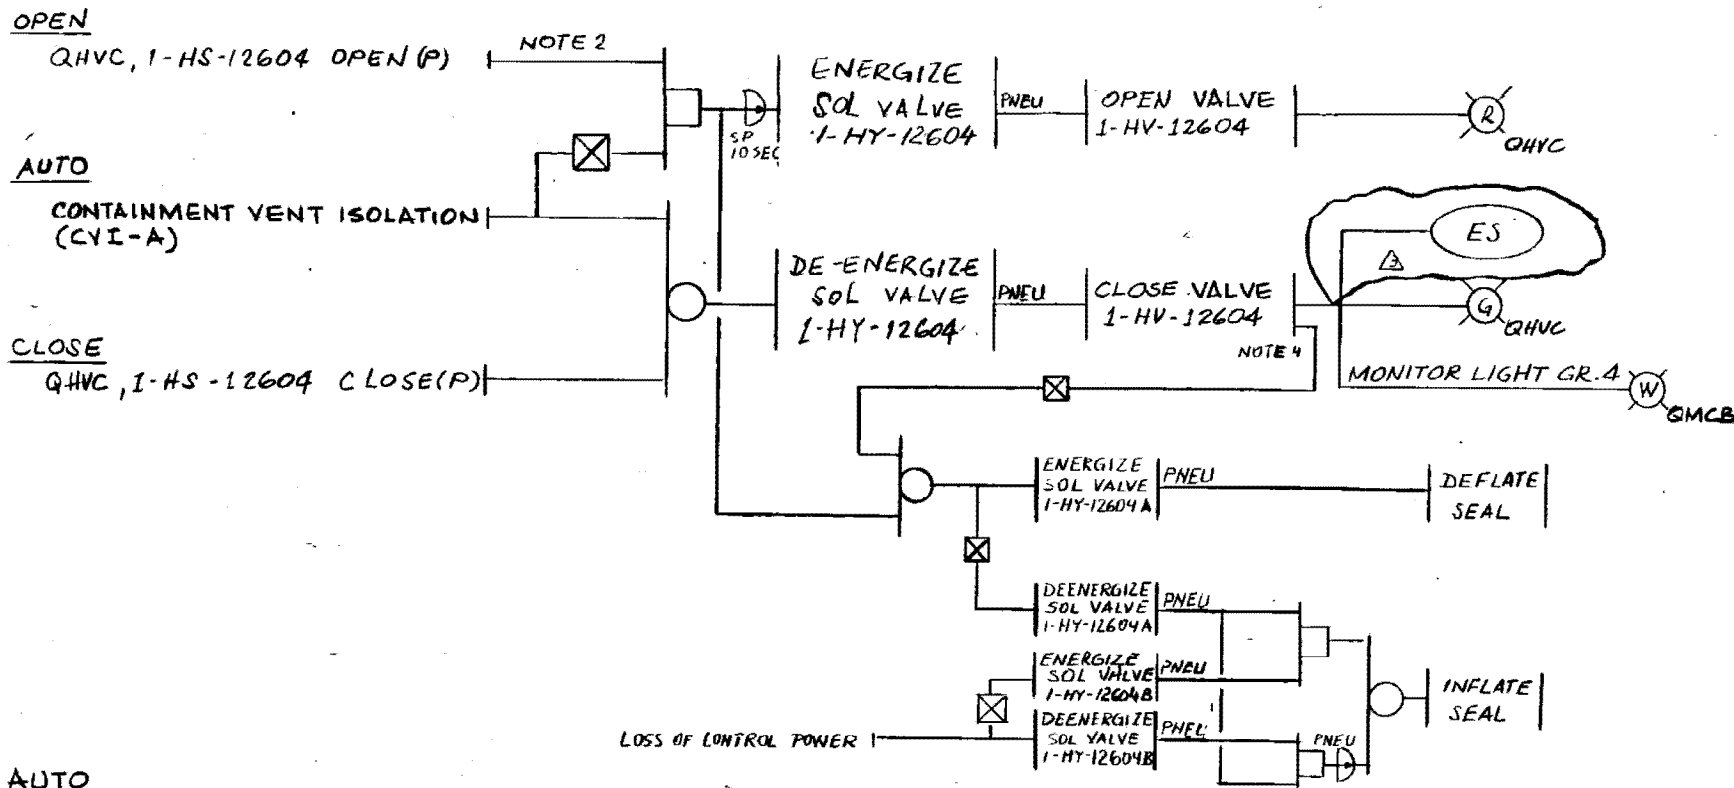

- NOTE:**
1. VALVE 1-HV-12604 SHOWN. OTHER VALVES LISTED IN TABLE 1 SIMILAR.
  2. TO OPEN VALVE, CONTROL SWITCH SHALL BE HELD ON OPEN POSITION UNTIL DAMPER IS FULLY OPEN TO ALLOW THE CIRCUIT TO SEAL IN THROUGH VALVE POSITION SWITCH.
  3. ELECTRIC INFRARED HEATER 1-1561-07-001 SHOWN. 1-1561-07-002 IS SIMILAR.
  4. POSITION SWITCH CONTACT 33ac VALVE NOT FULLY CLOSED.

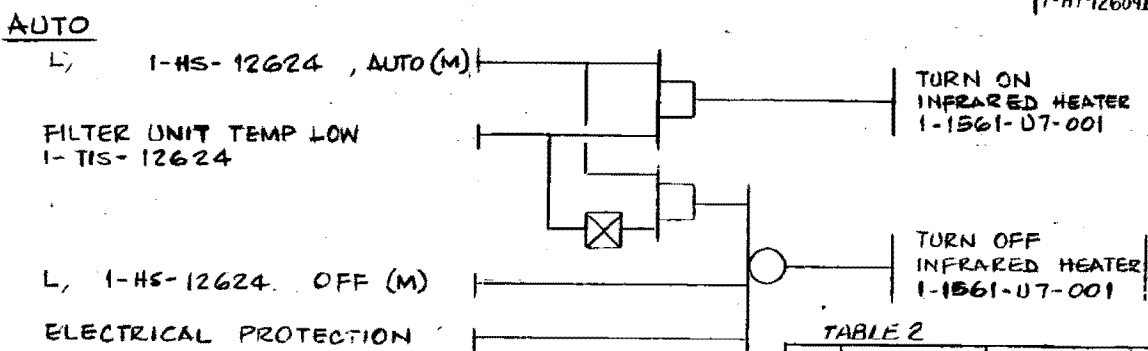

REF. DWGS.  
 P&ID 1X4DB 205-2  
 E.D. 1X3D-86-003X,Y, D04A,B

**NUCLEAR SAFETY RELATED**

ISOLATION VALVE & INFRARED HEATER

**TABLE 1**

INFRARED HEATER	HAND SW	TEMP SW
1-1561-07-001	1-HS-12624	1-TIS-12624
1-1561-07-002	↓	5

**TABLE 2**

TRN	VALVE	SOL VALVE	CNTRL SW	SAFETY SIG	SEAL CNTRL	DMPR. PROT
A	1-HV-12604	1-HY-12604	1-HS-12604	CVI-A	1-HY-12604A	1-HY-12604B
↓	5	5	5	↓	5	5
B	6	6	6	CVI-B	6	6
↓	7	7	7	↓	7	7

NO.	REVISIONS	DATE	DR	CHK	SUPV.	EGL	EGS	CHF.E.	P.L.	Q.A.E.	ENG. MGR.
3	ADDED COMPUTER INPUT PER IID LIST REV 4	10-16-84	ALU	W	M						
2	ADDED CONTROL FOR GAD BUBBLE TIGHT DAMPER PER DCN 6	5-11-84	ALU	W	M						
1	REVISED AS INDICATED	3-17-80	HL	FAL							
0	ISSUED FOR CONSTRUCTION	3-15-79	HL	FAL	MKK						

**BECHTEL**  
 LOS ANGELES

**GEORGIA POWER COMPANY**  
 ALVIN W. VOGTLE NUCLEAR PLANT

**[CONTROL LOGIC DIAGRAM]**

**PIPING PENETRATION ROOM**  
**FILTER AND EXHAUST UNITS**

SCALE: NONE      DRAWING NO.      REV.

JOB NO. 9510      [1X5DN030-4]      3

11-21-84

OPEN  
FAN RUNNING  
1-1561-N7-001-M01

CLOSE

OPEN  
FAN RUNNING  
1-1561-N7-001-M01

CLOSE

OPEN  
FAN RUNNING  
1-1561-N7-001-M01


CLOSE

MONITOR

CONTROL PWR LOSS  
1-PV-2550A

CONTROL PWR LOSS, 1-HV-12614

ALARM PIPING PENETRATION ROOM  
DIFF PRESSURE LOW  
1-PDIS-2550

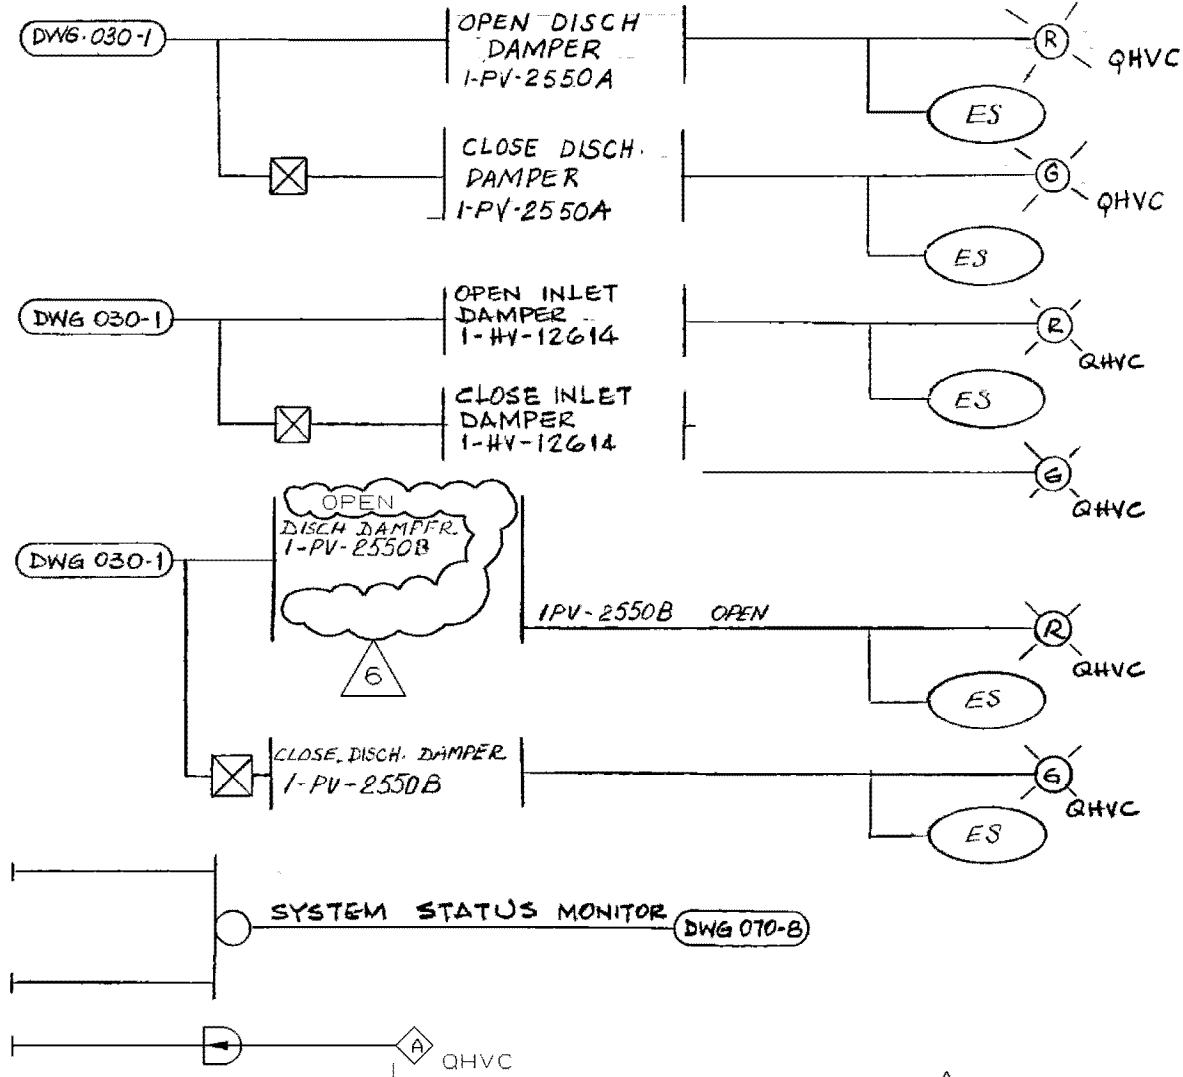

NOTE: 1 DAMPER FOR FILTER UNIT  
1-1561-N7-001-000  
SHOWN, DAMPER LISTED  
IN TABLE 1 SIMILAR.

REF. DWGS. PE1D 1X4DB205-1  
E.D. 1X3D-B4-D04J  
-D01J, D01K  
-D01L, D01M

NUCLEAR SAFETY RELATED  
FAN INLET & OUTLET DAMPERS

"Q"


TABLE 1

TRAIN	FAN RUNNING	DISCH DAMPER	DISCH. DAMPER	INLET DAMPER	FILTER UNIT	ΔP SWITCH
A	1-1561-N7-001-M01	1-PV-2550A	1-PV-2550B	1-HV-12614	1-1561-N7-001-000	1-PDIS-2550
B	002	1A	1B	6	002	1-PDIS-2551

NO.	REVISIONS	DATE	DR	CHK	APPV	DTL
△						
△						
△	INCORPORATED PER DCP 95-VAN0056	12-31-97	CD	WMW	EOG	✗
△	ISSUED FOR CONSTRUCTION	SEE MICROFILM FOR	SIGNATURES			


**SOUTHERN COMPANY SERVICES, INC.**  
BIRMINGHAM, ALABAMA  
GEORGIA POWER COMPANY  
ALVIN W. VOGTLE NUCLEAR PLANT  
CONTROL LOGIC DIAGRAM  
PIPING PENETRATION ROOM  
FILTER AND EXHAUST UNITS

SCALE: NONE	DRAWING NO.	REV
JOB NO. 10604	1X5DN030-5	6

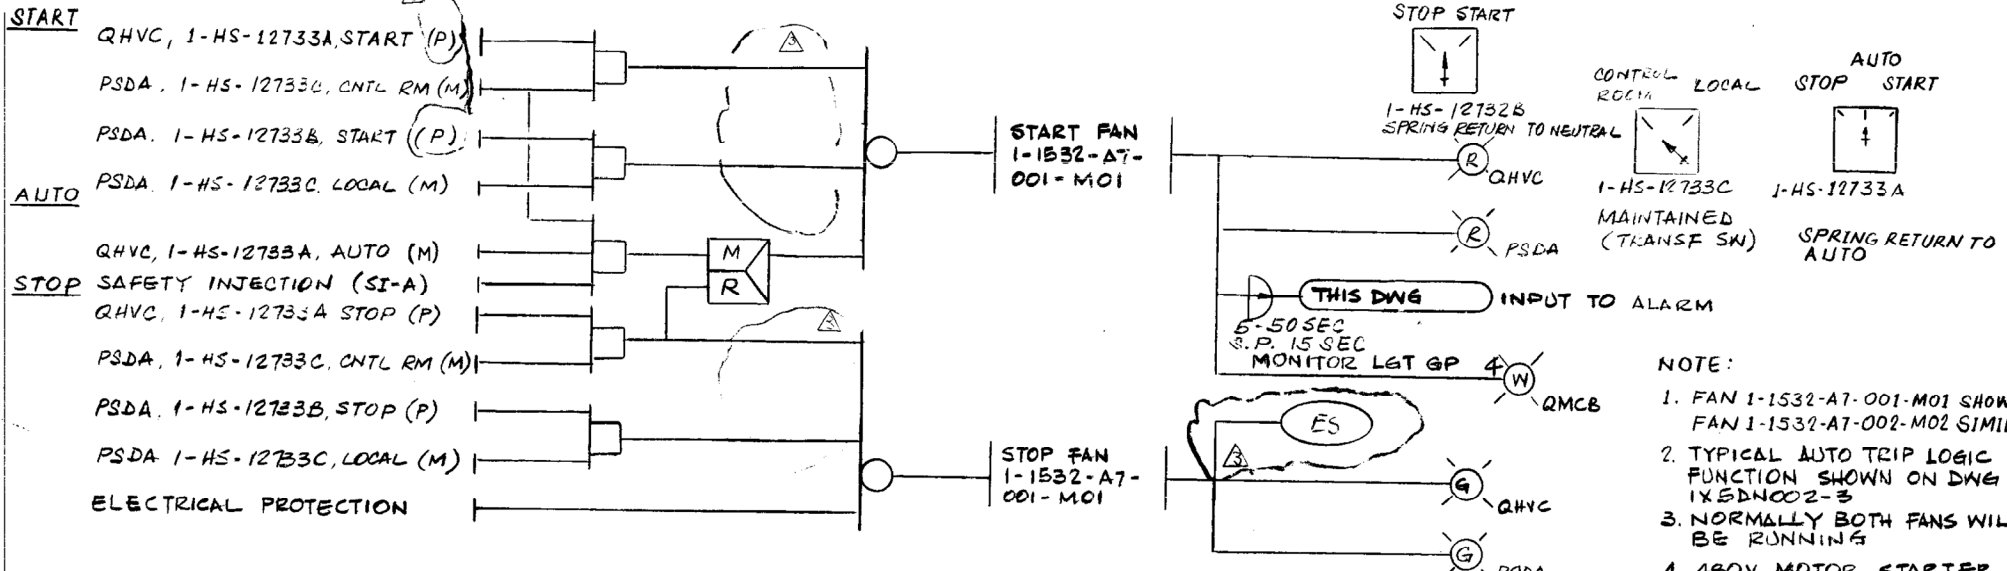

- NOTE:
1. FAN 1-1532-A7-001-M01 SHOWN FAN 1-1532-A7-002-M02 SIMILAR
  2. TYPICAL AUTO TRIP LOGIC FUNCTION SHOWN ON DWG 1X5DN002-3
  3. NORMALLY BOTH FANS WILL BE RUNNING
  4. 400V MOTOR STARTER
- REF. DWGS.  
PEID 1X4DB207-1  
E.D. 1X3D-B4-C04AEB

ALARMS & MONITORS

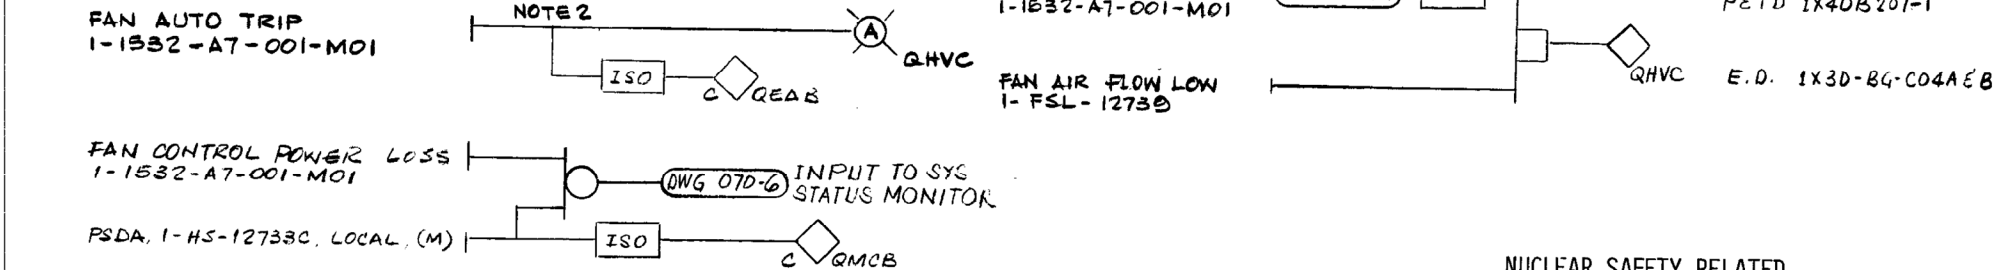

NUCLEAR SAFETY RELATED  
ELECTRICAL EQUIPMENT SUPPLY FAN "Q"

TRAIN	FAN	HAND SWITCH			FLOW SWITCH	SFTY SIG
A	1-1532-A7-001-M01	1-HS-12733A	1-HS-12733B	1-HS-12733C	1-FSL-12739	SI-A
B	002-	18A	18B	18C	24	SI-B

**BECHTEL**  
LOS ANGELES

**GEORGIA POWER COMPANY**  
ALVIN W. VOGTLE NUCLEAR PLANT

CONTROL LOGIC DIAGRAM  
CONTROL BUILDING  
SAFETY FEATURES ELECTRICAL  
EQUIPMENT ROOM HVAC

SCALE: NONE      DRAWING NO. 1X5DN044-1      REV. 3

JOB NO. 9510

NO.	REVISIONS	DATE	DR	CHK	SUPV.	EGL	EGS	CHF. E.	P. E.	Q. A. E.	ENG. MGR.
1	ADDED COMPUTER INPUT AND CLARIFIED SW ACTION	1-7-85	ALW	V/lu							
2	REVISED TO CONFORM WITH IE 80-06 BULLETIN	3-6-81	FAL	HAT							
3	REVISED AS INDICATED (COLD SHUTDOWN REQMT)	6-18-80	HL	FAL							
4	ISSUED FOR CONSTRUCTION	12/15/79	HL	FAL	MKK						

This drawing and the design it covers are the property of BECHTEL. They are merely loaned and on the borrower's express agreement that they will not be re-produced, copied, loaned, exhibited, or used except in the limited way and private use permitted by any written consent given by the lender to the borrower.

MODULATE

SAFETY INJECTION (SI-A)

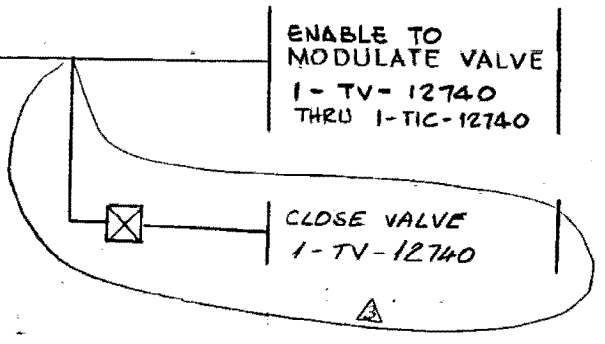


TABLE 1

VALVE	SFTY SIG.	TEMP CNTL
1-TV-12740	SI - A	1-TIC-12740
↓ 725	↓ B	↓ 725

NOTES:

1. VALVE 1-TV-12740 SHOWN OTHER VALVES LISTED IN TABLE 1 (SIMILAR AS TABULATED)

REF. DWGS

P&ID 1X4BB207-1

VIP 1X4AJ20-356,357

NUCLEAR SAFETY RELATED

ESF CHILLED WATER VALVE

<b>BECHTEL</b> LOS ANGELES		
GEORGIA POWER COMPANY ALVIN W. VOGTLE NUCLEAR PLANT		
CONTROL LOGIC DIAGRAM CONTROL BUILDING SAFETY FEATURES ELECTRICAL EQUIPMENT ROOM HVAC		
SCALE: NONE	DRAWING NO.	REV.
JOB NO. 9510	1X5DN044-2	3

SCANNED DATE: SEP 14 1991

NO.	REVISIONS	DATE	DR	CHK	SUPV.	EGL	EGS	CHF. E.	P. E.	Q. A. E.	ENG. MGR.
1	ADDED VALVE CLOSING SIGN AND REF DWGS	6-25-84	ALV	WJW							
2	REVISED REF. DWGS.	12-8-81	AD	FAL							
3	REVISED AS INDICATED.	3-12-80	HL	FAL							
4	ISSUED FOR CONSTRUCTION	5-31-79	AL	FAL	MKK						

P&ID 207-1 REV. 3

SIZE B 11x17

SCH 9-14-91

1-12-94


This drawing and the design it covers are the property of BECHTEL. They are merely loaned and on the borrower's express agreement that they will not be reproduced, copied, loaned, exhibited, or used except in the limited way and private use permitted by any written consent given by the lender to the borrower.

**START**  
 QHVC, 1-HS-12742A START (P)  
 PSDA, 1-HS-12742C CNTL RM (M)  
 PSDA, 1-HS-12742B START (P)  
 PSDA, 1-HS-12742C LOCAL (M)

**AUTO**  
 QHVC, 1-HS-12742A, AUTO (M)

**STOP**  
 SAFETY INJECTION (SI-A)  
 QHVC, 1-HS-12742A STOP (P)  
 PSDA, 1-HS-12742C CNTL RM (M)  
 PSDA, 1-HS-12742B STOP (P)  
 PSDA, 1-HS-12742C LOCAL (M)  
 ELECTRICAL PROTECTION

**ALARMS & MONITORS**

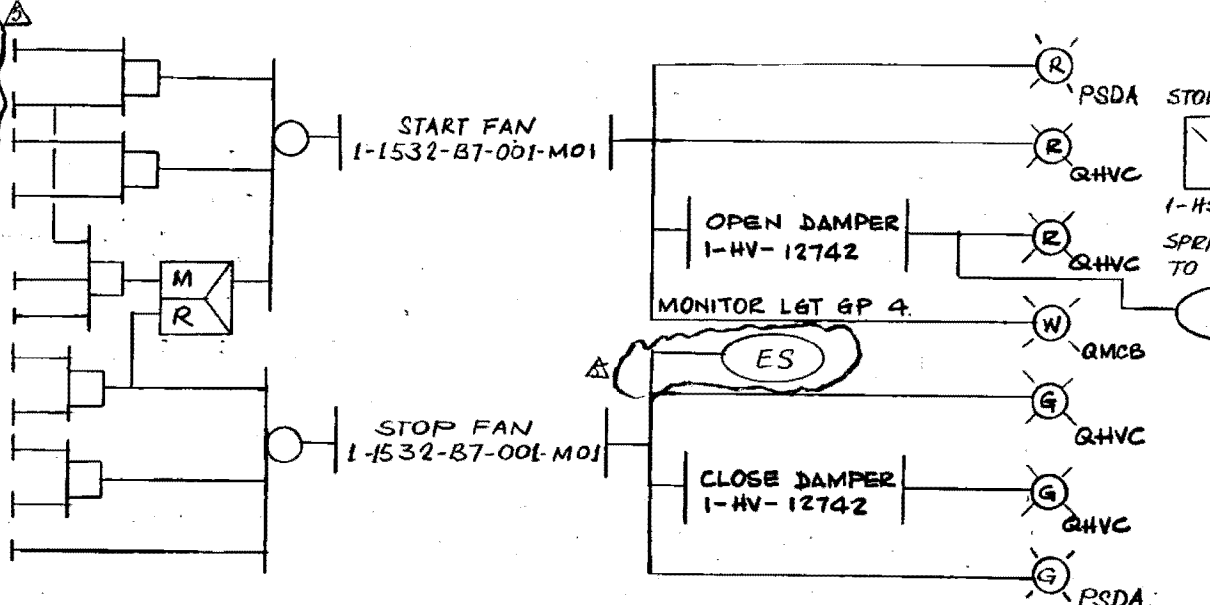

- NOTE:**
1. FAN I-1532-B7-001-M01 SHOWN OTHER FAN LISTED IN TABLE 1 ARE SIMILAR AS TABULATED.
  2. DAMPERS SHALL FAIL AS IS
  3. TYPICAL AUTO TRIP LOGIC FUNCTION SHOWN ON DWG 1X5DN002-3.
  4. 480V MOTOR STARTER.

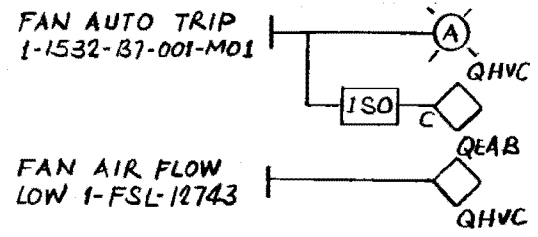
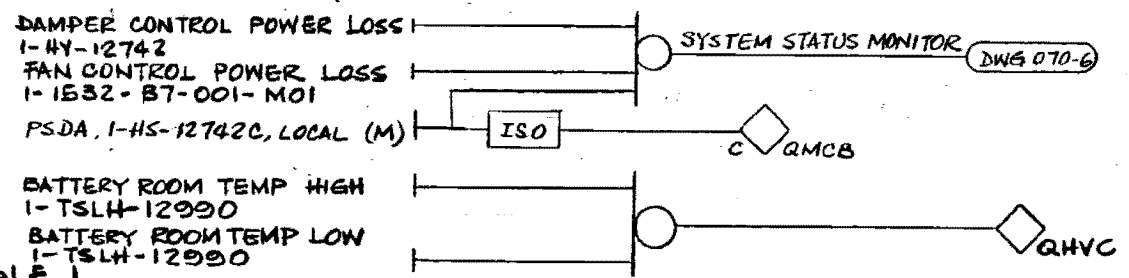


TABLE 1

TRAIN	EQUIP. TAG NOS.	HAND SWITCH	FLOW SW.	DAMPER	ROOM TEMP	HAND SWITCH		SFTY SIG
A	1-1532-B7-001-M01	1-HS-12742A	1-FSL-12743	1-HV-12742	1-TSLH-12990	1-HS-12742B	1-HS-12742C	SI-A
B	002	12727A	12728	12727	2	12727B	12727C	SI-B
A	003	12748A	12743	12748	1	12748B	12748C	SI-A
B	004	12749A	12728	12749	3	12749B	12749C	SI-B

REF. DWGS.

P.E.I.D. 1X4DB 207-1  
 E.D. 1X3D-B6-C04N, P, Q, R, S, T, U, V

NO.	REVISIONS	DATE	DR	CHK.	SUPV.	E&L	EGS	CHF. E.	P. E.	Q. A. E.	ENG. MGR.
1	REVISED REF DWGS & TAG NO	12-8-81	AV	FAL		PEZ					
2	ADDED COMPUTER INPUT AND CLARIFY SW ACTION	1-7-85	ALW	WJW							
3	CORRECTED NOTE 2 PER P.E.I.D. REV 7. ADDED COMP INPUT	6-25-84	ALV	WJW							
4	ISSUED FOR CONSTRUCTION	12/15/78	HL	FAL	MKK						

P.E.I.D. 207-1 REV 9

NUCLEAR SAFETY RELATED

SEP 1, 1981

**BECHTEL**  
 LOS ANGELES

**GEORGIA POWER COMPANY**  
**ALVIN W. VOGTLE NUCLEAR PLANT**

CONTROL LOGIC DIAGRAM  
 CONTROL BUILDING  
 SAFETY FEATURES BATTERY  
 ROOM EXHAUST FAN

SCALE: NONE

JOB NO. 9510


DRAWING NO. 1X5DN045-1

REV. 5

SIZE B 11x17



SLIT 9-14-91

This drawing and the design it covers are the property of BECHTEL. They are loaned and on the borrower's express agreement that they will not be re-produced, copied, loaned, exhibited, or used except in the limited way and private use permitted by any written consent given by the lender to the borrower.

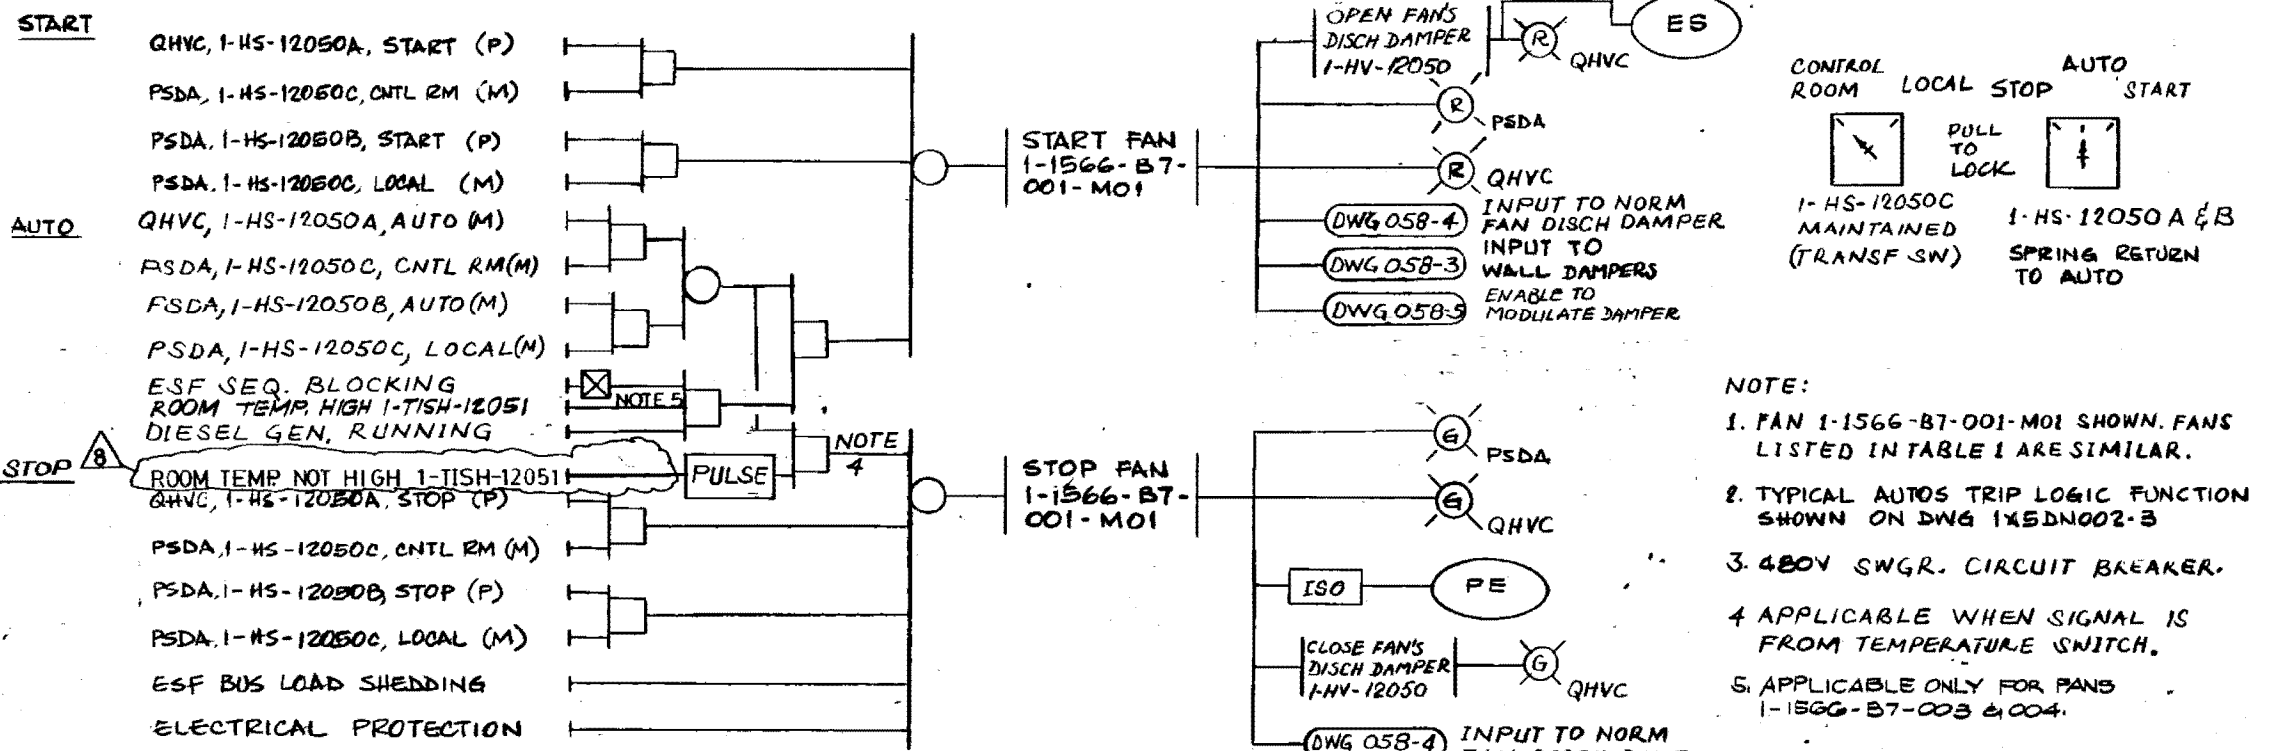

- NOTE:**
- FAN 1-1566-B7-001-M01 SHOWN. FANS LISTED IN TABLE 1 ARE SIMILAR.
  - TYPICAL AUTOS TRIP LOGIC FUNCTION SHOWN ON DWG 1X5DN002-B
  - 480V SWGR. CIRCUIT BREAKER.
  - APPLICABLE WHEN SIGNAL IS FROM TEMPERATURE SWITCH.
  - APPLICABLE ONLY FOR FANS 1-1566-B7-003 & 004.

**ALARMS**

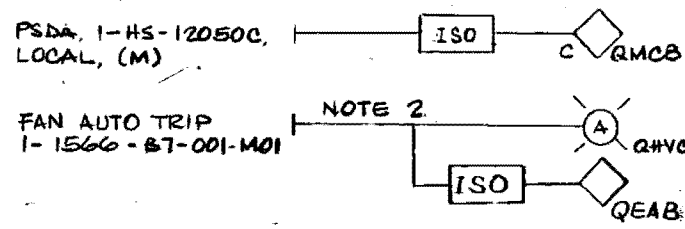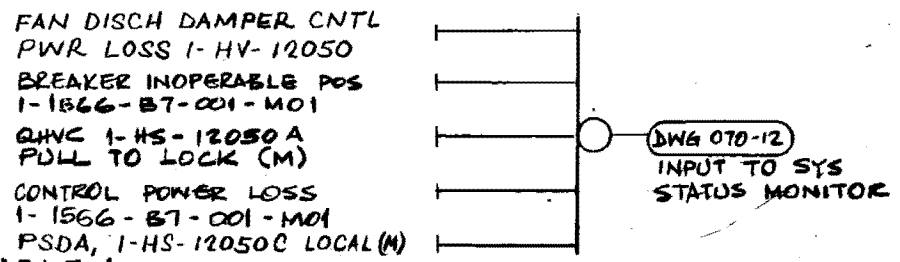

**TABLE 1**

TRAIN	FAN	HAND SW	HAND SW	TEMP SW	ESF SEQ	DISCH DAMPER
A	1-1566-B7-001-M01	1-HS-12050A	1-HS-12050B		TRAIN A	1-HV-12050
	003	1A	1	1-TISH-12051	A	51
B	002	3A	3		B	53
	004	4A	4	1-TISH-12054	B	54

**BECHTEL**  
LOS ANGELES

**GEORGIA POWER COMPANY**  
ALVIN W. VOGTLE NUCLEAR PLANT

CONTROL LOGIC DIAGRAM  
DIESEL GENERATOR BUILDING  
HVAC SYSTEM

SCALE: NONE

DRAWING NO. 1X5DN058-1

REV. 8

JOB NO. 9510

INCORP. ABN-01296	12/4/90	W.V.G.	RLW	CLQ	33							ENG. MGR.
REVISIONS	DATE	DR	CHK	RE	DM	DM	DM	PDM				
ISSUED FOR CONSTRUCTION	4/10/79	HL	FAL	MKK								DATE
REVISIONS	DATE	DR	CHK	SUPV.	EGL	EGS	CHF. E.	P. E.	Q. A. E.			

BM 9510  
PEID REV.

SCANNED DATE: 11/19/91

SIZE B 11x17



This drawing and the design it covers are the property of BECHTEL. They are loaned and on the borrower's express agreement that they will not be reproduced, copied, loaned, exhibited, or used except in the limited way and private use permitted by any written consent given by the lender to the borrower.

OPEN

FAN RUNNING, 1-1566-B7-001-M01 (DWG 058-1)

FAN RUNNING, 1-1566-B7-003-M01 (DWG 058-1)

NORMAL FAN AIR FLOW HIGH  
1-FS-12087

CLOSE

DE-ENERG. SOL. VALVE  
1-TY-12096

DE-ENERG. SOL. VALVE  
1-TY-12086

ENERGIZE SOL. VALVE  
1-TY-12096

ENERGIZE SOL. VALVE  
1-TY-12086

OPEN WALL DAMPER  
1-TV-12097

OPEN WALL DAMPER  
1-TV-12097A

OPEN WALL DAMPER  
1-TV-12096

OPEN WALL DAMPER  
1-TV-12096A

OPEN WALL DAMPER  
1-TV-12086

OPEN WALL DAMPER  
1-TV-12086A

CLOSE WALL DAMPER  
1-TV-12097

CLOSE WALL DAMPER  
1-TV-12097A

CLOSE WALL DAMPER  
1-TV-12096

CLOSE WALL DAMPER  
1-TV-12096A

CLOSE WALL DAMPER  
1-TV-12086

CLOSE WALL DAMPER  
1-TV-12086A

NOTE:

1. WALL DAMPER FOR TRAIN A AS SHOWN. TRAIN B SHALL BE SIMILAR AS TABULATED IN TABLE 1

REF. DWG.

P & ID 1X4DB217

E. D. 1X3D-B4-F01H, J

TABLE 1

SERVICE	TRAIN	SOL VALVE	WALL DAMPER	FAN RUNNING SIGNAL	FLOW SW
WALL DAMPER, 1-TV-12097	A	1-TY-12096	1-TV-12096	1-1566-B7-001-M01	1-FS-12087
1-TV-12096			1-TV-12096A		
1-TV-12086	B	12086	1-TV-12086	1-1566-B7-003-M01	1-FS-12088
1-TV-12098			1-TV-12086A		
1-TV-12085			1-TV-12086		
1-TV-12099			1-TV-12086A		

NUCLEAR SAFETY RELATED

WALL DAMPERS

<b>BECHTEL</b> LOS ANGELES		
GEORGIA POWER COMPANY ALVIN W. VOGTLE NUCLEAR PLANT		
CONTROL LOGIC DIAGRAM DIESEL GENERATOR BUILDING		
HVAC SYSTEM		
SCALE: NONE	DRAWING NO.	REV.
JOB NO. 9510	1X5DN058-3	4

3	CHANGED DAMPER TO PNEUMATIC FROM MOTOR OPERATED	7-14-82	AV	FAL	PCZ	04/82	1/7	ENG. MGR.		
2	REVISED TAG NO	12-9-81	AV	FAL	PCZ	04/82	1/7			
1	ADDED DOUBLE DMPR. PER DCH#10 ON PEID 1X4DB217 & AS SHOWN	2-12-85	ZEP	ALU						
0	ISSUED FOR CONSTRUCTION	4-27-79	HL	FAL	MKK					
NO.	REVISIONS	DATE	DR	CHK.	SUPV.	EGL	EGS	CHF. E.	P. E.	Q. A. E.

THIS DRAWING AND THE DESIGN IT CONVEYS ARE THE PROPERTY OF SCS. THEY ARE HEREBY LOANED AND ON THE BORROWER'S EXPRESS AGREEMENT THAT THEY WILL NOT BE REPRODUCED, COPIED, EMITTED, OR USED EXCEPT IN THE LIMITED WAY AND PRIVATE USE PERMITTED BY ANY WRITTEN CONSENT GIVEN BY THE LENDER TO THE BORROWER.

**START**

**AUTO**

**STOP**

**ALARM**

QHVC, 1-4S-12052, START (M)

QHVC, 1-4S-12052, AUTO (M)

D.G. ROOM TEMP HIGH  
1-TISHL12052

OPEN DISCH. DAMPER  
1ZS012052A

QHVC, 1-4S-12052, STOP (M)

ELECTRICAL PROTECTION

D.G. BLDG. TRN. A TEMP HI-HI  
1-TISHL-12036

D.G. BLDG. TRN. A TEMP LOW  
1-TISHL-12056

D.G. BI DG. RM. TRN A TEMP HI-HI  
1-TISHL-12056A

NOTE 4

E

OPEN

FAN STOPPED  
1-1566-B7-001-MOI

FAN STOPPED  
1-1566-B7-003-MOI

CLOSE

FAN RUNNING  
1-1566-B7-001-MOI

FAN RUNNING  
1-1566-B7-003-MOI

START FAN  
1-1566-B7-003-MOI

STOP FAN  
1-1566-B7-005-MOI

FAN STOPPED  
1-1566-B7-001-MOI

TABLE 2

FAN	DAMPERS
1-1566-B7-001-MOI	1-HV-12054 (TRAIN A)
1-1566-B7-003-MOI	1-HV-12055 (TRAIN B)
1-1566-B7-002-MOI	1-HV-12055 (TRAIN B)
1-1566-B7-004-MOI	

TABLE 1

FAN	CNTL SW	TEMP SW	LIMIT SWITCH	TEMP SW
1-1566-B7-003-MOI	1-4S-12052	1-TISHL-12052	1ZS012052A	1-TISHL-12036
006	5	5	1ZS012055A	1-TISHL-12056

AUTO STOP START



1-HS-12052(TYP)  
MAINTAINED

THIS DWG. INPUT TO STOP FAN

THIS DWG. 1

THIS DWG. 1  
INPUT TO STOP FAN

**NOTE:**

- FAN 1-1500-B7-005-MOI SHOWN FOR DIESEL GENERATOR BLDG. TRAIN A, FAN 1-1566-B7-006-MOI SIMILAR FOR DIESEL GENERATOR BUILDING TRAIN B.
- 480V MOTOR STARTER.
- NORMAL EXHAUST FAN DISCHARGE DAMPER 1-HV-12052 SHOWN OTHER DISCHARGE DAMPER LISTED IN TABLE 2 SIMILAR EXCEPT AS TABULATED.
- THE "LOW" SETPOINT SWITCH IS SPARE.

REF DWG  
P & I D 1X4DB217  
E.D 1X3D-BG-F01D,P,Q

NUCLEAR SAFETY RELATED

NORMAL VENTILATION "Q"

SOUTHERN COMPANY SERVICES, INC  
BIRMINGHAM, ALABAMA


GEORGIA POWER COMPANY  
ALVIN W. VOGTLE NUCLEAR PLANT

**CONTROL LOGIC DIAGRAM  
DIESEL GENERATION BUILDING  
HVAC SYSTEM**


SCALE: NONE	DRAWING NO.	REV
JOB NO. 10604	1X5DN058-4	9

SIZE B 11x17

This drawing and the design it covers are the property of BECHTEL. They are loaned and on the borrower's express agreement that they will not be reproduced, copied, loaned, exhibited, or used except in the limited way and for the limited purpose intended by the lender to the borrower.

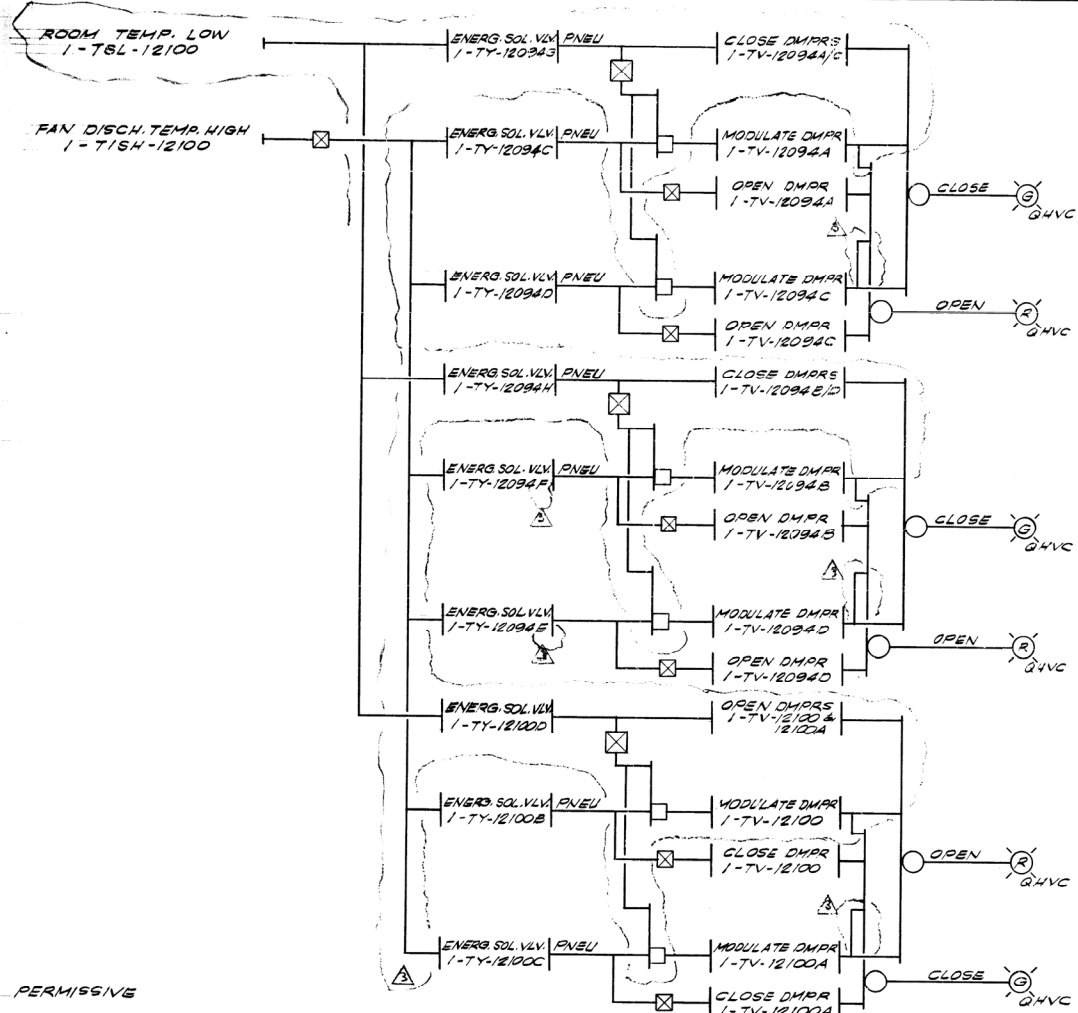

**NOTE:**  
 1. DAMPERS 1-TV-12094 & 1-TV-12100, SHOWN. OTHER DAMPERS LISTED IN TABLE 1 SIMILAR.  
 2. TEMP. SWITCHES 1TSL-12100, 1TSL-12101 AND SOL. VALVES 1TY-12094, H & 1TY-12100D ARE POWERED FROM NON 1-E SOURCE.

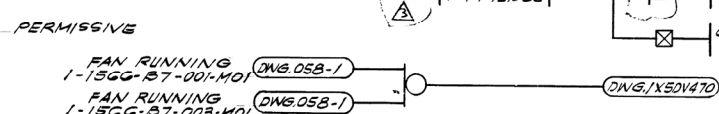

REF. DWGS.:  
 P & I.D. 1X408217  
 E.D. 1X30-BG-FOIK.L

**OUTSIDE AIR AND RECIRCULATION DAMPERS**

NUCLEAR SAFETY RELATED "Q"

**TABLE 1**

TRAIN	FAN	TEMP. CONTROLLER	LOOP DNG	WALL DAMPER	RECIRC. DAMPER	WALL DAMPER TEMP SOL. VLV.	RECIRC. DAMPER TEMP SOL. VLV.	TEMP. SW.
A	1-15GG-87-001-M01 1-15GG-87-003-M01	1-TIC-12100	1XSDV47D	1-TV-12094A,C 1-TV-12094B,D	1-TV-12100 1-TV-12100A	1-TY-12094C -12094F -12094G	1-TV-12094D -12094E -12094H	1-T15H-12100 1-TSL-12100
B	1-15GG-87-002-M01 1-15GG-87-004-M01	1-TIC-12101	1XSDV47I	1-TV-12095A,C 1-TV-12095B,D	1-TV-12101 1-TV-12101A	1-12095C -12095F -12095G	1-12095D -12095E -12095H	1-T15H-12101 1-TSL-12101

NO.	REVISIONS	DATE	DR	CHK	SUPV.	EGL	EGS	CHF. E.	P. E.	Q. A. E.	ENG. MGR.
	RE-DRAWN PER COP B1022GM, DCN #1	8-26-86	SEP	ALU							
	ISSUED FOR CONSTRUCTION	7-14-86									

**BECHTEL**  
 LOS ANGELES



**GEORGIA POWER COMPANY**  
**ALVIN W. VOGTLE NUCLEAR PLANT**

CONTROL LOGIC DIAGRAM  
 DIESEL GENERATOR BUILDING  
 HVAC SYSTEM




SCALE: NONE      DRAWING NO. 1XSDN058-5      REV. 3

JOB NO. 9510      SIZE C 17X22

This drawing and the design it covers are the property of BECHTEL. They are produced, copied, loaned, exhibited, or used except in the limited way and private use permitted by any written consent given by the lender to the borrower.

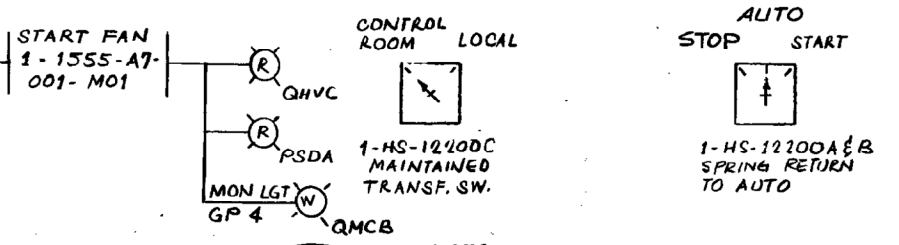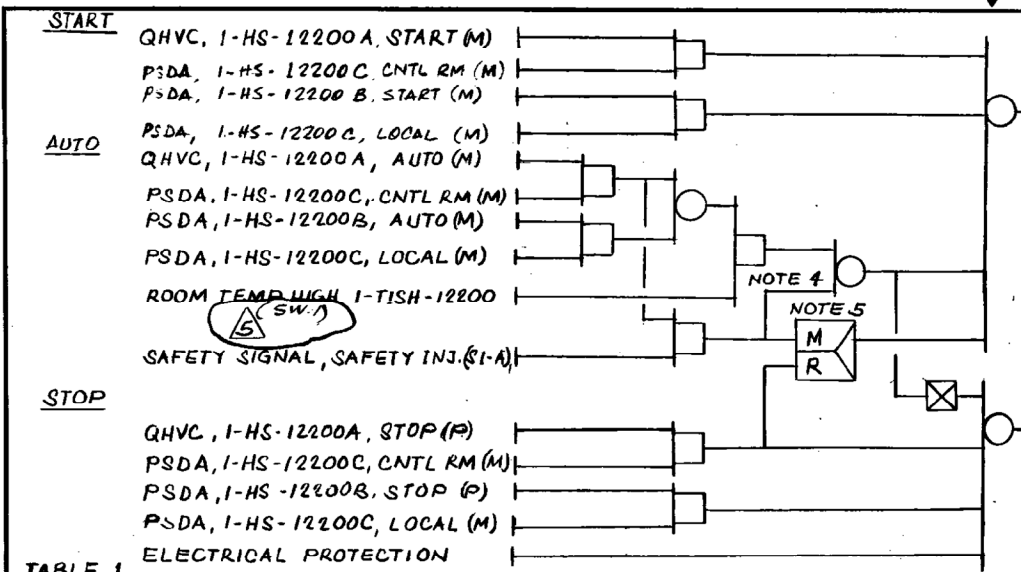

**NOTE:**  
 1. UNLESS OTHERWISE INDICATED, FAN 1-1555-A7-001-M01 IS AS SHOWN, OTHER FANS LISTED IN TABLE 1 ARE SIMILAR. EXCEPT AS TABULATED  
 2. TYPICAL AUTO TRIP LOGIC FUNCTION SHOWN ON DWG 1X5DN002-3  
 3. 480V MOTOR STARTER

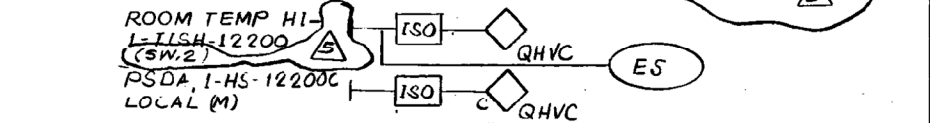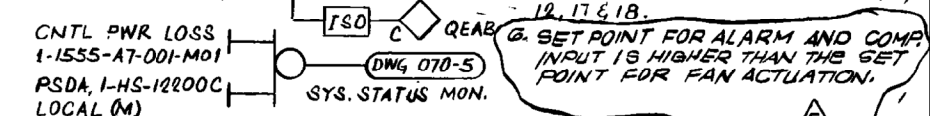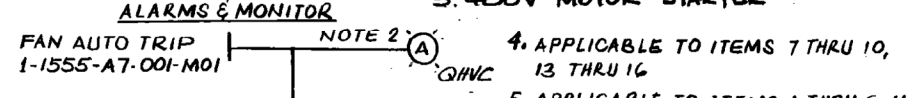

**REF DWGS**  
 P & ID 1X4DB 22B  
 E. D 1X3D-BG-DOSA, B, C, D, E, F, G, H, J, K, N, P, Q, R, S, T, U, V

**NUCLEAR SAFETY RELATED**  
**COOLER FANS**

**TABLE 1**

ITEM	LOCATION	TEMP SW	TRAIN	FAN 1-1555-A7	HAND SWITCHES	SAFETY SIGNAL
1		1-TISH-12200	A	001-M01	1-HS-12200A, B & C	SI-A
2		-12201	B	002-	-12201A, B & C	B
3	ELELT SWGR & MCC RM	-12202	A	003-	-12202A, B & C	A
4		-12203	B	004-	-12203A, B & C	B
5		-12204	A	005-	-12204A, B & C	A
6		-12205	B	006-	-12205A, B & C	B
7	RHR PUMP ROOM	1-TISH-12206	A	007-	-12206A, B & C	1-1205-P6-001
8		-12212	B	008-	-12212A, B & C	-002
9	CNMT SPRAY PUMP ROOM	1-TISH-12207	A	009-	-12207A	1-1206-P6-001
10		-12213	B	010-	-12213A	-002
11	CCW PUMP ROOM	-12208	A	011-	-12208A, B & C	SI-A
12		-12214	B	012-	-12214A, B & C	B
13	CHARG PUMP ROOM	1-TISH-12209	A	013-	-12209A, B & C	1-1208-P6-002
14		1-TISH-12215	B	014-	-12215A, B & C	-003
15	SI PUMP ROOM	-12210	A	015-	-12210A	1-1204-P6-003
16		-12216	B	016-	-12216A	-004
17	SFP HE & PUMP ROOM	1-TISH-12211	A	017-	-12211A	SI-A
18		1-TISH-12217	B	018-	-12217A	B

NO.	REVISIONS	DATE	DR	CHK	EGL	EGS	CHF. E	PHE	Q. A. E.	ENG. MGR.
1	ADDED COMPUTER INPUT PER 110 LIST REV. 4	10-16-84	ALV	J. J. M.						
2	REVISED AS SHOWN & ADDED NOTE G	2-22-85	ZEP	ALV						
3	CORRECTED TAG NOS PER DCN 9	1-17-85	ALV	W. J. M.						
4	ISSUED FOR CONSTRUCTION	1-12-84	HL	FAL	MKK					

**BECHTEL**  
 LOS ANGELES

**GEORGIA POWER COMPANY**  
 ALVIN W. VOGTLE NUCLEAR PLANT

**CONTROL LOGIC DIAGRAM**  
 SAFETY FEATURE ROOM COOLERS

SCALE: NONE

DRAWING NO. 1X5DN065-1

REV. 1


JOB NO. 9510

DATE

BM 9510 P&ID REV. 6

SIZE B 11x17

This drawing and the design it covers are the property of BECHTEL. They are loaned and on the borrower's express agreement that they will not be re-produced, copied, altered, modified, substituted, or used except in the limited way and private use permitted by any written consent given by the lender to the borrower.

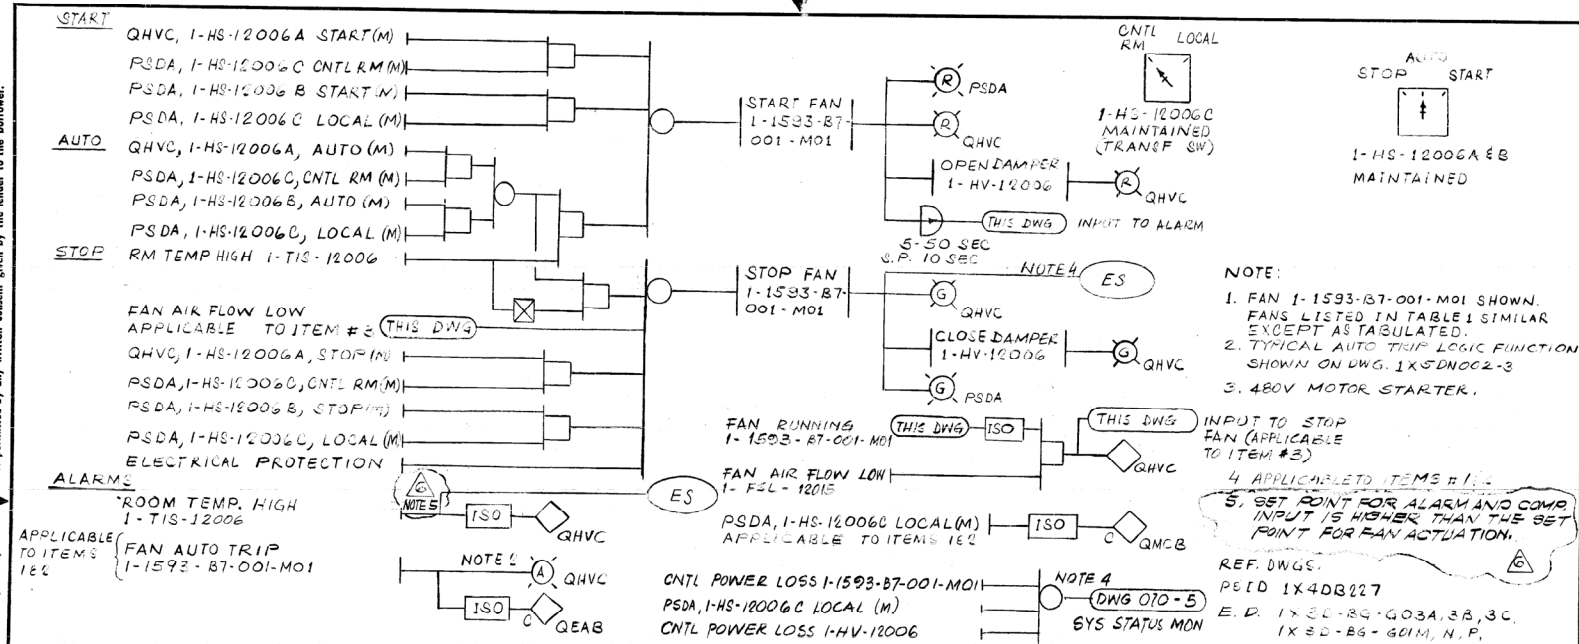

NOTE:

- FAN 1-1593-B7-001-M01 SHOWN. FANS LISTED IN TABLE 1 SIMILAR EXCEPT AS TABULATED.
- TYPICAL AUTO TRIP LOGIC FUNCTION SHOWN ON DWG. 1X5DNOG2-3
- 480V MOTOR STARTER.

REF. DWGS.  
 PSID 1X4DB227  
 E. D. 1X3D-B6-G03A,3B,3C.  
 1X3D-B6-G01M, N.P.

TABLE 1

ITEM	TRAIN	FAN NO.	HAND SW.	TEMP SW.	DAMPER	FLOW SW.	HAND SW.
1	A	1-1593-B7-001-M01	1-HS-12006A	1-TIS-12006	1-HV-12006	1-FSL-12015	1-HS-12006 B50
2	B	002-M01	12005A	12005	12005	12014	1-HS-12006 B50
3	-	003-M01	12004	12004	12004	12016	-

NO.	REVISIONS	DATE	DR	CHK.	SUPV.	EGL	EGS	CHF. E.	P.E.	Q.A.E.
1	ADDED NOTE 5	2-8-85	REP	ALV						
2	REVISED AS SHOWN	10-16-84	ALV							ENG. MGR.
3	ADDED COMPUTER IMPACT PER 1/0 LIST REV. 4	9-10-84	ALV							
4	ISSUED FOR CONSTRUCTION	5-3-79	NBP	FAL	MKK					

NUCLEAR SAFETY RELATED  
 VENTILATION FANS "Q"

**BECHTEL**  
 LOS ANGELES

**GEORGIA POWER COMPANY**  
 ALVIN W. VOGTLE NUCLEAR PLANT

CONTROL LOGIC DIAGRAM  
 AUXILIARY FEEDWATER PUMPHOUSE  
 HEATING AND VENTILATION


SCALE: NONE      DRAWING NO. 1X5DNOG8-1      REV. 6

JOB NO. 9510

DATE: 2-8-85      CAMERA OPERATOR: M. Parloff      SECTION SUPERVISOR: M. Strauss

THIS DRAWING IS THE PROPERTY OF BECHTEL. IT IS LOANED TO YOU FOR YOUR USE ONLY. IT IS NOT TO BE REPRODUCED OR COPIED IN ANY MANNER WITHOUT THE WRITTEN CONSENT OF BECHTEL. THE REGULAR COURSE OF BUSINESS, ON THE DATE STATED BELOW AND THAT IT IS AN ACCURATE REPRODUCTION OF THE DOCUMENT SUBMITTED TO MICROGRAPHICS. DATE: 9-10-84 CAMERA OPERATOR SECTION SUPERVISOR

This drawing and the design it covers are the property of BECHTEL. They are loaned to you for your use only. It is not to be reproduced, copied, issued, exhibited, or used except in the limited way and for the limited purpose intended.

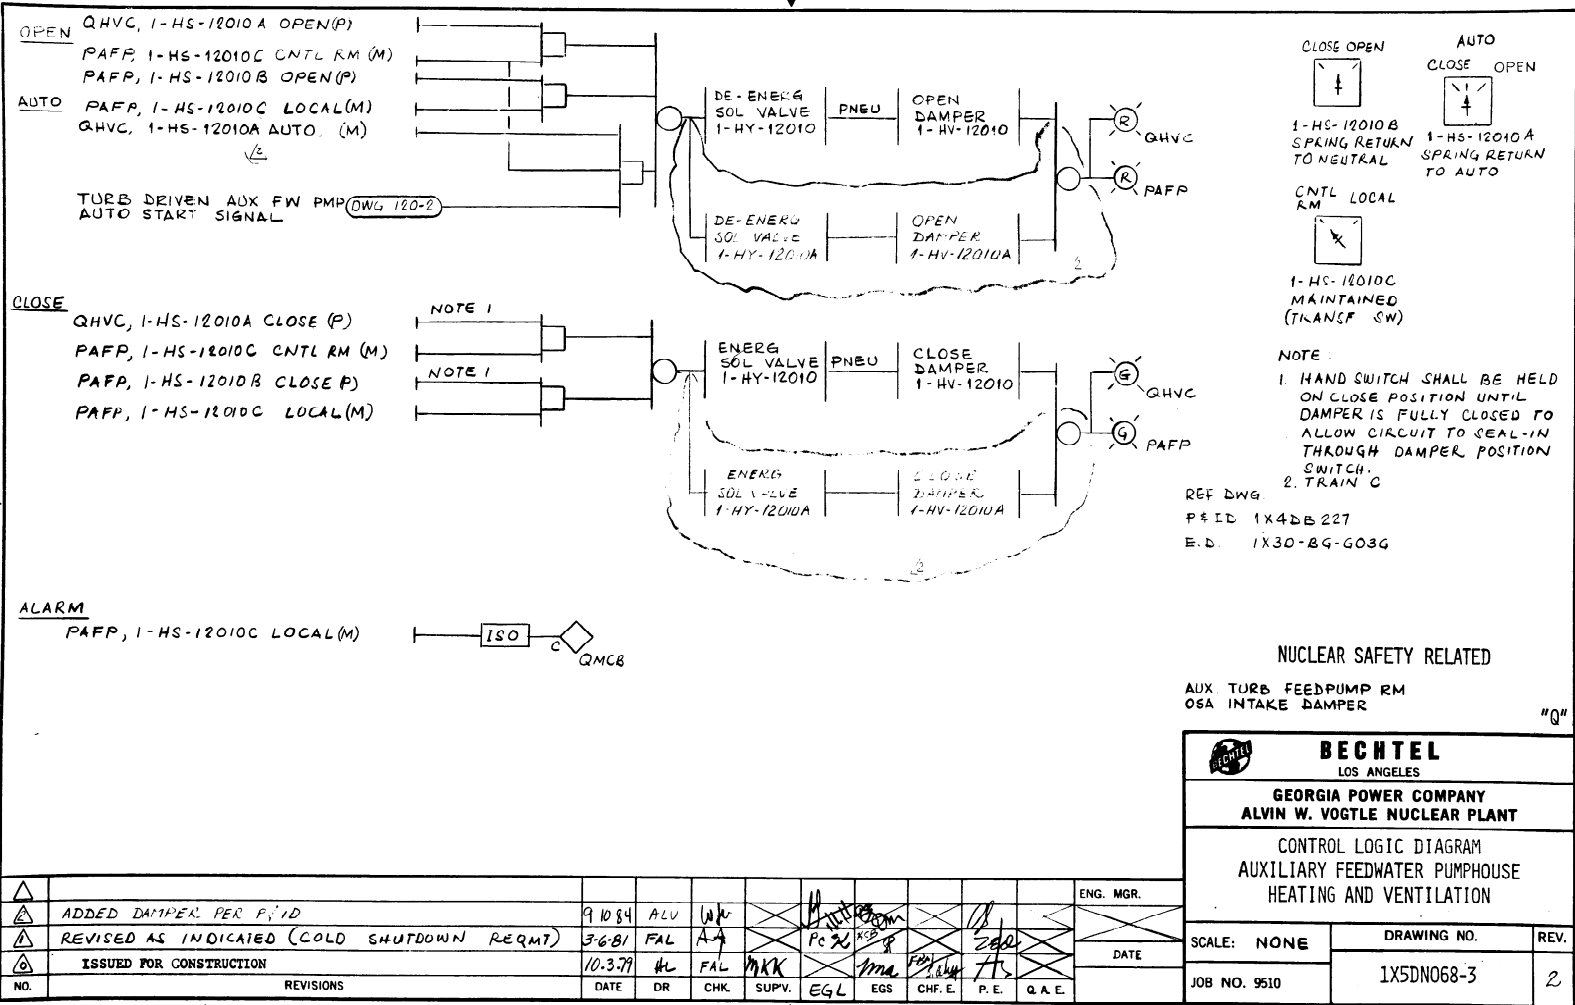

**BECHTEL**  
 LOS ANGELES  
**GEORGIA POWER COMPANY**  
**ALVIN W. VOGTLE NUCLEAR PLANT**  
 CONTROL LOGIC DIAGRAM  
 AUXILIARY FEEDWATER PUMPHOUSE  
 HEATING AND VENTILATION


SCALE: NONE  
 DRAWING NO. 1X5DN068-3  
 REV. 2

JOB NO. 9510  
 SIZE B 11x17



NO.	REVISIONS	DATE	DR	CHK	SUPV.	EG	EGS	CHF. E.	P. E.	Q. A. E.	ENG. MGR.
△	ADDED DAMPER PER P&ID	9/10/84	ALV	WPK							
△	REVISED AS INDICATED (COLD SHUTDOWN REQMT)	3/6/81	FAL	AA							
△	ISSUED FOR CONSTRUCTION	10-3-79	HL	FAL	MKK						

BM 9510 P&ID REV 4



I CERTIFY THAT THE IMAGE CONTAINED ON THIS FRAME WAS MADE IN THE NORMAL AND REGULAR COURSE OF BUSINESS, ON THE DATE STATED BELOW AND THAT IT IS AN ACCURATE REPRODUCTION OF THE DOCUMENT SUBMITTED TO MICROGRAPHICS.  
 9-10-84  
 DATE CAMERA OPERATOR SECTION SUPERVISOR

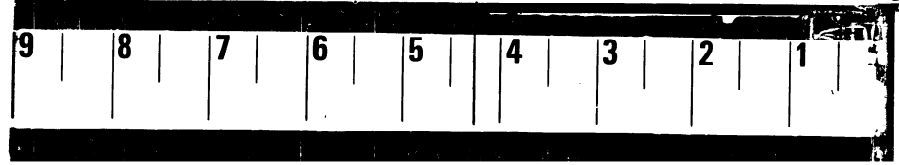

THIS DRAWING AND THE DESIGN IT COVERS ARE THE PROPERTY OF SCS. THEY ARE LOANED TO THE BORROWER'S EXPRESS AGREEMENT THAT THEY WILL NOT BE REPRODUCED, COPIED, LOANED, EXHIBITED, OR USED EXCEPT IN THE LIMITED MANNER PRIVATE USE PERMITTED BY THE LENDER TO THE BORROWER.

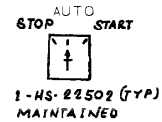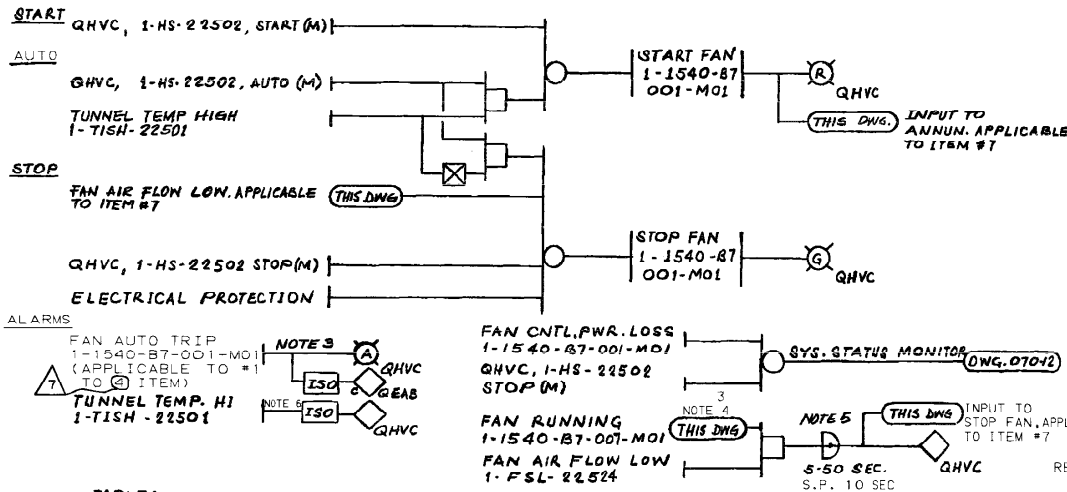

- NOTE**
1. FAN 1-1540-B7-001-M01 SHOWN OTHER FANS LISTED IN TABLE 1 ARE SIMILAR AS TABULATED.
  2. 480V MOTOR STARTER
  3. TYPICAL LOGIC FUNCTION SHOWN ON DRAWING 1X5DN002-3.
  4. FOR ITEM 6 SEE FAN RUNNING INPUT ON DWG. 1X5DN063-4
  5. FOR ITEM 6 TIME DELAY RELAY IS 1-10 MIN, S.P. 4 MIN
  6. SET POINT FOR ALARM IS HIGHER THAN THE SET POINT FOR FAN ACTUATION.

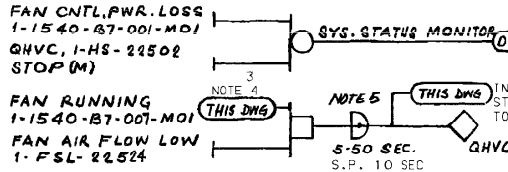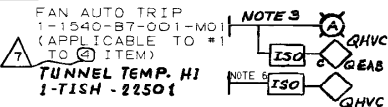

**TABLE 1**

ITEM	FUNCTION	TRAIN	FAN	CNTL. SW.	TEMP. SW.	FLOW SW.
1	DIESEL GEN. PWR. CABLE TUN.	A	1-1540-B7-001-M01	1-HS-22502	1-TISH-22501	
2	DIESEL GEN. PWR. CABLE TUN.	B	-002	-22506	-22505	
3	NSCW TOWER PWR. CABLE TUN.	A	-003	-22517	-22516	
4	NSCW TOWER PWR. CABLE TUN.	B	-004	-22520	-22519	
5						
6	TUNEL VENT FAN		1-1540-B7-006-M01		1-TISH-22513	1-FSL-22512
7	TURB. BLDG. CHASE TO CNTL. BLDG.		1-1540-B7-007-M01	1-HS-22523	-22522	1-FSL-22524

REF. DWG.  
P & ID 1X4DB238  
E.D. 1X3D-BG-K01C, 1D, 1G

**NUCLEAR SAFETY RELATED "Q"**  
**ELECTRICAL TUNNEL VENT FAN**

SOUTHERN COMPANY SERVICES, INC.  
BIRMINGHAM, ALABAMA  
GEORGIA POWER COMPANY  
ALVIN W. VOGTLE NUCLEAR PLANT




**CONTROL LOGIC DIAGRAM  
TUNNEL VENTILATION SYSTEM**



INCORP. AEN-12461.	DATE	DR	CHK	RE	DM	DM	DM	PDM	ENG MGR
ISSUED FOR CONSTRUCTION	3/7/79								DATE
NO.	DATE	DR	CHK	ELECT	EGL	EGS	CHF	PE	QAE

SCALE: NONE	DRAWING NO.	REV
JOB NO. 10604	1X5DN069-1	7

SIZE B 11x17

This drawing and the design it covers are the property of BECHTEL. They are loaned and on the borrower's express agreement that they will not be re-produced, copied, loaned, exhibited, or used except in the limited way and private use permitted by any written consent given by the lender to the borrower.

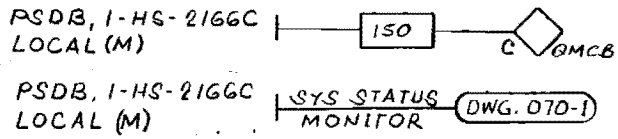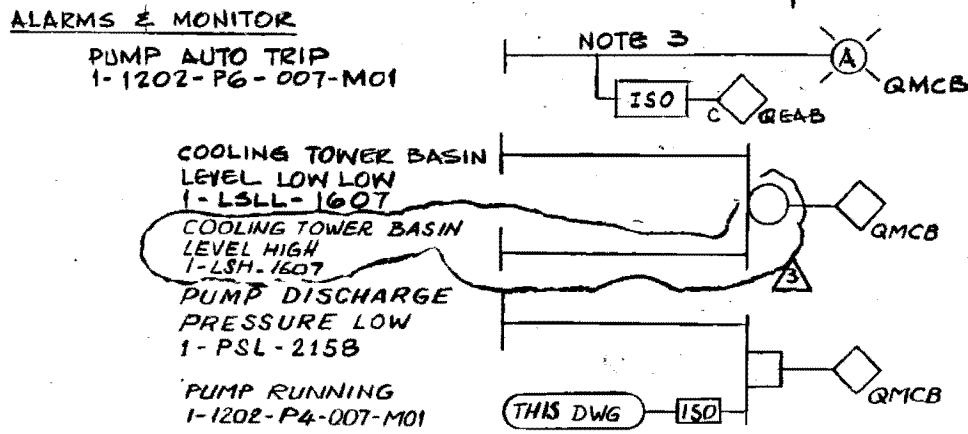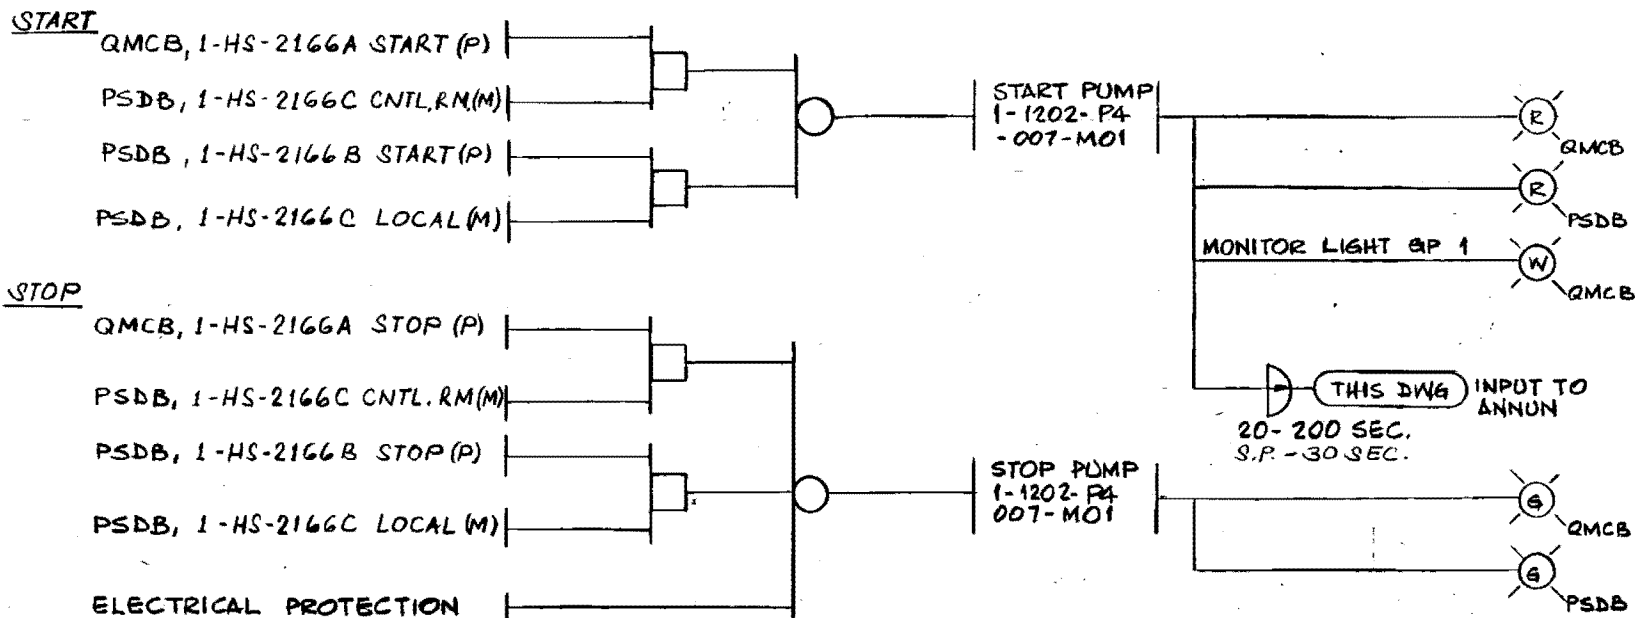

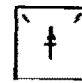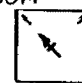
STOP START CONTROL LOCAL ROOM  
   
 1-HS-2166A(TYP.) 1-HS-2166C (TYP.)  
 1-HS-2166B(TYP.) MAINTAINED  
 SPRING RETURN (TRANSF. SWITCH)  
 TO NEUTRAL

- NOTE:
1. PUMP 1-1202-P4-007-M01 SHOWN. PUMP 1-1202-P4-008-M01 SIMILAR
  2. 480V MOTOR STARTER
  3. TYPICAL AUTO TRIP LOGIC FUNCTION SHOWN ON DWG. 1X5DN002-3.
  4. PUMP WILL STOP ON LOSS OF POWER AND WILL REMAIN STOPPED ON RESTORATION OF POWER

REF. DWGS.  
 P&ID 1X4DB133-1, 133-2  
 E.O. 1X30-BD-KO'B #  
 KOIA

NUCLEAR SAFETY RELATED

TRANSFER PUMP


 <b>BECHTEL</b> LOS ANGELES	
<b>GEORGIA POWER COMPANY</b> <b>ALVIN W. VOGTLE NUCLEAR PLANT</b>	
CONTROL LOGIC DIAGRAM NUCLEAR SERVICE COOLING TOWER TRANSFER PUMPS	
SCALE: NONE	DRAWING NO. 1X5DN086-1
JOB NO. 9510	REV. 3

TRAIN	PUMP	SWITCHES			PRESS SW	LVL SW	LVL SW
B	1-1202-P4-007-M01	1-HS-2166A	1-HS-2166B	1-HS-2166C	1-PSL-215B	1-LSLL-1607	1-LSH-1607
A	008	2167A	2167B	2167C	2159	1606	-1606

NO.	REVISIONS	DATE	DR	CHK	SUPV.	EGL	EGS	CHF. E.	P. E.	Q. A. E.	ENG. MGR.
3	ADDED HIGH ALARM TO REFLECT THE ACTUAL DESIGN	3/21/85	ZEP	ALV							
2	ADDED TIME DELAY SET POINT & REVISED AS INDICATED	3-6-81	FAL	AAT							
1	REVISED AS INDICATED	2-15-79	HL	FAL							
0	ISSUED FOR CONSTRUCTION	2/15/77	HL	FAL	MKK						

SIZE B 11x17



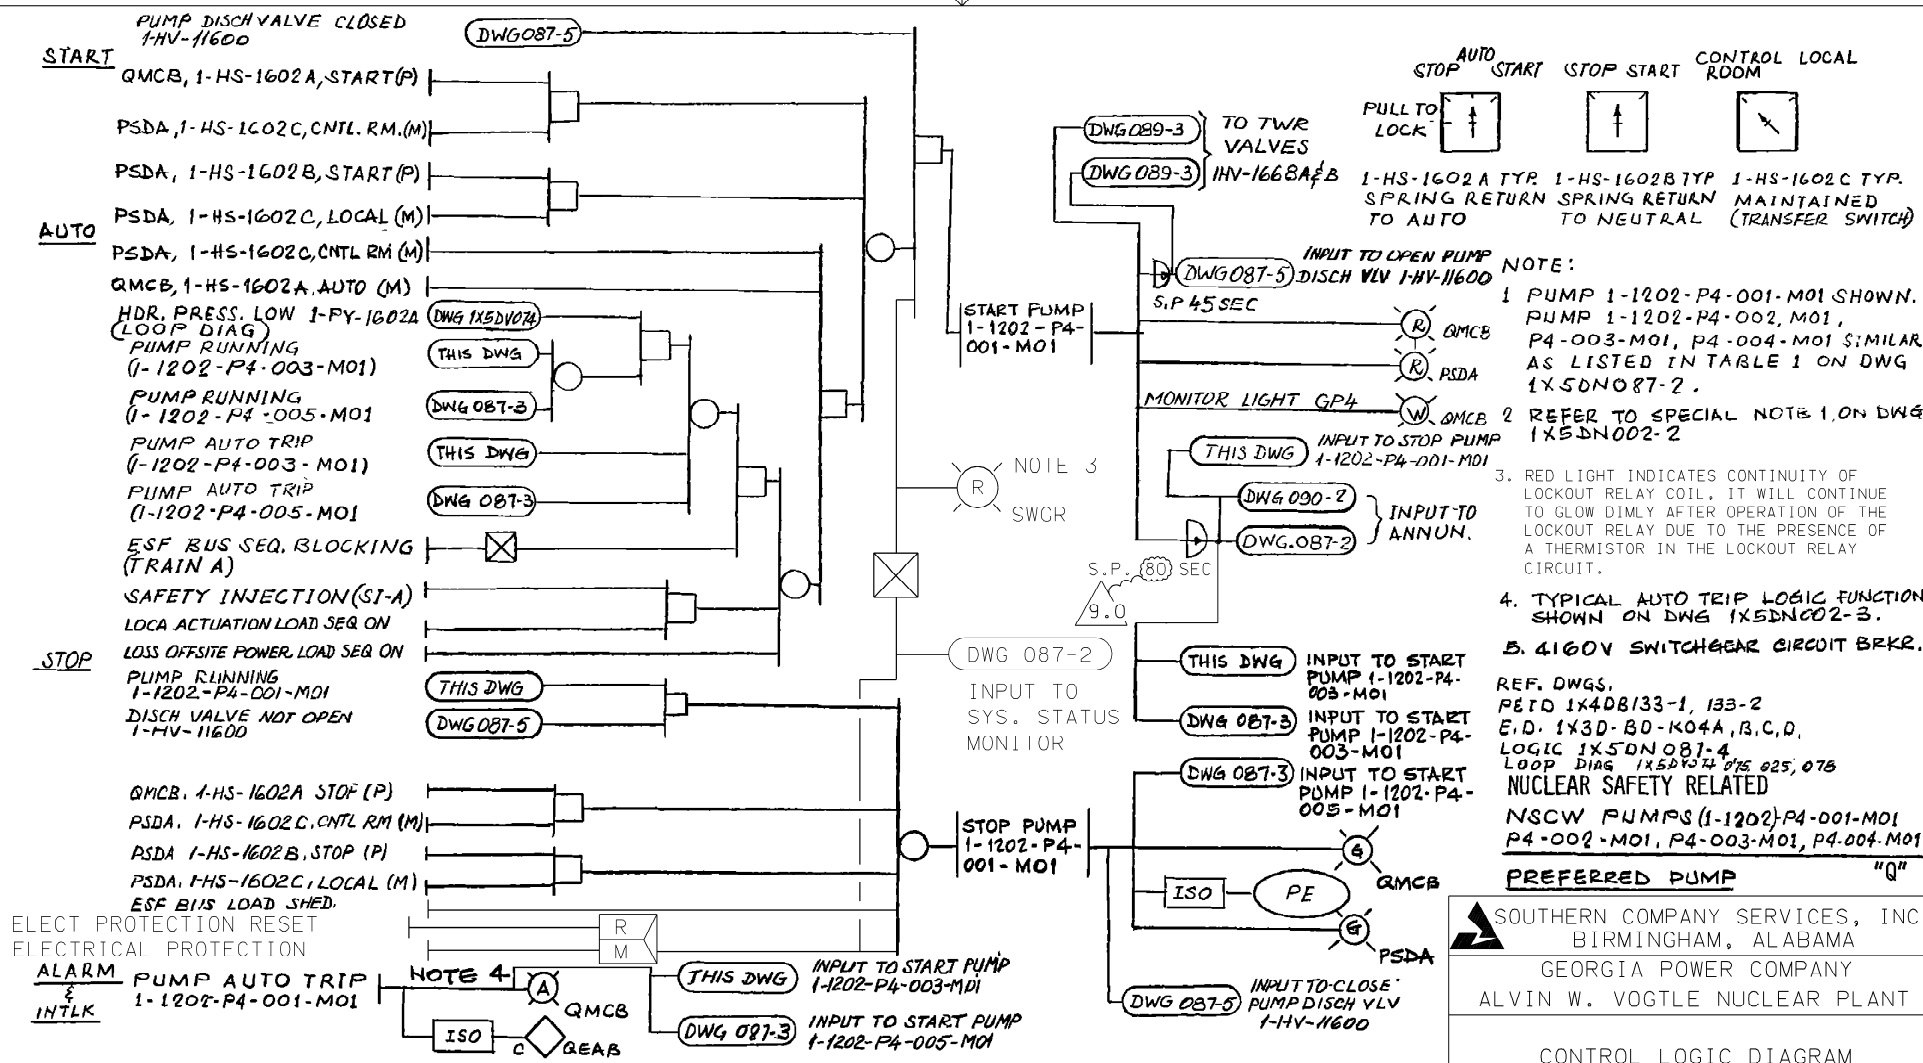

**AUTO STOP START STOP START CONTROL LOCAL ROOM**

PULL TO LOCK

1-HS-1602A TYP. SPRING RETURN TO AUTO  
 1-HS-1602B TYP. SPRING RETURN TO NEUTRAL  
 1-HS-1602C TYP. MAINTAINED (TRANSFER SWITCH)

**NOTE:**

1. PUMP 1-1202-P4-001-M01 SHOWN. PUMP 1-1202-P4-002-M01, P4-003-M01, P4-004-M01 SIMILAR AS LISTED IN TABLE 1 ON DWG 1X5DN087-2.

2. REFER TO SPECIAL NOTE 1. ON DWG 1X5DN002-2

3. RED LIGHT INDICATES CONTINUITY OF LOCKOUT RELAY COIL. IT WILL CONTINUE TO GLOW DIMLY AFTER OPERATION OF THE LOCKOUT RELAY DUE TO THE PRESENCE OF A THERMISTOR IN THE LOCKOUT RELAY CIRCUIT.

4. TYPICAL AUTO TRIP LOGIC FUNCTION SHOWN ON DWG 1X5DN002-3.

5. 4160V SWITCHGEAR CIRCUIT BRKR.

REF. DWGS.  
 PETD 1X4DB133-1, 133-2  
 E.D. 1X3D-80-K04A, B, C, D.  
 LOGIC 1X5DN087-4  
 LOOP DIAG 1X5DN074, 075, 025, 075  
**NUCLEAR SAFETY RELATED**  
 NSCW PUMPS (1-1202)-P4-001-M01, P4-002-M01, P4-003-M01, P4-004-M01  
**PREFERRED PUMP "Q"**

**SOUTHERN COMPANY SERVICES, INC.**  
 BIRMINGHAM, ALABAMA  
**GEORGIA POWER COMPANY**  
 ALVIN W. VOGTLE NUCLEAR PLANT

CONTROL LOGIC DIAGRAM  
 NUCLEAR SERVICE  
 COOLING WATER PUMPS


SCALE: NONE	DRAWING NO.	VER.
JOB NO. 10604	1X5DN087-1	9.0

9.0	REVISED PER ABN-V00180, VER. 1.0	1/29/07	JLO	ELC	JMR
NO.	VERSIONS	DATE	DR	CHK	APPV

THIS DRAWING AND THE DESIGN IT COVERS ARE THE PROPERTY OF SCS. THEY ARE HEREBY LOANED AND NOT TO BE REPRODUCED OR COPIED. REPRODUCTION OR COPIED, LOANED, EXHIBITED, OR USED EXCEPT IN THE LIMITED WAY AND MANNER SPECIFIED BY THE LENDER TO THE BORROWER.

**ALARMS AND MONITORS**

- PUMP RUNNING  
1-1202-P4-001-M01
- HEADER PRESS LOW  
1-PY-1602B  
(LOOP DIAG)
- PUMP CNTL PWR LOSS  
1-1202-P4-001-M01
- PUMP BREAKER POS.  
INOPERABLE  
1-1202-P4-001-M01  
QMCB, 1-HS-1602A  
PULL TO LOCK
- PSDA, 1-HS-1602C LOCAL (M)
- ELECT. PROT. BRKR. LOCKOUT  
1-1202-P4-001-M01
- PSDA, 1-HS-1602C LOCAL  
(M)

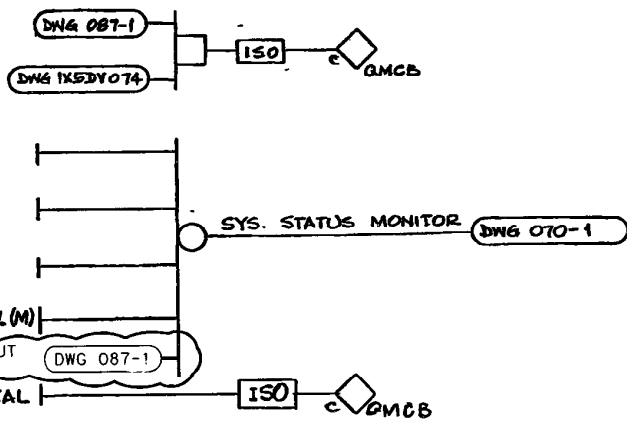

**NOTE:**

1. TRAIN A ALARMS & MONITORS SHOWN, OTHER ALARMS & MONITORS SIMILAR AS LISTED IN TABLE 1 & 2
2. OTHER LOGIC FUNCTION SHOWN ON DWG 1X5DN087-1, 1X5DN087-3.

**TABLE 1**

LOOP DWG 1X5DV-	TRAIN	PUMP N2	SAF. SIG.	SWITCHES			PRESS SW LOOP DIAG	PUMP RUNNING, ELEC OLVD		
-074	A	1-1202-P4-001-M01	SI-A	1-HS-1602A	1-HS-1602B	1-HS-1602C	1-PY-1602A,B	1-1202-P4-003-M01	1-1202-P4-008-M01	006
-075	B	-002	B	03A	03B	03C	03	004	006	006
-025	A	003	A	34A	34B	34C	36	001	005	005
-078	B	004	B	35A	35B	35C	37	002	006	006

REF DWGS

PEID 1X408133-1, 133-2  
E.D. 1X30-80-K04A,B,C,D,E,F  
LOOP DIAGRAM 1X5DV074, 075, 025, 078, 076, 077  
**NUCLEAR SAFETY RELATED** "Q"  
**ALARMS, MONITORS & EQUIP. LIST.**

**TABLE 2**


LOOP DWG 1X5DV	TRAIN	PUMP NO.	SAF. SIG.	SWITCHES			PRESS SW LOOP DIAG	PUMP RUNNING, ELEC OLVD	
-076	A	1-1202-P4-005-M01	SI-A	1-HS-1608A	1-HS-1608B	1-HS-1608C	1-PY-1608A,B	1-1202-P4-001-M01	1-1202-P4-003-M01
-077	B	006	B	09A	09B	09C	09	002	004

**SOUTHERN COMPANY SERVICES, INC.**  
BIRMINGHAM, ALABAMA  
**GEORGIA POWER COMPANY**  
ALVIN W. VOGTLE NUCLEAR PLANT

**CONTROL LOGIC DIAGRAM  
NUCLEAR SERVICE  
COOLING WATER PUMPS**

△																ENG MGR
△	INCORP. ABN-21049			11/29/85	MWD	WLM	EOH									
△	REVISIONS			DATE	DR	CHK	APPV	DTL								
△	ISSUED FOR CONSTRUCTION															
△	NO. REVISIONS			DATE	DR											

SCALE: NONE	DRAWING NO.	REV
JOB NO. 10604	1X5DN087-2	4

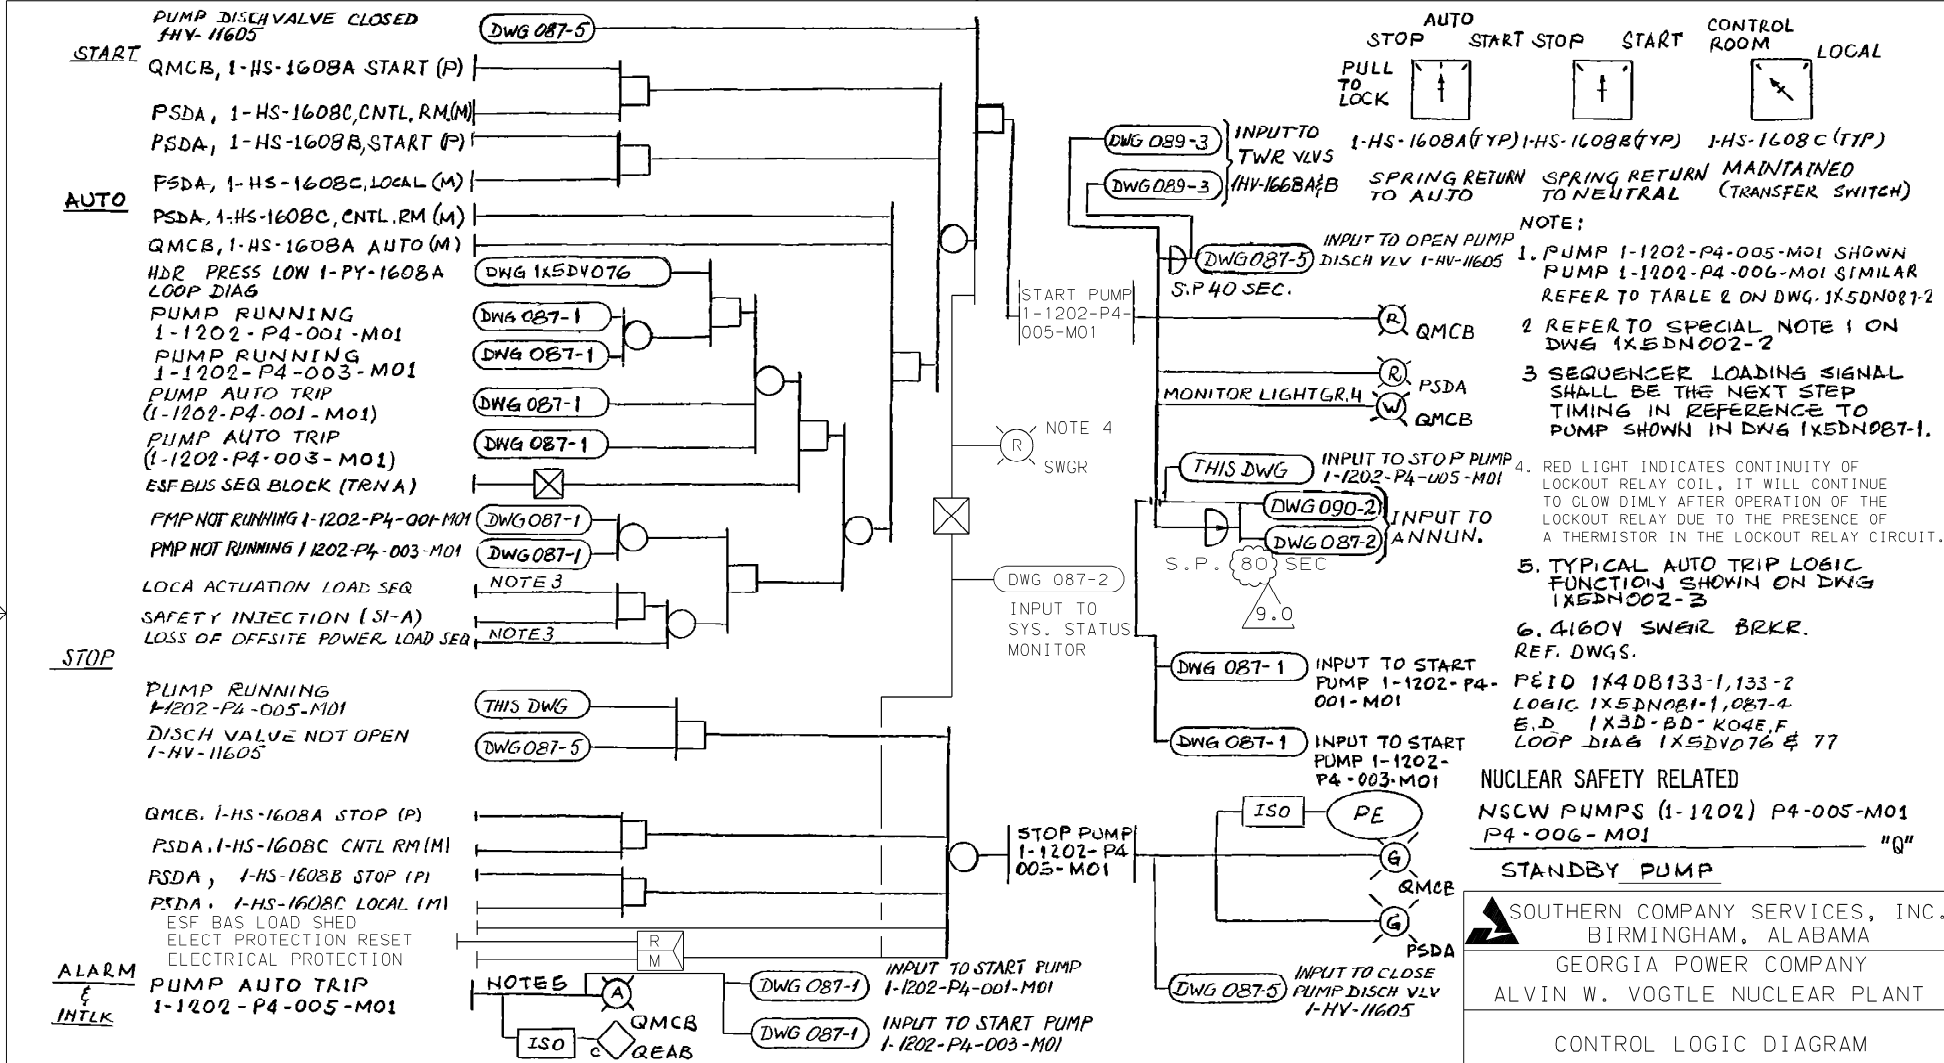


9.0 REVISED PER ABN-V00480, VER. 1.0				1/29/07	JLO	ELC	JMR		SCALE: NONE	DRAWING NO.	VER.
NO.	VERSIONS				DATE	DR	CHK	APPV	JOB NO. 10604	1X5DN087-3	9.0

**115X**  
 DATE: 7-25-84 CAMERA OPERATOR: D. C. COLLINS SECTION SUPERVISOR: Alvin W. Vogtle

I CERTIFY THAT THE IMAGE CONTAINED ON THIS FRAME WAS MADE IN THE NORMAL AND REGULAR COURSE OF BUSINESS, ON THE DATE STATED BELOW AND THAT IT IS AN ACCURATE REPRODUCTION OF THE DOCUMENT SUBMITTED TO MICROGRAPHICS.

This drawing and the design it covers are the property of BECHTEL. They are provided, copied, loaned, exhibited, or used except in the limited way and phrase as permitted by any written consent given by the lender to the borrower.

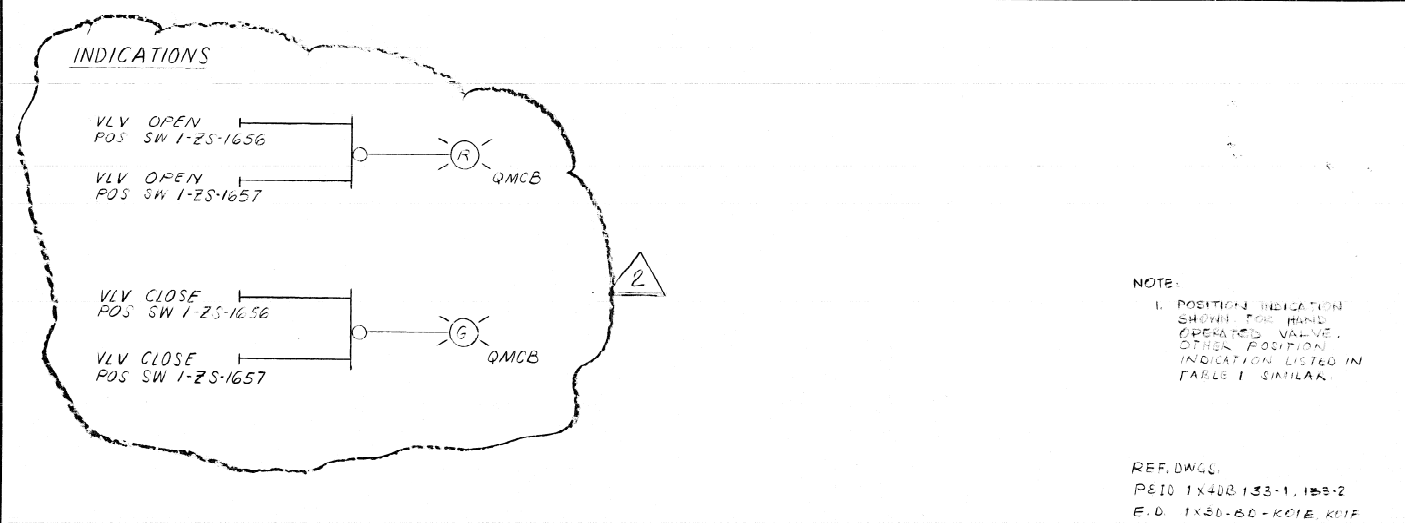

**TABLE 1**

FUNCTION	VLV POS SW
COOLING TOWER BASIN MAKE UP TRAIN A	1-2S-1656
COOLING TOWER BASIN MAKE UP TRAIN B	7
	8
	9


MANUAL MAKE-UP VALVE MONITOR

<b>BECHTEL</b> LOS ANGELES	
GEORGIA POWER COMPANY ALVIN W. VOGTLE NUCLEAR PLANT	
CONTROL LOGIC DIAGRAM NUCLEAR SERVICE COOLING WATER PUMPS	
SCALE: NONE	DRAWING NO. 1X5DN087-4
JOB NO. 9510	REV. 2

NO.	REVISIONS	DATE	DR	CHK.	SUPV.	EGL	EGS	CH.F. E.	P.E.	Q. A. E.	ENG. MGR.
1	CONNECTED THE LIGHT POS INDICATION	7-24-84	ETL	1/lu							
2	ADDED REF DWG.	8-18-80	HL	FAL							
3	ISSUED FOR CONSTRUCTION	8-28-80	HL	FAL	MKK						

DM 9510

SIZE B 11x17

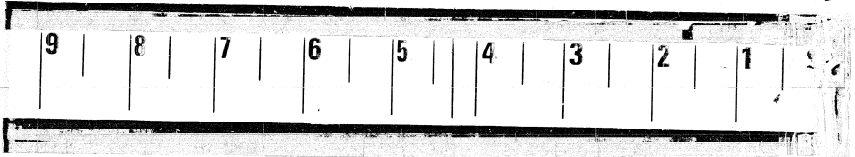

I CERTIFY THAT THE IMAGE CONTAINED ON THIS FRAME WAS MADE IN THE NORMAL AND REGULAR COURSE OF BUSINESS, ON THE DATE STATED BELOW AND THAT IT IS AN ACCURATE REPRODUCTION OF THE DOCUMENT SUBMITTED TO MICROGRAPHICS.

DATE: 7-25-84 CAMERA OPERATOR: D. C. COLLINS SECTION SUPERVISOR: Alvin W. Vogtle

OPEN

NSCW PUMP RUNNING  
1-1202-P4-001-M01

DWG 087-1

OPEN VALVE  
1-HV-11600

DWG 90-6

INPUT TO CLOSE  
BLOWDOWN VLV



QMCB (NOTE 4)

STOP

ELECTRICAL OVERLOAD  
(ONLY DURING PERIODIC TEST)

NOTE 3

STOP VALVE  
1-HV-11600



CLOSE

NSCW PUMP STOPPED  
1-1202-P4-001-M01

DWG 087-1

CLOSE VALVE  
1-HV-11600



QMCB (NOTE 4)

DWG 087-1

PERMISSIVE INPUT  
TO NSCW TO START

DWG 087-1

INPUT TO STOP  
NSCW PUMP

MONITOR & ALARM

VALVE 1-HV-11600  
CONTROL POWER LOSS

SYSTEMS STATUS MONITOR

DWG 070-2

NOTE:

1. VALVE 1-HV-11600 SHOWN, OTHER VALVES LISTED IN TABLE 1 SIMILAR.
2. VALVES LISTED IN TABLE 1 ARE BUTTERFLY VALVES.  
OPEN - LIMIT STOPPED  
CLOSE - LIMIT STOPPED
3. SPECIAL NOTE 2 ON DWG 1X5DN002-2,
4. INPUT FROM STEM MOUNTED POSITION SWITCH

REF. DWGS:


P&ID 1X4DB133-1, 133-2  
E.D. 1X3D-BD-K04Y, -K04Z

TABLE 1

TRAIN	VALVE	PUMP	DWG
A	1-HV-11600	1-1202-P4-001-M01	087-1
B	11607	2	
A	11606	3	
B	11613	4	
A	11605	5	087-3
B	11612	6	

VALVE CNTL POWER  
LOSS 1-HV-11600

VALVE MOTOR ELECT  
OVERLOAD 1-HV-11600

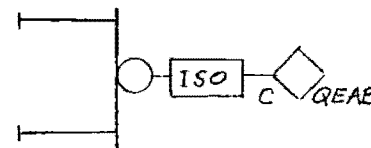

NUCLEAR SAFETY RELATED

PUMP DISCHARGE VALVES

"Q"

SOUTHERN COMPANY SERVICES, INC.  
BIRMINGHAM, ALABAMA

GEORGIA POWER COMPANY  
ALVIN W. VOGTLE NUCLEAR PLANT

CONTROL LOGIC DIAGRAM  
NUCLEAR SERVICE  
COOLING WATER PUMPS

NO.	REVISIONS	DATE	DR	CHK	APPV	DTL
△						
△						
△	INCORPORATED PER DCP 95-V1N0035	12-5-97	CD	GLB	WFP	
△	ISSUED FOR CONSTRUCTION	SEE MICROFILM FOR			SIGNATURES	

SCALE: NONE	DRAWING NO.	REV
JOB NO. 10604	1X5DN087-5	3

THIS DRAWING AND THE RECORD IT CONTAINS ARE THE PROPERTY OF SOUTHERN COMPANY SERVICES, INC. THEY ARE LOANED TO YOU BY THE COMPANY'S ENGINEERING DEPARTMENT. THEY ARE NOT TO BE REPRODUCED, COPIED, LOANED, OR USED EXCEPT AS THE WORKED WAY AND YOU WILL BE RESPONSIBLE FOR THE PROTECTION OF THE INFORMATION CONTAINED HEREIN.

**START**

- QMCB, 1-HS-1610A, START (P)
- PSDA, 1-HS-1610C, CNTL RM (M)
- PSDA, 1-HS-1610B, START (P)
- PSDA, 1-HS-1610C, LOCAL (M)

**AUTO**

- QMCB, 1-HS-1610A, AUTO (M)
- LOAD SEQ. BLOCKING
- PSDA, 1-HS-1610C, CNTL RM (M)

**STOP**



- SPRAY VALVE 1HV-1668A FULLY CLOSED
- QMCB, 1-HS-1610A, STOP (P)
- PSDA, 1-HS-1610C, CNTL RM (M)
- LOAD SEQUENCER BLOCK MANUAL STOP
- PSDA, 1-HS-1610B, STOP (P)
- PSDA, 1-HS-1610C, LOCAL (M)
- ESF BUS LOAD SHEDDING
- ELECTRICAL PROTECTION

**ALARM & MONITORS**

- FAN VIBRATION HI 1-XSH-1610

**CONTROL POWER LOSS**

- 1-1202-W4-001-F01
- QMCB, 1-HS-1610A PULL TO LOCK (M)
- FAN BREAKER NOT INOPERABLE 1-1202-W4-001-F01
- PSDA, 1-HS-1610C, LOCAL (M)

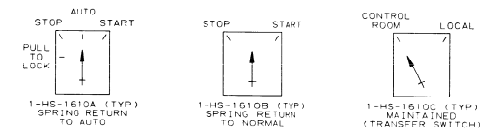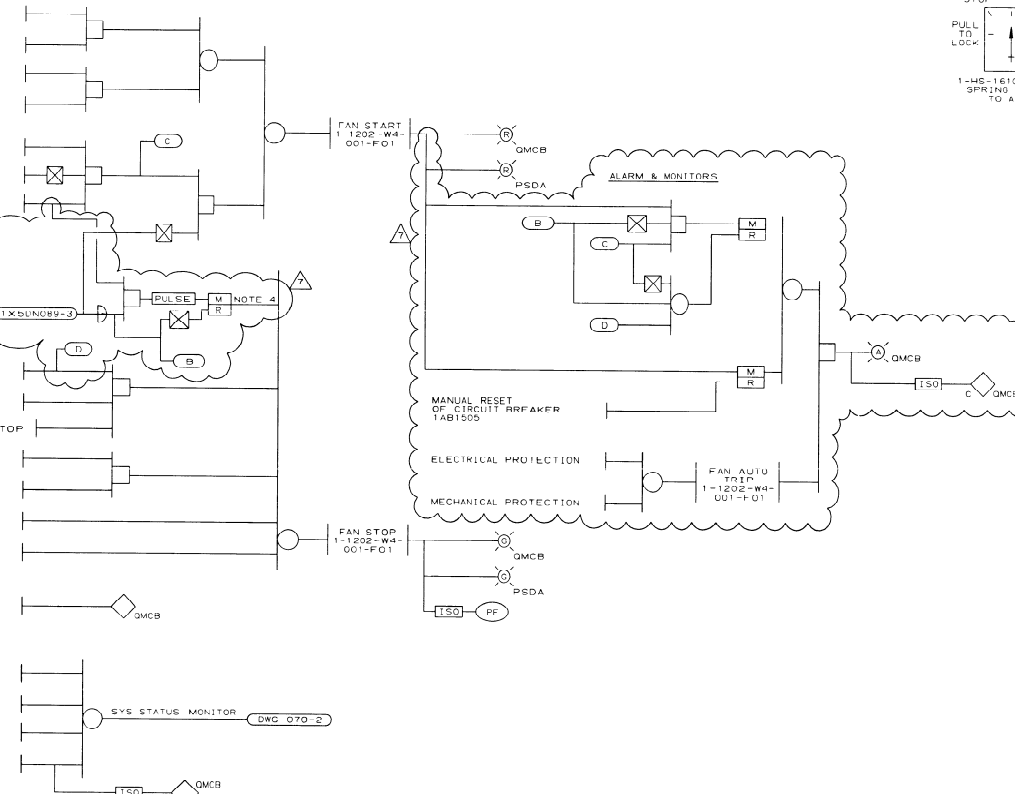

- NOTES:**
1. FAN 1-1202-W4-001-F01 SHOWN. FAN 1 LISTED IN TABLE 1 (SIMILAR).
  2. 480V SWGR CIRCUIT BREAKER.
  3. REFER TO SPECIAL NOTE 1 ON DWG 1X50N002-2.
  4. ONE PULSE SIGNAL IS GENERATED TO AUTO STOP THE FAN, FOR ANOTHER PULSE SIGNAL TO BE GENERATED TO AUTO STOP THE FAN THE SPRAY VALVE 1HV-1668A MUST BE IN THE NOT CLOSED POSITION.

- REFERENCES:**
- P & I D 1X4DB133-1, 133-2
  - E.C. 1X3D-BD-K03A, 1X3D-BD-K03E, 1X3D-BD-K05U, 1X3D-BD-K05W

LOCATION 1X4DE328, 329

**TABLE 1**

TRAIN	CLG TOWER FANS	SWITCHES			VIBRATION SWITCHES	CIRCUIT BREAKER	SPRAY VALVE
A	1-1202-W4-001-F01	1-HS-1610A	1-HS-1610B	1-HS-1610C	1-XSH-1610	1AB1500	1HV-1668A
R	1-1202-W4-002-F01	1-HS-1611A	1-HS-1611B	1-HS-1611C	1-XSH-1611	1BB1500	1HV-1669A

NUCLEAR SAFETY RELATED  
NSCW TOWER FANS

SOUTHERN COMPANY SERVICES, INC.  
BIRMINGHAM, ALABAMA



GEORGIA POWER COMPANY  
ALVIN W. VOGTLE NUCLEAR PLANT

CONTROL LOGIC DIAGRAM  
NUCLEAR SERVICE  
COOLING TOWER SYSTEM

NO.	REVISIONS	DATE	DR	CHK	RE	DM	DM	DM	PDW	UATL	SCALE:	NONE	DRAWING NO.	REV.
1	INCORP. ARN-11637	11/21/90	CLB	SMW	SMW	SMW	SMW	SMW	SMW				1X50N089-1	7
2	ISSUED FOR CONSTRUCTION													

SIZE 10 22434

THIS DRAWING AND THE DESIGN IT COVERS ARE THE PROPERTY OF SOUTHERN COMPANY SERVICES, INC. THEY ARE HEREBY LOANED AND ON THE LOANING IS EXPRESS AGREEMENT THAT THEY WILL NOT BE REPRODUCED, COPIED, LENT, LOANED, EXHIBITED, OR USED EXCEPT IN THE LIMITED WAY AND FOR THE ORIGINAL USE PERMITTED BY ANY WRITTEN CONSENT GIVEN BY THE LENDER TO THE BORROWER.

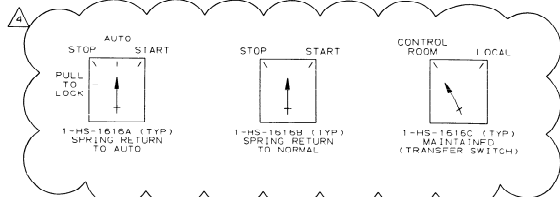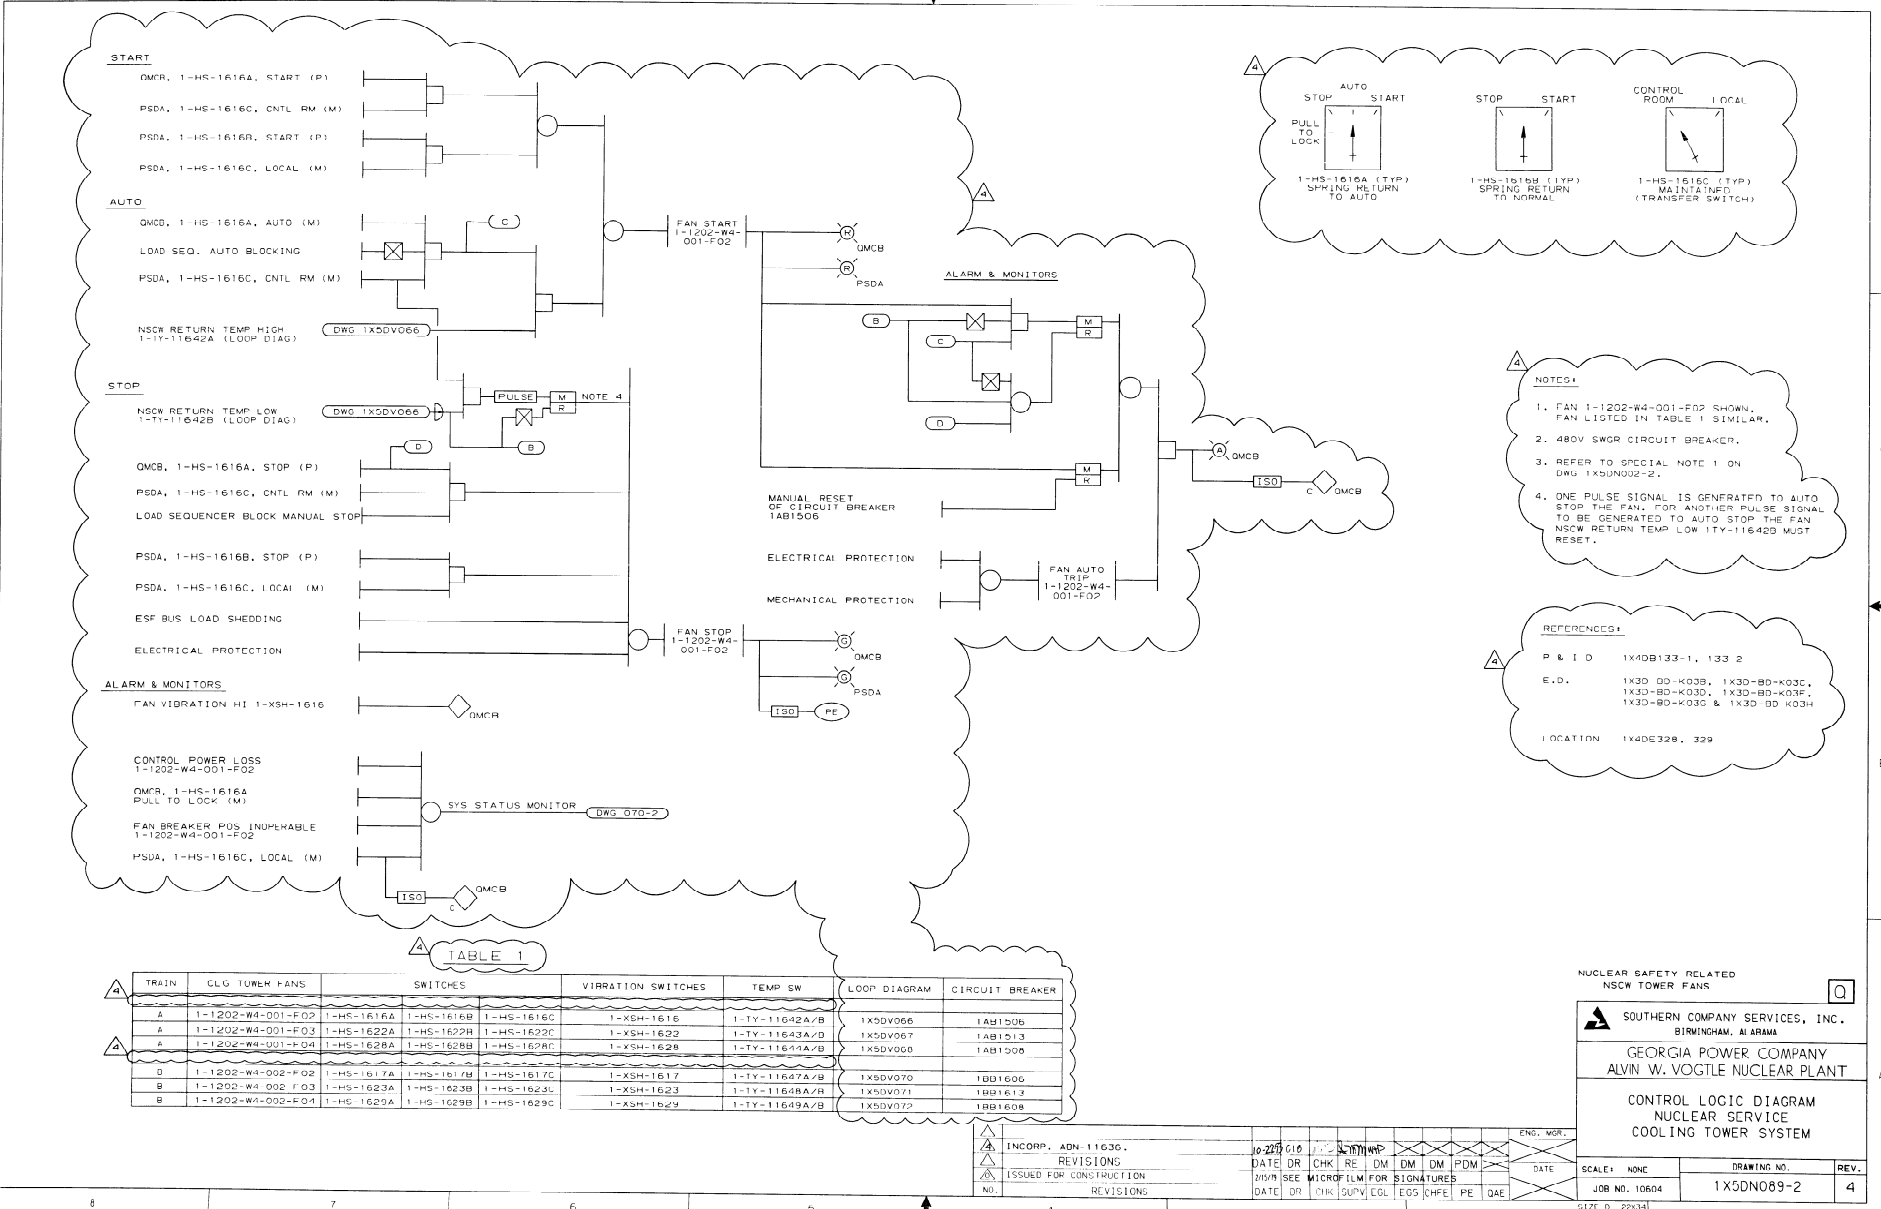

- NOTES:**
- FAN 1-1202-W4-001-F02 SHOWN. FAN LISTED IN TABLE 1 SIMILAR.
  - 480V SWGR CIRCUIT BREAKER.
  - REFER TO SPECIAL NOTE 1 ON DWG 1X5DN002-2.
  - ONE PULSE SIGNAL IS GENERATED TO AUTO STOP THE FAN. FOR ANOTHER PULSE SIGNAL TO BE GENERATED TO AUTO STOP THE FAN NSCW RETURN TEMP LOW 1TY-11642D MUST RESET.

- REFERENCES:**
- P & I D 1X4DB133-1, 133-2
- E.D. 1X3D-00-K03B, 1X3D-80-K03C, 1X3D-80-K03D, 1X3D-80-K03F, 1X3D-80-K03G & 1X3D-00-K03H
- LOCATION 1X4DE328, 329

**TABLE 1**

TRAIN	CLG TOWER FANS	SWITCHES			VIBRATION SWITCHES	TEMP SW	LOOP DIAGRAM	CIRCUIT BREAKER
A	1-1202-W4-001-F02	1-HS-1616A	1-HS-1616B	1-HS-1616C	1-XSH-1616	1-TY-11642A/B	1X5D0066	1AB1506
A	1-1202-W4-001-F03	1-HS-1622A	1-HS-1622B	1-HS-1622C	1-XSH-1622	1-TY-11643A/D	1X5D0067	1AB1513
A	1-1202-W4-001-F04	1-HS-1628A	1-HS-1628B	1-HS-1628C	1-XSH-1628	1-TY-11644A/B	1X5D0068	1AB1508
D	1-1202-W4-002-F02	1-HS-1617A	1-HS-1617B	1-HS-1617C	1-XSH-1617	1-TY-11647A/B	1X5D0070	1DB1606
B	1-1202-W4-002-F03	1-HS-1623A	1-HS-1623B	1-HS-1623C	1-XSH-1623	1-TY-11648A/R	1X5D0071	1DB1613
B	1-1202-W4-002-F04	1-HS-1629A	1-HS-1629B	1-HS-1629C	1-XSH-1629	1-TY-11649A/B	1X5D0072	1DB1608

NUCLEAR SAFETY RELATED  
NSCW TOWER FANS

SOUTHERN COMPANY SERVICES, INC.  
BIRMINGHAM, ALABAMA

GEORGIA POWER COMPANY  
ALVIN W. VOGTLE NUCLEAR PLANT

CONTROL LOGIC DIAGRAM  
NUCLEAR SERVICE  
COOLING TOWER SYSTEM

INCORP. ADN 11636.		DATE DR		CHK RE		DM DM		PDM		DATE		SCALE: NONE	DRAWING NO.	REV.
ISSUED FOR CONSTRUCTION		DATE DR		CHK RE		DM DM		PDM		DATE		JOB NO. 10604	1X5DN089-2	4
REVISIONS		DATE DR		CHK RE		DM DM		PDM		DATE		SIZE D 22X34		

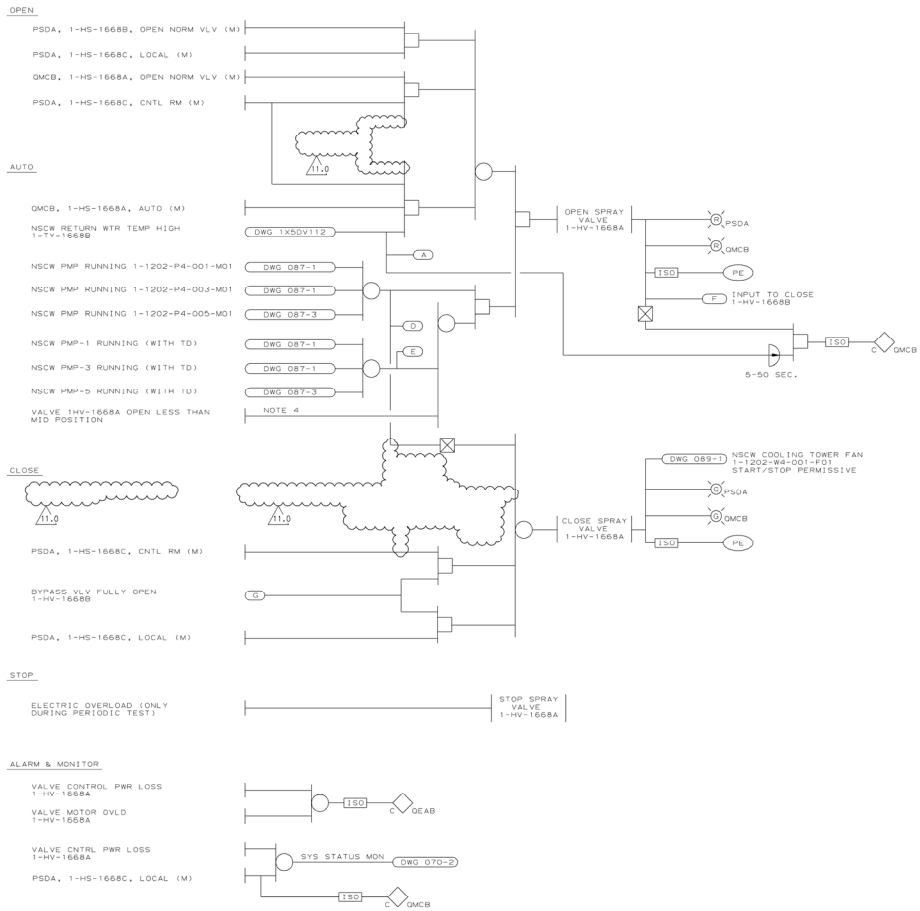


TABLE 1

LOOPS DIAGRAM	TRAIN	VALVE	VALVE FUNCTION	TEMP SW LOOP DIAG	HAND SW	NSCW COOLING TOWER FAN START PERMISSIVE
1X5DV112 1X5DV288	A	1-HV-1668A	SPRAY	1-TY-1668B	1-HS-1668A, B & C	1-1202-W4-001-F01
1X5DV113 1X5DV289	U	1-HV-1669A	SPRAY	1-1Y-1669W	1-HS-1669A, U & U	1-1202-W4-002-F01

NOTES:

1. VALVE 1-HV-1668A SHOWN, OTHER VALVES LISTED IN TABLE 1 SIMILAR EXCEPT AS TABULATED.
2. VALVES LISTED IN TABLE 1 ARE BUTTERFLY VALVES.  
OPEN - LIMIT STOPPED  
CLOSE - LIMIT STOPPED
3. REFER TO SPECIAL NOTE NO. 2 ON DWG 1X5DN002-2.
4. VALVE MID POSITION ANGLE IS:  
10° FOR 1HV-1668A  
7.5° FOR 1HV-1669A


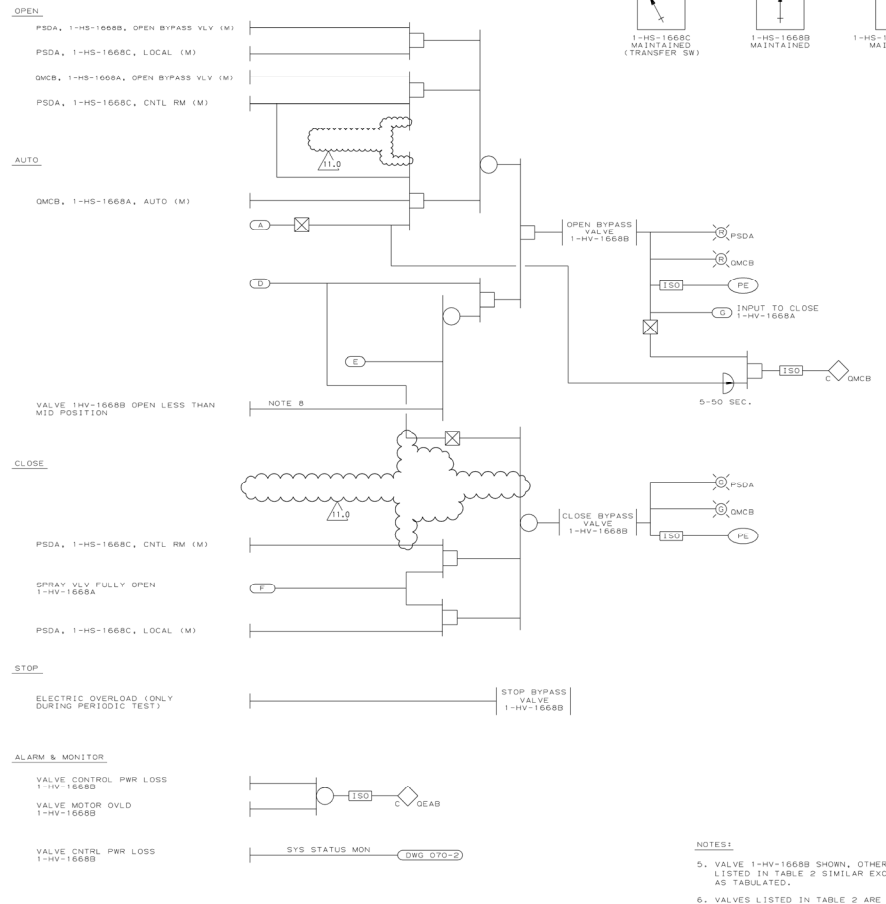


TABLE 2

LOOPS TRAIN	VALVE	VALVE FUNCTION	TEMP SW LOOP DIAG	HAND SW
1X5DV112 1X5DV288	A	1-HV-1668B	BYPASS	1-TY-1668B
1X5DV113 1X5DV289	U	1-HV-1669B	BYPASS	1-1Y-1669W

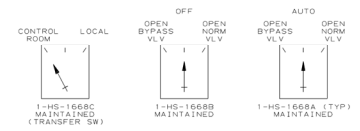

NOTES:

5. VALVE 1-HV-1668B SHOWN, OTHER VALVES LISTED IN TABLE 2 SIMILAR EXCEPT AS TABULATED.
6. VALVES LISTED IN TABLE 2 ARE BUTTERFLY VALVES.  
OPEN - LIMIT STOPPED  
CLOSE - LIMIT STOPPED
7. REFER TO SPECIAL NOTE NO. 2 ON DWG 1X5DN002-2.
8. VALVE MID POSITION ANGLE IS:  
12.6° FOR 1HV-1668B  
12.5° FOR 1HV-1669B

REFERENCES:

- P & I D 1X4DB133-1, 133-8  
E.D. 1X3D-BD-K05U, 1X3D-BD-K05V,  
1X3D-BD-K05W, 1X3D-BD-K05X,  
1X3D-BD-K05A & 1X3D-BD-K05E  
LOOP DIAG. 1X5DV112, 113  
LOCATION 1X4DE328, 329

COOLING TOWER SPRAY HEADER VALVES  
NUCLEAR SAFETY RELATED

**SOUTHERN COMPANY SERVICES, INC.**  
BIRMINGHAM, ALABAMA

GEORGIA POWER COMPANY  
ALVIN W. VOGTLE NUCLEAR PLANT


CONTROL LOGIC DIAGRAM  
NUCLEAR SERVICE  
COOLING TOWER SYSTEM

THIS DOCUMENT CONTAINS PROPRIETARY, CONFIDENTIAL, AND/OR TRADE SECRET INFORMATION OF THE SUBSIDIARIES OF THE SOUTHERN COMPANY OR OF THIRD PARTIES. IT IS INTENDED FOR USE ONLY BY EMPLOYEES OF, OR AUTHORIZED CONTRACTORS OF, THE SUBSIDIARIES OF THE SOUTHERN COMPANY. UNAUTHORIZED POSSESSION, USE, DISTRIBUTION, COPYING, DISSEMINATION, OR DISCLOSURE OF ANY PORTION HEREOF IS PROHIBITED.

1.1	REVISED PER ABN-V01148, VER. 1.0	7-7-08	Vep	ELC	JMR
NO.	VERSIONS	DATE	DRK	CHK	APPV


SCALE: NONE  
DRAWING NO. 1X5DN089-3  
JOB NO. 10604  
VER. 11.0



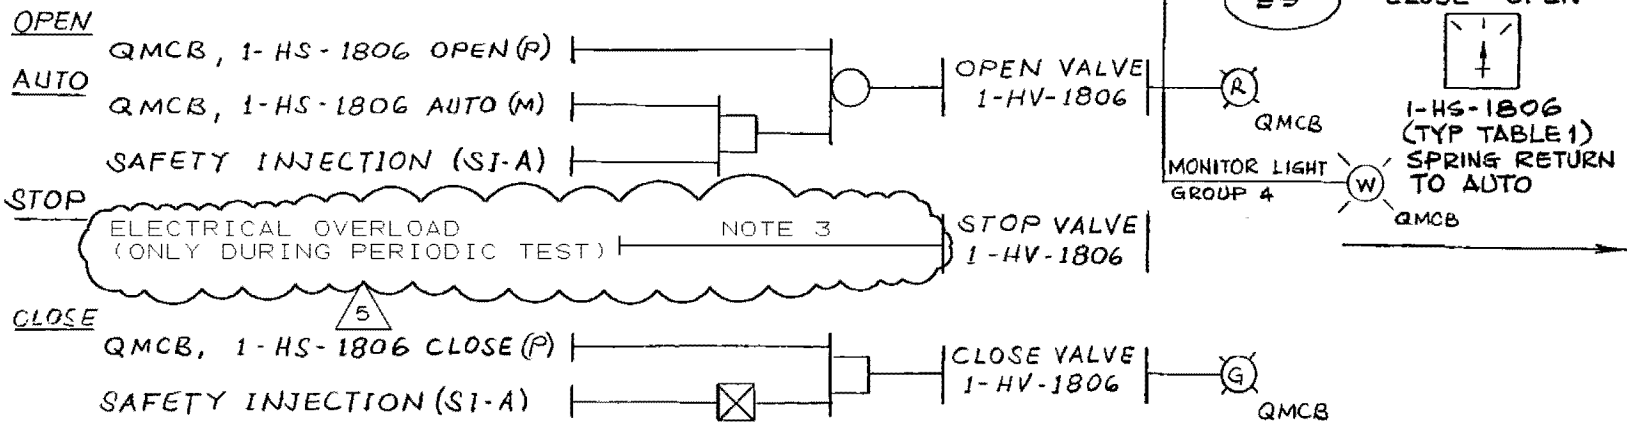

**TABLE 1**

TRAIN	EQUIPMENT TAG NOS.		SAFETY SIG.
A	1-HS-1806	1-HV-1806	SI-A
B	-1807	-1807	SI-B
A	-1808	-1808	SI-A
B	-1809	-1809	SI-B
A	-1822	-1822	SI-A
B	-1823	-1823	SI-B
A	-1830	-1830	SI-A
B	-1831	-1831	SI-B

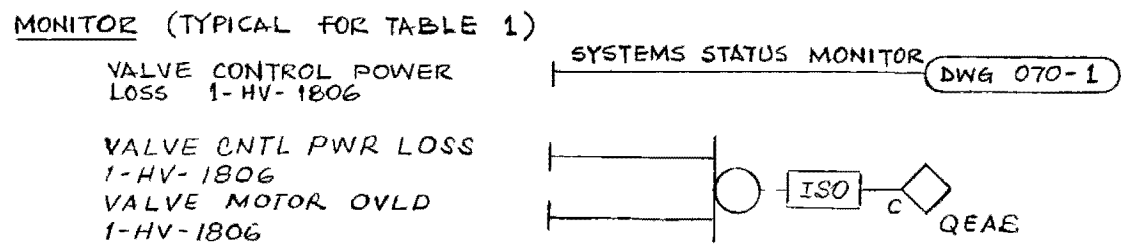

**NOTE:**  
 1. VALVES LISTED IN TABLE 1 ARE BUTTERFLY TYPE VALVES  
 OPEN - LIMIT STOPPED  
 CLOSE - LIMIT STOPPED

NUCLEAR SAFETY RELATED  
 CONTAINMENT COOLER ISOLATION VALVE

3. REFER TO SPECIAL NOTE 2 ON DWG 1X5DN002-2.

REF. DWGS  
 PEID 1X4DB135-1,-2  
 E.D. 1X3D-BD-K04J,K,N,P,S,T,U,V,W & X

NO.	REVISIONS	DATE	DR	CHK	APPV	DTL
△						
△						
△	INCORPORATED PER DCP 95-V1N0035	12/5/97	CD	GLB	WFP	
△	ISSUED FOR CONSTRUCTION	SEE MICROFILM FOR			SIGNATURES	

**SOUTHERN COMPANY SERVICES, INC.**  
 BIRMINGHAM, ALABAMA

GEORGIA POWER COMPANY  
 ALVIN W. VOGTLE NUCLEAR PLANT

CONTROL LOGIC DIAGRAM  
 NUCLEAR SERVICE  
 COOLING WATER SYSTEM  
 AUXILIARIES AND ALARMS

SCALE: NONE

JOB NO. 10604

DRAWING NO. 1X5DN090-1


REV 5

14.5X

I CERTIFY THAT THE IMAGE CONTAINED ON THIS FRAME WAS MADE IN THE NORMAL AND REGULAR COURSE OF BUSINESS, ON THE DATE STATED BELOW AND THAT IT IS AN ACCURATE REPRODUCTION OF THE DOCUMENT SUBMITTED TO MICROGRAPHICS.  
 DATE: 12/31/87  
 CAMERA OPERATOR: [Signature]  
 SECTION SUPERVISOR: [Signature]

This drawing and its design is the property of BECHTEL. They are loaned and on the borrower's express agreement that they will not be re-produced, copied, loaned, exhibited, or used except in the limited way and purpose intended by the lender to the borrower.

**ALARMS**

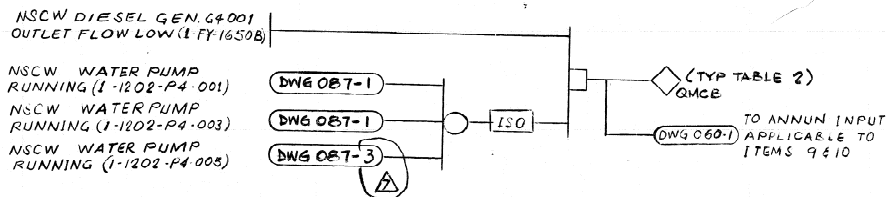

REF DNGS:  
 P&ID 1X4DB133-2, 134, 135-162  
 E.D. 1X3D-BD-K04A d  
 1X3D-BD-K04F

ITEM NO.	ANNUN WINDOW LOCATION	TABLE 2					
		SERVICE	FLOW SW	LEAK DIAG	NSCWS PUMP 1-1202-		
1	QMCB	NSCW DIESEL GEN G4-001	1-FY-1650B	1XEDV022	P4-001	P4-003	P4-005
2			2	1651B	33	2	4
3		CHTMT AIR CLR A7-911/092		1319E	15	1	3
4				1819B	16	2	4
5				1810AS	17	1	3
6				1811B	18	2	4
7		RX CAYTCLG COIL -001		2132B	19	1	3
8				2133B	20	2	4
9	QHVC	ESF CHLR COND C7-001	1-FIS-1802		185	1	3
10			2	1802	186	2	4
11	QMCB	RHR PMP & MTR COOLER	1-FS-1746			1	3
12				1747		2	4

**ALARMS**

**BECHTEL**  
LOS ANGELES

**GEORGIA POWER COMPANY**  
**ALVIN W. VOGTLE NUCLEAR PLANT**

CONTROL LOGIC DIAGRAM  
NUCLEAR SERVICE COOLING WATER  
SYSTEM AUXILIARIES AND ALARMS


SCALE: NONE      DRAWING NO. 1X5DN090-2      REV. 7

JOB NO. 9510      SIZE B 11x17

NO.	REVISIONS	DATE	DR	CHK	SUPV.	EGL	EGS	CHF. E	P. E.	Q. A. E.	ENG. MGR.
1	CORRECTED TAG NO.	12-13-84	ALV	ALV							
2	CORRECTED TAG NOS PER DCN 25 ON P&ID 134	9-11-84	EJL	ALV							
3	INCORPORATED ZIN #1	12/18/87	ALV	ALV							
4	ISSUED FOR CONSTRUCTION	12/31/87	ALV	FAL	ALV						

BM 9510 P&ID 133-2 REV. 134 REV.      P&ID 135-1 REV. 135-2 REV.

I CERTIFY THAT THE IMAGE CONTAINED ON THIS FRAME WAS MADE IN THE NORMAL AND REGULAR COURSE OF BUSINESS, ON THE DATE STATED BELOW AND THAT IT IS AN ACCURATE REPRODUCTION OF THE DOCUMENT SUBMITTED TO MICROGRAPHICS.  
 DATE: 12/31/87  
 CAMERA OPERATOR: [Signature]      SECTION SUPERVISOR: [Signature]

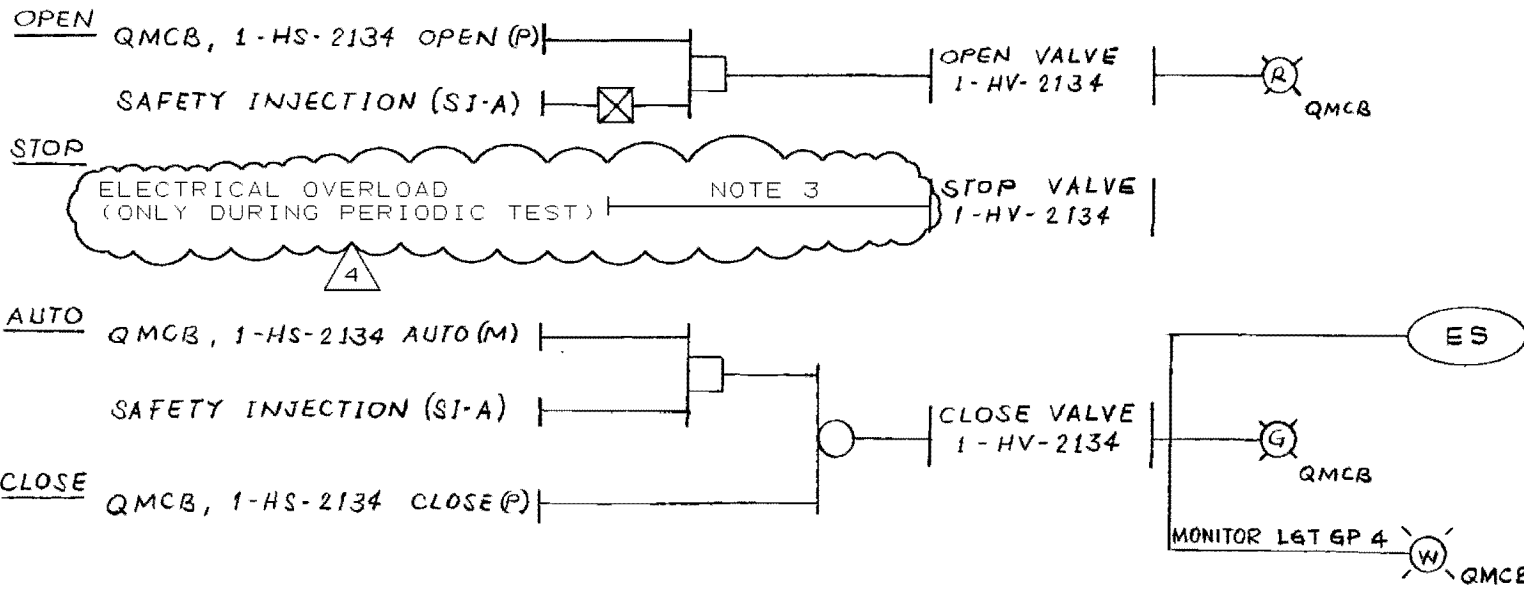

CLOSE AUTO OPEN

1-HS-2134 TYP.

SPRING RETURN TO AUTO

- NOTE:
1. VALVE 1-HV-2134 SHOWN, OTHER VALVES LISTED IN TABLE 1 SIMILAR.
  2. VALVES LISTED IN TABLE 1 ARE BUTTERFLY VALVES. OPEN-LIMIT STOPPED. CLOSE-LIMIT STOPPED.
  3. SPECIAL NOTE 2 ON DWG 1X5DN002-2

MONITOR & ALARM


VALVE 1-HV-2134 CONTROL POWER LOSS

SYSTEMS STATUS MONITOR DWG 070-1

REF. DWGS.  
 PEID 1X4DB135-1,2  
 E.D. 1X3D-BD-K04Q, K04R, K04L & K04M

TABLE 1

TRAIN	VALVE	SWITCH	SAFETY SIG
A	1-HV-2134	1-HS-2134	SI-A
B	-2135	-2135	SI-B
A	-2138	-2138	SI-A
B	-2139	-2139	SI-B

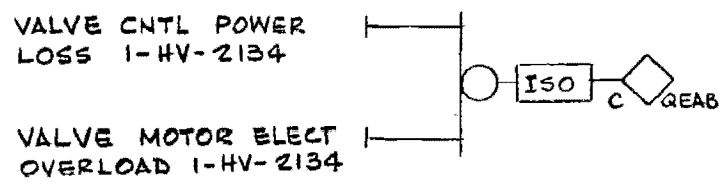



NUCLEAR SAFETY RELATED  
 REACTOR CAVITY AND CRDM  
 COOLING COIL ISOLATION VALVES

**SOUTHERN COMPANY SERVICES, INC.**  
 BIRMINGHAM, ALABAMA

GEORGIA POWER COMPANY  
 ALVIN W. VOGTLE NUCLEAR PLANT

CONTROL LOGIC DIAGRAM  
 NUCLEAR SERVICE  
 COOLING WATER SYSTEM  
 AUXILIARIES AND ALARMS

△								
△								
△	INCORPORATED PER DCP 95-V1N0035	12/5/97	CD	GLB	WFP	✗	SCALE: NONE	DRAWING NO.
△	ISSUED FOR CONSTRUCTION	SEE MICROFILM FOR	SIGNATURES				JOB NO. 10604	REV
NO.	REVISIONS	DATE	DR	CHK	APPV	DTL	1X5DN090-3	4

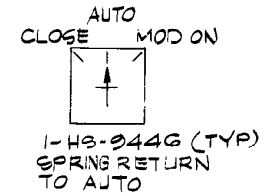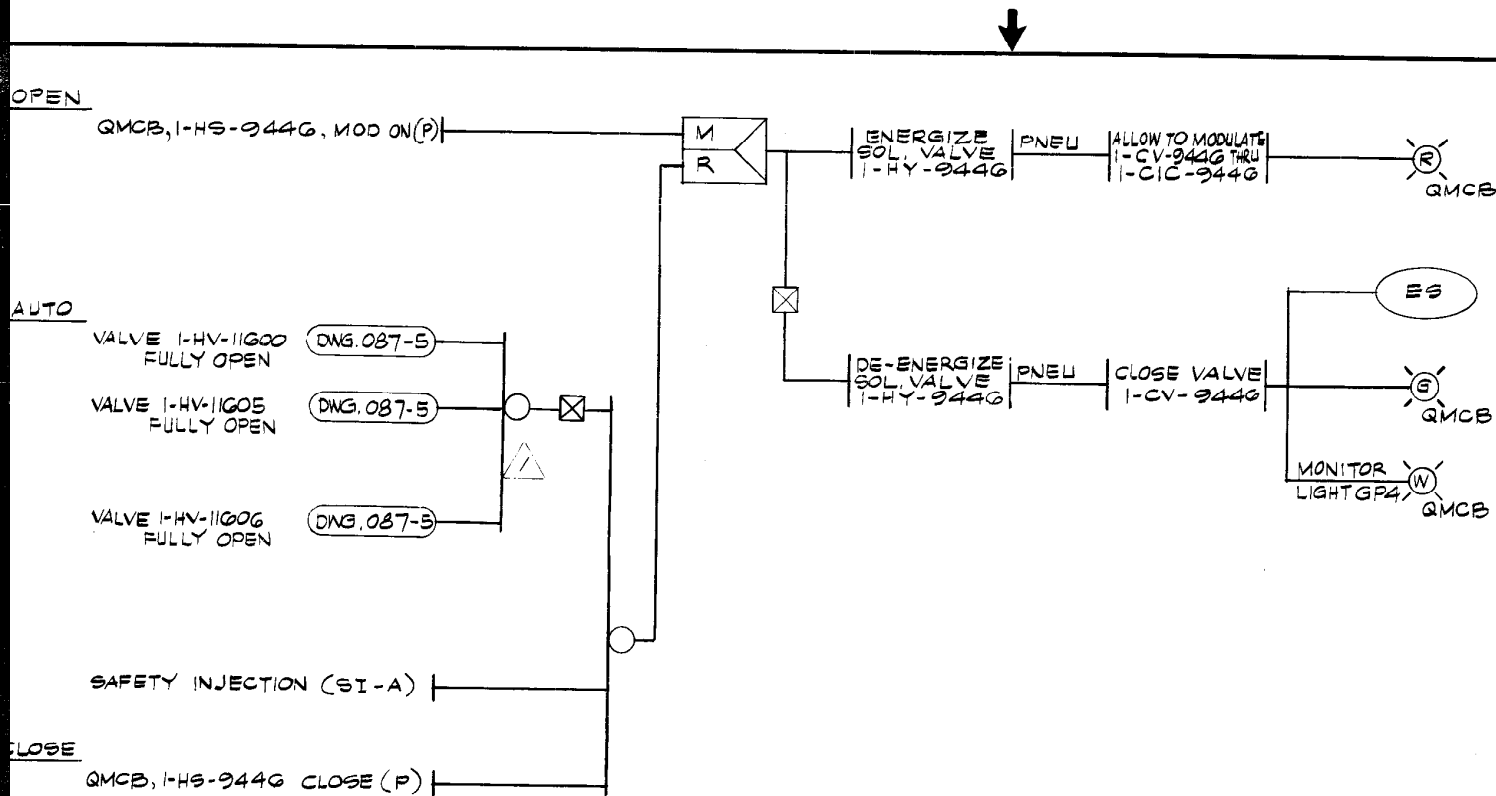

NOTES:

1. VALVE 1-CV-944G SHOWN, OTHER VALVES LISTED IN TABLE 1 ARE SIMILAR.

REF. DVGS.:

P&ID 1X40B133-1,2  
E.O. 1X30-00-K04J,K

TABLE 1

TRAIN	SWITCH	VALVE	SOL. VALVE NOS.	SFTY SIG.	CONTR.	NSCW DISCH. VALVES
A	1-HS-944G	1-CV-944G	1-HY-944G	SI-A	1-CIC-944G	1-HV-11600, 11605, 11606
B	-9447	-9447	-9447	SI-B	-9447	1-HV-11607, 11612, 11613

NO.	REVISIONS	DATE	DR	CHK.	SUPV.	EGL	EGS	CHF. E.	P. E.	Q. A. E.	ENG. MGR.
	DELETED NOTE PER DCN #1	1/21/87	ALJ	11/1/87							
	CHANGED RESET LOGIC, ADDED NOTES.	1-7-86	ZEP	ALJ							
	ISSUED FOR CONSTRUCTION	3/21/85	ZEP	1/1/85							

NSCW TOWER BLOWDOWN VALVE "Q"

**BECHTEL**  
LOS ANGELES


**GEORGIA POWER COMPANY**  
**ALVIN W. VOGTLE NUCLEAR PLANT**

**CONTROL LOGIC DIAGRAM**  
**NUCLEAR SERVICE COOLING WATER**  
**SYSTEM AUXILIARIES AND ALARMS**

SCALE: NONE      DRAWING NO.      REV.

JOB NO. 9510      1X5DN090-6      2

THIS DRAWING AND THE DESIGN IT COVERS ARE THE PROPERTY OF SCS. THEY ARE LOANED TO YOU BY THE BORROWER'S EXPRESS AGREEMENT THAT THEY WILL NOT BE REPRODUCED, COPIED, LOANED, EXHIBITED, OR USED EXCEPT IN THE LIMITED WAY AND PRIVATE USE PERMITTED BY ANY WRITTEN CONSENT GIVEN BY THE LENDER TO THE BORROWER.

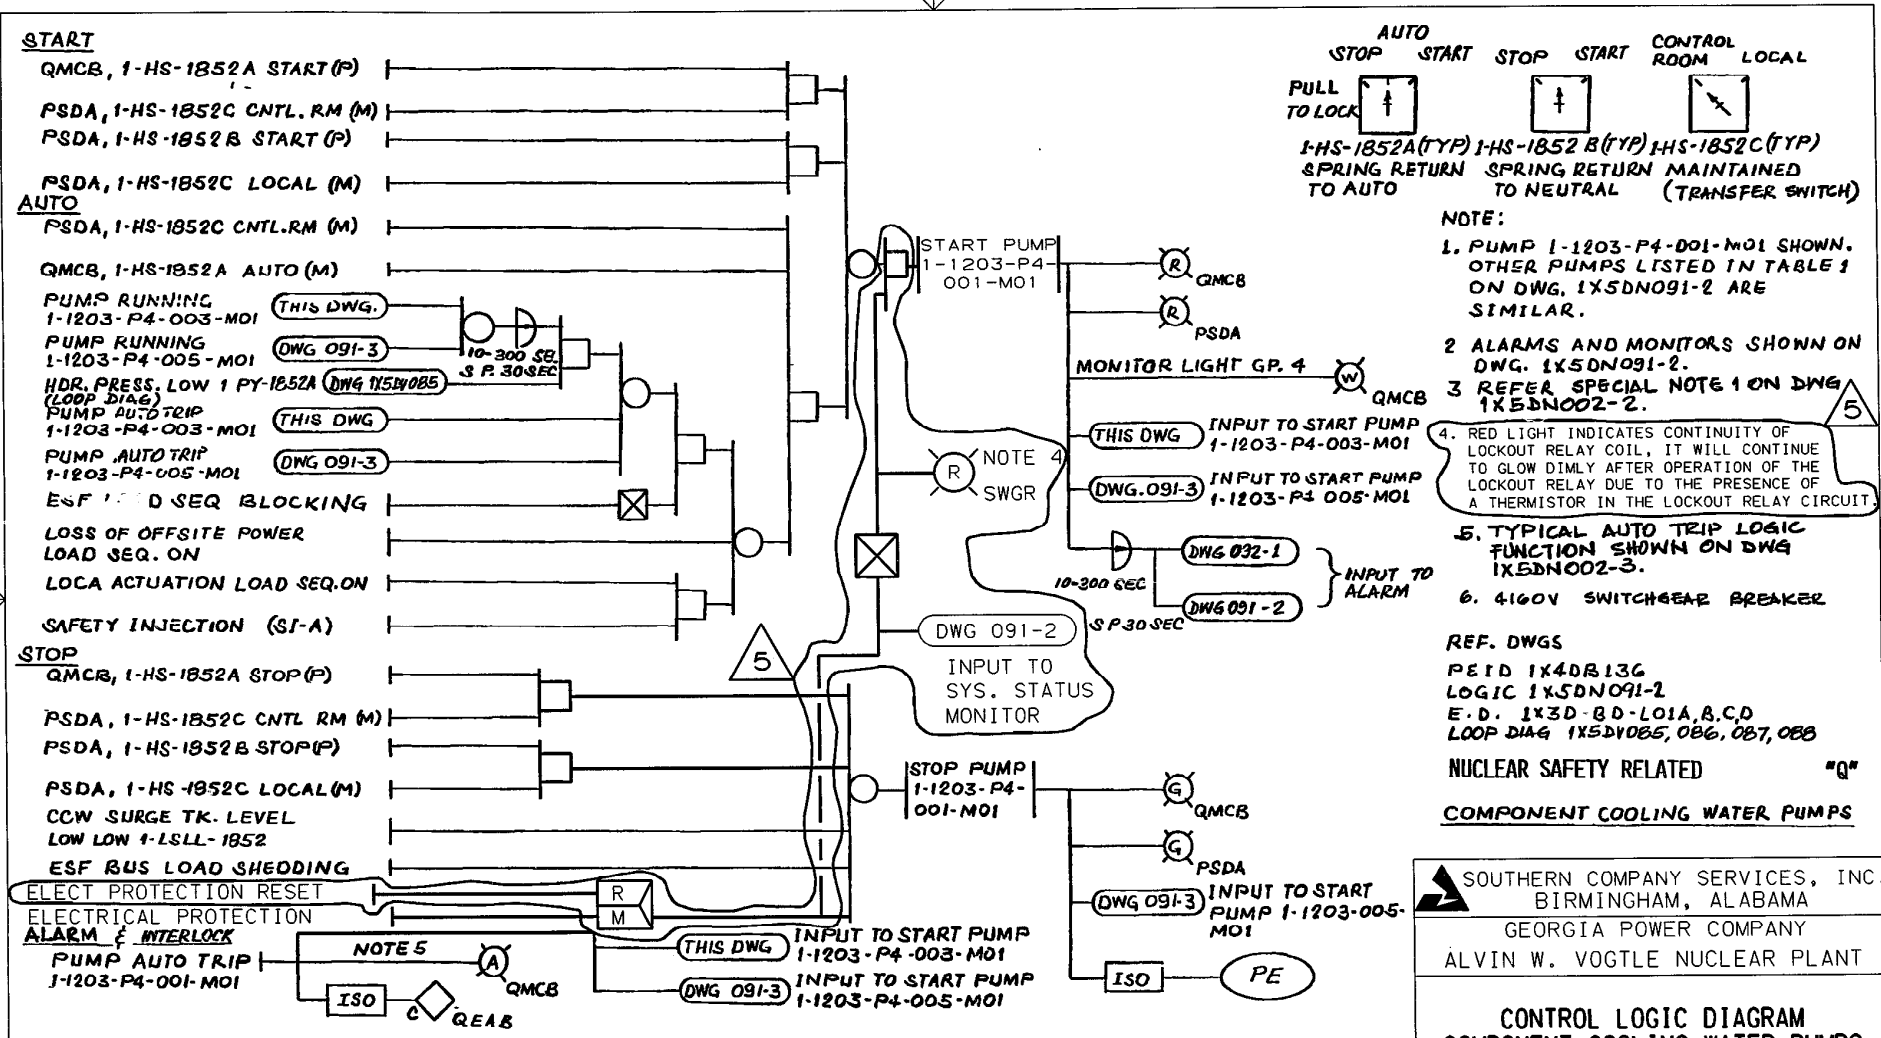

**AUTO**  
 STOP START STOP START CONTROL ROOM LOCAL  
 PULL TO LOCK

1-HS-1852A (TYP) 1-HS-1852 B (TYP) 1-HS-1852 C (TYP)  
 SPRING RETURN SPRING RETURN MAINTAINED  
 TO AUTO TO NEUTRAL (TRANSFER SWITCH)

- NOTE:**
1. PUMP 1-1203-P4-001-M01 SHOWN. OTHER PUMPS LISTED IN TABLE 1 ON DWG. 1X5DN091-2 ARE SIMILAR.
  - 2 ALARMS AND MONITORS SHOWN ON DWG. 1X5DN091-2.
  - 3 REFER SPECIAL NOTE 1 ON DWG. 1X5DN002-2.
  4. RED LIGHT INDICATES CONTINUITY OF LOCKOUT RELAY COIL, IT WILL CONTINUE TO GLOW DIMLY AFTER OPERATION OF THE LOCKOUT RELAY DUE TO THE PRESENCE OF A THERMISTOR IN THE LOCKOUT RELAY CIRCUIT.
  5. TYPICAL AUTO TRIP LOGIC FUNCTION SHOWN ON DWG. 1X5DN002-3.
  6. 4160V SWITCHGEAR BREAKER

**REF. DWGS**  
 PEID 1X4DB13G  
 LOGIC 1X5DN091-2  
 E.D. 1X3D-8D-LO1A,B,C,D  
 LOOP DIAG 1X5DV085, 086, 087, 088

**NUCLEAR SAFETY RELATED "Q"**

**COMPONENT COOLING WATER PUMPS**




**SOUTHERN COMPANY SERVICES, INC.**  
 BIRMINGHAM, ALABAMA  
 GEORGIA POWER COMPANY  
 ALVIN W. VOGTLE NUCLEAR PLANT

**CONTROL LOGIC DIAGRAM  
 COMPONENT COOLING WATER PUMPS**


										ENG MGR
INCORP. ABN-21051	11/30/95	MWD	WLM	EQH						
REVISIONS										
ISSUED FOR CONSTRUCTION	DATE	DR	CHK	APPV	DTL					
SEE MICROFILM FOR SIGNATURES										
										DATE
										SCALE: NONE
										DRAWING NO.
										REV
										JOB NO. 10604
										1X5DN091-1
										5

THIS DRAWING AND THE DESIGN IT COVERS ARE THE PROPERTY OF SOUTHERN COMPANY SERVICES, INC. AND ARE NOT TO BE REPRODUCED, COPIED, LOANED, EXHIBITED, OR USED EXCEPT IN THE LIMITED WAY AND UNDER THE SUPERVISION AND CONTROL OF THE BORROWER. PRIVATE USE PERMITTED BY ANY WRITTEN CONSENT GIVEN BY THE LENDER TO THE BORROWER.

**ALARMS**

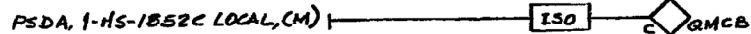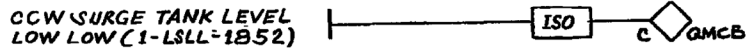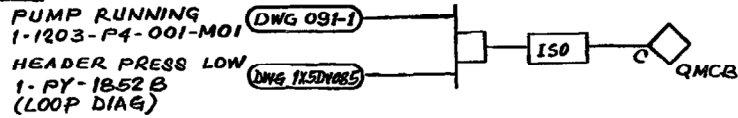

**MONITORS**

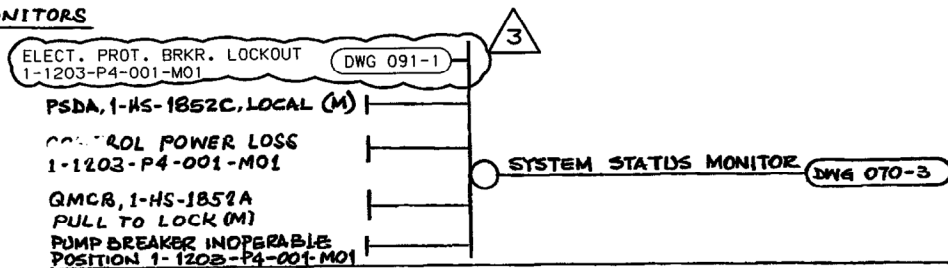

**NOTE:**

1. TYPICAL ALARMS AND MONITORS SHOWN. OTHER DEVICES LISTED IN TABLE 1 AND 2 SIMILAR.
2. TABLE 1 LOGIC SHOWN ON DWG. 1X5DN091-1 AND TABLE 2 LOGIC SHOWN ON DWG. 1X5DN091-3.

**REF. DWGS**

- P&ID 1X4DB136  
LOGIC 1X5DN091-1, 091-3  
E.D 1X3D-80-LO1A, B, C, D, E, F  
LOOP DIAG 1X5DY085, 086, 087, 088, 089, 090

**NUCLEAR SAFETY RELATED**

**ALARMS, MONITOR AND EQPT. LIST "Q"**

**TABLE 1**

TRAIN	PUMP NO. (1-1203-)	SAFETY ACT. SIG.	SWITCHES			PRESS SW LOOP DIAG	LEVEL SW	PUMP START/OVLD. (1-1203-)	
A	P4-001-M01	SI-A	1-HS-1852A	1-HS-1852B	1-HS-1852C	1-PY-1852A/B	1-LSLL-1852	P4-003-M01	P4-005-M01
B	P4-002-M01	SI-B	1853A	1853B	1853C	1853A/B	-1853	P4-004-M01	P4-006-M01
A	P4-003-M01	SI-A	1854A	1854B	1854C	1854A/B	1854	P4-001-M01	P4-005-M01
B	P4-004-M01	SI-B	1855A	1855B	1855C	1855A/B	1855	P4-002-M01	P4-006-M01

**TABLE 2**

TRAIN	PUMP NO. (1-1203-)	SAFETY ACT. SIG.	SWITCHES			PRESS SW LOOP DIAG	LEVEL SW	PUMP START/OVLD. (1-1203-)	
A	P4-005-M01	SI-A	1-HS-1856A	1-HS-1856B	1-HS-1856C	1-PY-1856A/B	1-LSLL-1856	P4-001-M01	P4-003-M01
B	P4-006-M01	SI-B	1857A	1857B	1857C	1857A/B	1857	P4-002-M01	P4-004-M01


**SOUTHERN COMPANY SERVICES, INC.**  
BIRMINGHAM, ALABAMA  
GEORGIA POWER COMPANY  
ALVIN W. VOGTLE NUCLEAR PLANT

**CONTROL LOGIC DIAGRAM  
COMPONENT COOLING WATER PUMPS**

△												ENG MGR
△	INCORP. ABN-21052		1/6/85	MWD	WLM	EB/3						
△	REVISIONS		DATE	DR	CHK	APPV	DTL					DATE
△	ISSUED FOR CONSTRUCTION			SEE	MICROFILM	FOR	SIGNATURES					
NO.	REVISIONS		DATE	DR								

SCALE: NONE	DRAWING NO.	REV
JOB NO. 10604	1X5DN091-2	3

THIS DRAWING AND THE DESIGN IT COVERS ARE THE PROPERTY OF SCS. THEY ARE LOANED TO THE BORROWER'S EXPRESS AGREEMENT THAT THEY WILL NOT BE REPRODUCED, COPIED, EXHIBITED, LOANED, OR USED EXCEPT IN THE LIMITED WAY AND PRIVATE USE PERMITTED BY THE LENDER TO THE BORROWER.

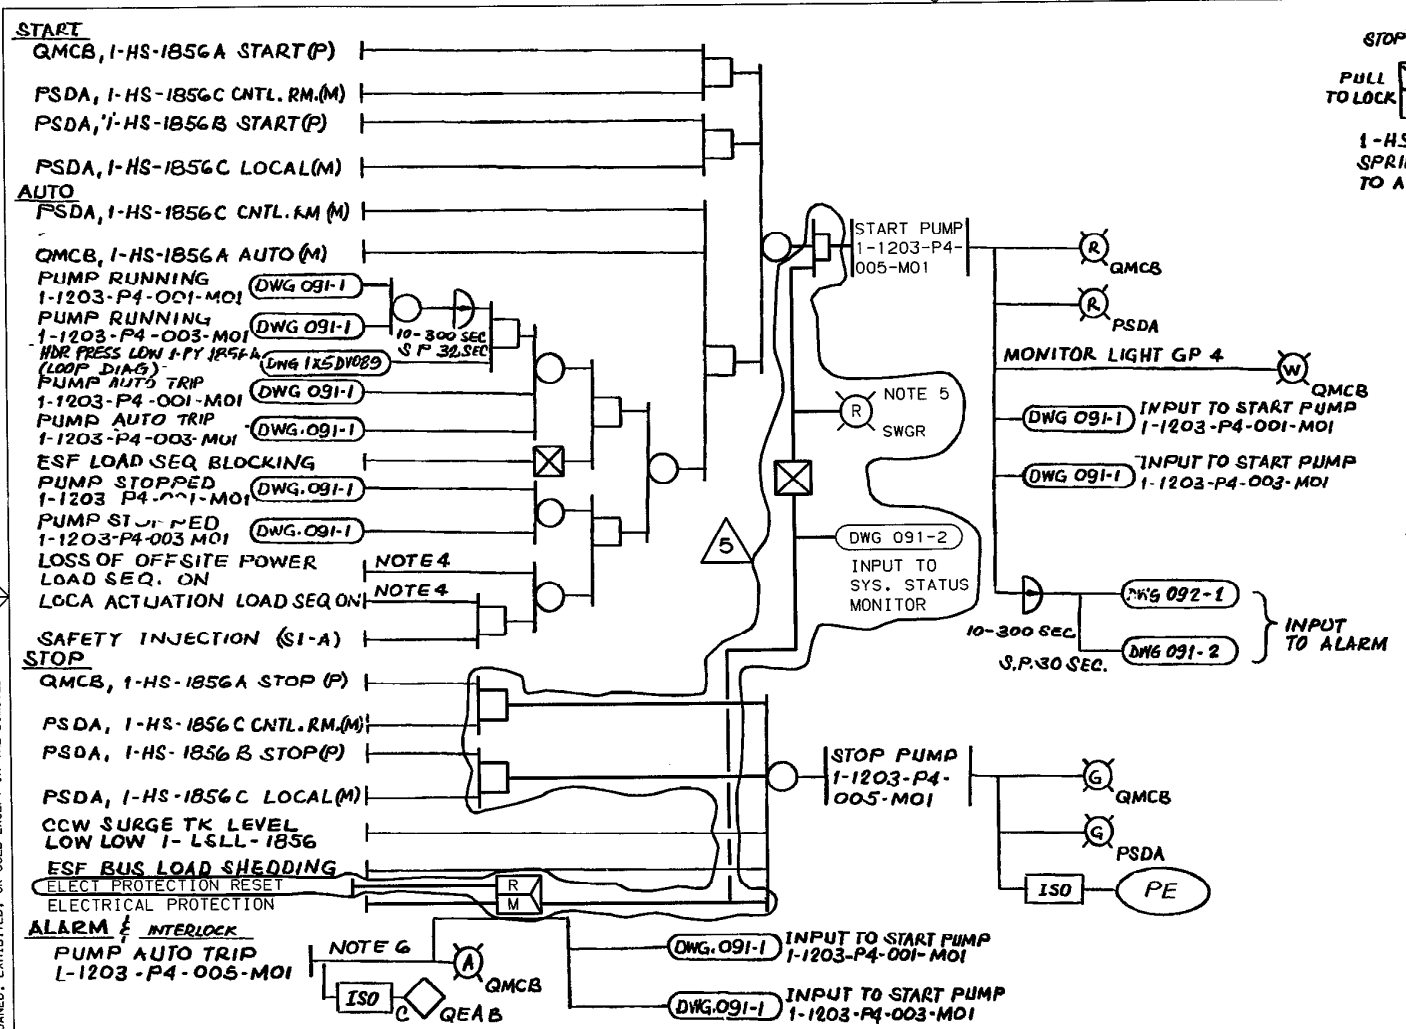

STOP AUTO START STOP START CONTROL ROOM LOCAL  
 PULL TO LOCK

1-HS-1856A (TYR) 1-HS-1856B (TYR) 1-HS-1856C (TYR)  
 SPRING RETURN TO AUTO SPRING RETURN TO NEUTRAL (TRANSF SW)

- NOTE:
1. PUMP 1-1203-P4-005-M01 SHOWN ON DWG. 1X5DN091-2 SIMILAR.
  2. REFER TO SPECIAL NOTE 1 ON DWG. 1X5DN002-2
  3. ALARMS AND MONITOR SHOWN ON DWG. 1X5DN091-2.
  4. SEQUENCER LOADING SIGNAL SHALL BE THE NEXT STEP TIMING OF PUMPS SHOWN ON DWG. 1X5DN091-1
  5. RED LIGHT INDICATES CONTINUITY OF LOCKOUT RELAY COIL. IT WILL CONTINUE TO GLOW DIMLY AFTER OPERATION OF THE LOCKOUT RELAY DUE TO THE PRESENCE OF A THERMISTOR IN THE LOCKOUT RELAY CIRCUIT.
  6. TYPICAL AUTO TRIP LOGIC FUNCTION SHOWN ON DWG. 1X5DN002-3.
  7. 4160V SWGR CKT BKR.
- REF DWGS:  
 P&ID 1X4DB136  
 E.D. 1X3D-6D-LOIE, F  
 LOGIC 1X5DN091-2  
 LOOP DIAG 1X5DN089, 090

NUCLEAR SAFETY RELATED "Q"  
 CCW PUMPS

SOUTHERN COMPANY SERVICES, INC.  
 BIRMINGHAM, ALABAMA

GEORGIA POWER COMPANY  
 ALVIN W. VOGTLE NUCLEAR PLANT

CONTROL LOGIC DIAGRAM  
 COMPONENT COOLING WATER PUMPS

△												ENG MGR
△	INCORP. ABN-21053	11/30/95	MWD	WLM	EOH							
△	REVISIONS	DATE	DR	CHK	APPV	DTL						DATE
△	ISSUED FOR CONSTRUCTION		SEE	MICROFILM	FOR	SIGNATURES						
NO.	REVISIONS	DATE	DR									

SCALE: NONE	DRAWING NO.	REV
JOB NO. 10604	1X5DN091-3	5

This drawing and the design it covers are the property of BECHTEL. They are merely loaned and on the borrower's express agreement that they will not be re-produced, copied, loaned, exhibited, or used except in the limited way and private use permitted by any written consent given by the lender to the borrower.



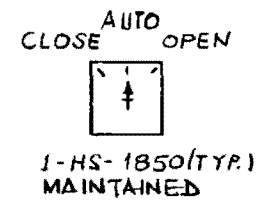


TABLE 1

VALVE	SWITCH	LEVEL SW	
1-LV-1850	1-HS-1850	1-LSH-1850	1-LSL-1850
↓ 1851	↓ 1851	↓ 1851	↓ 1851

NOTE:  
 1. VALVE 1-LV-1850 SHOWN. 1-LV-1851 SIMILAR.  
 2. VALVE LISTED IN TABLE 1 ARE GATE VALVES  
 OPEN - LIMIT STOPPED  
 CLOSE - TORQUE STOPPED

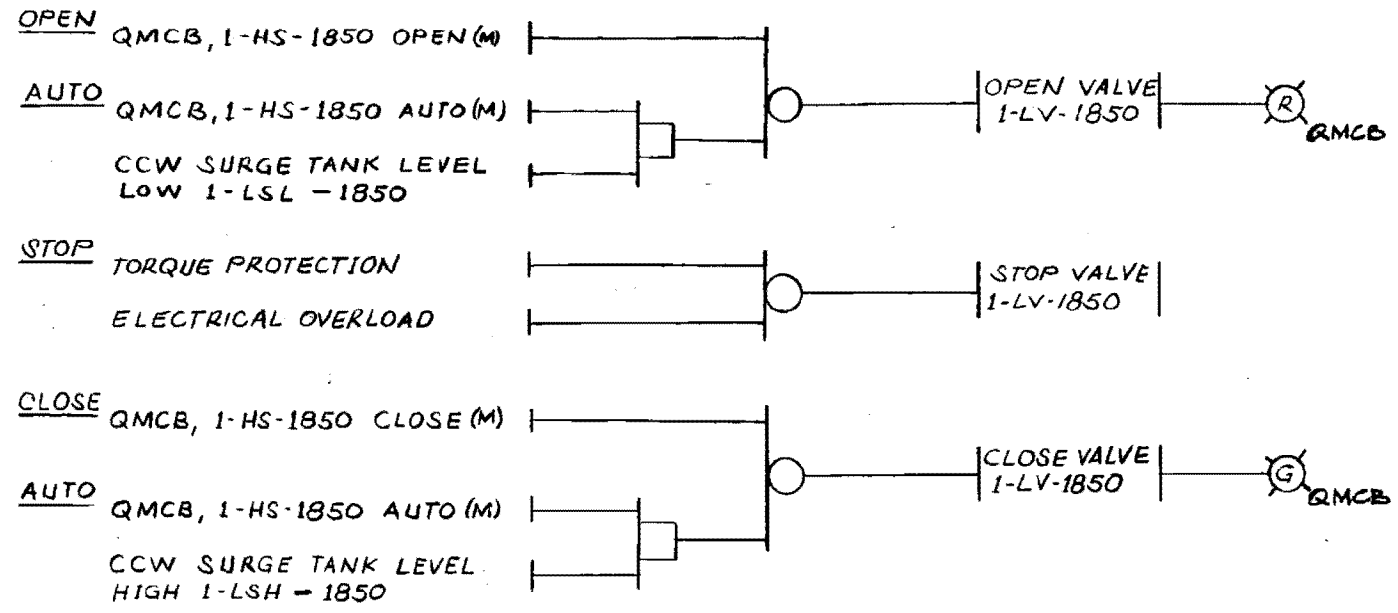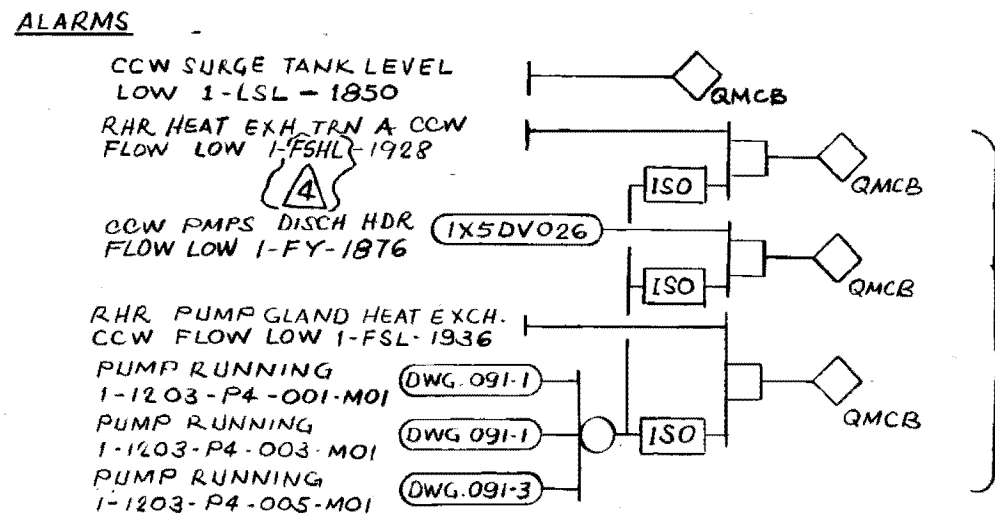

REF. DWG.  
 PEID 1X4DB136 & 137  
 E.D. 1X3D-80-LO16, LO1K, LO1A, LO1E  
 LOOP DIAG 1X5DN026, 027

FLOW SW	PUMP	FLOW SW
1-FSHL-1928	1-1203-P4-001-MO1	
1-FSL-1936	-003	1-FY-1876 (LOOP DIAG 026)
	-005	
1-FSHL-1929	-002	
1-FSL-1937	-004	1-FY-1877 (LOOP DIAG 027)
	-006	

NORMAL-MAKE-UP VALVE

<b>BECHTEL</b> LOS ANGELES		
<b>GEORGIA POWER COMPANY</b> <b>ALVIN W. VOGTLE NUCLEAR PLANT</b>		
CONTROL LOGIC DIAGRAM COMPONENT COOLING SYSTEM AUXILIARIES AND ALARMS		
SCALE: NONE	DRAWING NO.	REV.
JOB NO. 9510	1X5DN092-1	4



NO.	REVISIONS	DATE	DR	CHK	SUPV.	EGL	EGS	CHF. E.	R. E.	Q. A. E.	ENG. MGR.
△	ADDED ALARM INPUT PER PEID 137 DCN #1	8-28-81	FD	FAL							
△	ADDED ALARM INPUT AND REVISED AS INDICATED	7-9-81	FAL	V.V.							
△	INCORPORATED DCN #1	2-2-81	RBR	ALV							
△	ISSUED FOR CONSTRUCTION	1-12-77	HL	FAL	MKK						

PEID 436 REV. 2  
 137 REV. 7 DCN #1

SIZE B 11x17



This drawing and the design it covers are the property of BECHTEL. They are produced, copied, loaned, exhibited, or used except in the limited way and private use permitted by any written consent given by the lender to the borrower.

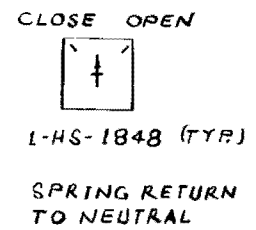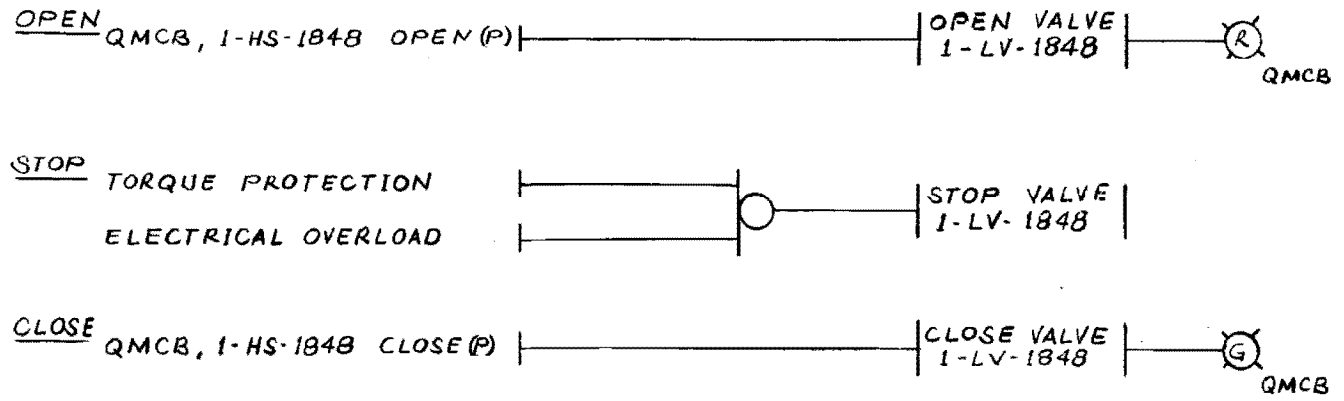

NOTE:  
 1. VALVE 1-LV-1848 SHOWN. 1-LV-1849 SIMILAR.  
 2. VALVES LISTED IN TABLE 1 ARE GATE VALVES.  
 OPEN - LIMIT STOPPED  
 CLOSE - TORQUE STOPPED

REF. DWGS  
 PEID 1X4DB136  
 E.D. 1X3D-BD-L01H, LOIM

TABLE 1



VALVE	SWITCH
1-LV-1848	1-HS-1848
↓ 1849	↓ 1849

SCANNED DATE \_\_\_\_\_  
 BACK-UP MAKE-UP VALVE

<b>BECHTEL</b> LOS ANGELES		
<b>GEORGIA POWER COMPANY</b> <b>ALVIN W. VOGTLE NUCLEAR PLANT</b>		
CONTROL LOGIC DIAGRAM COMPONENT COOLING SYSTEM AUXILIARIES AND ALARMS		
SCALE: NONE	DRAWING NO.	REV.
JOB NO. 9510	1X5DN092-2	1

NO.	REVISIONS	DATE	DR	CHK	SUPV.	EGL	EGS	CHF. E.	P. E.	Q. A. E.	ENG. MGR.
	ADDED REF DWGS.	3-18-80	HL	FAL							
	ISSUED FOR CONSTRUCTION	1-12-79	HL	FAL	AKK						

*MWD*

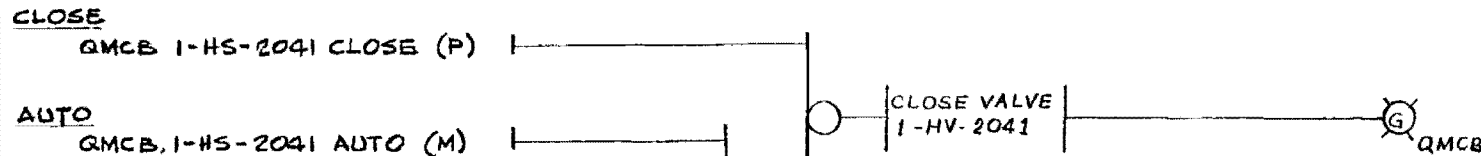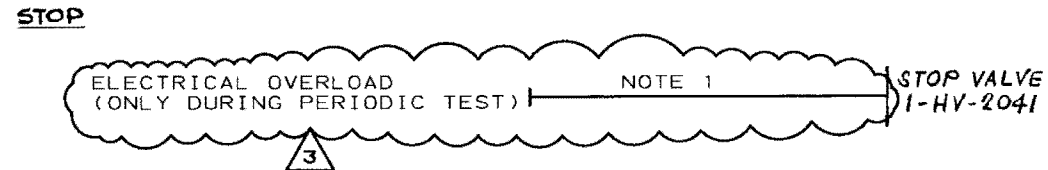


RECTOR COOLANT PUMPS  
THERMAL BARRIER OUTLET  
HEADER PRESSURE HIGH  
1-PY-2041A  
(LOOP DIAG)  
REACTOR COOLANT PUMPS  
THERMAL BARRIER OUTLET  
HEADER FLOW HIGH  
1-FY-2043  
(LOOP DIAG)

DWG 1X5DV060

DWG 1X5DV060


**ALARM AND MONITOR**

CNTL PWR. LOSS  
1-HV-2041  
ELECT. OVERLOAD  
1-HV-2041

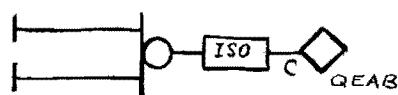

VALVE CNTL PWR  
LOSS 1-HV-2041

SYS. STATUS MONITOR (DWG 070-3)

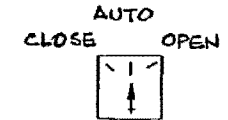

1-HS-2041

SPRING RETURN  
TO AUTO

- NOTE:
- REFER TO SPECIAL NOTE 2 ON DWG 1X5DN002-2
  - VALVE IS A GATE VALVE  
OPEN - LIMIT STOPPED  
CLOSE - LIMIT STOPPED
  - VALVE 1-HV-2041 POWERED FROM TRAIN B
- 3

REF DWGS

- P&ID 1X4DB138-2
- E.D. 1X3D-BD-LOSP
- LOOP DIAG 1X5DV060

NUCLEAR SAFETY RELATED "Q"

REACTOR COOLANT PUMPS THERMAL  
BARRIER ACCWS OUTLET HEADER  
VALVE

SOUTHERN COMPANY SERVICES, INC.  
BIRMINGHAM, ALABAMA

GEORGIA POWER COMPANY  
ALVIN W. VOGTLE NUCLEAR PLANT

CONTROL LOGIC DIAGRAM  
AUXILIARY COMPONENT  
COOLING WATER AUXILIARIES

△											
△											
3	INCORP. PER DCP 95-V1N0022.	9/23/60	GD	AWM	SM					SCALE: NONE	DRAWING NO.
△	ISSUED FOR CONSTRUCTION	SEE MICROFILM FOR SIGNATURES									REV
NO.	REVISIONS	DATE	DR	CHK	APPV	DTL	JOB NO. 10604	1X5DN094-3	3		

THIS DOCUMENT CONTAINS PROPRIETARY, CONFIDENTIAL, AND/OR TRADE SECRET INFORMATION OF THE SUBSIDIARIES OF THE SOUTHERN COMPANY OR OF THIRD PARTIES. IT IS INTENDED FOR USE ONLY BY EMPLOYEES OF, OR AUTHORIZED CONTRACTORS OF, THE SUBSIDIARIES OF THE SOUTHERN COMPANY. UNAUTHORIZED POSSESSION, USE, DISTRIBUTION, COPYING, DISSEMINATION, OR DISCLOSURE OF ANY PORTION HEREOF IS PROHIBITED.

15DN0943

START  
QEAB, 1-HS-9044 START(M)

AUTO  
QEAB, 1-HS-9044 AUTO(M)

DAY TANK LEVEL LOW  
LOW, 1-LSLL-9020

PUMP RUNNING  
1-2403-P4-002-M01

PUMP DISCH. PRESSURE  
LOW 1-PY-9014A  
(LOOP DIAG)

DAY TANK LEVEL  
LOW 1-LSL-9020

STOP  
QEAB, 1-HS-9044 STOP(M)

DAY TANK LEVEL HIGH  
1-LSH-9020

ELECTRICAL PROTECTION

ALARMS



PUMP AUTO TRIP  
1-2403-P4-001-M01

STORAGE TANK LEVEL  
HIGH, 1-LIS-9022

STORAGE TANK LEVEL  
LOW, 1-LIS-9022

DAY TANK LEVEL  
HIGH, 1-LSHL-9018

DAY TANK LEVEL LOW  
1-LSHL-9018

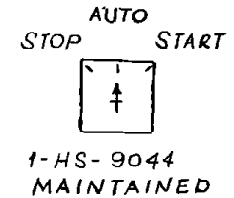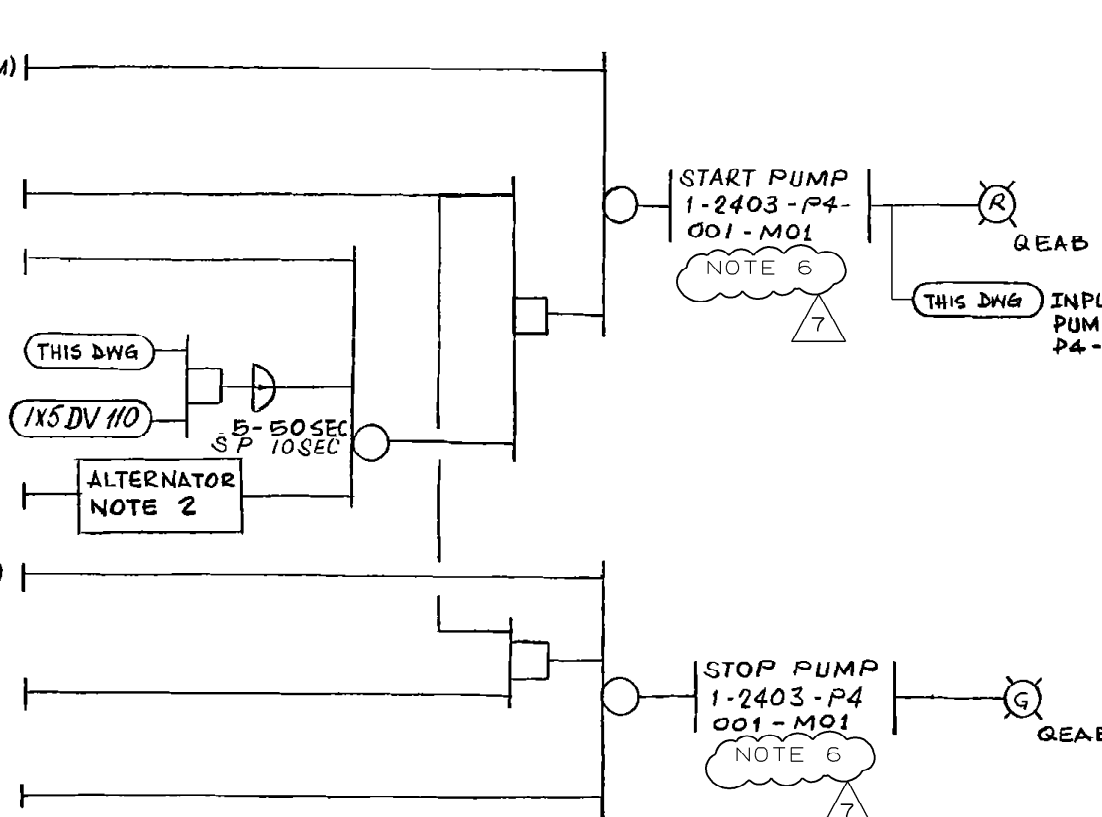

NOTE:

1. PUMP 1-2403-P4-001 OF TRAIN A SHOWN OTHER PUMP LISTED IN TABLE 1 SIMILAR.
2. ALTERNATOR SWITCH SHALL ALTERNATELY START EACH PUMP OF THE DUPLEX.
3. 480V MOTOR STARTER
4. TYPICAL AUTO TRIP LOGIC SHOWN ON DWG 1X5DN002-3
5. ANNUN INPUT TO QEAB WILL BE FROM A RETRANSMITTING CONTACT ON PANEL PDG1 OR PDG2

6. THE CONTROL POWER TO THE TRAIN A (B) PUMP (LISTED) MAY BE PLUGGED INTO A TRAIN B (A) PUMP. THIS ARRANGEMENT SHOULD ONLY EXIST DURING PLANT EMERGENCIES OR FOR TESTING.

REF. DWGS.

- PEID 1X4DB170-1, 170-2
- ED 1X3D-BH-601X, 601Z, 602B & 602D
- LOOP DIAG. 1X5DV110, 111, 106 & 107

NUCLEAR SAFETY RELATED

FUEL OIL STORAGE TK PUMP "Q"

SOUTHERN COMPANY SERVICES, INC.  
BIRMINGHAM, ALABAMA

GEORGIA POWER COMPANY  
ALVIN W. VOGTLE NUCLEAR PLANT

CONTROL LOGIC DIAGRAM  
DIESEL GENERATOR  
FUEL OIL SYSTEM

CONTROL POWER LOSS  
1-2403-P4-001-M01  
QEAB, 1-HS-9044 STOP(M)



SYS STATUS  
MONITOR (DWG 070-12)

TABLE 1

TRN	PANEL	PUMP	SWITCH	DAY TK. LEVEL SW.	STOR. TK. LEVEL SW.	PRESS. SW. (LOOP DIAG)
A	PDG2	1-2403-P4-001-M01	1-HS-9044	1-LSHL-9018	1-LIS-9022	1-PY-9014A
		-002	9046	1-LSH-9020		9014B
B	PDG4	003	9045	1-LSHL-9019	1-LIS-9023	9015A
		004	9047	1-LSL-9021		9015B

NO.	REVISIONS	DATE	DR	CHK	APPV	DTL

SCALE: NONE	DRAWING NO.	REV
	1X5DN107-1	7
JOB NO. 10604		

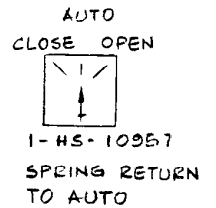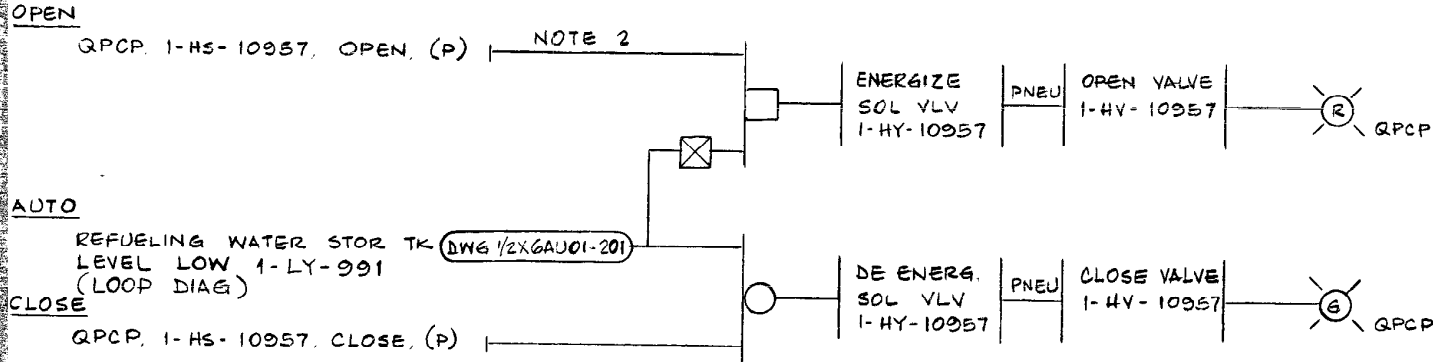

- NOTE:
1. VALVE 1-HY-10957 SHOWN VALVES LISTED IN TABLE 1 SIMILAR EXCEPT AS TABULATE
  2. HAND SWITCH SHALL BE HELD IN OPEN POSITION UNTIL VALVE IS FULLY OPEN TO ALLOW CIRCUIT TO SEAL IN THROUGH VALVE POSITION SWITCH

REF. DWGS.  
 PE ID 1X4DB121  
 E.D. 1X3D-BD-D058  
 LOOP DIAG 1/2 X 6A001-201

TABLE 1.

TRAIN	VALVE	HAND SWITCH	LEVEL SWITCH (LOOP DIAG)	SOLENOID VALVE
B	1-HY-10957	1-HS-10957	1-LY-991	1-HY-10957
A	10958	10958	990	10958

NUCLEAR SAFETY RELATED

ISOLATION VALVES

"Q"

**BECHTEL**  
 LOS ANGELES  
**GEORGIA POWER COMPANY**  
**ALVIN W. VOGTLE NUCLEAR PLANT**

CONTROL LOGIC DIAGRAM  
 REFUELING WATER SYSTEM



NO.	REVISIONS	DATE	DR	CHK	SUPV.	EGS	EGS	CHF. E.	P.E.	Q.A.E.	ENG. MGR.
1	ADDED SOLENOID VALVES TO TABLE 1	2-8-85	AS	ALV							
2	ADDED REF. DWG	7-9-81	FAL	V.V							
3	ISSUED FOR CONSTRUCTION	12-6-77	HL	FAL							

SCALE: NONE	DRAWING NO. 1X5DN114-4	REV. 2
JOB NO. 9510		

BM 9510

SIZE B 11x17

THIS DRAWING AND THE DESIGN IT COVERS ARE THE PROPERTY OF SOUTHERN COMPANY SERVICES, INC. THEY ARE MERELY LOANED AND ON THE BORROWER'S EXPRESS AGREEMENT THAT THEY WILL NOT BE REPRODUCED, COPIED, LOANED, EXHIBITED, OR USED EXCEPT IN THE LIMITED WAY AND PRIVATE USE PERMITTED BY THE LENDER TO THE BORROWER.

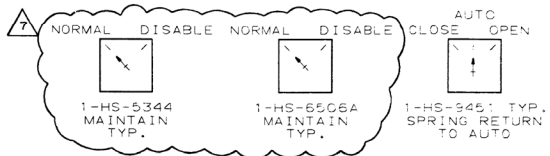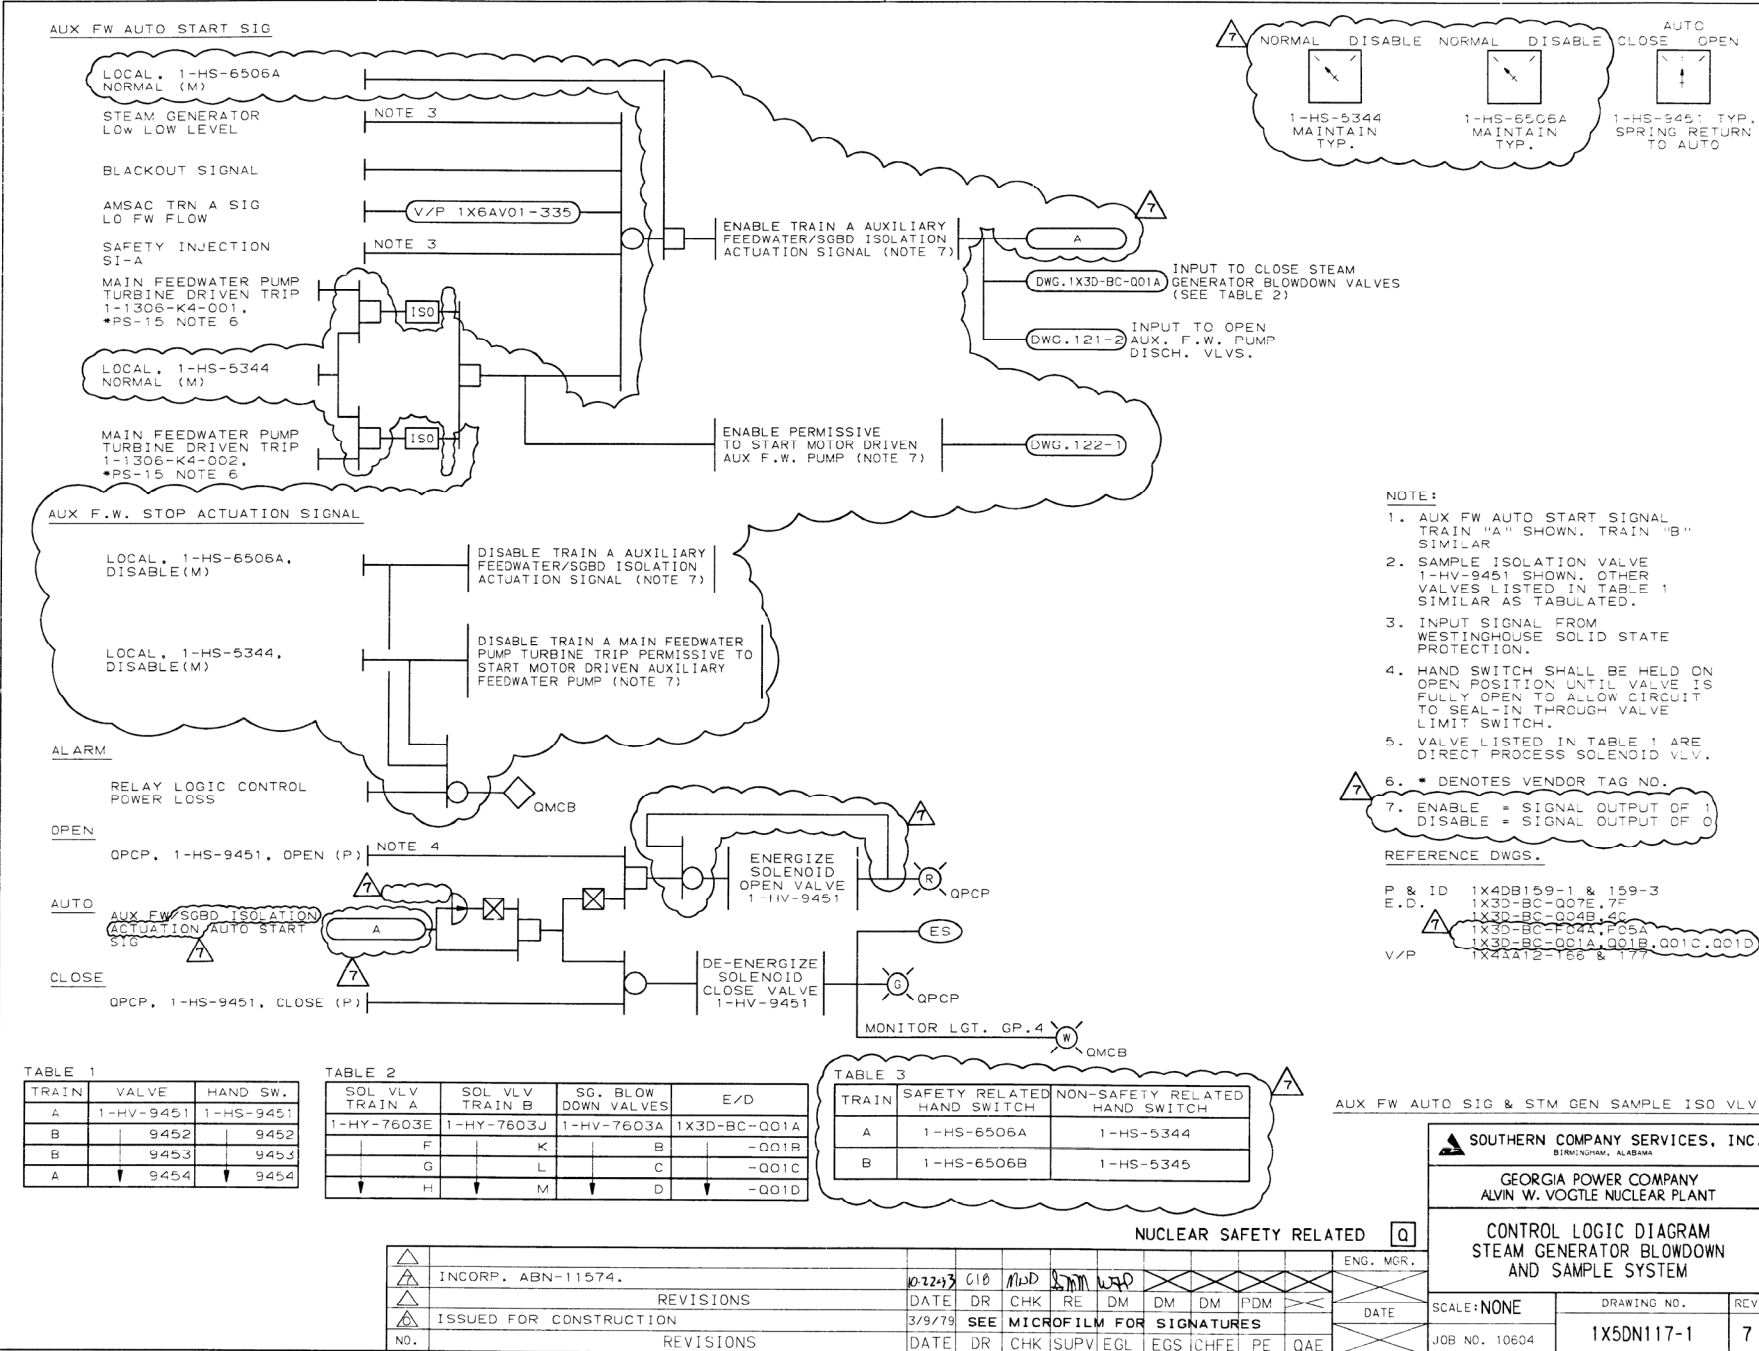

- NOTE:**
- AUX FW AUTO START SIGNAL TRAIN "A" SHOWN. TRAIN "B" SIMILAR
  - SAMPLE ISOLATION VALVE 1-HV-9451 SHOWN. OTHER VALVES LISTED IN TABLE 1 SIMILAR AS TABULATED.
  - INPUT SIGNAL FROM WESTINGHOUSE SOLID STATE PROTECTION.
  - HAND SWITCH SHALL BE HELD ON OPEN POSITION UNTIL VALVE IS FULLY OPEN TO ALLOW CIRCUIT TO SEAL-IN THROUGH VALVE LIMIT SWITCH.
  - VALVE LISTED IN TABLE 1 ARE DIRECT PROCESS SOLENOID VLV.
  - \* DENOTES VENDOR TAG NO.
  - ENABLE = SIGNAL OUTPUT OF 1  
DISABLE = SIGNAL OUTPUT OF 0

**REFERENCE DWGS.**

P & ID 1X4DB159-1 & 159-3  
 E.D. 1X3D-BC-007E, 7F  
 1X3D-BC-004B, 4C  
 1X3D-BC-004A, 405A  
 1X3D-BC-001A, 001B, 001C, 001D  
 V/P 1X2A12-166 & 177

**TABLE 1**

TRAIN	VALVE	HAND SW.
A	1-HV-9451	1-HS-9451
B	9452	9452
B	9453	9453
A	9454	9454

**TABLE 2**

SOL VLV TRAIN A	SOL VLV TRAIN B	SG. BLOW DOWN VALVES	E/D
1-HY-7603E	1-HY-7603J	1-HV-7603A	1X3D-BC-001A
F	K	B	-001B
G	L	C	-001C
H	M	D	-001D

**TABLE 3**

TRAIN	SAFETY RELATED HAND SWITCH	NON-SAFETY RELATED HAND SWITCH
A	1-HS-6506A	1-HS-5344
B	1-HS-6506B	1-HS-5345

NUCLEAR SAFETY RELATED										Q	
NO.	REVISIONS			DATE	DR	CHK	RE	DM	DM	PDM	DATE
	INCORP. ABN-11574.			10/22/73	GIS	MJD	SM	WFD			
	ISSUED FOR CONSTRUCTION			3/9/79	SEE	MICROFILM FOR SIGNATURES					
	REVISIONS			DATE	DR	CHK	SUPV	EGL	EGS	CHFE	PE

**SOUTHERN COMPANY SERVICES, INC.**  
 BIRMINGHAM, ALABAMA

**GEORGIA POWER COMPANY**  
 ALVIN W. VOGTLE NUCLEAR PLANT

**CONTROL LOGIC DIAGRAM**  
 STEAM GENERATOR BLOWDOWN  
 AND SAMPLE SYSTEM


SCALE: NONE      DRAWING NO. 1X5DN117-1      REV. 7

JOB NO. 10604


SIZE C 17X22

This drawing and the design it covers are the property of BECHTEL. They are produced, copied, loaned, altered, or used except in the limited way and for the use permitted by any written consent given by the lender to the borrower.

OPEN

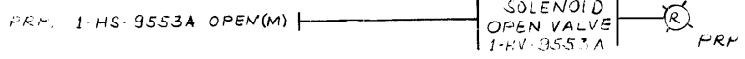

CLOSE

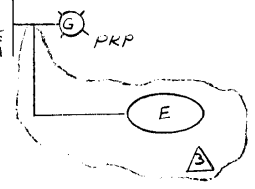

CLOSE OPEN



1-HV-9553A (TYP)  
MAINTAINED

NOTE:  
1. PROCESS SOLENOID VALVE 1-HV-9553A SHOWN. OTHER SOLENOID VALVES LISTED IN TABLE 1 ARE SIMILAR.

TABLE 1

VALVE	CNTL. SW.
1-HV-9553A	1-HS-9553A
9553B	9553B
9554A	9554A
9554B	9554B
9555A	9555A
9555B	9555B
9556A	9556A
9556B	9556B

REF. DWGS  
PEID 1X4DB159-1 & 159-2  
E.D. 1X3D-BC-2035, T

SAMPLING VALVES

<b>BECHTEL</b> LOS ANGELES		
<b>GEORGIA POWER COMPANY</b> ALVIN W. VOGTLE NUCLEAR PLANT		
CONTROL LOGIC DIAGRAM STEAM GENERATOR BLOWDOWN AND SAMPLE SYSTEM		
SCALE: NONE	DRAWING NO.	REV.
JOB NO. 9510	1X5DA117-2	3


NO.	REVISIONS	DATE	DR	CHK	SUPV.	EGL	EGS	CHF. E.	P. E.	Q. A. E.	ENG. MGR.
⚠	SHOWN COMP INPUT PER TID LIST REVS (NO PHYSICAL CONTACT)	3/27/85	ZEP	ALV							
⚠	REVISED REF. DWGS	12-8-81	AL	FAL							
⚠	CHANGED REF DWGS	1-10-80	HL	FAL							
⚠	ISSUED FOR CONSTRUCTION	3-9-79	NED	FAL	MKK						

BM 9510 PEID 159-1 REV 3

SIZE B 11x17

I CERTIFY THAT THE IMAGE CONTAINED ON THIS FRAME WAS MADE IN THE NORMAL AND REGULAR COURSE OF BUSINESS, ON THE DATE STATED BELOW AND THAT IT IS AN ACCURATE REPRODUCTION OF THE DOCUMENT SUBMITTED TO MICROGRAPHICS.

DATE: 3/27/85  
 CAMERA OPERATOR: Ben M...  
 SECTION SUPERVISOR: [Signature]

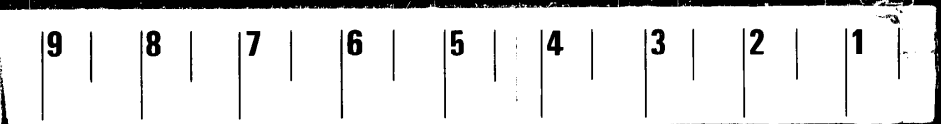

This drawing and the design it covers are the property of BECHTEL. They are to be used only for the purposes intended and may not be reproduced, copied, issued, exhibited, or used except in the limited way and private use permitted by any written consent given by the issuer to the borrower.

**OPEN**

QPCP, 1-HS-5104, OPEN. (P)

NOTE 2

ENERGIZE  
SOL VALVE  
1-HY-5104

PNEU

OPEN  
VALVE  
1-HV-5104



QPCP

CLOSE OPEN



1-HS-5104 (TYP)  
SPRINGS RETURN  
TO NEUTRAL

**CLOSE**

QPCP, 1-HS-5104, CLOSE (P)


DE-ENERGIZE  
SOL VALVE  
1-HY-5104

PNEU

CLOSE  
VALVE  
1-HV-5104



QPCP

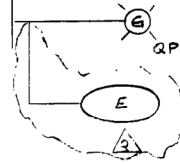

NOTE:

1. VALVE 1-HV-5104 SHOWN. OTHER VALVES LISTED IN TABLE 1 ARE SIMILAR.
2. HAND SWITCH SHALL BE HELD IN OPEN POSITION UNTIL VALVE IS FULLY OPEN TO ALLOW CIRCUIT TO SEAL IN THROUGH VALVE LIMIT SWITCH.

TABLE 1

SERVICE	HAND SWITCH	SOL VALVE	VALVE
CHEMICAL FEED	1-HS-5104	1-HY-5104	1-HV-5104
	5	5	5
	6	6	6
	7	7	7
WET LAYUP	1-HS-5278	1-HY-5278	1-HV-5278
	70	70	70
	80	80	80
	81	81	81

REF:

P & I D 1X4DB150-1, 159-3 & 168-3  
E. D. 1X3D-80-C04N, Q04A

STM GEN CHEM FEED & WET LAYUP VALVE

<b>BECHTEL</b> LOS ANGELES		
GEORGIA POWER COMPANY ALVIN W. VOGTLE NUCLEAR PLANT		
CONTROL LOGIC DIAGRAM STEAM GENERATOR BLOWDOWN AND SAMPLE SYSTEM		
SCALE: NONE	DRAWING NO.	REV.
JOB NO. 9510	1X5DN117-3	3

NO.	REVISIONS	DATE	DR	CHK	SUPV.	EGL	EGS	CHF. E.	P. E.	Q. A. E.	ENG. MGR.
1	ADDED COMP INPUT PER I/D LIST REVS (NO PHYSICAL IMPACT)	3/27/85	ZEP	ALV							
2	ADDED REF DWG	12/8/81	ALV	FAL							
3	ADDED REF DWGS	1-10-80	AL	FAL							
4	ISSUED FOR CONSTRUCTION	9/17/79	AL	FAL	MKK						






BM 9510 P&ID 150-1 REV. P&ID KA-3 REV.

SIZE B 11x17

I CERTIFY THAT THE IMAGE CONTAINED ON THIS FRAME WAS MADE IN THE NORMAL AND REGULAR COURSE OF BUSINESS, ON THE DATE STATED BELOW AND THAT IT IS AN ACCURATE REPRODUCTION OF THE DOCUMENT SUBMITTED TO MICROGRAPHICS.

DATE: 3/27/85 CAMERA OPERATOR: SECTION SUPERVISOR:

9 | 8 | 7 | 6 | 5 | 4 | 3 | 2 | 1

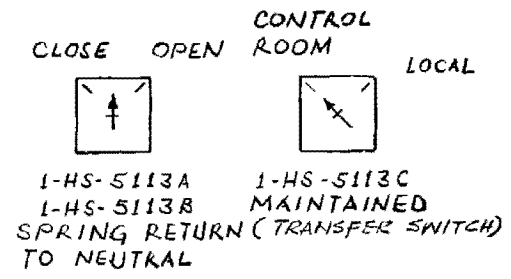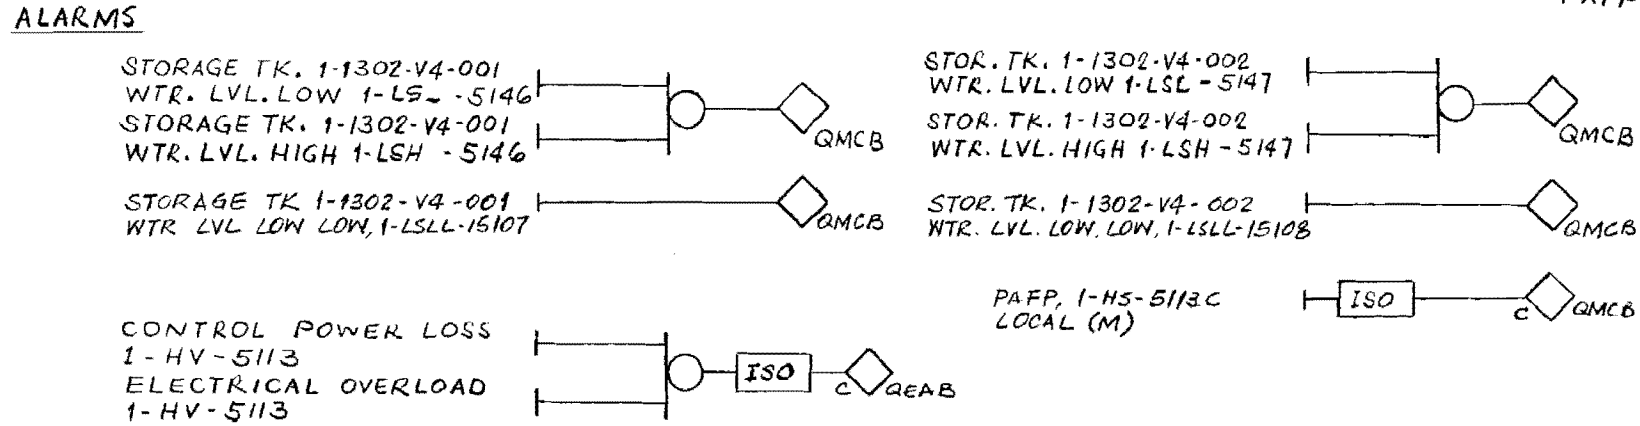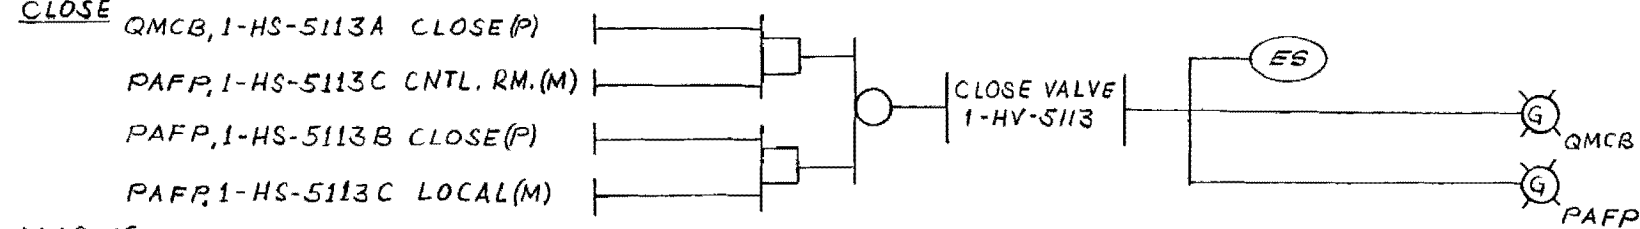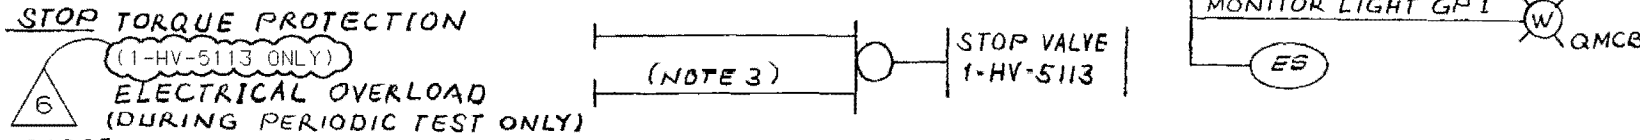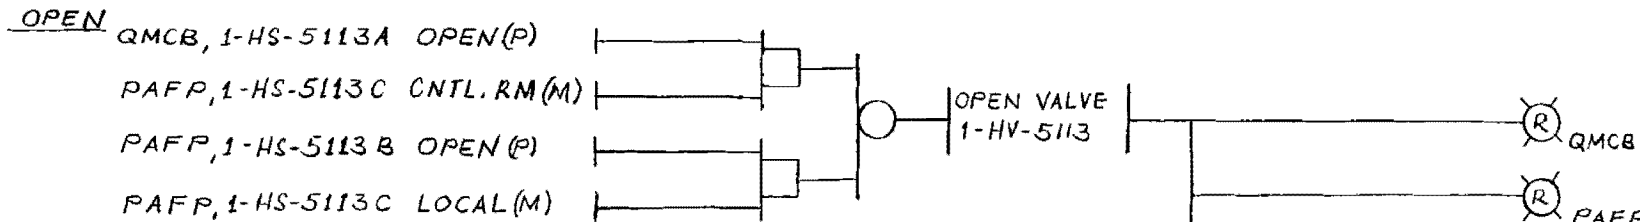

- NOTE:
1. VALVE 1-HV-5113 SHOWN. OTHER VALVE LISTED IN TABLE 2 ARE SIMILAR.
  2. REFER TO SPECIAL NOTE 1 ON DWG. 1X5DN002-2.
  3. REFER TO SPECIAL NOTE 2 ON DWG. 1X5DN002-2.
  4. VALVES LISTED IN TABLE 2 ARE BUTTERFLY VALVES  
OPEN - LIMIT STOPPED  
CLOSE - LIMIT STOPPED
  5. VALVE 1-HV-5113 HAS A D.C. MOTOR OTHERS ARE A.C. MOTORS.

REF. DWGS.  
P&ID 1X5DN161-1&2  
E.D. 1X3D-BC-F02C, D. B

TABLE 2

SERVICE	TRAIN	VALVE	SWITCHES			PANEL
AUX. FW PUMP TURB. DRIVEN	C	1-HV-5113	1-HS-5113A	1-HS-5113B	1-HS-5113C	PAFP
AUX. FW PUMP MOTOR DRIVEN	B	5118	5118A	5118B	5118C	PSDB
AUX. FW PUMP MOTOR DRIVEN	A	5119	5119A	5119B	5119C	PSDA

△							
△							
△	INCORPORATED PER DCP 95-V1N0035		12-5-97	CD	GLB	WFP	✗
△	ISSUED FOR CONSTRUCTION		SEE MICROFILM FOR	SIGNATURES			
NO.	REVISIONS		DATE	DR	CHK	APPV	DTL

**NUCLEAR SAFETY RELATED  
PUMP SUCTION VALVE**

**SOUTHERN COMPANY SERVICES, INC.**  
BIRMINGHAM, ALABAMA

**GEORGIA POWER COMPANY**  
ALVIN W. VOGTLE NUCLEAR PLANT

**CONTROL LOGIC DIAGRAM  
AUXILIARY FEEDWATER SYSTEM**

SCALE: NONE	DRAWING NO.	REV
JOB NO. 10604	1X5DN120-1	6





**OPEN**  
 QMCB, 1-HS-5106A, OPEN (P)  
 PAFP, 1-HS-5106C, CNTRL RM (M)  
 PAFP, 1-HS-5106 B, OPEN (P)

**AUTO**  
 PAFP, 1-HS-5106 C, LOCAL (M)  
 QMCB, 1-HS-5106A, AUTO (M)  
 PAFP, 1-HS-5106C, CNTRL RM (M)  
 TURB. DRIVEN AUX. FEED WTR. PUMP START SIG. (THIS DWG)


**STOP**  
 TORQUE PROTECTION  
 ELECTRICAL OVERLOAD (DURING PERIODIC TEST ONLY) NOTE 2

**CLOSE**  
 QMCB, 1-HS-5106A, CLOSE (P)  
 PAFP, 1-HS-5106C, CNTRL RM (M)  
 PAFP, 1-HS-5106B, CLOSE (P)  
 PAFP, 1-HS-5106C, LOCAL (M)

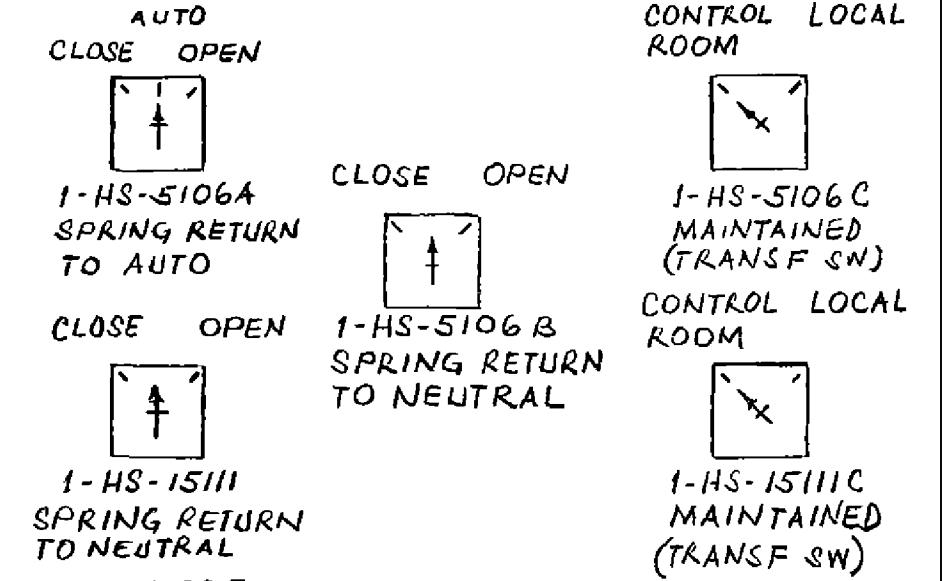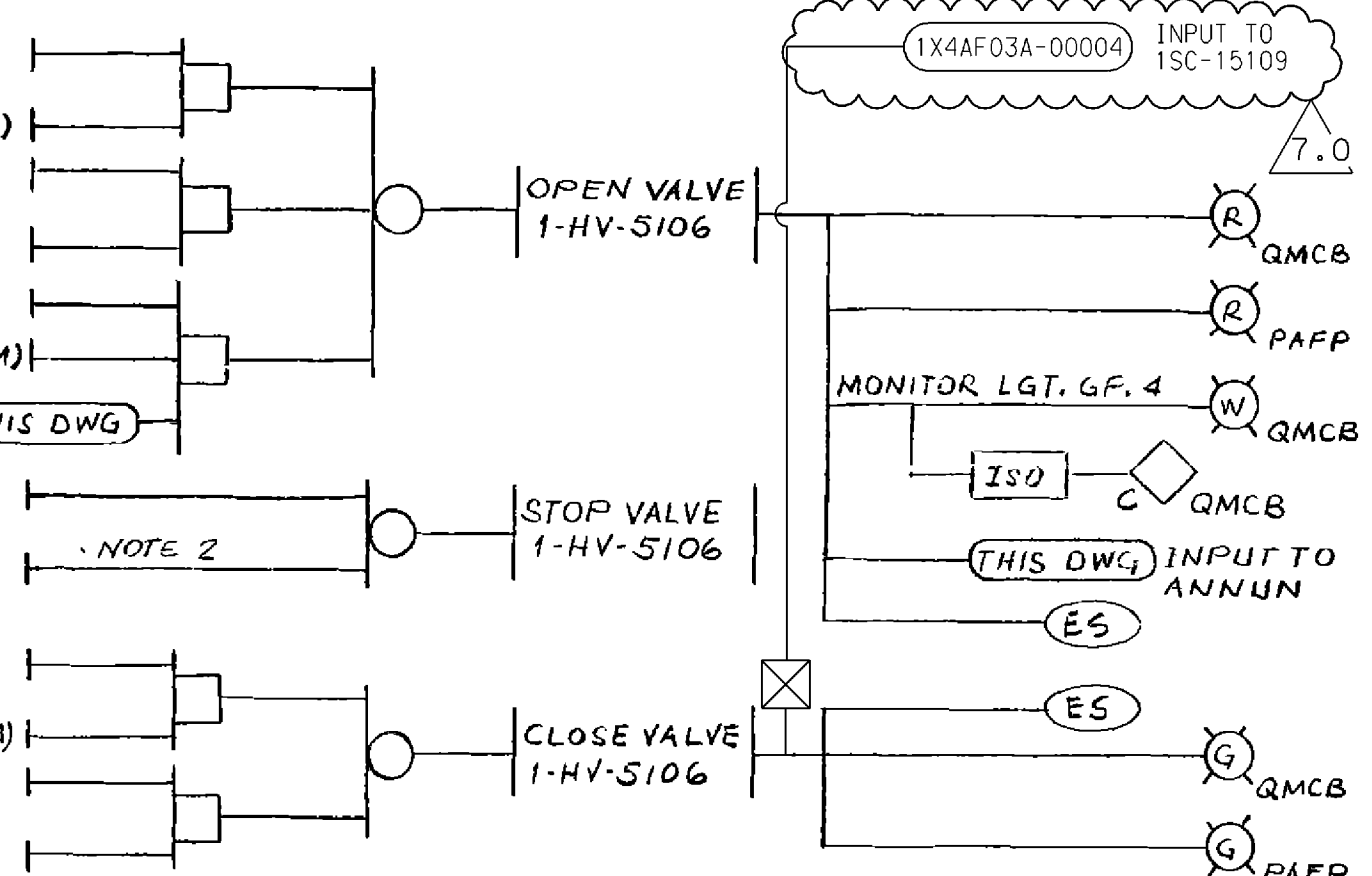


**NOTE:**  
 1. REFER TO SPECIAL NOTE 1 ON DWG 1XSDN002-2.  
 2. REFER TO SPECIAL NOTE 2 ON DWG 1XSDN002-2.  
 3. VALVE 1-HV-5106 IS A GATE VALVE  
 OPEN - LIMIT STOPPED  
 CLOSE - TORQUE STOPPED  
 4. VALVE MOTOR POWERED FROM D.C. TRAIN C.  
 5. SIGNAL INPUT FROM WESTINGHOUSE SOLID STATE PROTECTION SYSTEM V/P XGAA02-239  
 6. CIRCUIT INTERLOCK WITH TRANSFER SW. FOR CONTROL ROOM ONLY.


**TURB. DRIVEN AUX FEED WTR. PUMP START SIGNAL**

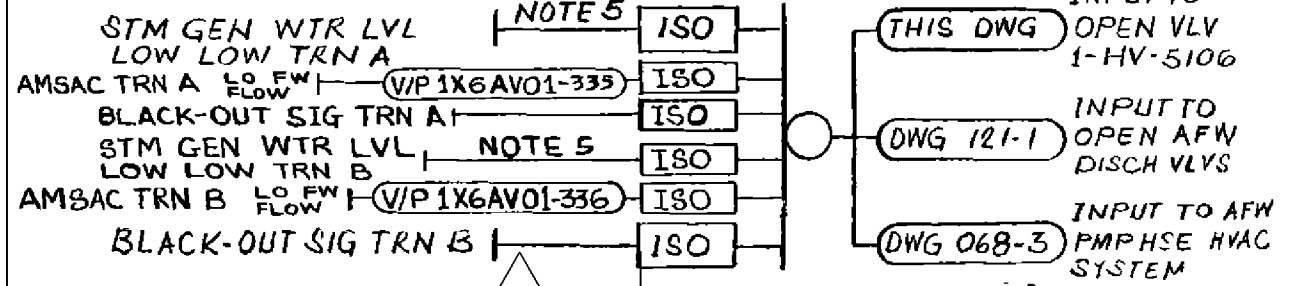

**ALARMS & MONITOR**

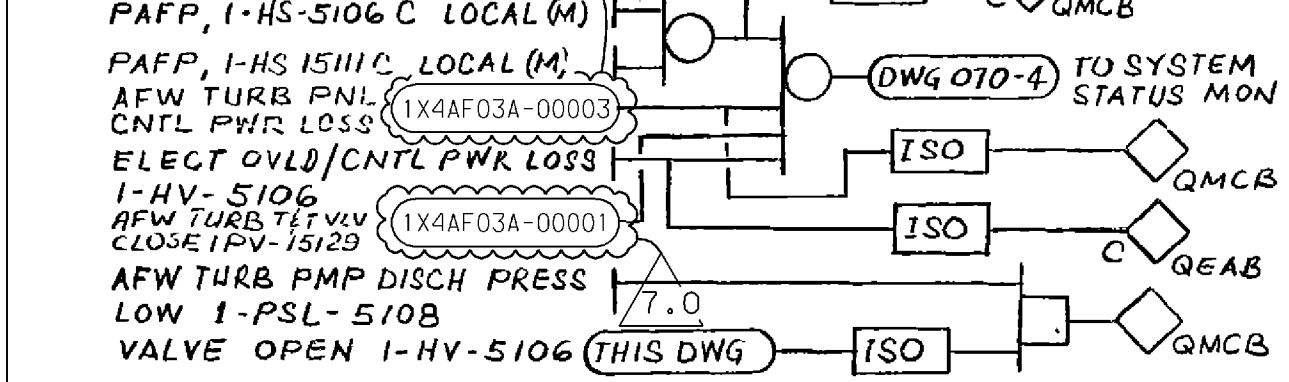

**AFW TURB TRIP/RESET & ALARM**

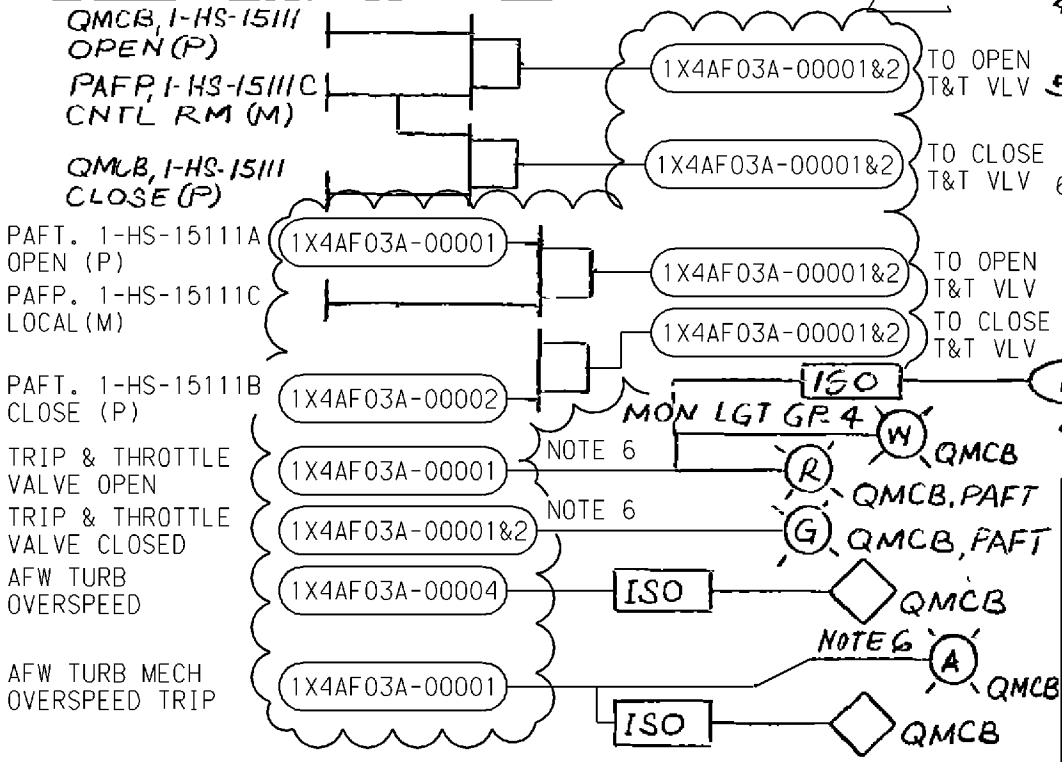

**NUCLEAR SAFETY RELATED "Q"**  
 AUX. FDWTR. TURB. STM. INLET VALVE TURB TRIP & RESET

**SOUTHERN COMPANY SERVICES, INC.**  
 BIRMINGHAM, ALABAMA  
**GEORGIA POWER COMPANY**  
 ALVIN W. VOGTLE NUCLEAR PLANT


**CONTROL LOGIC DIAGRAM**  
**AUXILIARY FEEDWATER SYSTEM**

7.0	REVISED PER ABN 1019003501J023, VER. 3.0	8-2-05	LPM	ELC	DEW	X
NO.	VERSION	DATE	DR	CHK	APPV	DTL

SCALE: NONE	DRAWING NO.	VER.
JOB NO. 10604	1X5DN120-2	7.0

14.5X

This drawing and all data thereon are the property of BECHTEL. They are loaned to you for your use only and are not to be reproduced, copied, loaned, exhibited, or used except in the limited way and extent permitted by my written consent given by the leader to the borrower.

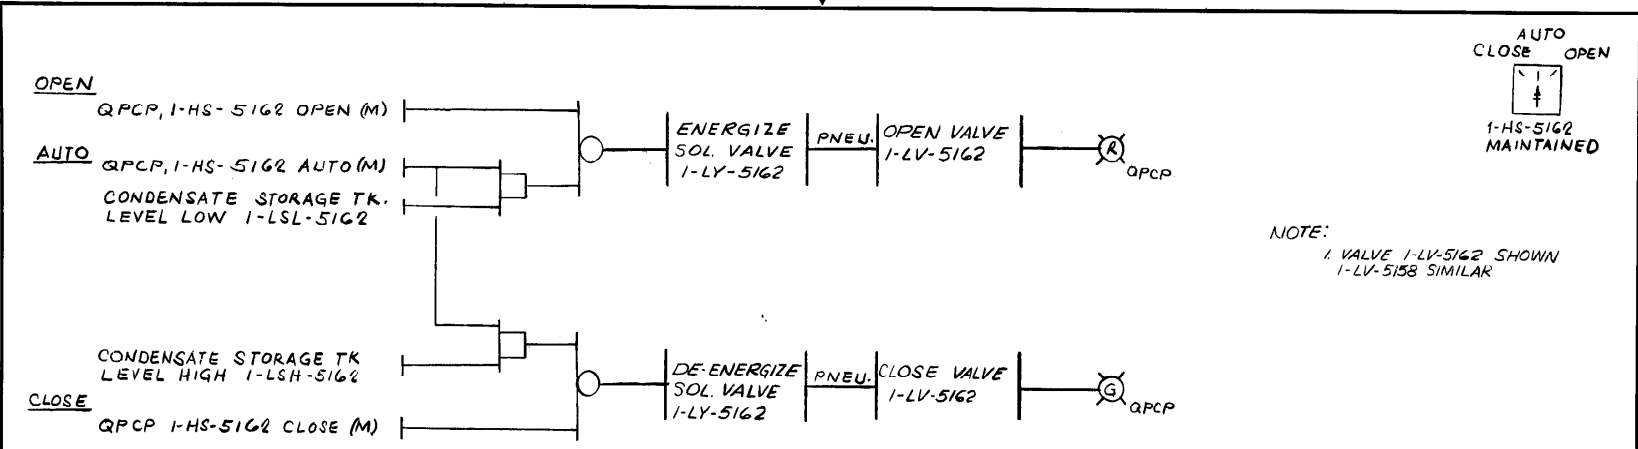

NOTE:  
1. VALVE 1-LV-5162 SHOWN  
1-LV-5158 SIMILAR

REF DWGS:  
PID 1X4DB1G1-1  
ED 1X3D-BC-F02E,F

COND. STOR. TANK	VALVE	SOL. VALVE	LEVEL SW.	LEVEL SW.	HAND SW.
1-1302-VA-002	1-LV-5162	1-LY-5162	1-LSH-5162	1-LSL-5162	1-HS-5164
↓ -001	↓ -5158	↓ -5158	↓ -5158	↓ -5158	↓ 5158


CONDENSATE TANK MAKE-UP VALVE

<b>BECHTEL</b> LOS ANGELES		
GEORGIA POWER COMPANY ALVIN W. VOGTLE NUCLEAR PLANT		
CONTROL LOGIC DIAGRAM AUXILIARY FEEDWATER SYSTEM		
SCALE:	DRAWING NO.	REV.
JOB NO. 9510	1X5DN120-3	1

NO.	REVISIONS	DATE	DR	CHK.	SUPV.	EGL	EGS	CHF. E.	P. E.	Q. A. E.	ENG. MGR.
△	ADDED REF DWGS.	1-10-80	HL	FAL							
△	ISSUED FOR CONSTRUCTION	3-15-79	NBD	FAL	MKK.						

BM 9510


SIZE B 11x17

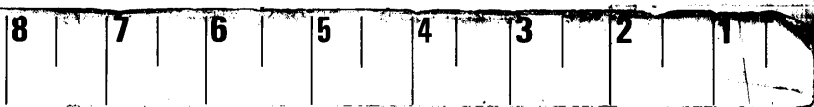

I CERTIFY THAT THE IMAGE CONTAINED ON THIS FRAME WAS MADE IN THE NORMAL AND REGULAR COURSE OF BUSINESS, ON THE DATE STATED BELOW AND THAT IT IS AN ACCURATE REPRODUCTION OF THE DOCUMENT SUBMITTED TO MICROGRAPHICS.  
 1-10-80 Denise Turner Section Supervisor  
 DATE: CAMERA OPERATOR SECTION SUPERVISOR

14.5X

This drawing and the design it covers are the property of BECHTEL. They are loaned to the borrower's express agreement that they will not be re-produced, copied, loaned, exhibited, or used except in the limited way and for the purpose permitted by the lender to the borrower.

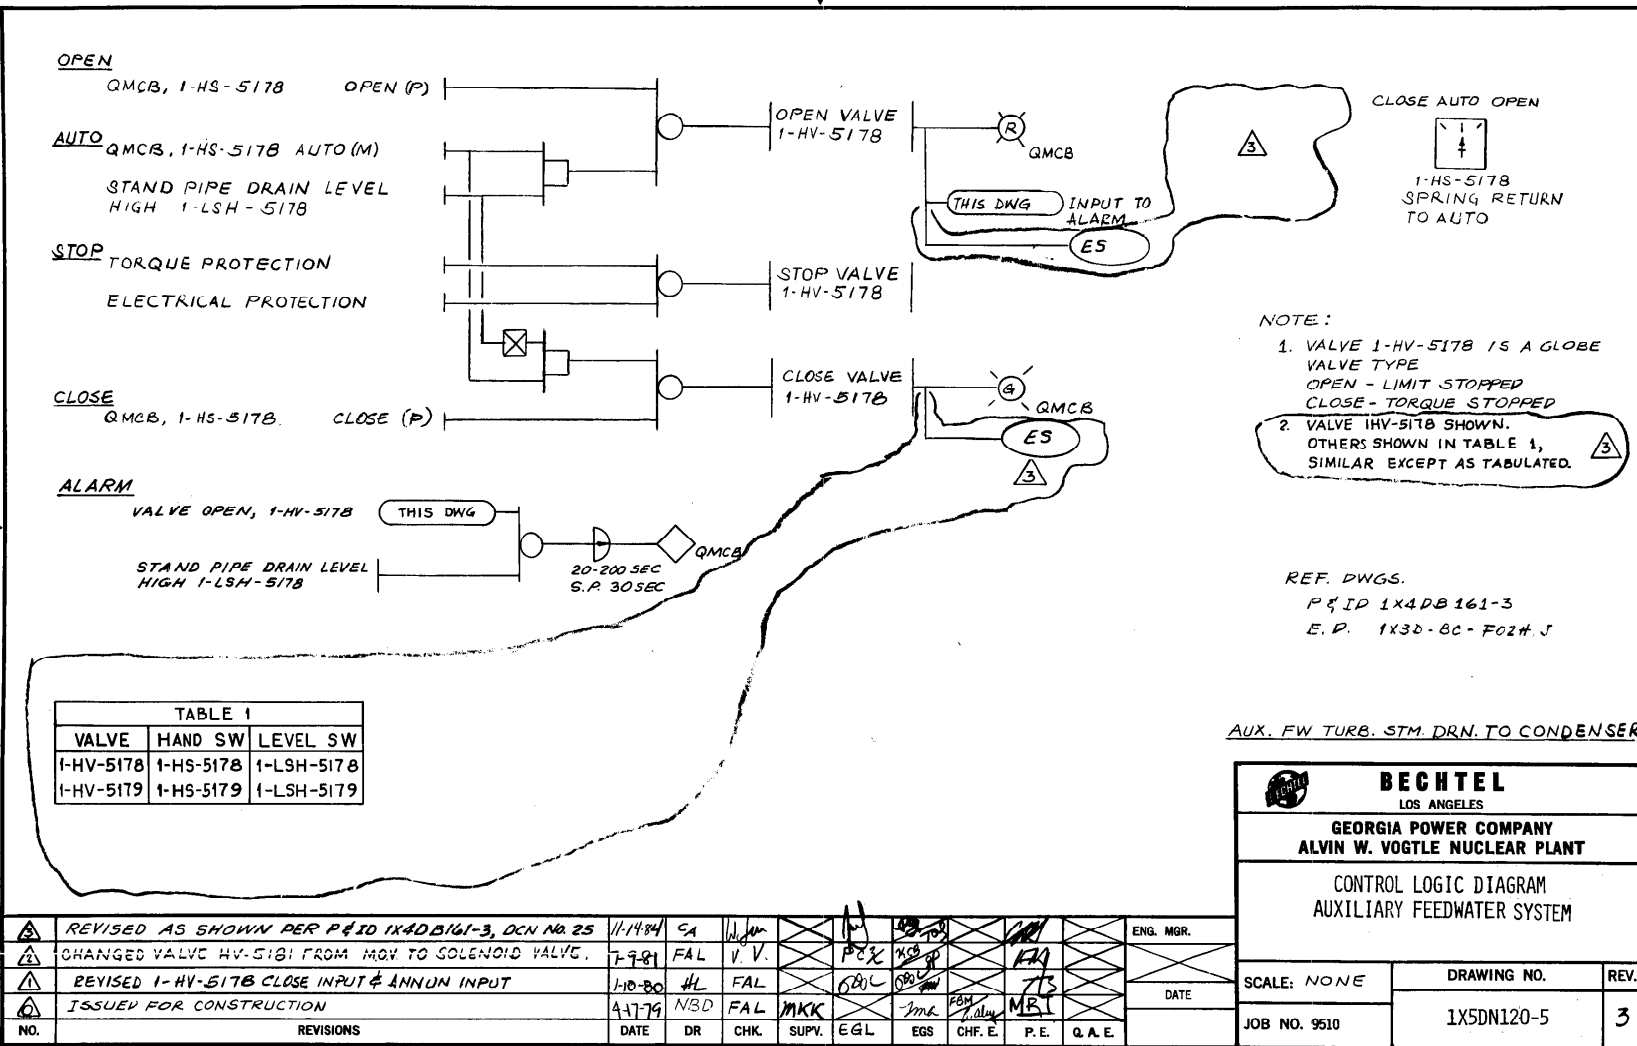

VALVE	HAND SW	LEVEL SW
1-HV-5178	1-HS-5178	1-LSH-5178
1-HV-5179	1-HS-5179	1-LSH-5179

NO.	REVISIONS	DATE	DR	CHK.	SUPV.	EGL	EGS	CHF. E.	P. E.	Q. A. E.	ENG. MGR.	DATE
1	REVISED AS SHOWN PER P&ID 1X4DB161-3, DCN No 25	11-17-84	SA	W. J.								
2	CHANGED VALVE HV-5181 FROM MQV TO SOLENOID VALVE.	7-9-81	FAL	V. V.								
3	REVISED 1-HV-5178 CLOSE INPUT & ANNUN INPUT	1-10-80	HL	FAL								
4	ISSUED FOR CONSTRUCTION	4-17-79	NBD	FAL	MKK							

**BECHTEL**  
LOS ANGELES

**GEORGIA POWER COMPANY**  
**ALVIN W. VOGTLE NUCLEAR PLANT**

**CONTROL LOGIC DIAGRAM**  
**AUXILIARY FEEDWATER SYSTEM**

SCALE: NONE      DRAWING NO. 1X5DN120-5      REV. 3

JOB NO. 9510

SIZE B 11x17

I CERTIFY THAT THE IMAGE CONTAINED ON THIS FRAME WAS MADE IN THE NORMAL AND REGULAR COURSE OF BUSINESS, ON THE DATE STATED BELOW AND THAT IT IS AN ACCURATE REPRODUCTION OF THE DOCUMENT SUBMITTED TO MICROGRAPHICS.


DATE: 11-14-84      CAMERA OPERATOR      SECTION SUPERVISOR

9    8    7    6    5    4    3    2    1



OPEN

QPCP, 1-HS-50B7, OPEN (P)

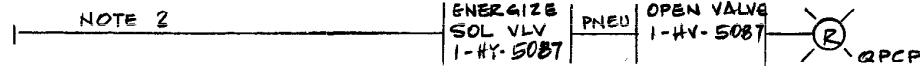


AUTO

PUMP SUCTION PRESS. LOW  
1-PSL-50B7


CLOSE

QPCP, 1-HS-50B7 CLOSE (P)

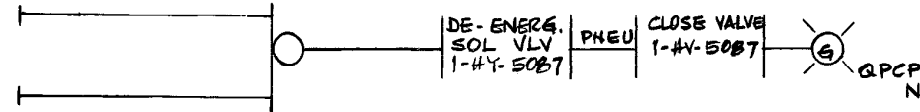

ALARM

PUMP SUCTION PRESS. LOW  
1-PSL-50B7

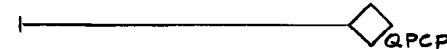

AUTO  
CLOSE OPEN



1-HS-50B7

SPRING RETURN  
TO AUTO

NOTE:

1. VALVE 1-HY-50B7 SHOWN, 1-HY-50B8 IS SIMILAR.
2. TO OPEN VALVE, CONTROL SWITCH SHALL BE HELD ON OPEN POSITION UNTIL VALVE IS FULLY OPEN TO ALLOW THE CIRCUIT TO SEAL-IN THROUGH VALVE POSITION SWITCH. AND TO RESET PRESSURE SWITCH AFTER LINE IS DEPRESSURIZED.

REF DWG

P&ID 1X4DB161-1  
E.D. 1X3D-BC-F02M



TABLE 1

VALVE	SWITCH	SOL VLV	PRESS SW
1-HY-50B7	1-HS-50B7	1-HY-50B7	1-PSL-50B7
B	B	B	B

VACUUM DEGASIFIER ISOL. VALVE



**BECHTEL**

LOS ANGELES



GEORGIA POWER COMPANY  
ALVIN W. VOGTLE NUCLEAR PLANT

CONTROL LOGIC DIAGRAM  
AUXILIARY FEEDWATER SYSTEM

NO.	REVISIONS	DATE	DR	CHK	SUPV.	EGL	EGS	CHF. E.	P. E.	Q. A. E.	ENG. MGR.
△	CORRECTED REF. DWG.	2-15-83	ZEP	ALV							
△	REVISED OPEN INPUT, NOTE 2 AND ADDED REF DWGS	1-10-80	HL	FAL							
△	ISSUED FOR CONSTRUCTION	4-6-79	HL	FAL	MKK						

SCALE: NONE	DRAWING NO.	REV.
JOB NO. 9510	1X5DN120-6	2



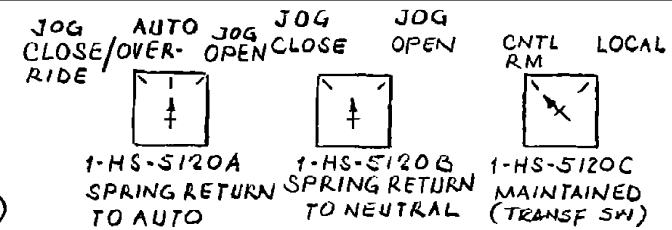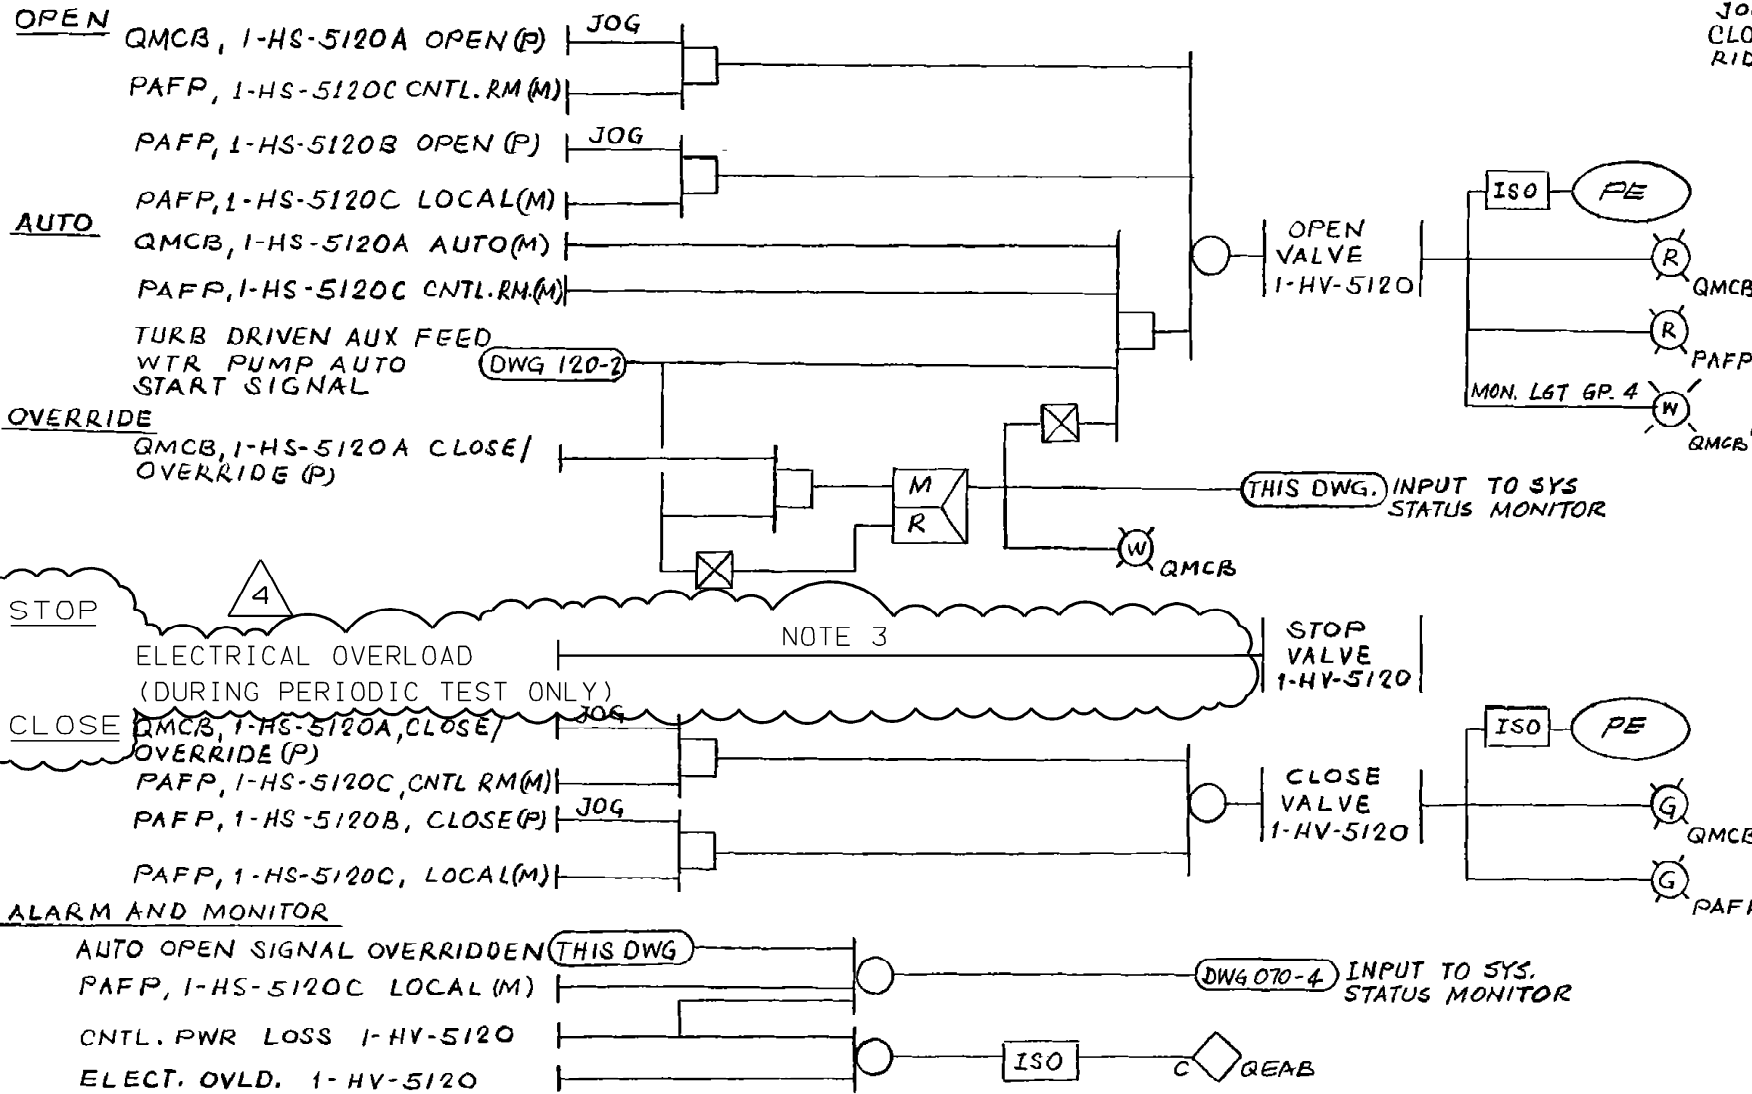

- NOTE:
1. VALVE 1-HV-5120 SHOWN OTHER VALVES LISTED IN TABLE 1 ARE SIMILAR.
  2. REFER TO SPECIAL NOTE 1 ON DWG. 1X5DN002-2
  3. REFER TO SPECIAL NOTE 2 ON DWG. 1X5DN002-2
  4. VALVES LISTED IN TABLE 1 ARE GLOBE VALVES  
OPEN - LIMIT STOPPED  
CLOSE - LIMIT STOPPED
  5. VALVE MOTORS LISTED IN TABLE 1 ARE D.C.

REF. DWGS.  
PEID 1X4DB161-2  
E.D. 1X3D-BC-F09A,B,C,D

NUCLEAR SAFETY RELATED "Q"  
TURB. DRIVEN AUX. FEEDWATER PUMP DISCHARGE VALVE

TABLE 1

TRAIN	PUMP NO	VALVE	SWITCHES		
			1-HS-5120A	1-HS-5120B	1-HS-5120C
C	1-1302-P4-001-000	1-HV-5120	5122A	5122B	5122C
			5125A	5125B	5125C
			5127A	5127B	5127C

PAFP, 1-HS-5120C LOCAL (M) — ISO — C — QMCB

NO.	REVISIONS	DATE	DR	CHK	APPV	DTL
△						
△						
△						
△	INCORP. PER DCP 98-V1N0025	04/16/02	PM	TSL	RBH	

SOUTHERN COMPANY SERVICES, INC.  
BIRMINGHAM, ALABAMA

GEORGIA POWER COMPANY  
ALVIN W. VOGTLE NUCLEAR PLANT

CONTROL LOGIC DIAGRAM

AUXILIARY FEEDWATER VALVES  
TO STEAM GENERATOR

SCALE: NONE	DRAWING NO.	REV
JOB NO. 10604	1X5DN121-1	4

**OPEN**  
 QMCB, 1-HS-5132A OPEN (P)  
 PSDB, 1-HS-5132C CNTL. RM. (M)  
 PSDB, 1-HS-5132B OPEN (P)  
 PSDB, 1-HS-5132C LOCAL (M)



**AUTO**  
 QMCB, 1-HS-5132A, AUTO (M)  
 PSDB, 1-HS-5132C, CNTL. RM. (M)  
 MOTOK DRIVEN AUX. FEED  
 WTR. PUMP AUTO START  
 SIG. (DWG. I17-1)

**OVERRIDE**  
 QMCB, 1-HS-5132A CLOSE/  
 OVERRIDE (P)

**STOP**  
 ELECTRICAL OVERLOAD  
 (DURING PERIODIC TEST ONLY)

**CLOSE**  
 QMCB, 1-HS-5132A CLOSE/  
 OVERRIDE (P)  
 PSDB, 1-HS-5132C, CNTL. RM. (M)  
 PSDB, 1-HS-5132B, CLOSE (P)  
 PSDB, 1-HS-5132C, LOCAL (M)


**ALARM**  
 PSDB, 1-HS-5132C, LOCAL (M)

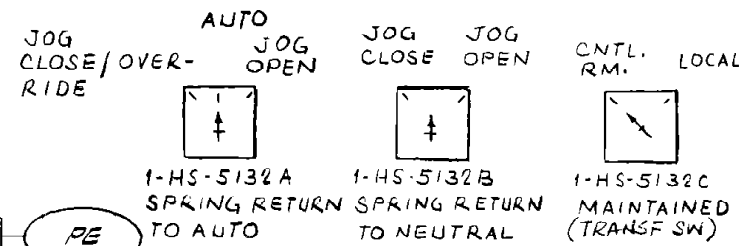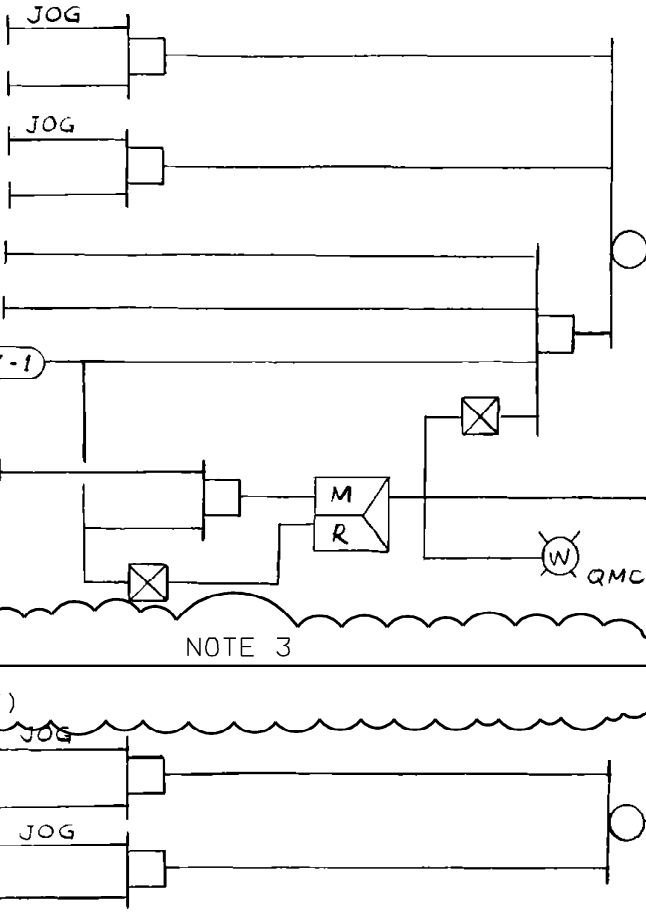

**NOTE:**  
 1. VALVE 1-HV-5132 SHOWN, VALVES LISTED IN TABLE 1 SIMILAR.  
 2. REFER TO SPECIAL NOTE 1 ON DWG. 1X5DN002-2.  
 3. REFER TO SPECIAL NOTE 2 ON DWG. 1X5DN002-2  
 4. VALVES LISTED IN TABLE 1 ARE GLOBE VALVES  
 OPEN - LIMIT STOPPED  
 CLOSE - LIMIT STOPPED

REF. DWGS.  
 P&ID 1X4DB161-2  
 E.D. 1X3D-BC-FO8A,B,C,D

**ALARM AND MONITOR**

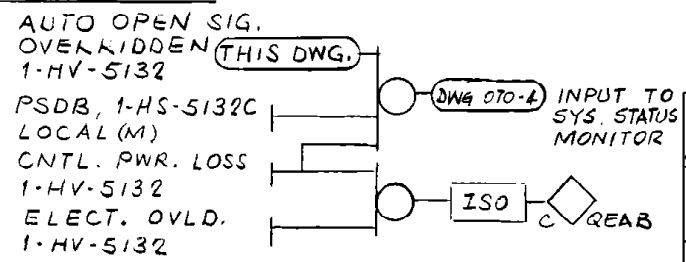

NUCLEAR SAFETY RELATED "Q"  
 MOTOR DRIVEN AUX. FDWTR. PUMPS  
 DISCHARGE VALVE

TABLE 1



TRAIN	PUMP NO.	VALVE	SWITCHES			
B	1-1302-P4-002-M01	1-HV-5132	1-HS-5132A	1-HS-5132B	1-HS-5132C	
			5134	5134A	5134B	5134C
A	1-1302-P4-003-M01		5137	5137A	5137B	5137C
			5139	5139A	5139B	5139C

NO.	REVISIONS	DATE	DR	CHK	APPV	DTL
△						
△						
△						
△	INCORP. PER DCP 98-V1N0025	04/16/02	PM	TSL	RBH	

SOUTHERN COMPANY SERVICES, INC.  
 BIRMINGHAM, ALABAMA  
 GEORGIA POWER COMPANY  
 ALVIN W. VOGTLE NUCLEAR PLANT  
 CONTROL LOGIC DIAGRAM  
 AUXILIARY FEEDWATER VALVES  
 TO STEAM GENERATOR

SCALE: NONE	DRAWING NO.	REV
JOB NO. 10604	1X5DN121-2	4

THIS DRAWING AND THE DESIGN IT COVERS ARE THE PROPERTY OF SCS. THEY ARE MERELY LOANED AND ON THE BORROWER'S EXCLUSIVE USE. NO REPRODUCTION, COPIED, LOANED, EXHIBITED, OR USED EXCEPT IN THE LIMITED WAY AND UNDER THE SUPERVISION OF THE LENDER TO THE BORROWER.

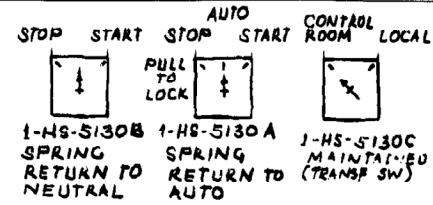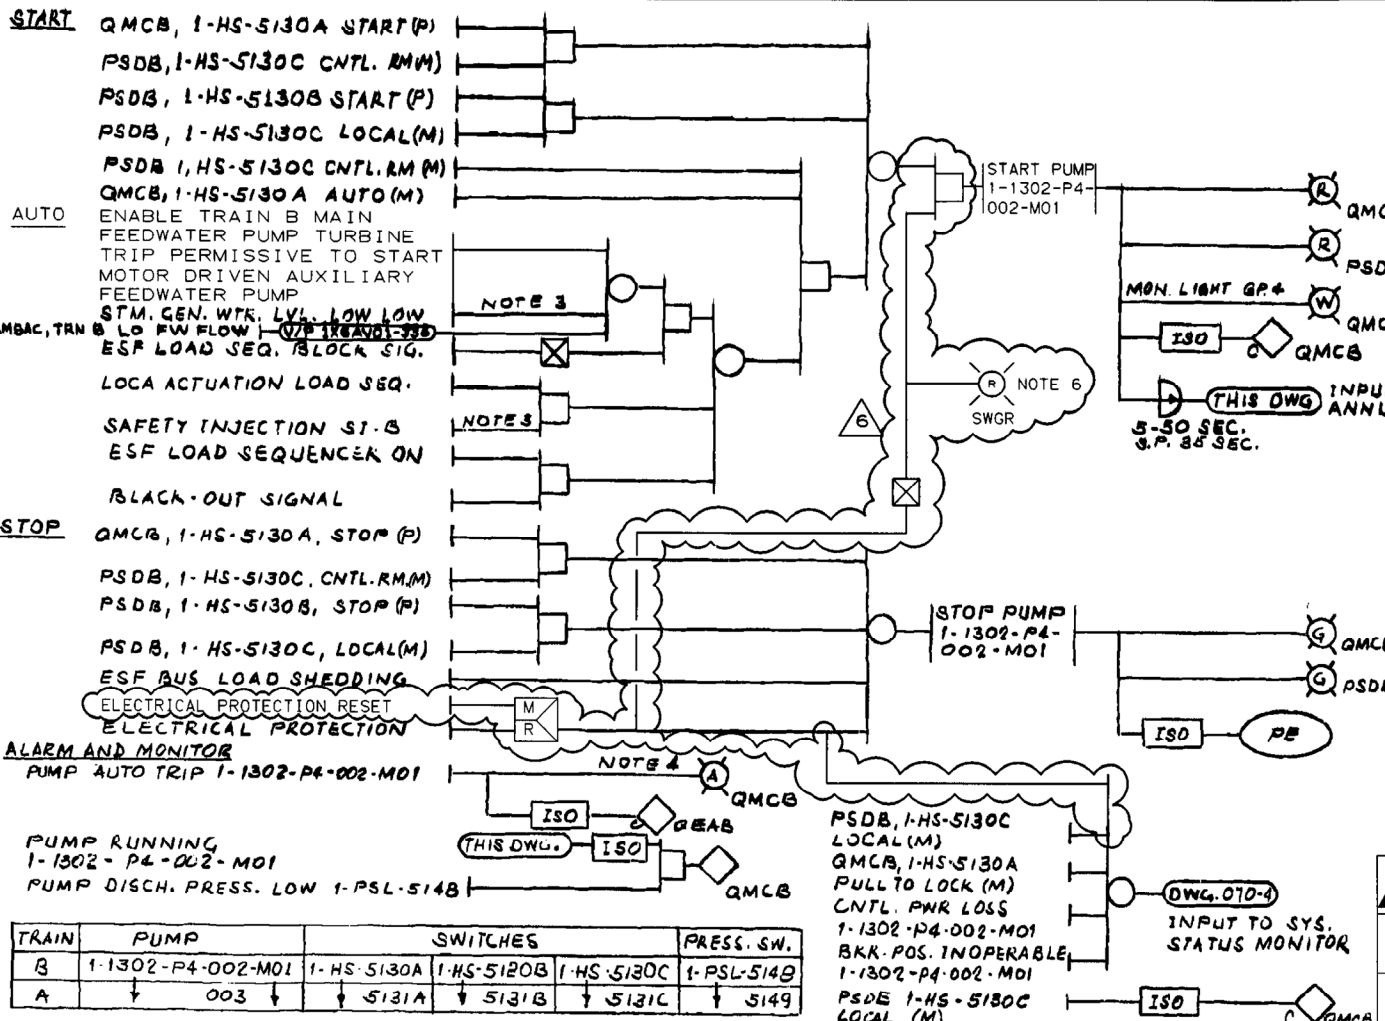

- NOTE:**
1. PUMP 1-1302-P4-002-MOI SHOWN PUMP 1-1302-P4-003-MOI SIMILAR
  2. REFER TO SPECIAL NOTE 1 ON DWG. 1X5DN002-2
  3. SIGNAL INPUT FROM WESTINGHOUSE SOLID STATE PROTECTION SYSTEM V/P X6AA02-239
  4. TYPICAL AUTO TRIP FUNCTION SHOWN ON DWG. 1X5DN002-3
  5. 4160V SWGR. CIRCUIT BRK.
  6. RED LIGHT INDICATES CONTINUITY OF LOCKOUT RELAY COIL. IT WILL CONTINUE TO GLOW DIMLY AFTER OPERATION OF THE LOCKOUT RELAY DUE TO THE PRESENCE OF A THERMISTOR IN THE LOCKOUT RELAY CIRCUIT.

REF. DWGS.  
P&ID 1X4DB161-2  
E.D. 1X3D-BC-F04A-F05A

**NUCLEAR SAFETY RELATED** [Q]  
MOTOR DRIVEN FEEDPUMP

**SOUTHERN COMPANY SERVICES, INC.**  
BIRMINGHAM, ALABAMA  
GEORGIA POWER COMPANY  
ALVIN W. VOGTLE NUCLEAR PLANT

**CONTROL LOGIC DIAGRAM  
MOTOR-DRIVEN  
AUXILIARY FEEDWATER PUMPS**

TRAIN	PUMP	SWITCHES			PRESS. SW.
B	1-1302-P4-002-MOI	1-HS-5130A	1-HS-5120B	1-HS-5130C	1-PSL-514B
A	↓ 003 ↓	↓ 5131A ↓	↓ 5131B ↓	↓ 5131C ↓	↓ 5149 ↓

PSDB, 1-HS-5130C LOCAL (M)  
QMCB, 1-HS-5130A PULL TO LOCK (M)  
CNTL. PWR LOSS 1-1302-P4-002-MOI  
BKK. POS. INOPERABLE 1-1302-P4-002-MOI  
PSDB 1-HS-5130C LOCAL (M)

NOTE 4: ISO, GEAB, QMCB  
NOTE 6: SWGR

DWG. 070-4 INPUT TO SYS. STATUS MONITOR

NO.	REVISIONS	DATE	DR	CHK	SUPV	EGL	EGS	CHF	E	PE	QAE	ENG MGR
1	INCORP. ABN-20848	5/1/95		LVL	DMH	LJL						
2	ISSUED FOR CONSTRUCTION	2/28/79										

SCALE: NONE	DRAWING NO.	REV
JOB NO. 10604	1X5DN122-1	6

This drawing and the design it covers are the property of BECHTEL. They are loaned and on the borrower's express agreement that they will not be re-produced, copied, loaned, exhibited, or used except in the limited way and private use permitted by any written consent given by the lender to the borrower.

**OPEN**

PSDA, 1-HS-5155B, OPEN (P)  
 PSDA, 1-HS-5155C, LOCAL (M)

PUMP DISCHARGE FLOW (DWG 1X5DV080)  
 LOW 1-FY-5155A (LOOP DIAG)  
 PSDA, 1-HS-5155C, CNTL RM (M)

**STOP**

TORQUE PROTECTION

ELECTRICAL OVERLOAD  
 (DURING PERIODIC TEST ONLY)

**CLOSE**

PSDA, 1-HS-5155C, CNTL RM (M)

PUMP DISCHARGE FLOW (DWG 1X5DV080)  
 HIGH 1-FY-5155B (LOOP DIAG)

PSDA, 1-HS-5155C, LOCAL (M)

PSDA, 1-HS-5155B CLOSE (P)


NOTE 2

1.5-15 SEC.  
 S.P. 2.0 SEC.

OPEN VALVE  
 1-FV-5155

STOP VALVE  
 1-FV-5155

CLOSE VALVE  
 1-FV-5155

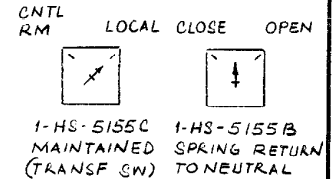


**NOTE:**


1. VALVE 1-FV-5155 SHOWN 1-FV-5154 SIMILAR.
2. REFER TO SPECIAL NOTE 2 ON DWG 1X5DN002-2.
3. VALVES LISTED IN TABLE 1 ARE GLOBE VALVES.  
 OPEN - LIMIT STOPPED  
 CLOSE - TORQUE STOPPED

**ALARM AND MONITOR**

CNTL. POWER LOSS  
 1-FV-5155  
 ELECT. OVERLOAD  
 1-FV-5155

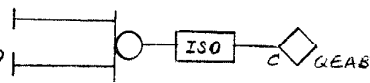

PSDA, 1-HS-5155C,  
 LOCAL (M)  
 CNTL PWR LOSS  
 1-FV-5155

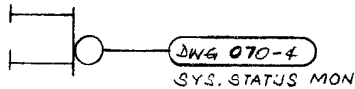

PSDA, 1-HS-5155C,  
 LOCAL (M)

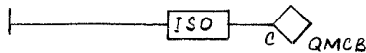


TABLE 1

TRAIN	HAND SWITCH	VALVE	FLOW SW (LOOP DIAG)	
A	1-HS-5155 B & C	1-FV-5155	1-FY-5155A	1-FY-5155B
B	5154 B & C	5154	5154A	5154B

REF. DWGS.  
 PEID 1X4DB161-2  
 E.D. 1X3D-BC-FO4B, FO5B  
 LOOP DIAG 1X3DV073 & 080

NUCLEAR SAFETY RELATED "Q"  
 PUMP MINI FLOW VALVE

 <b>BECHTEL</b> LOS ANGELES		
<b>GEORGIA POWER COMPANY</b> <b>ALVIN W. VOGTLE NUCLEAR PLANT</b>		
CONTROL LOGIC DIAGRAM MOTOR-DRIVEN AUXILIARY FEED-WATER PUMPS		
SCALE: NONE	DRAWING NO.	REV.
JOB NO. 9510	1X5DN122-2	4


NO.	REVISIONS	DATE	DR.	CHK.	RPE	DM	ODPM	DPM	DPM	ENG. MGR.
1	ADDED COMPUTER INPUT PER I/O LIST REV. 5	2-15-85	ZEP	ALV						
2	IN CORR. ABN 86-VIE007A001	10/22/87	TJS	SP	JBP					
3	ISSUED FOR CONSTRUCTION	2-28-79	NRD	FAL	MKK					



# 14.5X

CERTIFY THAT THE IMAGE CONTAINED ON THIS FRAME WAS MADE IN THE NORMAL AND REGULAR COURSE OF BUSINESS, ON THE DATE STATED BELOW AND THAT IT IS AN ACCURATE REPRODUCTION OF THE DOCUMENT SUBMITTED TO MICROGRAPHICS.  
 DATE: 10-21-86  
 CAMERA OPERATOR: [Signature]  
 SECTION SUPERVISOR: [Signature]


This drawing and the design it covers are the property of BECHTEL. They are to be used only for the purposes stated on the drawing's original approval sheet. They may not be reproduced, copied, loaned, leased, exhibited, or used except in the limited way and for the limited purpose stated on the drawing's original approval sheet.

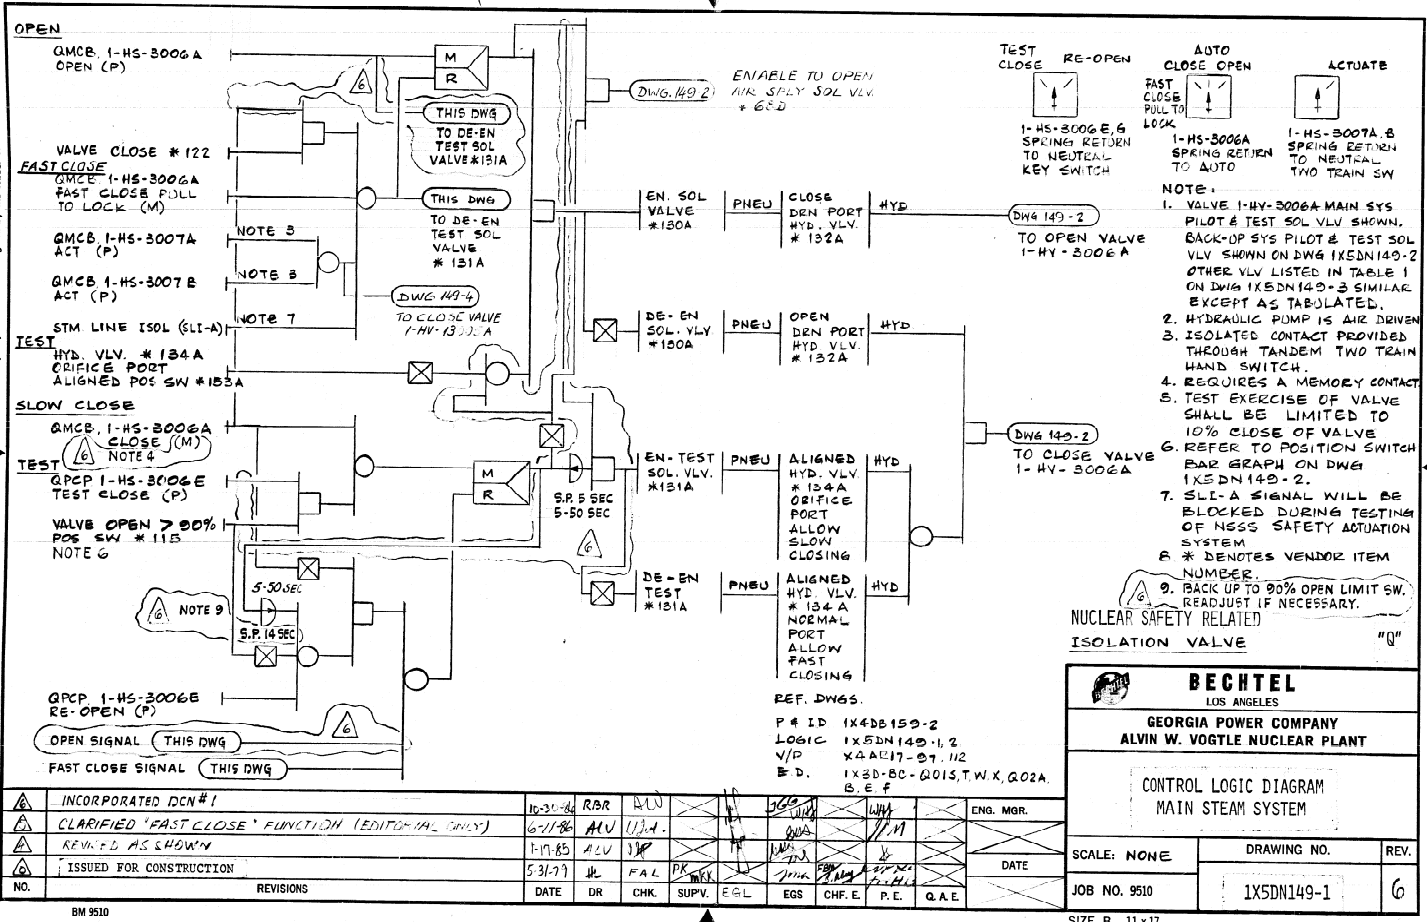

NO.	REVISIONS	DATE	DR	CHK	SUPV.	EGL	EGS	CHF. E.	P. E.	Q. A. E.	ENG. MGR.	DATE
1	INCORPORATED DCN #1	10-20-86	RBR	BLU								
2	CLARIFIED 'FAST CLOSE' FUNCTION (EDITORIAL ONLY)	6-21-86	AVU	112-1								
3	REVISED AS SHOWN	1-17-85	ALU	38								
4	ISSUED FOR CONSTRUCTION	5-31-79	HL	FAL	PK	MX						

I CERTIFY THAT THE IMAGE CONTAINED ON THIS FRAME WAS MADE IN THE NORMAL AND REGULAR COURSE OF BUSINESS, ON THE DATE STATED BELOW AND THAT IT IS AN ACCURATE REPRODUCTION OF THE DOCUMENT SUBMITTED TO MICROGRAPHICS.  
 DATE: 10-21-86  
 CAMERA OPERATOR: [Signature]  
 SECTION SUPERVISOR: [Signature]

This drawing and the design it covers are the property of BECHTEL. They are loaned to the borrower's express agreement that they will not be re-  
 produced, copied, loaned, exhibited, or used except in the limited way and private use permitted by any written consent given by the lender to the borrower.

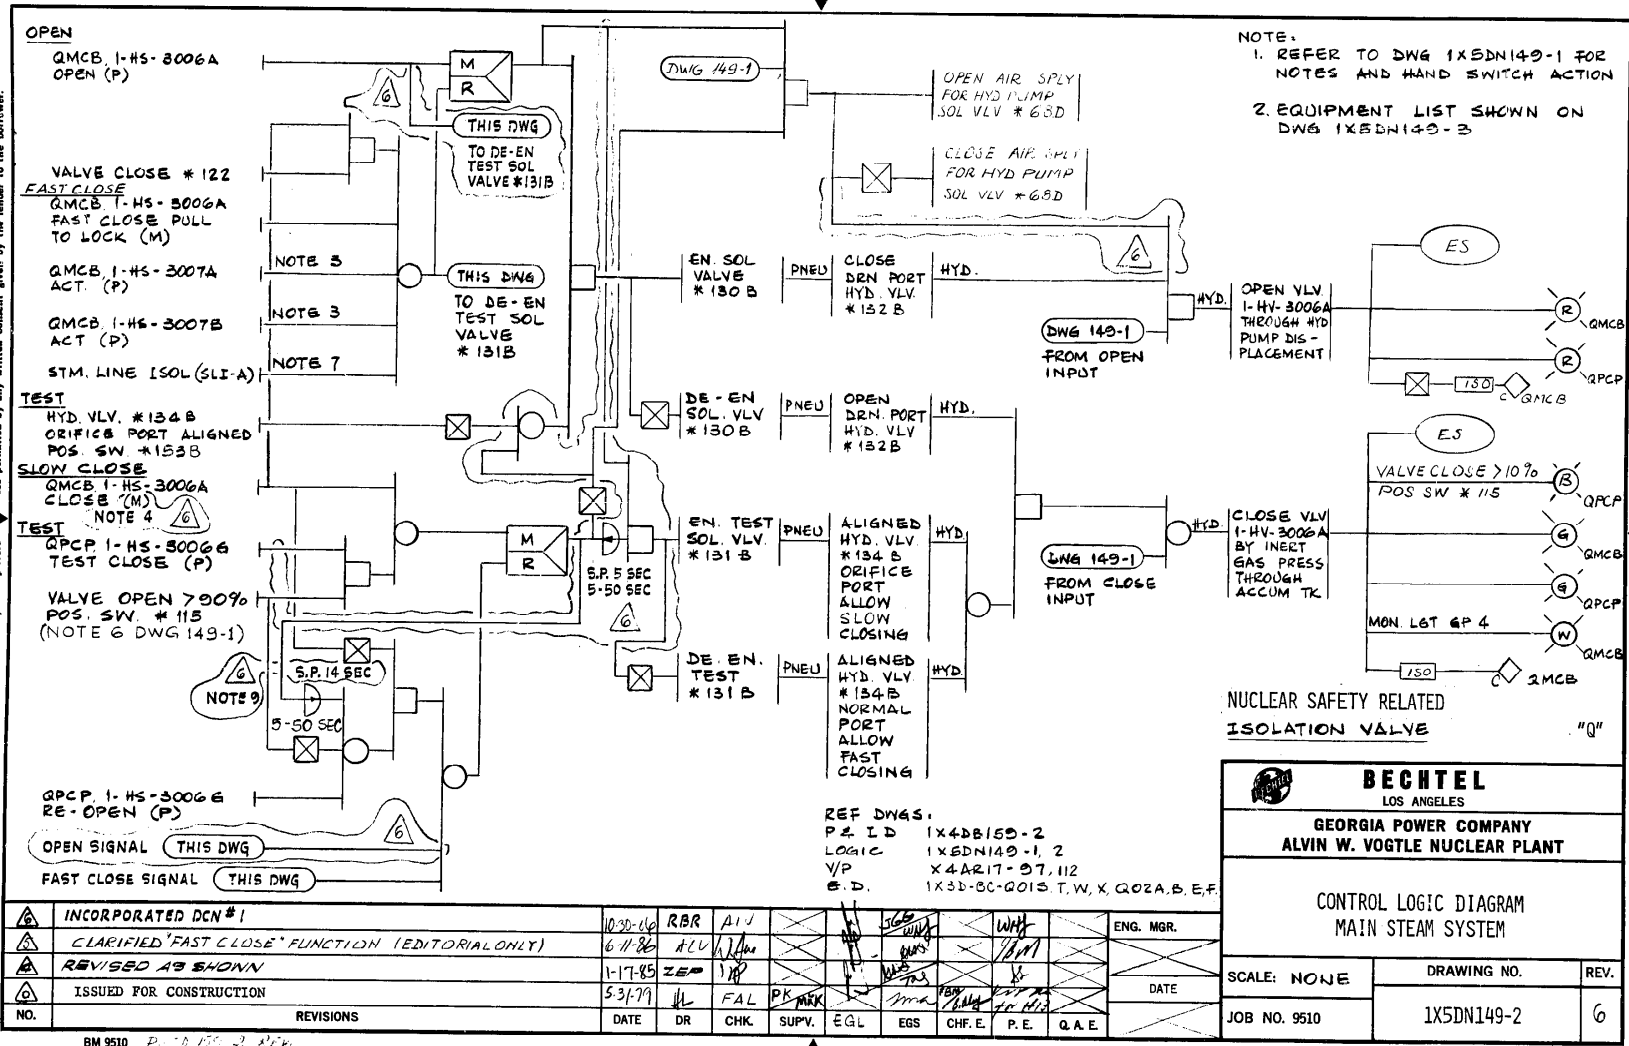

REF DWGS:  
 P.E. ID 1X4DB165-2  
 LOGIC 1X5DN149-1, 2  
 V/P X4AR17-97, 112  
 E.D. 1X3D-0C-0015 T, W, X, QOZA, B, E, F

NUCLEAR SAFETY RELATED  
 ISOLATION VALVE "Q"

<b>BECHTEL</b> LOS ANGELES		
GEORGIA POWER COMPANY ALVIN W. VOGTLE NUCLEAR PLANT		
CONTROL LOGIC DIAGRAM MAIN STEAM SYSTEM		
SCALE: NONE	DRAWING NO.	REV.
JOB NO. 9510	1X5DN149-2	6



NO.	REVISIONS	DATE	DR	CHK.	SUPV.	EGL	EGS	CH.F.E.	P.E.	Q.A.E.	ENG. MGR.	DATE
1	INCORPORATED DCN #1	10-30-86	RBR	ALV								
2	CLARIFIED 'FAST CLOSE' FUNCTION (EDITORIAL ONLY)	6-11-86	ALV									
3	REVISED AS SHOWN	1-17-85	ZEP									
4	ISSUED FOR CONSTRUCTION	5-31-79	HL	FAL	PK							

BM 9510 P. 10 OF 2 R/F

SIZE B 11x17

I CERTIFY THAT THE IMAGE CONTAINED ON THIS FRAME WAS MADE IN THE NORMAL AND REGULAR COURSE OF BUSINESS, ON THE DATE STATED BELOW AND THAT IT IS AN ACCURATE REPRODUCTION OF THE DOCUMENT SUBMITTED TO MICROGRAPHICS.  
 DATE: 10-31-86  
 CAMERA OPERATOR: [Signature]  
 SECTION SUPERVISOR: [Signature]

**ALARMS AND MONITORS**

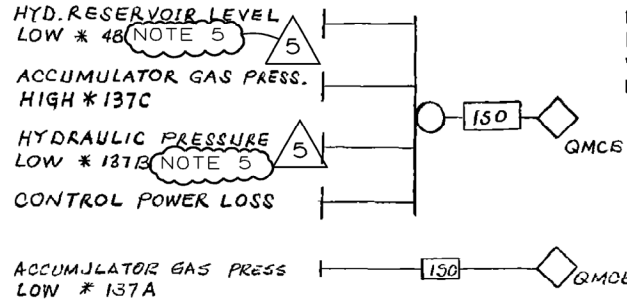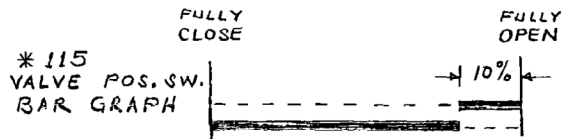

**REF DWGS**

P & ID 1X4DB159-2  
 LOGIC 1X5DN149-1,2  
 V/P X4AR17-97,101  
 E.D. 1X3D-BC-Q01S,T,W,X Q02A,B,E,F

**TABLE 1**

TRAIN	SFTY STG.	VALVE	HAND SW MAIN AND BACK-UP SYSTEM	HAND SW. MANUAL ISOL. ACTUATION	TEST SW MAIN SYS.	TEST SW. BACK-UP	SOL VALVE MAIN SYS.	SOL. VALVE BACK-UP SYS.	HYD. VALVE MAIN SYS.	HYD VALVE BACK-UP SYS	SOL.VLV TEST EXERC. MAIN SYS.	SOL.VLV. TEST EXERC. BACK UP SYS.	HYD ORIFICE VALVE MAIN SYS.	HYD. ORIFICE VALVE BACK-UP SYS	HYD. ORIFICE VLV POS. SW MAIN SYS.	HYD ORIFICE VLV. POS. SW BACK UP SYS.	TEST EXERC POS SW.	VALVE POS SW	HYD RSYR LEVEL SWITCH	HYD PRESS SWITCH	ACCUM GAS PRESS SWITCH	AIR SUPPLY SHUT OFF SOL VLV	
A	SLI-A	1-HV-3006A	1-HS-3006A	1-HS 3007A 1-HS-3007B	1-HS-3006E	1-HS-3006G	*130A	*130B	*132A	*132B	*131A	*131B	*134A	*134B	*153A	*153B	*115	*122	*48	*137B	*137AC	*68D	
B	-B	-3006B	-3006B		-3006F	-3006H																	
A	-A	-3016A	-3016A		-3016E	-3016G																	
B	-B	-3016B	-3016B		-3016F	-3016H																	
A	-A	-3026A	-3026A		-3026E	-3026G																	
B	-B	-3026B	-3026B		-3026F	-3026H																	
A	-A	-3036A	-3036A		-3036E	-3036G																	
B	-B	-3036B	-3036B		-3036F	-3036H																	

**NOTE.**

- LOGIC SHOWN ON DWG. 1X5DN149-1 & 2
- \* DENOTES VENDOR ITEM NUMBER.
- VALVE BAR GRAPH POSITION SWITCH SOLID LINE DENOTES CONTACT CLOSED.
- REFER TO DWG 1X5DN149-1 FOR OTHER NOTES

5. THE HYD RESV LEVEL LOW SWITCH AND HYD PRESSURE LOW SWITCH ARE NOT SAFETY RELATED. SEE CALC. X5CFEMA1816.

VALVE	OPEN POSITION SWITCH		TEST POSITION SWITCH		CLOSE POSITION SWITCH	
	VENDOR	BECTEL	VENDOR	BECTEL	VENDOR	BECTEL
1HV-3006A	* 111	1250-3006A	* 115	1250T-3006A	* 122	125C-3006A
1HV-3006B		1250-3006B		1250T-3006B		125C-3006B
1HV-3016A		1250-3016A		1250T-3016A		125C-3016A
1HV-3016B		1250-3016B		1250T-3016B		125C-3016B
1HV-3026A		1250-3026A		1250T-3026A		125C-3026A
1HV-3026B		1250-3026B		1250T-3026B		125C-3026B
1HV-3036A		1250-3036A		1250T-3036A		125C-3036A
1HV-3036B		1250-3036B		1250T-3036B		125C-3036B

**NUCLEAR SAFETY RELATED EQUIPMENT LIST AND ALARM**

SOUTHERN COMPANY SERVICES, INC.  
 BIRMINGHAM, ALABAMA  
 GEORGIA POWER COMPANY  
 ALVIN W. VOGTLE NUCLEAR PLANT

**CONTROL LOGIC DIAGRAM MAIN STEAM SYSTEM**

△							
△							
△	INCORP. PER ABN-50579			7-16-98	ELC	EOG	MWD
△	ISSUED FOR CONSTRUCTION			SEE MICROFILM FOR SIGNATURES			
NO.	REVISIONS			DATE	DR	CHK	APPV

SCALE: NONE	DRAWING NO.	REV
JOB NO. 10604	1X5DN149-3	5

This drawing and the design it covers are the property of BECHTEL. They are merely loaned and on the borrower's express agreement that they will not be re-produced, copied, loaned, exhibited, or used except in the limited way and private use permitted by any written consent given by the lender to the borrower.


OPEN

QMCB, 1-HS-13005A, OPEN (PI)

NOTE 2

ENERGIZE SOL VALVE  
1-HY-13005A

OPEN VALVE  
1-HV-13005A

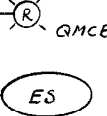

AUTO

QMCB, 1-HS-13005A, AUTO (PI)


QMCB, 1-HS-3007A  
1-HS-3007B

DWG 149-1

STM LINE ISOL (SLI-A)


DE ENERGIZE SOL VALVE  
1-HY-13005A

CLOSE VALVE  
1-HV-13005A

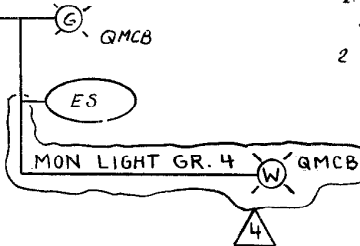

CLOSE

QMCB, 1-HS-13005A, CLOSE (P)

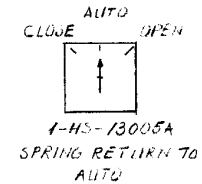

NOTES:

1. VALVE 1-HV-13005A SHOWN. OTHER VALVES LISTED IN TABLE 1 SIMILAR EXCEPT AS TABLED.
2. HAND SWITCH SHALL BE HELD ON OPEN POSITION UNTIL VALVE IS FULLY OPEN TO ALLOW CIRCUIT TO SEAL IN THROUGH VALVE POSITION SWITCH.

REF DWGS

PE 1D 1X4DA153-2  
E-D 1X3D-BC-Q02H, J

TABLE 1

HAND VALVE	HAND SWITCH	SAFETY SIGNAL	SOLENOID VALVE
1-HV-13005A	1-HS-13005A	SLI-A	1-HY-13005A
↓ B	↓ B	-B	↓ B
1-HV-13006A	1-HS-13006A	-A	1-HY-13006A
↓ B	↓ B	-B	↓ B
1-HV-13007A	1-HS-13007A	-A	1-HY-13007A
↓ B	↓ B	-B	↓ B
1-HV-13008A	1-HS-13008A	-A	1-HY-13008A
↓ B	↓ B	-B	↓ B

MSIV BYPASS VALVES

NUCLEAR SAFETY RELATED

**BECHTEL**  
LOS ANGELES

**GEORGIA POWER COMPANY**  
ALVIN W. VOGTLE NUCLEAR PLANT

CONTROL LOGIC DIAGRAM  
MAIN STEAM SYSTEM

---

SCALE: NONE

JOB NO. 9510

DRAWING NO. 1X5DN149-4

REV. 4

NO.	REV. TO INC. DCN 1	DATE	DR	CHK.	SUPV.	EGL	EGS	CHF. E.	P. E.	Q. A. E.	ENG. MGR.
NO.	REVISIONS	DATE	DR	CHK.	SUPV.	EGL	EGS	CHF. E.	P. E.	Q. A. E.	DATE
NO.	REVISIONS	DATE	DR	CHK.	SUPV.	EGL	EGS	CHF. E.	P. E.	Q. A. E.	DATE


BM 9510

SIZE B 11x17

14.5X

I CERTIFY THAT THE IMAGE CONTAINED ON THIS FRAME WAS MADE IN THE NORMAL AND REGULAR COURSE OF BUSINESS, ON THE DATE STATED BELOW AND THAT IT IS AN ACCURATE REPRODUCTION OF THE DOCUMENT SUBMITTED TO MICROGRAPHICS  
 G.H. B. [Signature]  
 DATE 6/22/80  
 CONTROL OPERATOR SECTION SUPERVISOR

This drawing and the design it covers are the property of BECHTEL. They are loaned and on the borrower's express agreement that they will not be reproduced, copied, loaned, exhibited, or used except in the limited way and private use permitted by any written consent given by the lender to the borrower.

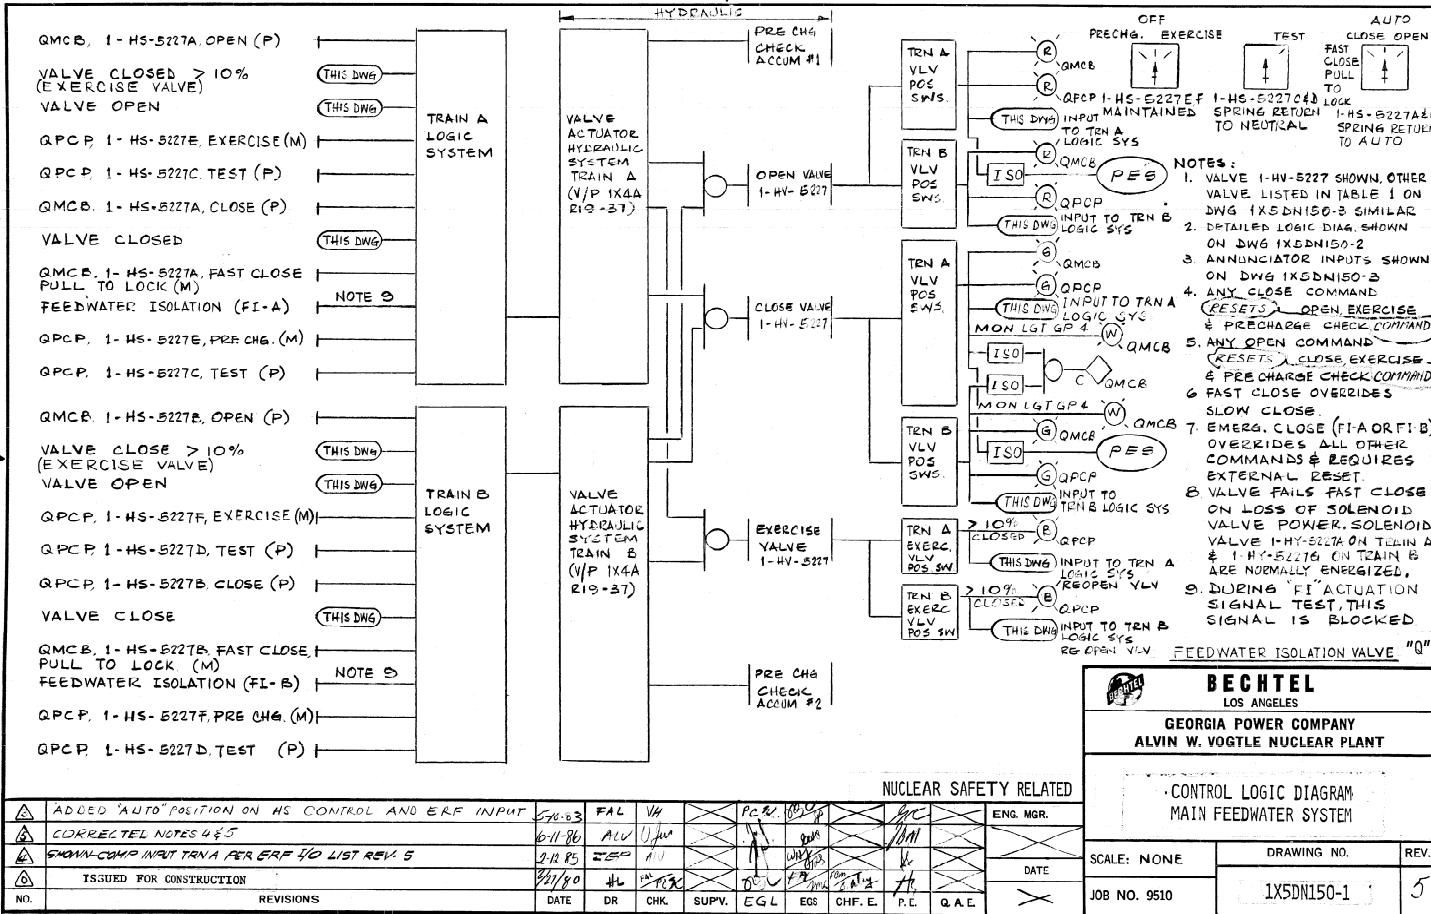

- NOTES:**
1. VALVE 1-HV-5227 SHOWN, OTHER VALVE LISTED IN TABLE I ON DWG 1X5DN150-3 SIMILAR
  2. DETAILED LOGIC DIAG. SHOWN ON DWG 1X5DN150-2
  3. ANNUNCIATOR INPUTS SHOWN ON DWG 1X5DN150-3
  4. ANY CLOSE COMMAND (RESETS) OPEN EXERCISE & PRECHARGE CHECK COMMAND
  5. ANY OPEN COMMAND (RESETS) CLOSE EXERCISE & PRECHARGE CHECK COMMAND
  6. FAST CLOSE OVERRIDES SLOW CLOSE.
  7. EMERG. CLOSE (FI-A OR FI-B) OVERRIDES ALL OTHER COMMANDS & REQUIRES EXTERNAL RESET.
  8. VALVE FAILS FAST CLOSE ON LOSS OF SOLENOID VALVE POWER. SOLENOID VALVE 1-HV-5227A ON TRAIN A & 1-HV-5227B ON TRAIN B ARE NORMALLY ENERGIZED.
  9. DURING 'FI' ACTUATION SIGNAL TEST, THIS SIGNAL IS BLOCKED


<b>BECHTEL</b> LOS ANGELES		
GEORGIA POWER COMPANY ALVIN W. VOGTLE NUCLEAR PLANT		
CONTROL LOGIC DIAGRAM MAIN FEEDWATER SYSTEM		
SCALE: NONE	DRAWING NO.	REV.
JOB NO. 9510	1X5DN150-1	5

NUCLEAR SAFETY RELATED

△	ADDED "AUTO" POSITION ON HS CONTROL AND ERF INPUT	5/20/83	FAL	VH						ENG. MGR.
△	CORRECTED NOTES 4 & 5	6/11/86	ALV	UJW						
△	SHOWING COMP INPUT TRNA PER ERF VO LIST REV. 5	3/11/85	SSO	AI						
△	ISSUED FOR CONSTRUCTION	12/1/80	HL	WPK						
NO.	REVISIONS	DATE	DR	CHK.	SUPV.	EGL	EGS	CHF. E.	P.L.	Q.A.E.

I CERTIFY THAT THE IMAGE CONTAINED ON THIS FRAME WAS MADE IN THE NORMAL AND REGULAR COURSE OF BUSINESS, ON THE DATE STATED BELOW AND THAT IT IS AN ACCURATE REPRODUCTION OF THE DOCUMENT SUBMITTED TO MICROGRAPHICS  
 G.H. B. [Signature]  
 DATE 6/22/80  
 CONTROL OPERATOR SECTION SUPERVISOR

This drawing and the design it covers are the property of BECHTEL. They are loaned and on the borrower's express agreement that they will not be re-used, modified, or made known in the limited way and scope permitted by any written consent given by the borrower.

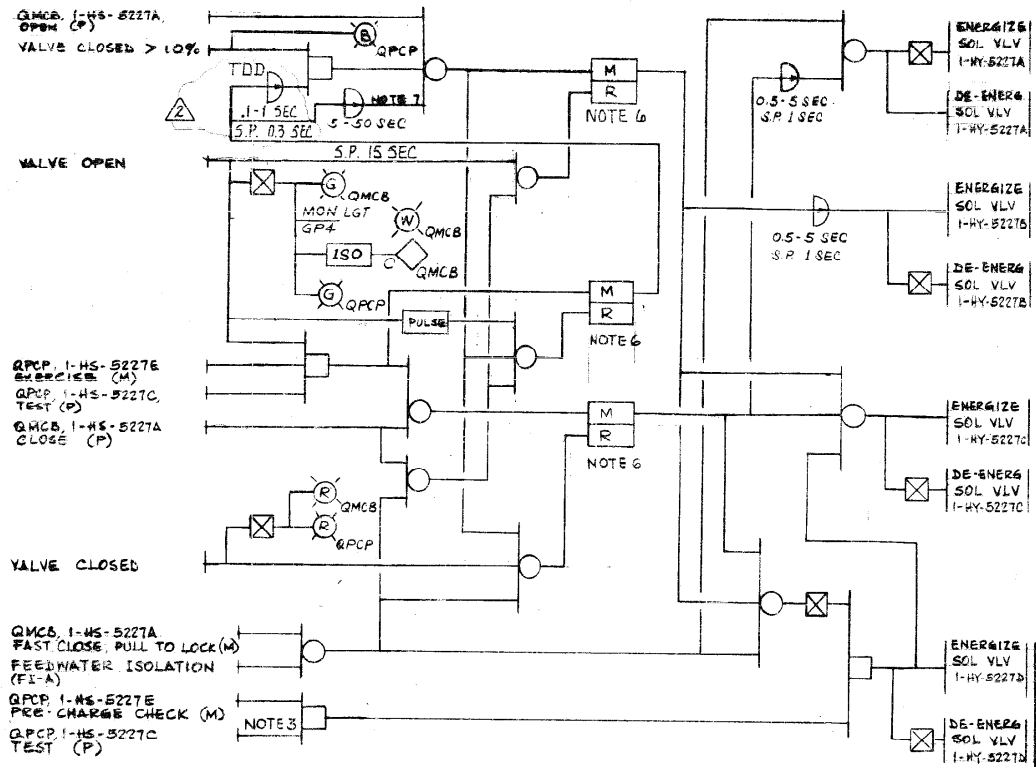

- NOTES:**
1. VALVE 1-HY-5227 LOGIC TRAIN A SHOWN, TRAIN B SIMILAR, OTHER VALVES LISTED IN TABLE 1 ON DWG 1X5DN150-2.
  2. HAND SWITCH POSITION SHOWN ON DWG 1X5DN150-1.
  3. HOLD DURING PRECHARGE ACCUMULATOR PRESSURE CHECK AND THEN RELEASE.
  4. SOLENOID VALVES ARE 125VDC.
  5. SEQUENCE OF OPERATION SHOWN IN TABLE 2 ON DWG 1X5DN150-3.
  6. RESET HAS PRIORITY OVER MEMORY.
  7. TIME DELAY SHALL BE SET MORE THAN THE TIME THE VALVE REACHES 10% CLOSE FROM FULLY OPEN POSITION, THIS TIME DELAY SIGNAL IS A BACK-UP TO TEST EXERCISE.

REF DWGS:  
 P & ID 1X4DB16B-3  
 E.D. 1X30-80-0069, 60, 70, 80, 80, 90, 90  
 V/P 1X4AR19-37, 39 & 57

NUCLEAR SAFETY RELATED "Q"  
 FEEDWATER ISOLATION VALVE

BECHTEL LOS ANGELES
GEORGIA POWER COMPANY ALVIN W. VOSTLE NUCLEAR PLANT
CONTROL LOGIC DIAGRAM MAIN FEEDWATER SYSTEM

INCORP. ASN 87-VIE207A001		DATE	M.W.D.	CHK	SUPV.	ENGL	EGS	CHK	P.E.	Q.A.E.	ENG. MGR.
NO.	REVISIONS	DATE	DR.	CHK	RPE	DM	ODPM	DPM	DPM		
1	ADDED TIME DELAY SET POINT & REVISED AS INDICATED	7-9-81	FAL	V.V.	X	P.R.	X	X	X	X	
2	ISSUED FOR CONSTRUCTION	8/1/80	JL	S.P.O.	X	D.L.	X	X	X	X	
NO.	REVISIONS	DATE	DR.	CHK.	SUPV.	ENGL	EGS	CHK	P.E.	Q.A.E.	DATE

SCALE: NONE	DRAWING NO. 1X5DN150-2	REV. 2
JOB NO. 9510		

DN 9510

SIZE B 11x17

TABLE 1 (EQUIPMENT LIST)

VALVE	HAND SWITCHES			SOLENOID VALVES				SFTY ACT	TRAIN	HYDRAULIC PRESS SW	AIR RESERV. PRESS SW	HYD. TK LVL SW	HYD. PRESS. RELIEF VLV.
	I-HS-5227A	I-HS-5227C	I-HS-5227E	I-HY-5227A	I-HY-5227B	I-HY-5227C	I-HY-5227D						
I-HV-5227	27B	27D	27F	27G	27H	27J	27K	B	A	I-PS-5227A	I-PS-5227B	I-LS-5227	IPS-V-5227C
	28A	28C	28E	28A	28B	28C	28D	A	A		28A		28B
28	28B	28D	28F	28G	28H	28J	28K	B	B	29A	29B	29	IPS-V-5228C
	29A	29C	29E	29A	29B	29C	29D	A	A		29A		29B
29	29B	29D	29F	29G	29H	29J	29K	B	B	30A	30B	30	IPS-V-5229C
	30A	30C	30E	30A	30B	30C	30D	A	A		30A		30B
30	30B	30D	30F	30G	30H	30J	30K	B	B		30C		IPS-V-5230C
													30C


- NOTES:
- TABLE 2 SHOWS VALVE I-HY-5227 SOLENOID VALVES SEQUENCE OF OPERATION, OTHER VALVES SIMILAR
  - E - ENERGIZE  
D - DE-ENERGIZE  
TD - TIME DELAY
  - LOGIC DIAGRAM SHOWN ON DWG 1X5DN150-1 & 2
  - ANNUNCIATOR INPUTS FOR VALVE I-HV-5227 SHOWN OTHER VALVES ALARM INPUT SIMILAR AS LISTED IN TABLE 1.

4

TABLE 2 (SEQUENCE OF OPERATION)

CONTROL ACTION	STEP	SOLENOID VALVE STATUS (TRAIN A)				SOLENOID VALVE STATUS (TRAIN B)			
		I-HY-5227A	I-HY-5227B	I-HY-5227C	I-HY-5227D	I-HY-5227G	I-HY-5227H	I-HY-5227J	I-HY-5227K
SLOW OPEN	FULL CLOSE	E	D	D	D	E	D	D	D
	OPENING		TD, E	E			TD, E	E	
SLOW CLOSE	FULL OPEN		D	D			D	D	
	CLOSING	TD, D		E		TD, D		E	
FAST OR EMERG CLOSE	FULL CLOSE	E		D		E		D	
	FULL OPEN			D				D	
EXERCISE 10% VALVE STROKE	FULL OPEN	E		D		E		D	
	CLOSING	TD, D		E		TD, D		E	
ACCUM INERT GAS PRE CHG CHECK	OPEN OR CLOSE			D				D	
	RECHG ACCUM HYDR FLUID			D				D	

ALARMS

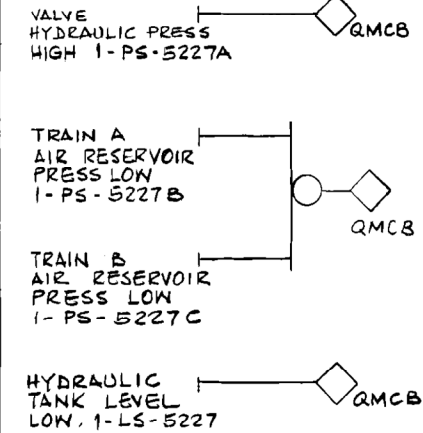

REF DWGS:  
P&ID 1X4DB16B-3  
E.D 1X3D-8C-C06C, 6D, 7C, 7D, 8C, 8D, 9C, 9D

NUCLEAR SAFETY RELATED "Q"

ALARMS & EQUIPMENT LIST


SOUTHERN COMPANY SERVICES, INC.  
BIRMINGHAM, ALABAMA  
GEORGIA POWER COMPANY  
ALVIN W. VOGTLE NUCLEAR PLANT

CONTROL LOGIC DIAGRAM  
MAIN FEEDWATER SYSTEM

△									
△									
△									
4	INCORP. PER DCP 00-V1N0045	12-12-03	RCR	RBH	DEW	X			
NO.	REVISIONS	DATE	DR	CHK	APPV	DTL			

SCALE: NONE	DRAWING NO.	REV
JOB NO. 10604	1X5DN150-3	4

THIS DRAWING AND THE DESIGN IT COVERS ARE THE PROPERTY OF SCS. THEY ARE LOANED TO THE BORROWER TO EXPRESS AGREEMENT THAT THEY WILL NOT BE REPRODUCED, COPIED, LOANED, EXHIBITED, OR USED EXCEPT IN THE LIMITED WAY AND MERELY LOANED AND ON THE BORROWER'S EXPRESS AGREEMENT THAT THEY WILL NOT BE REPRODUCED, COPIED, LOANED, EXHIBITED, OR USED EXCEPT IN THE LIMITED WAY AND

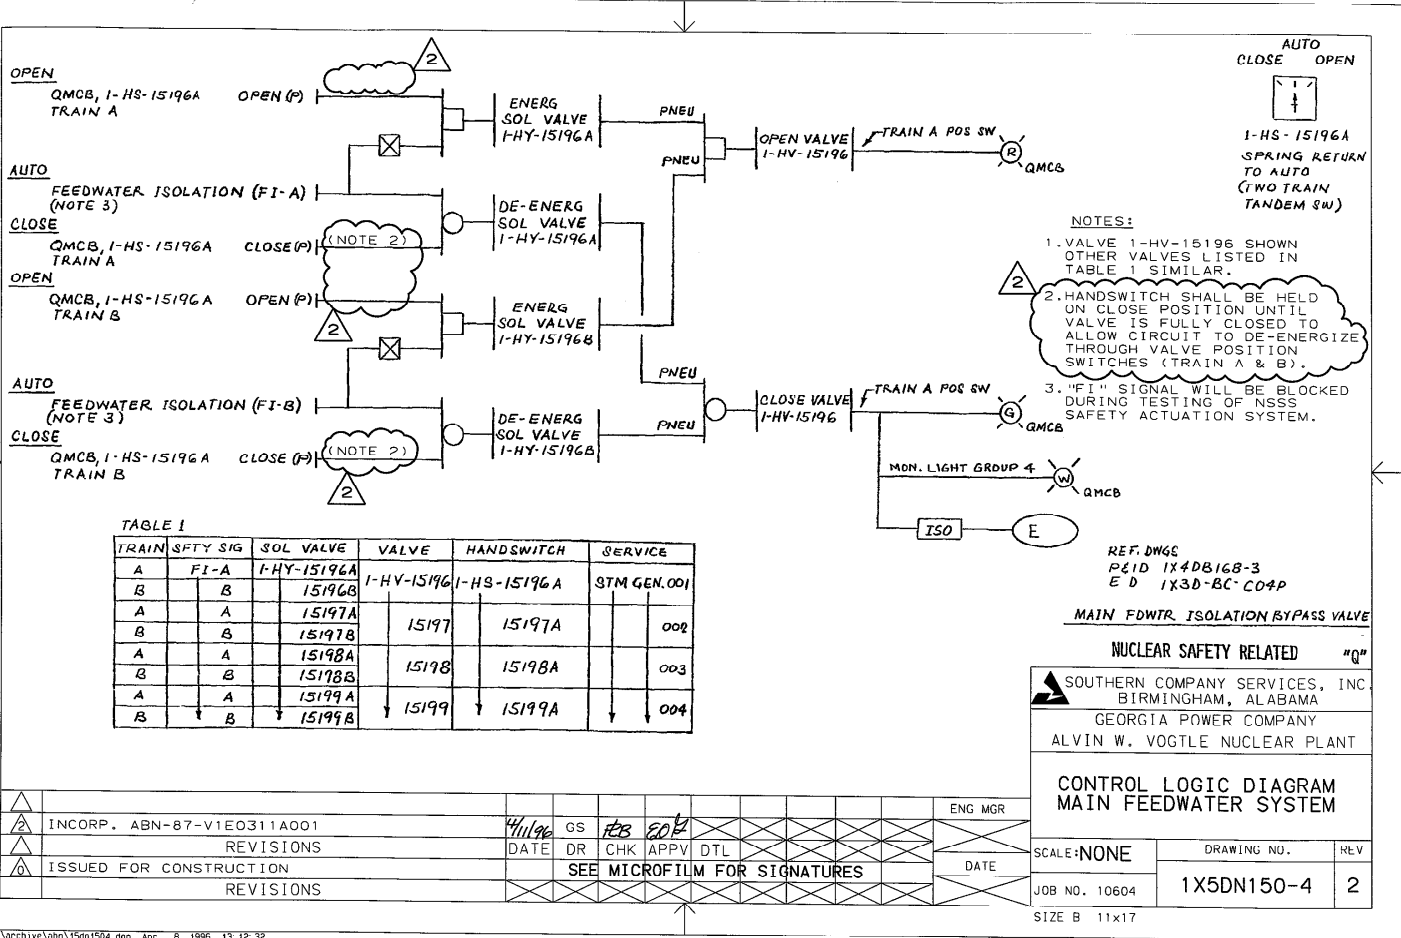

- NOTES:**
1. VALVE 1-HV-15196 SHOWN OTHER VALVES LISTED IN TABLE 1 SIMILAR.
  2. HANDSWITCH SHALL BE HELD ON CLOSE POSITION UNTIL VALVE IS FULLY CLOSED TO ALLOW CIRCUIT TO DE-ENERGIZE THROUGH VALVE POSITION SWITCHES (TRAIN A & B).
  3. "FI" SIGNAL WILL BE BLOCKED DURING TESTING OF NSSS SAFETY ACTUATION SYSTEM.

**TABLE 1**

TRAIN	SFTY SIG	SOL VALVE	VALVE	HANDSWITCH	SERVICE
A	FI-A	1-HY-15196A	1-HY-15196	1-HS-15196A	STM GEN.001
B	B	15196B			
A	A	15197A	15197	15197A	002
B	B	15197B			
A	A	15198A	15198	15198A	003
B	B	15198B			
A	A	15199A	15199	15199A	004
B	B	15199B			

REF. DWGS  
 P&ID 1X4DB168-3  
 E D 1X3D-BC-C04P

**MAIN FDWTR ISOLATION BYPASS VALVE**

**NUCLEAR SAFETY RELATED "Q"**

SOUTHERN COMPANY SERVICES, INC.  
 BIRMINGHAM, ALABAMA  
 GEORGIA POWER COMPANY  
 ALVIN W. VOGTLE NUCLEAR PLANT

**CONTROL LOGIC DIAGRAM  
 MAIN FEEDWATER SYSTEM**

SCALE: NONE      DRAWING NO.      REV  
 JOB NO. 10604      1X5DN150-4      2

SIZE B 11x17

INCORP. ABN-87-V1E0311A001	4/11/96	GS	REB	EDP																ENG MGR
REVISIONS	DATE	DR	CHK	APPV	DTL															DATE
ISSUED FOR CONSTRUCTION	SEE MICROFILM FOR SIGNATURES																			
REVISIONS																				



This drawing and the design it covers are the property of BECHTEL. They are loaned to the borrower's express agreement that they will not be re-produced, copied, loaned, exhibited, or used except in the limited way and private use permitted by any written consent given by the lender to the borrower.

OPEN

QMCB, 1-HS-15214 OPEN (P)


NOTE 1

AUTO

AB, CVCS LETDOWN HX RM R-A07  
HIGH TEMP 1-TY-15214D (1X5DV202)

AB, CVCS VLV GALLERY RM R-A08  
HIGH TEMP 1-TY-15214F (1X5DV203)

AB, PIPE PENET RM R-A09  
HIGH TEMP 1-TY-15214G (1X5DV204)

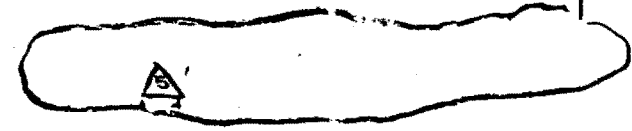

CLOSE

QMCB, 1-HS-15214 CLOSE (P)

ENERGIZE SOL VALVE  
1-HY-15214

PNEU

OPEN VALVE  
1-HV-15214



QMCB

DE-ENERG SOL VALVE  
1-HY-15214

PNEU

CLOSE VALVE  
1-HV-15214



QMCB

AUTO  
CLOSE OPEN



1-HS-15214  
SPRING RETURN  
TO AUTO

NOTES:

- HANDSWITCH SHALL BE HELD ON OPEN POSITION UNTIL VALVE IS FULLY OPEN TO ALLOW CIRCUIT TO SEAL IN THROUGH VALVE POSITION SWITCH.
- TRAIN B POWER SUPPLY.

ALARM

AB, CVCS LETDOWN HX RM R-A07  
HIGH TEMP 1-TY-15214J (1X5DV202)

AB, CVCS VLV GALLERY RM R-A08  
HIGH TEMP 1-TY-15214K (1X5DV203)

AB, PIPE PENET RM R-A09  
HIGH TEMP 1-TY-15214L (1X5DV204)



QPCP

ZEF DWGS.

P # ID 1X4DB114

E. D. 1X3D-30-COIS.

NUCLEAR SAFETY RELATED

"Q"

<b>BECHTEL</b> LOS ANGELES		
GEORGIA POWER COMPANY ALVIN W. VOGTLE NUCLEAR PLANT		
CONTROL LOGIC DIAGRAM CVCS LETDOWN HX INLET PIPE BREAK ROOM PROTECTION		
SCALE: NONE	DRAWING NO.	REV.
JOB NO. 9510	1X5DN151-1	5

SCANNED DATE: SEP 14 1994

NO.	REVISIONS	DATE	DR	CHK	SUPV.	E&L	EGS	CHF. E.	P. E.	Q. A. E.
1	INPUT PARAMETER CHANGED FROM FY-15214A TO PY-15214A PER P#ID	6-13-83	ALV	FAL						ENG. MGR.
2	INCORPORATED DCN #1 (YFCRB-4353)	9-17-86	ALV	NCB						
3	CHANGED SWITCH ACTION PER PROCESS REQUIREMENTS	4-2-84	ALV	FAL						
4	ISSUED FOR CONSTRUCTION	10-24-90	FAL	XCB						


BM 9510 P&ID REV.

SIZE B 11x17

JLH  
9-14-91

This drawing and the design it covers are the property of BECHTEL. They are loaned and on the borrower's express agreement that they will not be re-produced, copied, loaned, exhibited, or used except in the limited way and private use permitted by any written consent given by the lender to the borrower.


**ISOLATING SIGNAL**

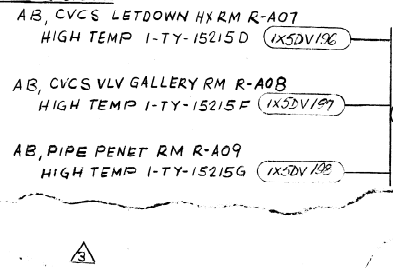

ENERGIZE SOL VALVE I-HY-15215	PNEU NOTE 1	ENABLE TO OPEN VALVE I-HY-8160
DE-ENERG. SOL VALVE I-HY-15215	PNEU NOTE 1	CLOSE VLV I-HY-8160

- NOTES**
1. ANOTHER SOLENOID VALVE I-HY-8160 SHALL BE ENERGIZED TO OPEN VALVE I-HY-8160 AND DE-ENERGIZED TO CLOSE, REFER TO DWG IX3D-BD-C04A.
  2. TRAIN A POWER SUPPLY.

**ALARM**

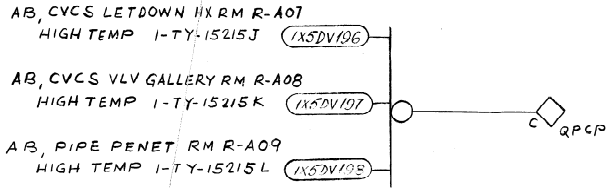

REF DWGS  
P&ID IX40B114  
E. D. IX3D-BD-COIR.

NUCLEAR SAFETY RELATED "Q"

<b>BECHTEL</b> LOS ANGELES		
GEORGIA POWER COMPANY ALVIN W. VOGTLE NUCLEAR PLANT		
CONTROL LOGIC DIAGRAM CVCS LETDOWN HX INLET PIPE BREAK ROOM PROTECTION		
SCALE: NONE	DRAWING NO. IXSDW151-2	REV. 3
JOB NO. 9510		

NO.	REVISIONS	DATE	DR	CHK	SUPV.	EG1	EGS	CHF. E.	P. E.	Q. A. E.	ENG. MGR.
△	INCORPORATED DCN #1 - YFCR - 4854	9-17-80	AW	NCB							
△	CHANGED SWIT. ACTION PER PROTECT. REQUIREMENT.	4-2-84	AW	FAL		PC	AW				
△	INPUT PARAMETER CHANGED FROM FY-15215A TO FY-15215H PER P&ID	6-13-83	AW	FAL		PC	AW				
△	ISSUED FOR CONSTRUCTION	10-1-83	AW	FAL		PC	AW				




BM 9510 P&ID REV

SIZE B 11x17

I CERTIFY THAT THE IMAGE CONTAINED ON THIS FRAME WAS MADE IN THE NORMAL AND REGULAR COURSE OF BUSINESS, ON THE DATE STATED BELOW AND THAT IT IS AN ACCURATE REPRODUCTION OF THE DOCUMENT SUBMITTED TO MICROGRAPHICS.

DATE: 9-18-86 CAMERA OPERATOR SECTION SUPERVISOR

This drawing and the design it covers are the property of BECHTEL. They are merely loaned and on the borrower's express agreement that they will not be re-produced, copied, loaned, exhibited, or used except in the limited way and private use permitted by any written consent given by the lender to the borrower.

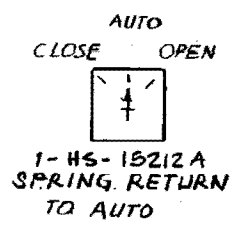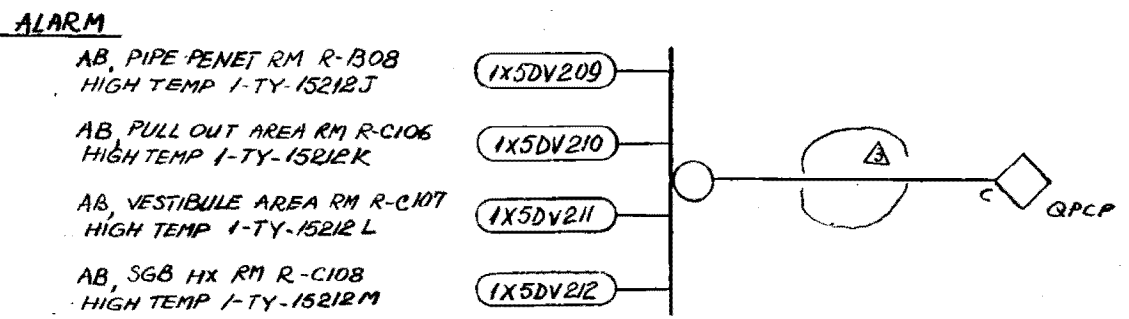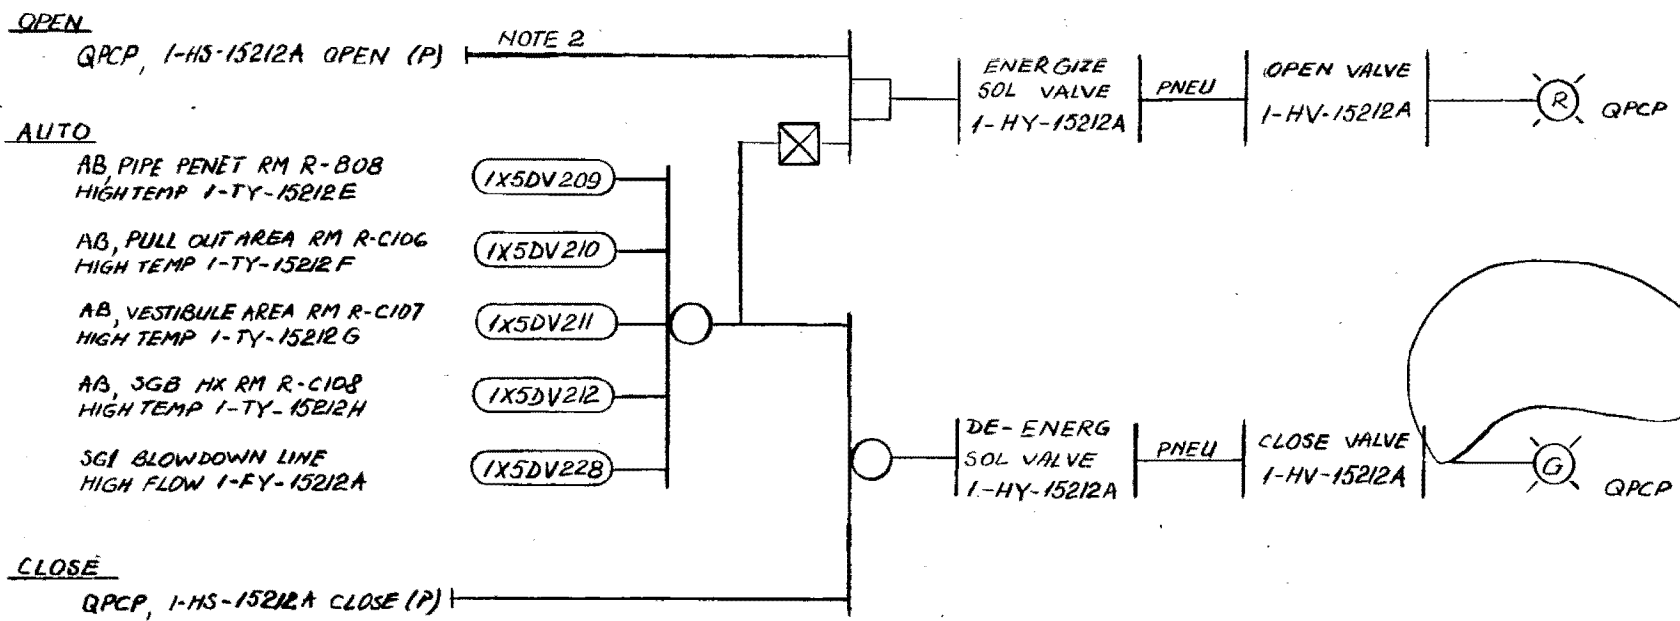

**NOTES:**

1. VALVE 1-HV-15212A SHOWN. OTHER VALVES LISTED IN TABLE 1. SIMILAR, EXCEPT AS TABULATED
2. HANDSWITCH SHALL BE HELD ON OPEN POSITION UNTIL VALVE IS FULLY OPEN TO ALLOW CIRCUIT TO SEAL IN THROUGH VALVE POSITION SWITCH.

**REF. DWGS.**  
 P & ID 1X4DB179-1, 159-1, 159-3  
 LOOP DIAG. 1X5DV228, 230, 232, 234  
 E.D. 1X3D-BC-Q01J

SCANNED DATE: SEP 16 1991

NUCLEAR SAFETY RELATED

TABLE 1

SERVICE	TRAIN	SOL VALVE	VALVE	HAND SW.	TEMP SW	FLOW SW.
SG 1 BLOWDOWN LINE	A	1-HY-15212A	1-HV-15212A	1-HS-15212A	1-TY-15212 E, F, G & H	1-FY-15212A
2	A	-15212B	-15212B	-15212B		-15212B
3	A	-15212C	-15212C	-15212C		-15212C
4	A	-15212D	-15212D	-15212D		-15212D

**BECHTEL**  
LOS ANGELES

**GEORGIA POWER COMPANY**  
**ALVIN W. VOGTLE NUCLEAR PLANT**

CONTROL LOGIC DIAGRAM  
AB STM GEN BLOWDOWN  
PIPE BREAK ROOM PROTECTION

SCALE: NONE	DRAWING NO.	REV.
JOB NO. 9510	1X5DN152-1	3

NO.	REVISIONS	DATE	DR	CHK	SUPV.	EGL	EGS	CHF. E.	P. E.	Q. A. E.	ENG. MGR.
	DELETED MONITORING LIGHTS. VALVES NOT CONSIDERED CMNT. ISOLATION	10-18-82	AV	FAL		PCZ					
	DELETED PRESSURE PARAMETER AND ADDED ISOLATION VALVE	6-25-82	AD	FAL		PCZ					
	REVISED PER REF P&ID REV. 5 MARKED-UP	2-8-82	FAL			PCZ					
	ISSUED FOR CONSTRUCTION	12-21-80	FAL	KCB		PCZ					

REM

h6-11-90



This drawing and the design it covers are the property of BECHTEL. They are merely loaned and on the borrower's express agreement that they will not be re-produced, copied, loaned, exhibited, or used except in the limited way and private use permitted by any written consent given by the lender to the borrower.

OPEN  
QPCP, 1-HS-15216A OPEN (P)

AUTO  
AB, PIPE PENET RM R-B08  
HIGH TEMP 1-TY-15216E  
AB, PULL OUT AREA RM R-C106  
HIGH TEMP 1-TY-15216F  
AB, VESTIBULE AREA RM R-C107  
HIGH TEMP 1-TY-15216G  
AB, SGB HX RM R-C108  
HIGH TEMP 1-TY-15216H  
SGI BLOWDOWN LINE  
HIGH FLOW 1-FY-15216A

CLOSE  
QPCP, 1-HS-15216A CLOSE (P)

ALARM  
AB, PIPE PENET RM R-B08  
HIGH TEMP 1-TY-15216J  
AB, PULL OUT AREA RM R-C106  
HIGH TEMP 1-TY-15216K  
AB, VESTIBULE AREA RM R-C107  
HIGH TEMP 1-TY-15216L  
AB, SGB HX RM R-C108  
HIGH TEMP 1-TY-15216M

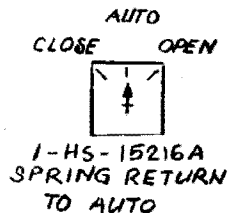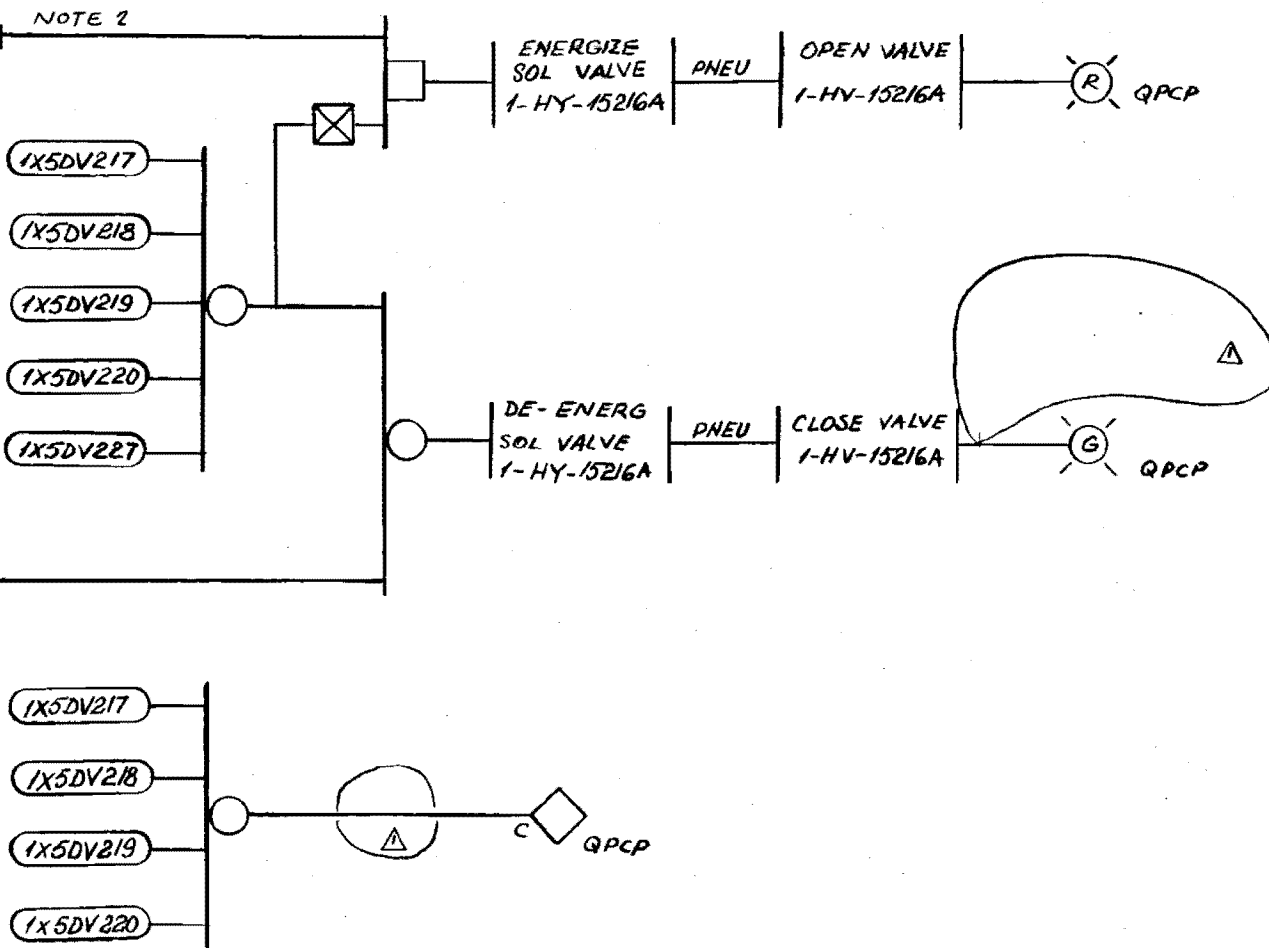

NOTES.  
1. VALVE 1-HV-15216A SHOWN. OTHER VALVES LISTED IN TABLE 1 SIMILAR EXCEPT AS TABULATED.  
2. HANDSWITCH SHALL BE HELD ON OPEN POSITION UNTIL VALVE IS FULLY OPEN TO ALLOW CIRCUIT TO SEAL IN THROUGH VALVE POSITION SWITCH.

REF. DWGS.  
P & ID 1X4DB179-1.159-1.159-3  
LOOP DIAG. 1X5DV227, 229, 231 & 233  
E.D. 1X3D-BC-Q01K

SCANNED DATE: SEP 11 1991  
NUCLEAR SAFETY RELATED "Q"

TABLE 1

SERVICE	TRAIN	SOL VALVE	VALVE	HAND SW.	TEMP SW.	FLOW SW.
SG 1 BLOWDOWN LINE	B	1-HY-15216A	1-HV-15216A	1-HS-15216A	1-TY-15216 E, F, G & H	1-FY-15216A
2	B	-15216B	-15216B	-15216B		-15216B
3	B	-15216C	-15216C	-15216C		-15216C
4	B	-15216D	-15216D	-15216D		-15216D

NO.	REVISIONS	DATE	DR	CHK.	SUPV.	EGS	CHF. E.	P. E.	Q. A. E.	ENG. MGR.
△										
△	DELETED MONITORING LIGHTS. VALVES NOT CONSIDERED ONMT. ISOLATION	10-18-82	AV	FAL						
△	ISSUED FOR CONSTRUCTION	6-25-82	AD	FAL						

**BECHTEL**  
LOS ANGELES

**GEORGIA POWER COMPANY**  
**ALVIN W. VOGTLE NUCLEAR PLANT**


**CONTROL LOGIC DIAGRAM**  
**AB STM GEN BLOWDOWN**  
**PIPE BREAK ROOM PROTECTION**

SCALE: NONE	DRAWING NO.	REV.
JOB NO. 9510	1X5DM152-2	1

SM

THIS DOCUMENT CONTAINS PROPRIETARY, CONFIDENTIAL, AND/OR TRADE SECRET INFORMATION OF THE SUBSIDIARIES OF THE SOUTHERN COMPANY OR OF THIRD PARTIES. IT IS INTENDED FOR USE ONLY BY EMPLOYEES OF, OR AUTHORIZED CONTRACTORS OF, THE SOUTHERN COMPANY. UNAUTHORIZED POSSESSION, USE, DISTRIBUTION, COPYING, DISSEMINATION, OR DISCLOSURE OF ANY PORTION HEREOF IS PROHIBITED.

**24 V DC SYSTEM**

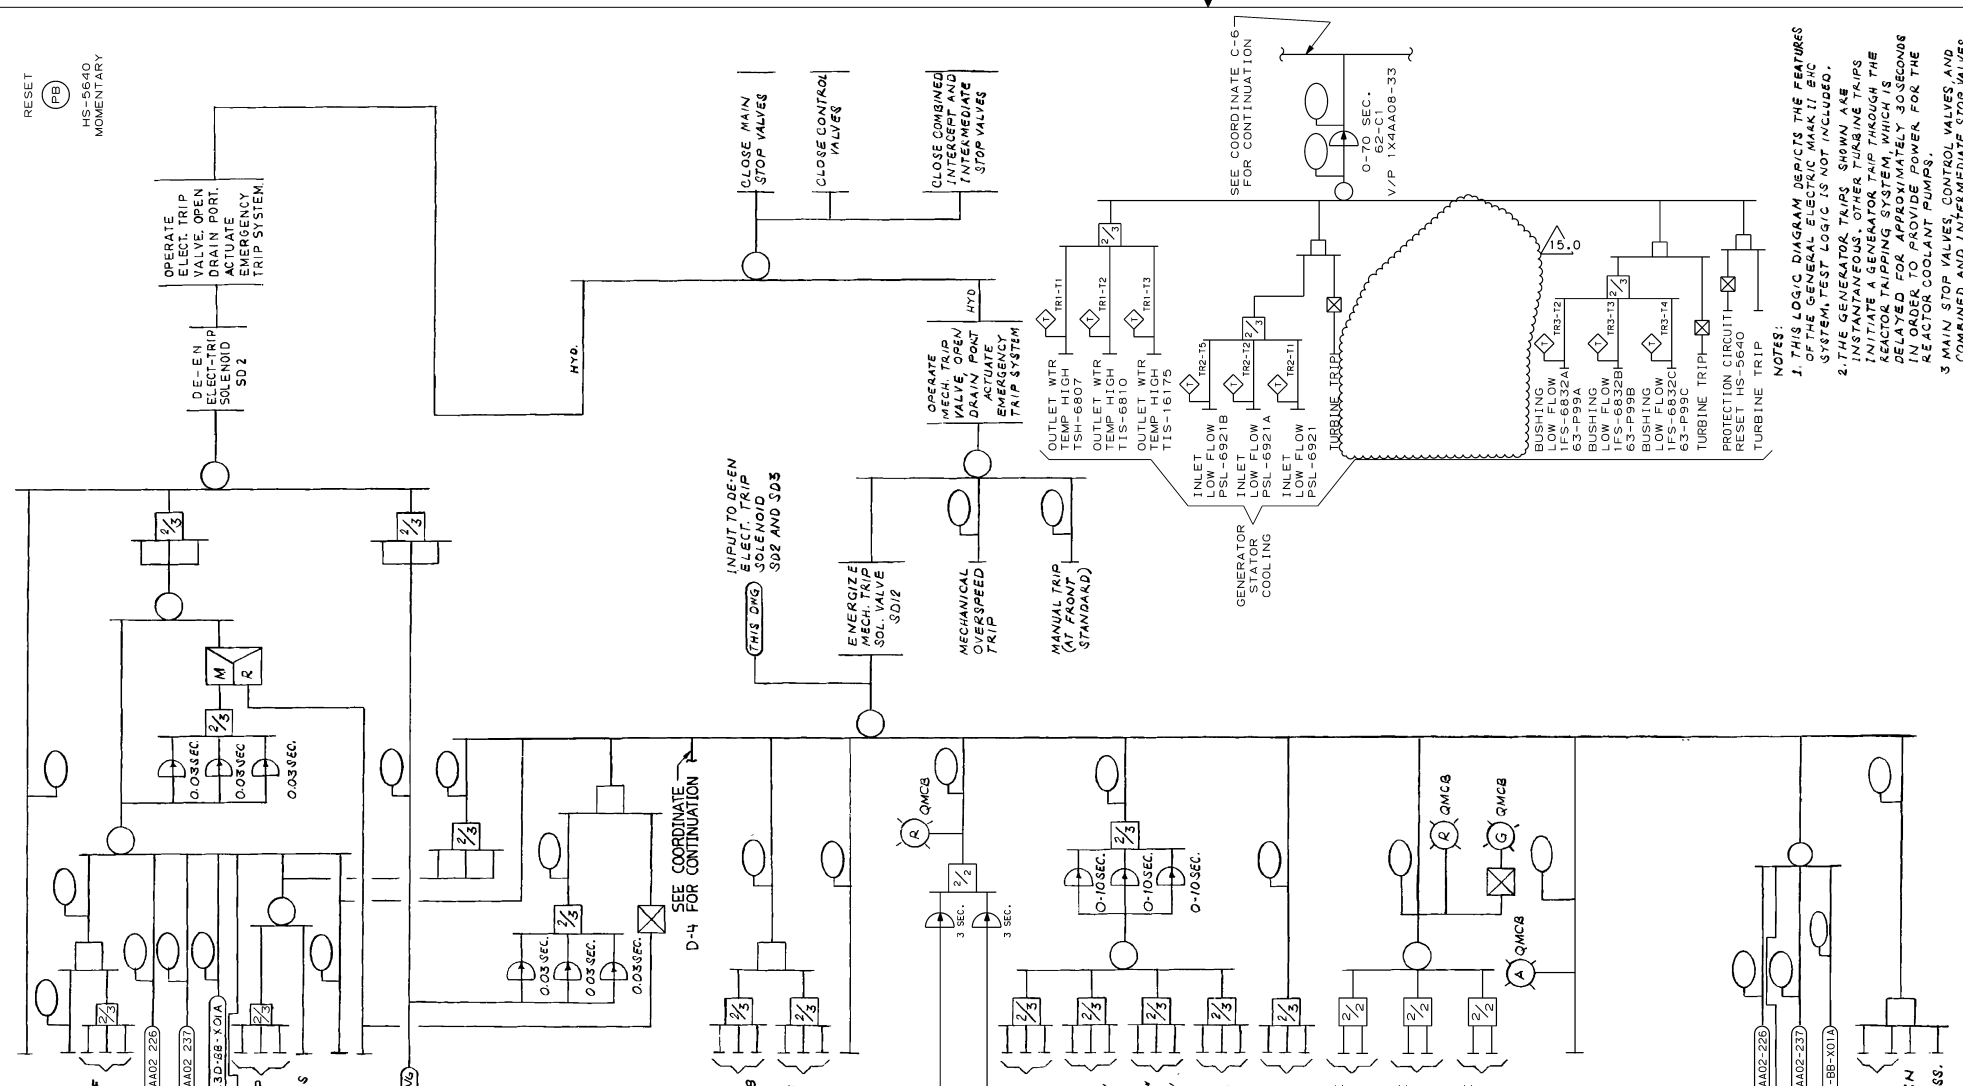

RESET (RB) HS-5640 MOMENTARY

OPERATE ELECT. TRIP VALVE, OPEN DRAIN PORT, ACTUATE EMERGENCY TRIP SYSTEM.

AM5AC TRN B LO FW (V/P IX6A01-336) BACK-UP OVERSPEED TRIP

**125 V DC SYSTEM**

SHAFT L.O. PUMP DISCH PRESSURE LOW PSL-6336, 6327, 6328

SPEED ABOVE 75% OF RATED SPEED

BKG. VIBRATION HIGH

LOW HYDRAULIC PRESSURE PISL-6338A

MOISTURE SEPARATOR 'A' HIGH LEVEL, LSH-4844A, B & C.

MOISTURE SEPARATOR 'B' HIGH LEVEL, LSH-4845A, B & C.

MOISTURE SEPARATOR 'C' HIGH LEVEL, LSH-4846A, B & C.

MOISTURE SEPARATOR 'D' HIGH LEVEL, LSH-4847A, B & C.

LOW BEARING OIL PRESS PSL-6533, 6530 & 6531

EXHAUST HOOD 'A' PRESSURE HIGH LEVEL, PISH-6292A & PISH-6292B

EXHAUST HOOD 'B' PRESSURE HIGH LEVEL, PISH-6293A & PISH-6293B

EXHAUST HOOD 'C' PRESSURE HIGH LEVEL, PISH-6294A & PISH-6294B

THRUST BEARING FAILURE ZIS-6631

AM5AC TRN A LO FW (V/P IX6A02-226) REACTOR TRIP TRAIN A OR SFTY INT TRN A GENERATOR TRIP

EMERG. TRIP SYSTEM PRESSURE LOW PS-6309 & 6310

GEN. CIRCUIT BKR. OPEN

MECH. TRIP VLV. NO PRESS. PS-6305

**INTERFACE INTERLOCK**

SOUTHERN COMPANY SERVICES, INC. BIRMINGHAM, ALABAMA

GEORGIA POWER COMPANY ALVIN W. VOGTLE NUCLEAR PLANT

CONTROL LOGIC DIAGRAM MAIN TURBINE TRIPPING SYSTEM


SCALE: NONE	DRAWING NO. 1X5DN203-1	VER. 15.0
JOB NO. 10604		

NUCLEAR SAFETY RELATED


15.0	REVISED PER ABN 1049001501J011, VER 1.0	8/18/09	RBH	MWD	JMR	
NO.	VERSIONS	DATE	DR	CHK	APPV	DTL

- NOTES:**
- THIS LOGIC DIAGRAM DEPICTS THE FEATURES OF THE GENERAL ELECTRIC MARK II BNC SYSTEM. TEST LOGIC IS NOT INCLUDED.
  - THE GENERATOR TRIPS SHOWN ARE INSTANTANEOUS. OTHER TURBINE TRIPS INITIATE A GENERATOR TRIP THROUGH THE REACTOR TRIPPING SYSTEM, WHICH IS DELAYED APPROXIMATELY 30 SECONDS IN ORDER TO PROVIDE POWER FOR THE REACTOR COOLANT PUMPS.
  - MAIN STOP VALVES, CONTROL VALVES AND COMBINED AND INTERMEDIATE STOP VALVE POSITIONS ARE INDICATED BY PERCENTAGE INDICATORS.
  - PROVIDE ANNUNCIATOR INPUT FOR CONTROL POWER LOSS ON CUSTOMER TRIP ISOLATION LOSS (TRAIN A & B).
  - THE SYMBOL REPRESENTS INTERPOSING INTERLOCKS WHICH ARE LOCATED ON THE HYDROGEN RELAYS WHICH ARE LOCATED ON THE CONTROL PANEL (HS50).


REF. DNGS V/P 1X4A411-445 UP TO 454 INST LOOP DNG 1X5DN094-95-96

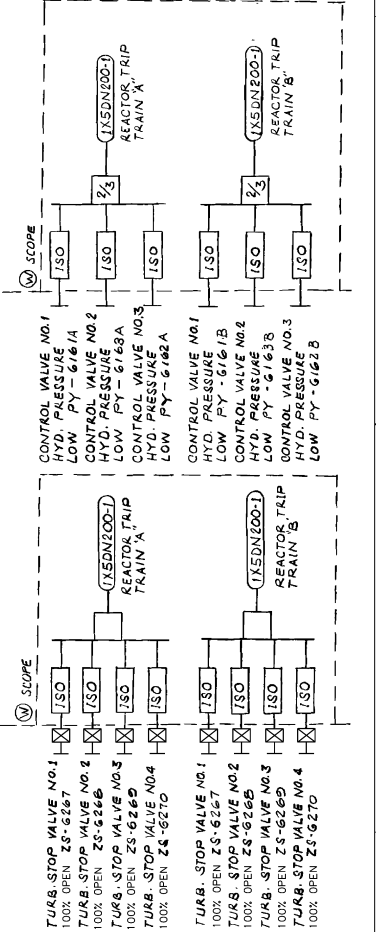

**PNEUMATIC INSTRUMENTS**

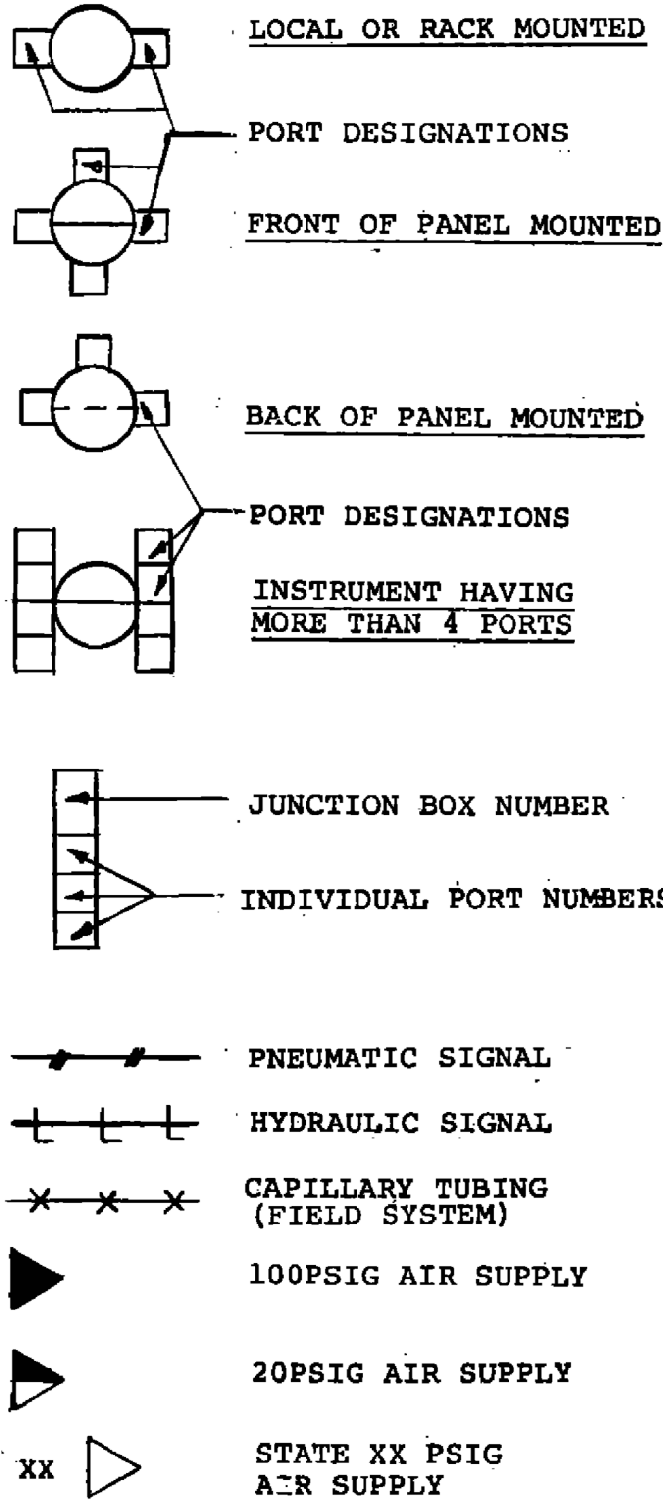

**ELECTRONIC INSTRUMENTS**

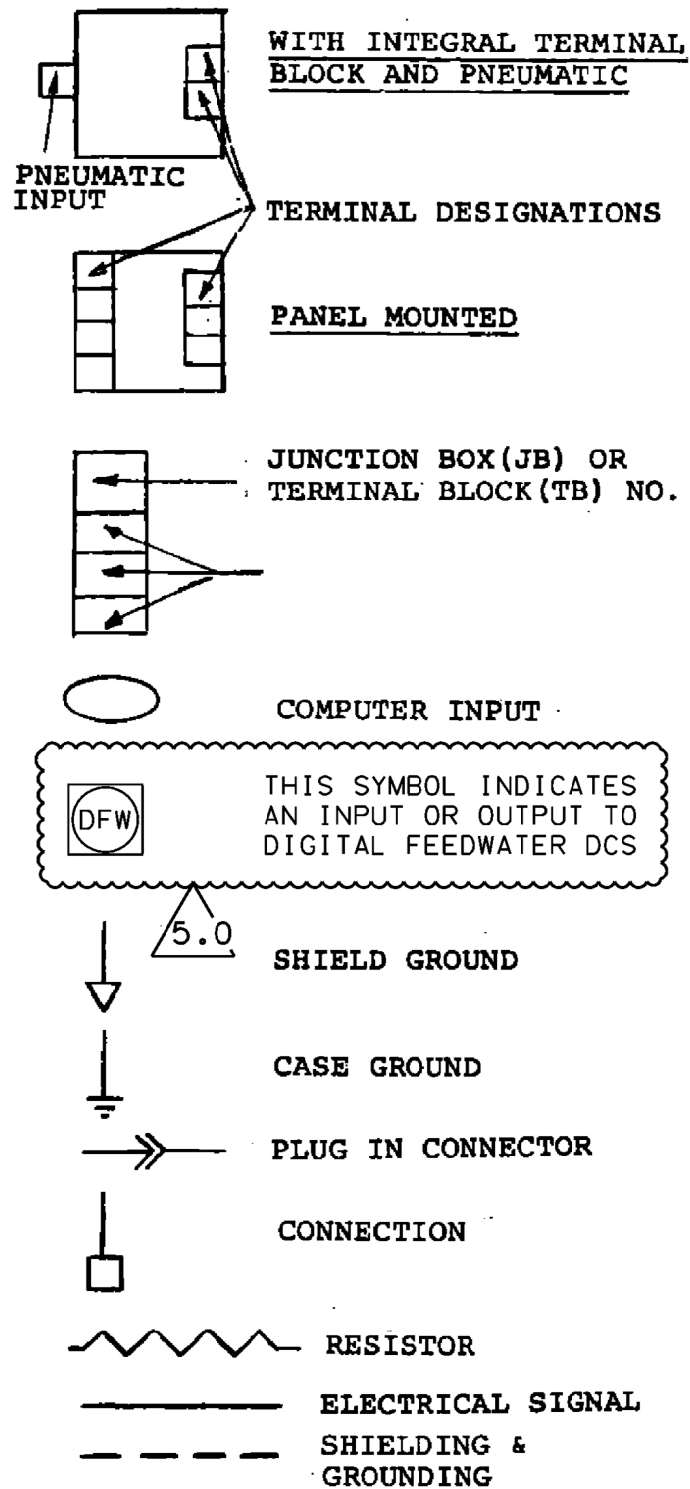

**GENERAL NOTES**

- For symbols & abbreviations not covered, refer to:
  - P&ID Drawing 1X5DV 101 & 1X5DV102
  - ISA Standard S5.4-1976, Instrument Loop Diagrams.
- All equipment numbers, line numbers, and instrument tag numbers have a Unit 1 prefix, unless otherwise noted.
- All computer output signals are 24 VDC nominal, unless otherwise noted.
- All shield wire to be grounded at the process cabinets, unless otherwise noted.
- All pneumatic signals are 3-15 PSIG, unless otherwise noted.
- All resistors are 100 OHM, one watt, one percent tolerance, unless otherwise noted.
- Information shown on individual loop diagrams includes field instrument, panels/process rack connections, hard-wired indicators/recorders, and transfer switches.
- Applicable secondary loop information (alarms, computer points, and control interlocks) i.e., cabling information, termination information, location number information, can be found on the cross reference drawing identified on the individual loop diagrams, or in the EE-580 Data Base.
- All loop instruments are direct acting unless otherwise noted.
- For all OIM stations manual actuation of "RAISE" button opens the valve to increase the process variable, and actuation of "LOWER" button closes the valve to decrease the process variable, unless otherwise noted.

**BISTABLE**

- Process variable normally less than set point or reference. Comparator energizes on increase.
- Process variable normally less than set point or reference. Comparator de-energizes on increase.
- Process variable normally greater than set point or reference. Comparator energizes on decrease.
- Process variable normally greater than set point or reference. Comparator de-energize on decrease.

**NOTES ON OUTPUT RELAY ACTION**

Output relay state (A) or (B)

All cabinet outputs from bistable driven relays shall be unpowered isolated dry contacts. Contact state is identified as follows:

(A) Contact open with bistable de-energized.

(B) Contact closed with bistable de-energized.

- AC Source
- Subtract, difference
- Output equals square root of input
- Algebraic summation or totalize
- Cabinet mounted card

**SOUTHERN COMPANY SERVICES, INC.**  
BIRMINGHAM, ALABAMA

**GEORGIA POWER COMPANY**  
ALVIN W. VOGTLE NUCLEAR PLANT



**INSTRUMENT LOOP DIAGRAM LEGEND**

5.0	REVISED PER ABN 1039002501J173, VER 1.0	07/26/13	DCP	MWD	JMR	
NO.	VERSIONS	DATE	DR	CHK	APPV	


SCALE: NONE	DRAWING NO.	VER.
JOB NO. 10604	1X5DV002	5.0

1-1385  
200827

LOGIC SYMBOLS

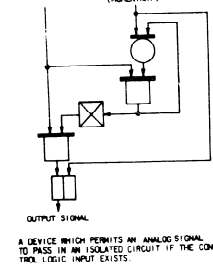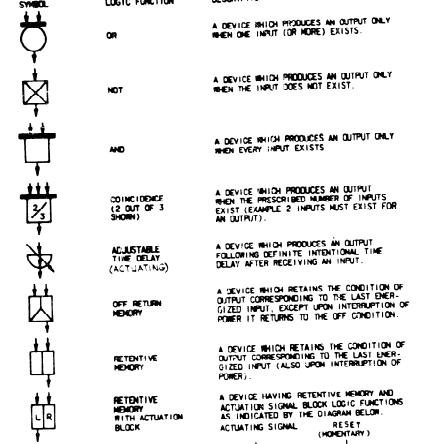

ADDITIONAL SYMBOLS

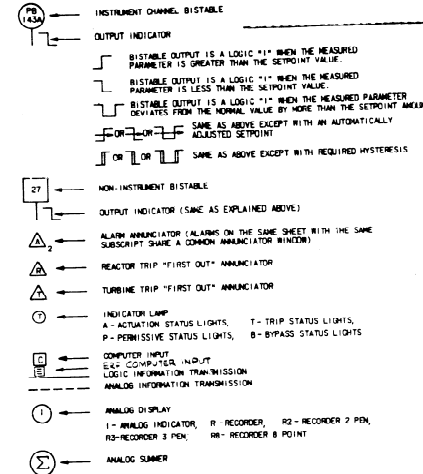

GENERAL NOTES: (FOR ALL SHEETS)


- IN ALL LOGIC CIRCUITS, THE INDICATED ACTUATION OF A SYSTEM OR DEVICE OCCURS WHEN A LOGIC "1" SIGNAL IS PRESENT, EXCEPT WHERE INDICATED OTHERWISE. ALL BISTABLES ARE THE "ENERGIZE TO ACTIVATE" SUCH THAT A LOGIC 1 SIGNAL IS DEFINED TO BE PRESENT WHEN THE BISTABLE OUTPUT VOLTAGE IS OFF.
- EXCEPT WHERE INDICATED OTHERWISE, THE FOLLOWING IS TRUE: ALL LOGIC CIRCUITS ARE REDUNDANT THAT IS EVERY LOGIC CIRCUIT SHOWN HAS A DUPLICATE LOCATED IN A SEPARATE CABINET. ALL INSTRUMENT CHANNELS, BISTABLES, ANNUNCIATORS, COMPUTER INPUTS, AND INDICATOR LAMPS ARE NOT REDUNDANT. MANUAL CONTROLS DO NOT HAVE REDUNDANT ACTUATORS, BUT DO HAVE REDUNDANT CONTACTS WHERE LOGIC IS REDUNDANT. ALL INDICATOR LAMPS, ANNUNCIATORS, AND COMPUTER INPUTS ARE CONNECTED TO BOTH TRAINS (WHERE LOGIC IS REDUNDANT) SO THAT A SIGNAL IN EITHER TRAIN WILL ACTUATE.
- WHenever a PROCESS SIGNAL IS USED FOR CONTROL AND IS DERIVED FROM A PROTECTION CHANNEL, ISOLATION MUST BE PROVIDED.
- THIS SET OF DRAWINGS ILLUSTRATES THE FUNCTIONAL REQUIREMENTS OF THE REACTOR CONTROL AND PROTECTION SYSTEM, INCLUDING ENGINEERED SAFEGUARDS. THESE DRAWINGS DO NOT REPRESENT ACTUAL HARDWARE IMPLEMENTATION. FOR HARDWARE IMPLEMENTATION, REFER TO THE FOLLOWING LIST:  
FUNCTIONAL DIAGRAM: REACTOR PROTECTION SYSTEM (SHEETS 1 TO 8 AND 15 TO 17)  
REACTOR CONTROL SYSTEM (SHEETS 9 TO 14 AND 18 TO 20)
- THIS SET OF DRAWINGS IS IDENTICAL FOR UNITS 1 AND 2 EXCEPT FOR THE TAG NUMBERS. FOR UNIT 1 TAG NUMBERS ADD A "1" EXAMPLE: 1PH-455E. FOR UNIT 2 TAG NUMBERS ADD A "2" EXAMPLE: 2PH-455E.

GEORGIA POWER COMPANY  
PLANT: VOGTLE ELECTRIC GENERATING PLANT  
UNITS: 1 & 2 SPIN: AASPECCS  
STATUS: APPROVED  
AUTHORITY: C. L. TAYLOR  
CERTIFICATION LTR. NO. GP-14217  
ENGR. LTR. NO. EP/SA-64490

DEVICE FUNCTION LETTERS AND NUMBERS

- FB FLOW CHANNEL
- LB LEVEL CHANNEL
- MC MISC. CHANNEL
- PC PRESSURE CHANNEL
- RC RADIATION CHANNEL
- SB SPEED CHANNEL
- TB TEMPERATURE CHANNEL
- ZB POSITION CHANNEL
- 20 ELECTRIC OPERATED VALVE
- 27 UNDERVOLTAGE RELAY
- 33 POSITION SWITCH
- 50 AC CIRCUIT BREAKER
- 63 PRESSURE SWITCH
- 71 LEVEL SWITCH
- 80 FLOW SWITCH
- 81 UNDERVOLTAGE RELAY


LOGIC SYMBOLS (CONT.)

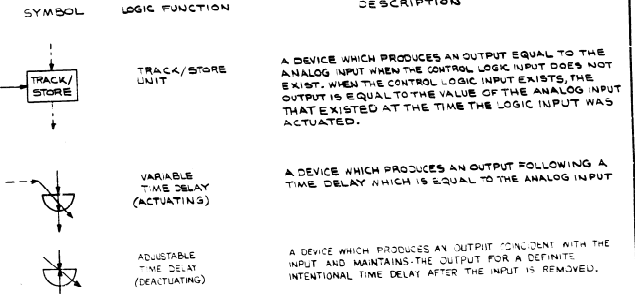

INDEX

TITLE	DN	NO	NO	SUBS
INDEX AND SYMBOLS	1	2	1	
REACTOR TRIP SIGNALS	2	2	6	
NUCLEAR INSTR. PERMISSIVES AND BLOCKS	3	4	4	
NUCLEAR INSTR. PERMISSIVES AND BLOCKS	4	4	2	
PRIMARY COOLANT SYSTEM TRIP SIGNALS	6	6	6	
PRESSURIZER TRIP SIGNALS	6	6	6	
STEAM GENERATOR TRIP SIGNALS	7	7	2	
SAFEGUARDS ACTUATION SIGNALS	8	8	11	
RED CONTROLS & RED BLOCKS	8	8	6	
STEAM CLAMP CONTROL	10	10	4	
PRESSURIZER PRESSURE CONTROL	11	11	5	
FEEDWATER CONTROL & ISOLATION	12	12	5	
FEEDWATER HEATER CONTROL	13	13	5	
FEEDWATER CONTROL & ISOLATION	14	14	5	
AUXILIARY FEEDWATER PUMPS STARTUP	15	15	7	
TURBINE TRIPS, TURBOCOMPS & OTHER SIGNALS	16	16	14	
PRESSURIZER PRESS. REL. SYS. (TRAIN A)	17	17	2	
PRESSURIZER PRESS. REL. SYS. (TRAIN B)	18	18	2	
PRESSURIZER LEVEL CONTROL	20	20	2	
SAFEGUARDS ACTUATION SIGNALS (CONT.)	21	21	11	

\* SHEET 1 DELETED

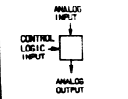

SCOPE OF SUPPLY DEMARCATION

REDAUNDANCY DEMARCATION

NO.	DESCRIPTION	DATE	BY	CHKD BY	APP'D BY
1	DESIGNED	11/11/77	...	...	...
2	REVISION	...	...	...	...
3	...	...	...	...	...
4	...	...	...	...	...
5	...	...	...	...	...
6	...	...	...	...	...
7	...	...	...	...	...
8	...	...	...	...	...
9	...	...	...	...	...
10	...	...	...	...	...
11	...	...	...	...	...

WESTINGHOUSE PROPRIETARY DATA

THIS DOCUMENT CONTAINS PROPRIETARY INFORMATION OF THE WESTINGHOUSE CORPORATION WHICH IS UNLAWFULLY TO BE REPRODUCED OR TRANSMITTED IN ANY FORM OR BY ANY MEANS, ELECTRONIC OR MECHANICAL, INCLUDING PHOTOCOPYING, RECORDING, OR BY ANY INFORMATION STORAGE AND RETRIEVAL SYSTEM, WITHOUT PERMISSION IN WRITING FROM THE WESTINGHOUSE WATER REACTOR DIVISION.

WESTINGHOUSE Electric Corporation

7243 D07

SHEET 1

NO. 1000

DATE: 11/11/77

BY: ...

CHKD BY: ...

APP'D BY: ...

THIS DOCUMENT CONTAINS PROPRIETARY INFORMATION OF THE WESTINGHOUSE CORPORATION WHICH IS UNLAWFULLY TO BE REPRODUCED OR TRANSMITTED IN ANY FORM OR BY ANY MEANS, ELECTRONIC OR MECHANICAL, INCLUDING PHOTOCOPYING, RECORDING, OR BY ANY INFORMATION STORAGE AND RETRIEVAL SYSTEM, WITHOUT PERMISSION IN WRITING FROM THE WESTINGHOUSE WATER REACTOR DIVISION.

SUBSTANDARD  
 NOT SUITABLE FOR ORIGINAL  
 LEGIBLE REPRODUCTION  
 REVISION APPROVAL  
 (K-2)

VOGTLE ELECTRIC GENERATING PLANT JOB NO. 8510

EQUIPMENT TAG NO. WAT

STARTUP DESIGNATION NO. WAT

ACTIVITY NO. N/A

SYSTEM NO. WAT

CATEGORY NO. N/A

RE: MODIFYING REQUIRED  YES  NO

DISTRIBUTION TO: FOR REVIEW IN

- MECHANICAL
- HYD
- EQUIPMENT
- PROCESS
- CONTROL SYSTEMS
- ELECTRICAL
- WIRING
- CONDUIT
- HAZARDOUS
- CIVIL/STRUCTURAL
- NUCLEAR
- STRESS PLANT DESIGN
- CODES AND STANDARDS
- ARCHITECTURAL
- STARTUP
- CONSTRUCTION
- NOT RECD BY ENGRS
- CLIENT
- EQUIP. QUALIFICATION
- M & OS
- WESTINGHOUSE

IDENTIFYING TITLE OF THIS DOCUMENT  
FULL-SCALE DESIGN INDEX AND LISTS

1ch Log No  
160-102-205

**IMPORTANT**

Permission to proceed does not constitute acceptance or approval of design details, calculations, analyses, test methods or materials developed or selected by the supplier and does not relieve supplier of full compliance with contractual obligations.

DATE RECEIVED: 2-10-89 SIG


DOCUMENT STATUS

- DESIGN NOT PROCESSED
- DESIGN AND RESUBMIT WORK MAY BE PROCESSED, BUT TO INCORPORATION OF CHANGES INDICATED
- DESIGN AND RESUBMIT WORK MAY NOT BE PROCESSED
- NO MODIFICATION ONLY DISTRIBUTION PROCEEDS
- NO RESUBMIT - NOT ACCEPTABLE FOR MICROFILM WORK - MAY BE PROCESSED


**TRAIN A REACTOR SHUNT TRIP SIGNALS**

MANUAL REACTOR TRIP SIGNAL (SHEET 3)  
 MANUAL SAFETY INJECTION SIGNAL (SHEET 5)  
 MANUAL REACTOR TRIP SIGNAL (LOCAL) (SHEET 3)

**LOGIC TRAIN A REACTOR TRIP SIGNALS**


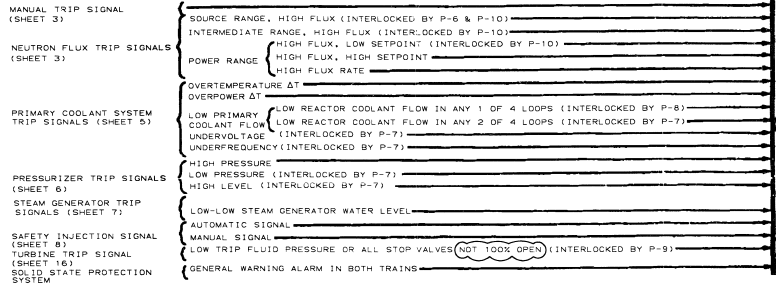


**LOGIC TRAIN B REACTOR TRIP SIGNALS**

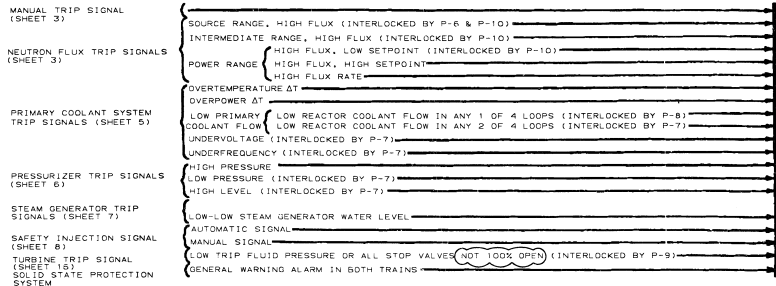

**TRAIN B REACTOR SHUNT TRIP SIGNALS**

MANUAL REACTOR TRIP SIGNAL (LOCAL) (SHEET 3)  
 MANUAL REACTOR TRIP SIGNAL (SHEET 3)  
 MANUAL SAFETY INJECTION SIGNAL (SHEET 5)

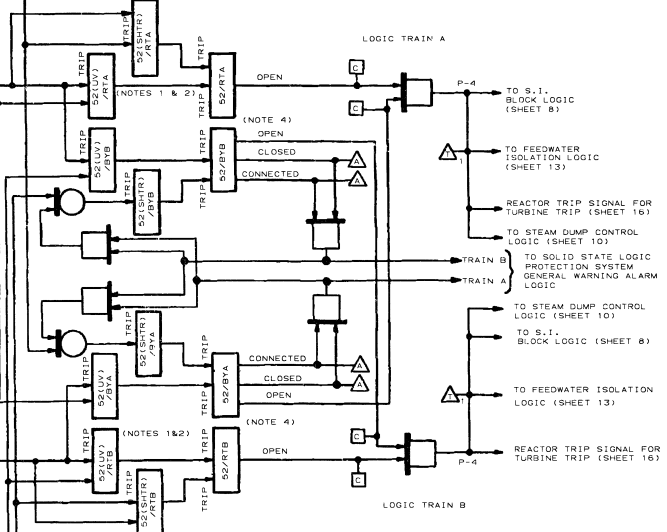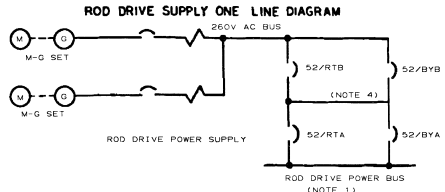

- NOTES:**
- TRIPPING THE REACTOR TRIP BREAKERS 52/RTA AND 52/RTB REDUNDANTLY DE-ENERGIZES THE ROD DRIVES. ALL FULL LENGTH CONTROL RODS AND SHUTDOWN RODS ARE THEREBY RELEASED FOR GRAVITY INSERTION INTO THE REACTOR CORE.
  - NORMAL REACTOR OPERATION IS TO BE WITH REACTOR TRIP BREAKERS 52/RTA AND 52/RYB IN SERVICE AND BY-PASS BREAKERS 52/RYA AND 52/RYB WITHDRAWN. DURING TEST, ONE BY-PASS BREAKER IS TO BE PUT IN SERVICE AND THEN THE RESPECTIVE REACTOR TRIP BREAKER IS OPERATED USING A SIMULATED REACTOR TRIP SIGNAL IN THE TRAIN UNDER TEST. THE REACTOR WILL NOT BE TRIPPED BY THE SIMULATED SIGNAL SINCE THE BY-PASS BREAKER IS CONTROLLED FROM THE OTHER TRAIN. ONLY ONE REACTOR TRIP BREAKER IS TO BE TESTED AT A TIME.
  - ALL CIRCUITS ON THIS SHEET ARE NOT REDUNDANT BECAUSE BOTH TRAINS ARE SHOWN.
  - OPEN/CLOSED INDICATION FOR EACH TRIP BREAKER AND EACH BYPASS BREAKER IN CONTROL ROOM.

ABN-05114  
 DESIGN BY TCS  
 AND CHECKED BY TCS  
 INCORP. ABN-05114

**Westinghouse Electric Corporation**  
 NUCLEAR ENERGY SYSTEMS INTERNATIONAL, INC. U.S.A.  
 ALVIN W. VOITTE UNITS 1 & 2  
 FUNCTIONAL DIAGRAM  
 REACTOR TRIP SIGNALS

SCALE: DIMENSIONS IN INCHES  
 SHEET 2  
 7243D07

DO NOT SCALE

**Southern Company Services, Inc.**

PLANT: VOITTE  
 TX06A03-278-9  
 FUNCTIONAL DIAGRAMS REACTOR TRIP SIGNALS  
 DATE RECEIVED: 12/03/93  
 REVISIONS AND REVISED BY SCS TO INCORPORATE ABN-05114

7/2/93




SOURCE RANGE REACTOR TRIP

INTERMEDIATE RANGE REACTOR TRIP

POWER RANGE REACTOR TRIP

POWER RANGE HIGH NEUTRON FLUX RATE REACTOR TRIP

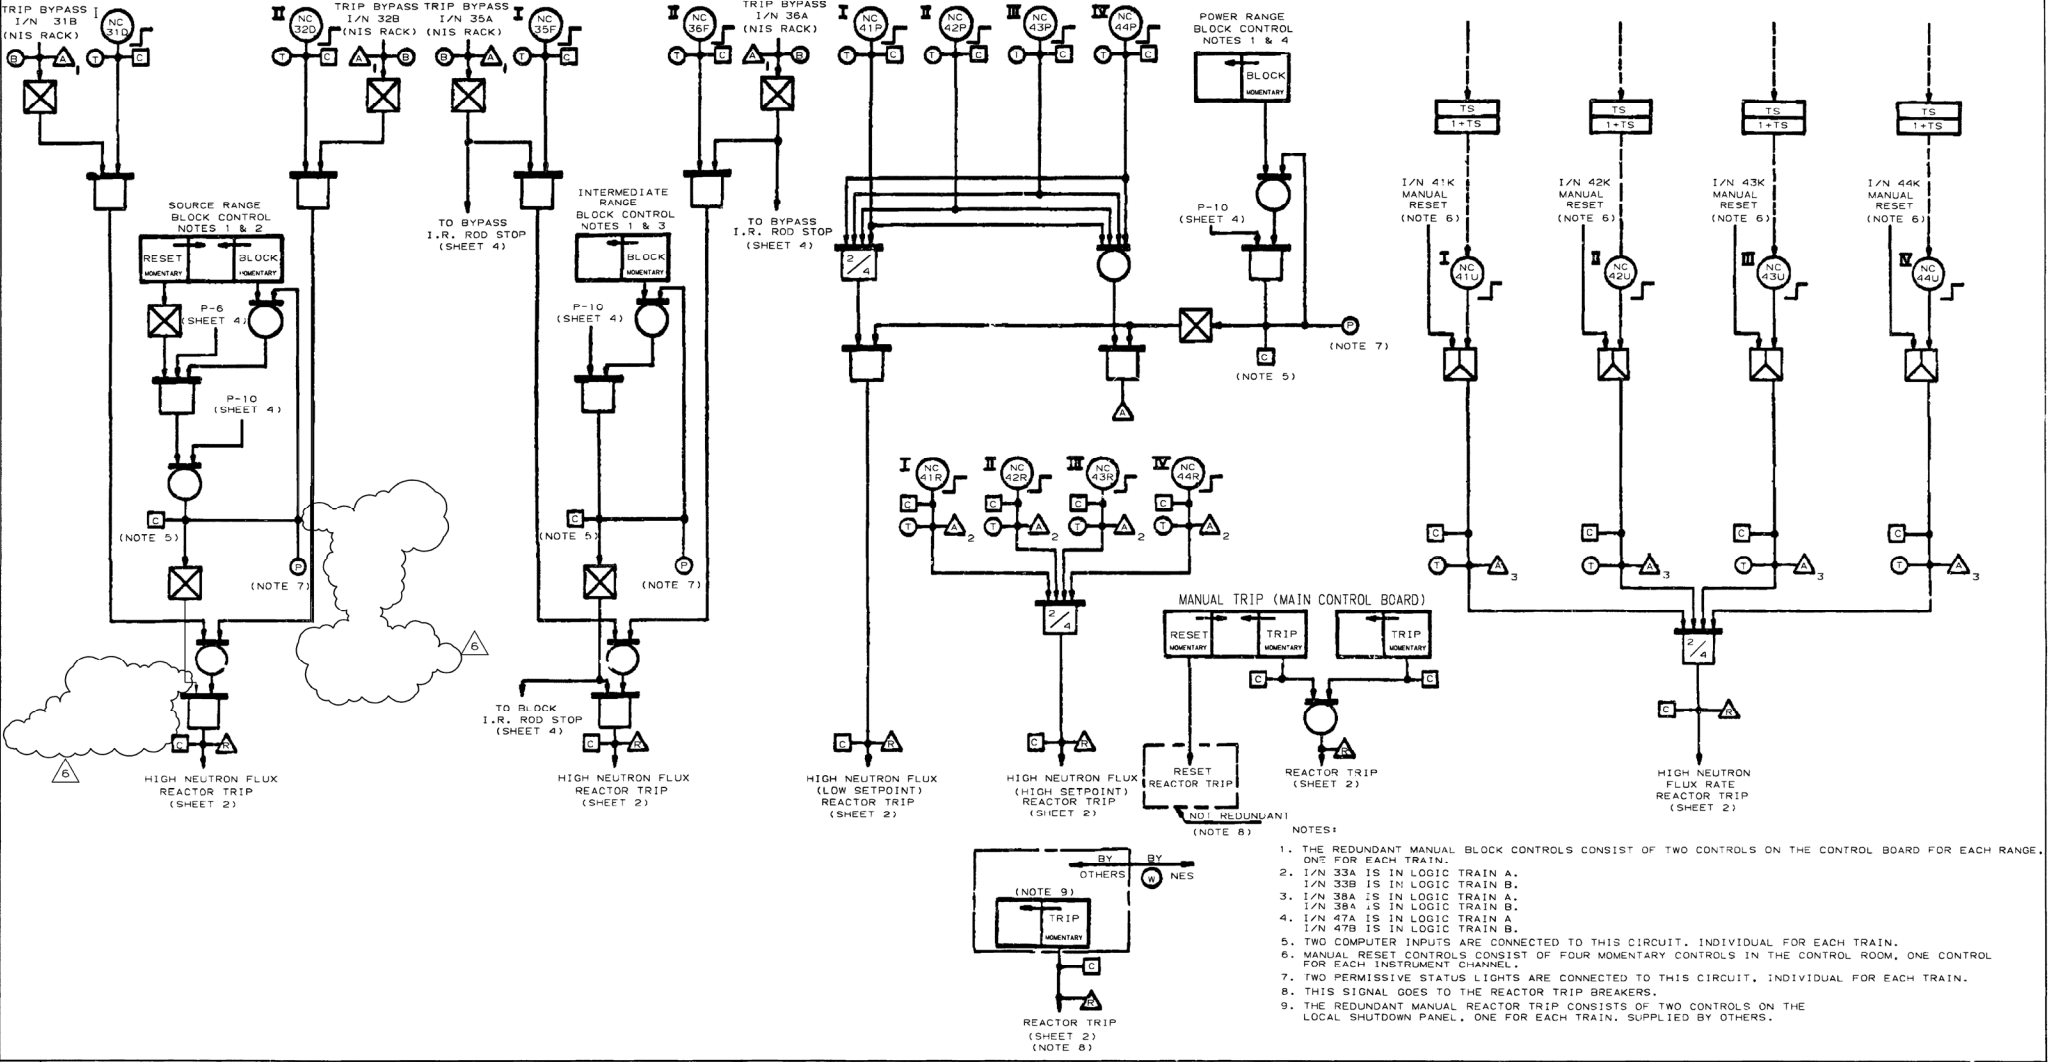

- NOTES:
1. THE REDUNDANT MANUAL BLOCK CONTROLS CONSIST OF TWO CONTROLS ON THE CONTROL BOARD FOR EACH RANGE, ONE FOR EACH TRAIN.
  2. I/N 33A IS IN LOGIC TRAIN A.  
I/N 33B IS IN LOGIC TRAIN B.
  3. I/N 38A IS IN LOGIC TRAIN A.  
I/N 38B IS IN LOGIC TRAIN B.
  4. I/N 47A IS IN LOGIC TRAIN A  
I/N 47B IS IN LOGIC TRAIN B.
  5. TWO COMPUTER INPUTS ARE CONNECTED TO THIS CIRCUIT, INDIVIDUAL FOR EACH TRAIN.
  6. MANUAL RESET CONTROLS CONSIST OF FOUR MOMENTARY CONTROLS IN THE CONTROL ROOM, ONE CONTROL FOR EACH INSTRUMENT CHANNEL.
  7. TWO PERMISSIVE STATUS LIGHTS ARE CONNECTED TO THIS CIRCUIT, INDIVIDUAL FOR EACH TRAIN.
  8. THIS SIGNAL GOES TO THE REACTOR TRIP BREAKERS.
  9. THE REDUNDANT MANUAL REACTOR TRIP CONSISTS OF TWO CONTROLS ON THE LOCAL SHUTDOWN PANEL, ONE FOR EACH TRAIN, SUPPLIED BY OTHERS.

GAE GBE-300  
ECN-14937  
CHANGES ENCLOSED  
RE-DRAWN AND  
RE-ISSUED BY SCS  
TO INDRP. ABR-11479

NO.	REVISIONS	DATE	DR	CHK	APPV
6	INCORPORATED PER DCP 96-V1N0044	05/12/99	ELC	EOG	GLB

SCS REVISIONS



DOCUMENT STATUS CODE 1

1X6AA02-00227-9

<p>BY: P. NEARN DATE: 1/1/99 DRAWN: J. Williams CHECKED: J. Williams DATE: 1/1/99 SCALE: AS SHOWN BY: J. Williams</p>	<p>Westinghouse Electric Corporation Nuclear Energy Systems, Pittsburgh, PA, U.S.A. TITLE: GEORGIA POWER CO. ALVIN W. VOGLIE UNITS 1 &amp; 2 NUCLEAR INSTR. &amp; MANUAL TRIP SIGNALS 7243D07 SHEET 3 DO NOT SCALE SHEET 6</p>
---	--

INTERMEDIATE RANGE



POWER RANGE

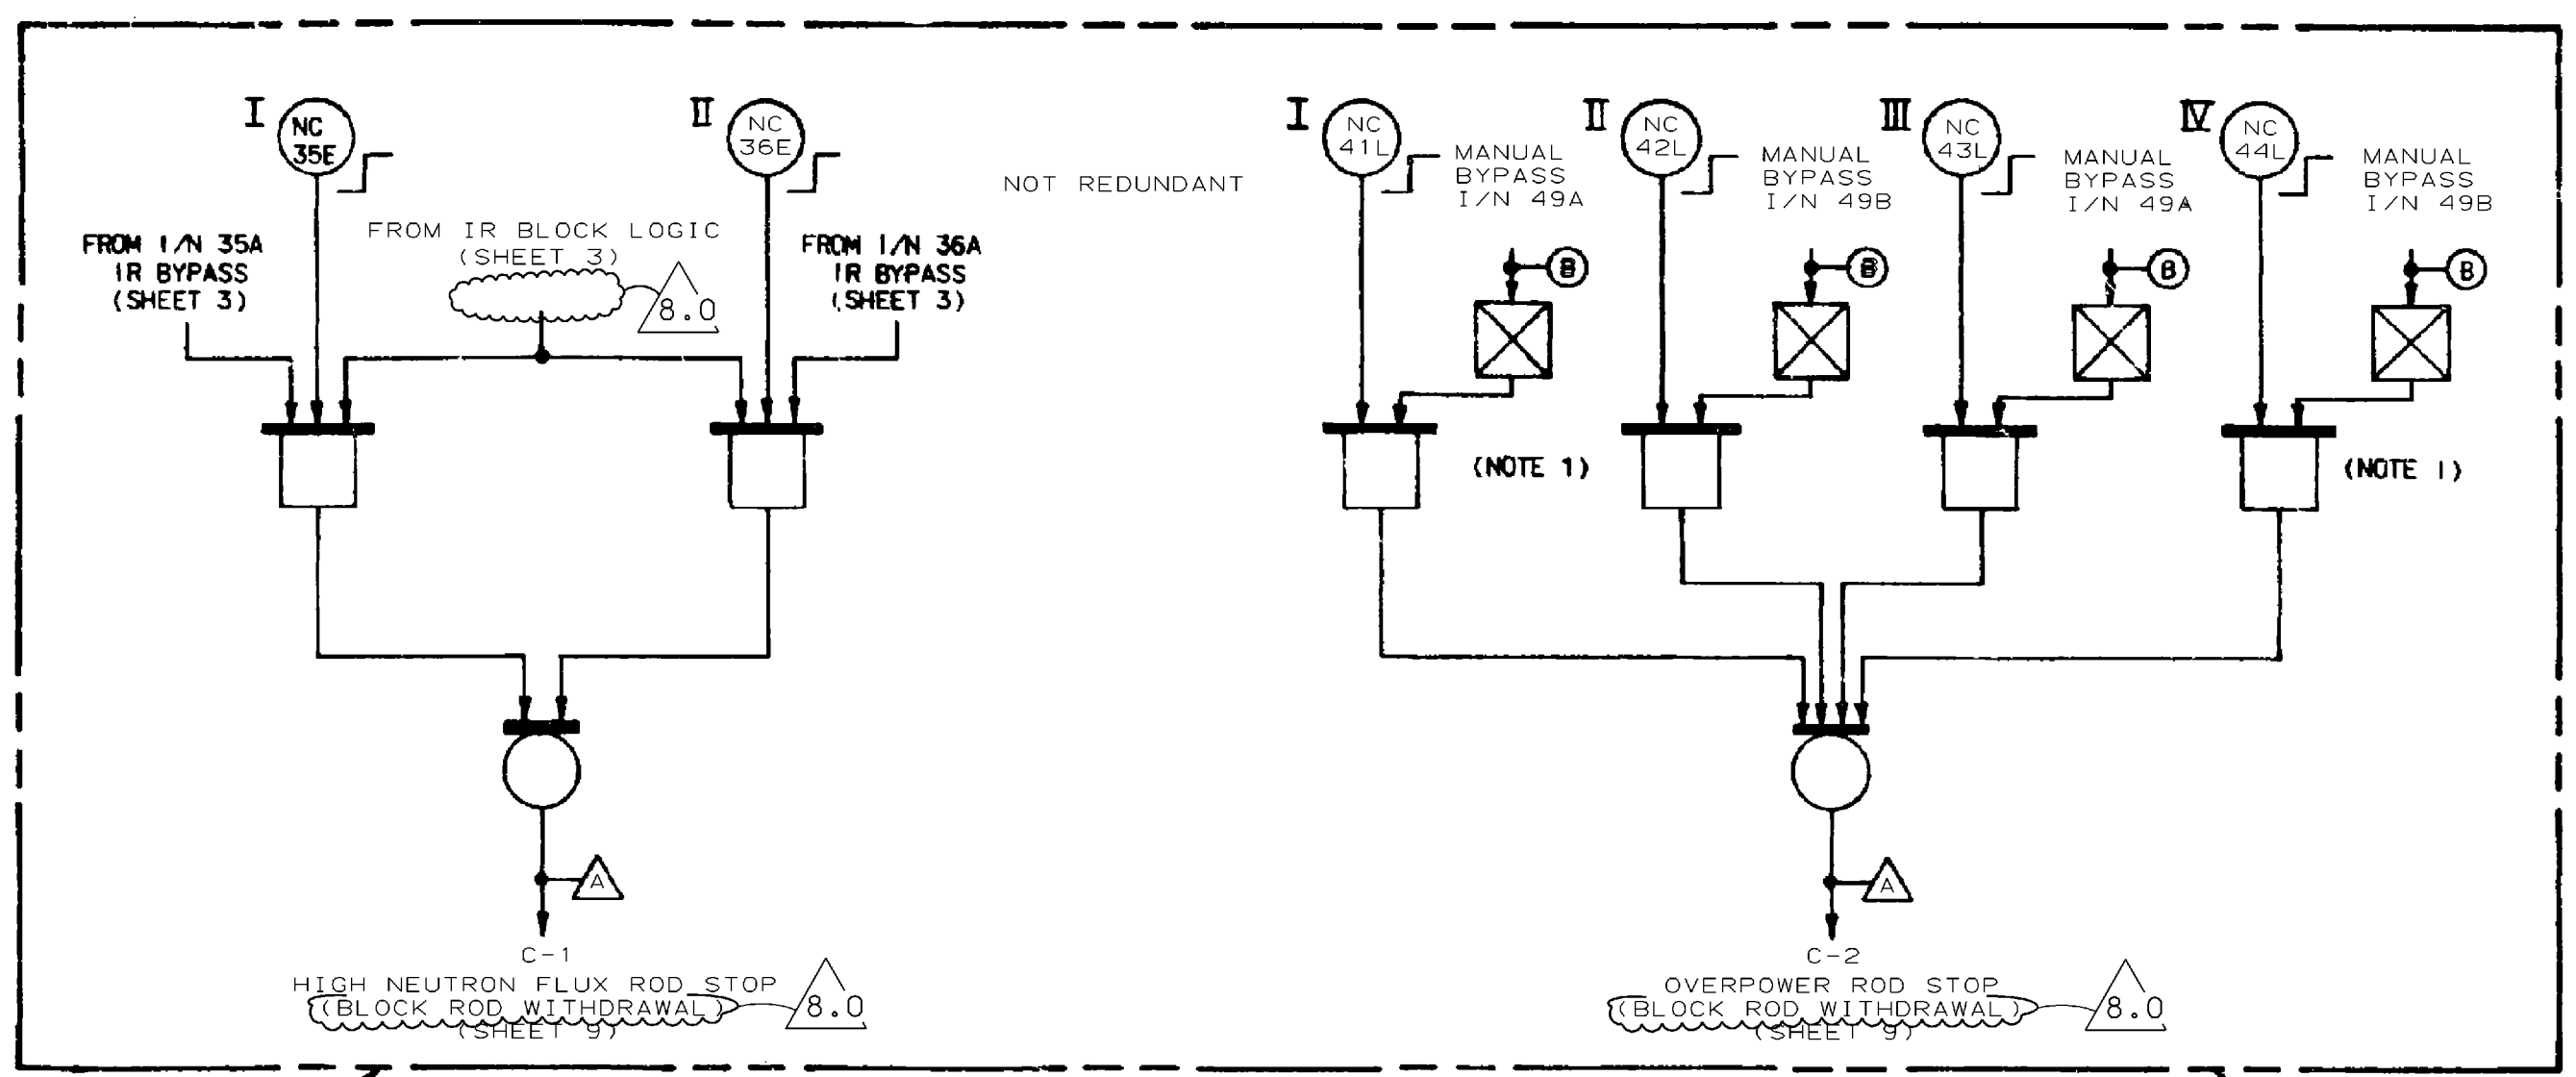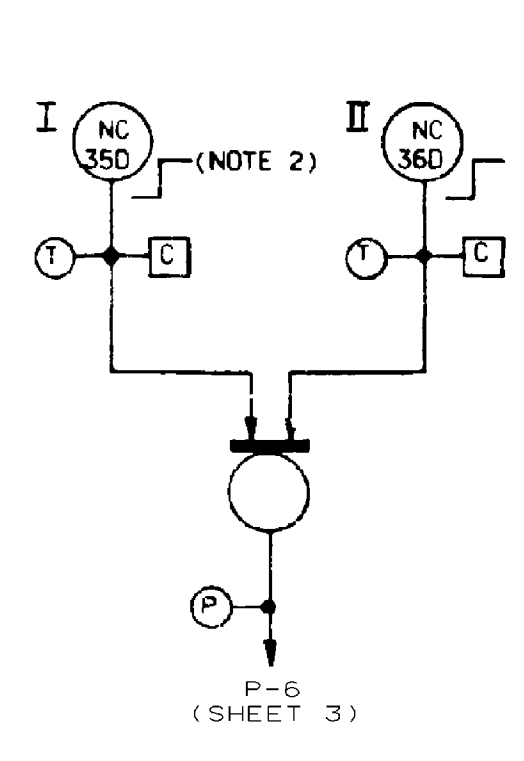

NOT REDUNDANT


NOT REDUNDANT

NOT REDUNDANT

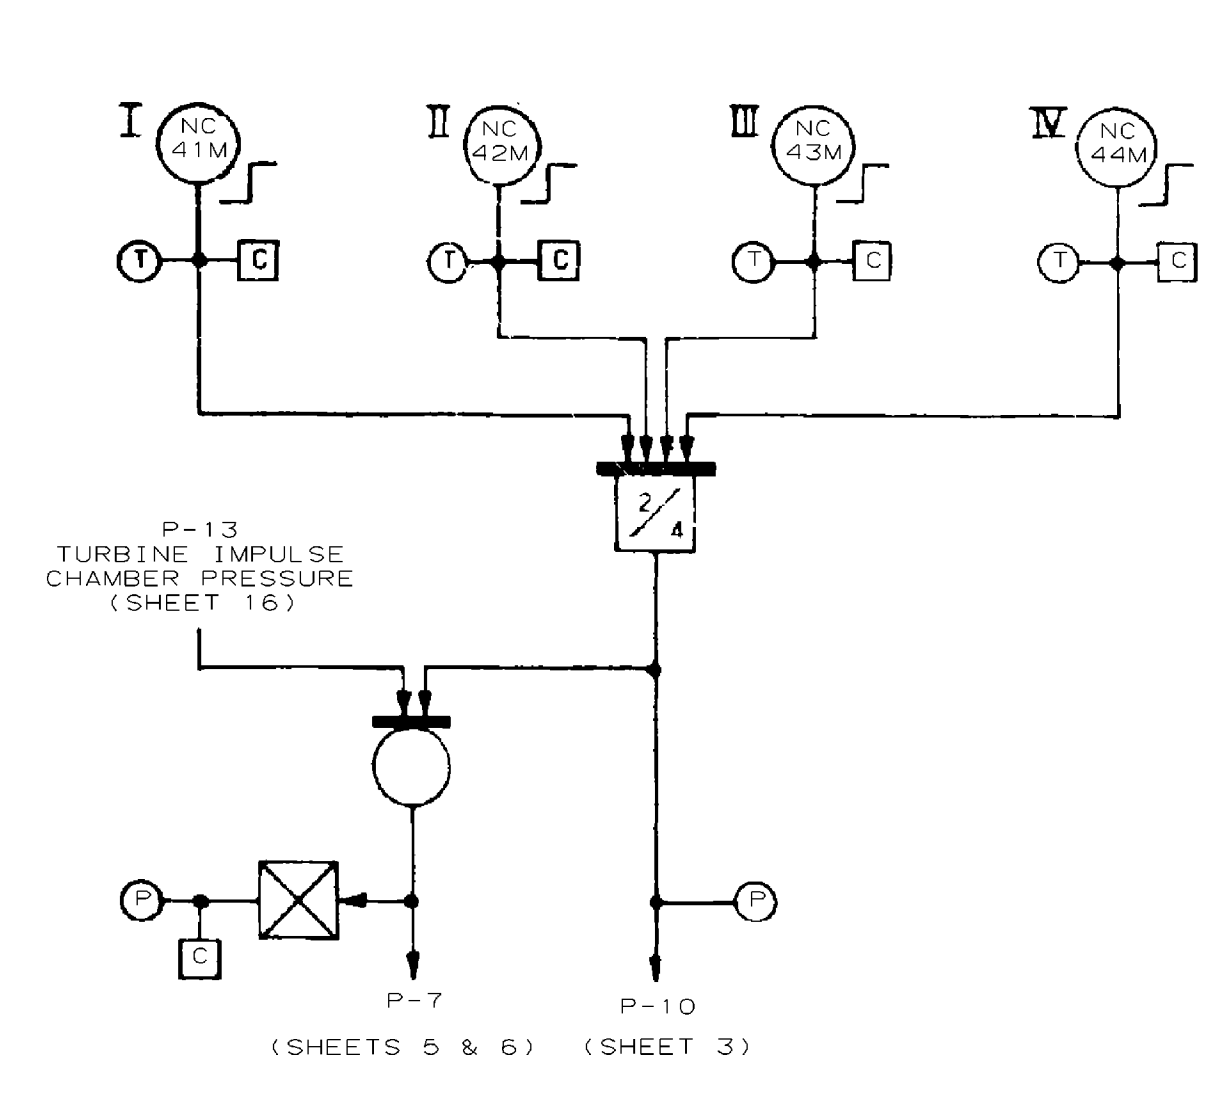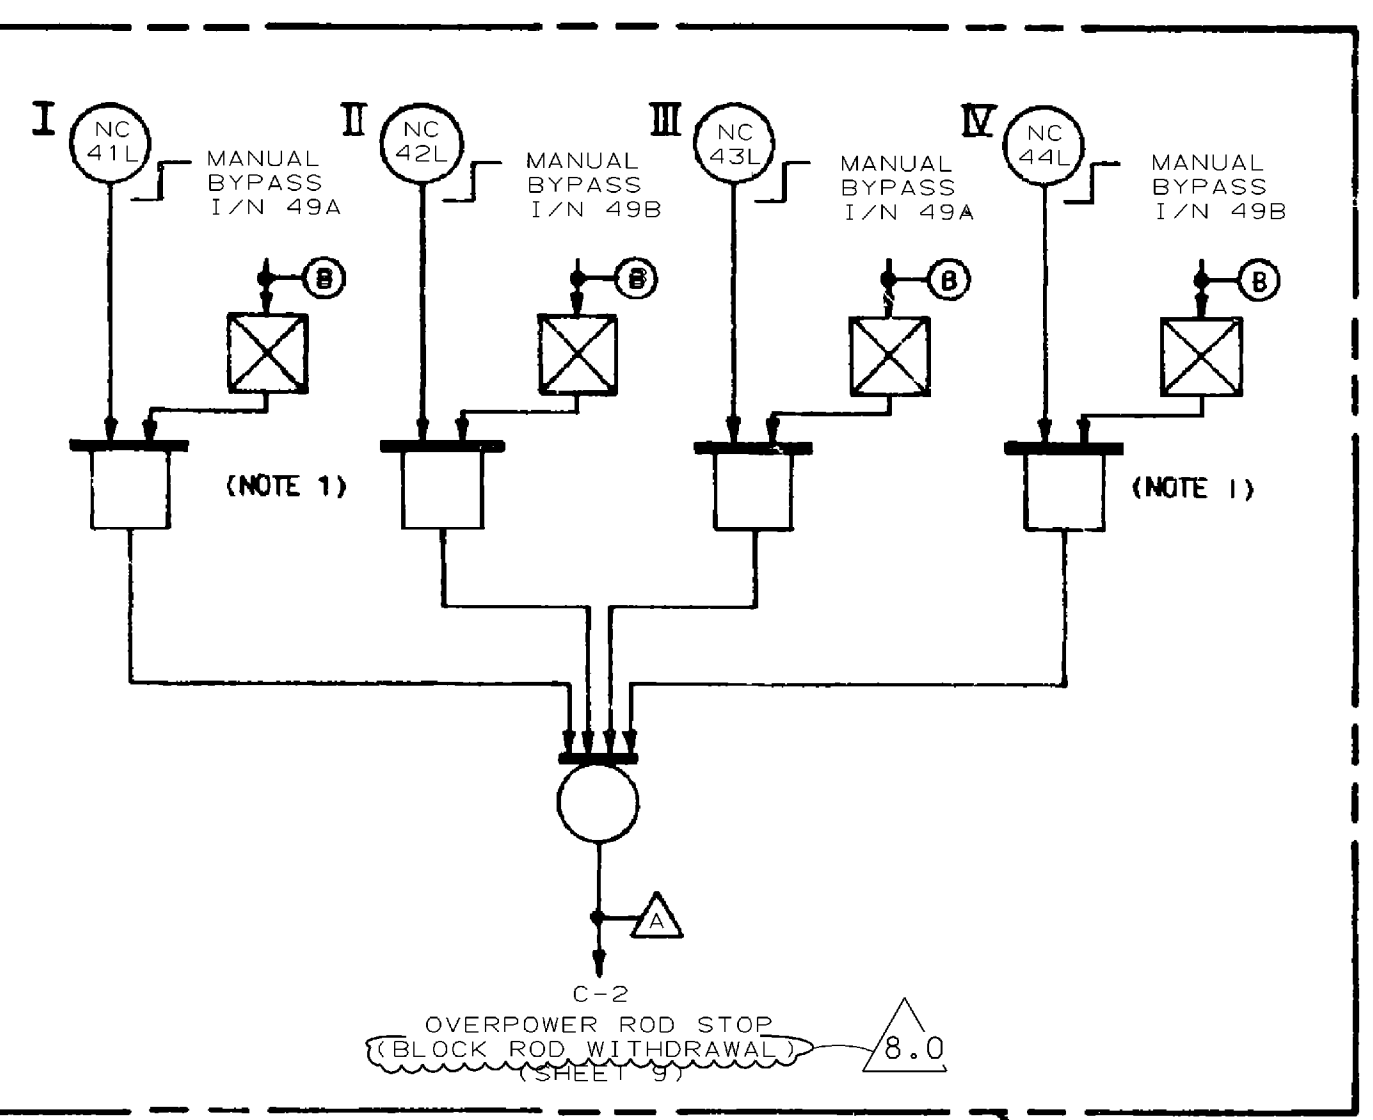


P-13  
TURBINE IMPULSE  
CHAMBER PRESSURE  
(SHEET 16)

P-7 (SHEETS 5 & 6) P-10 (SHEET 3)

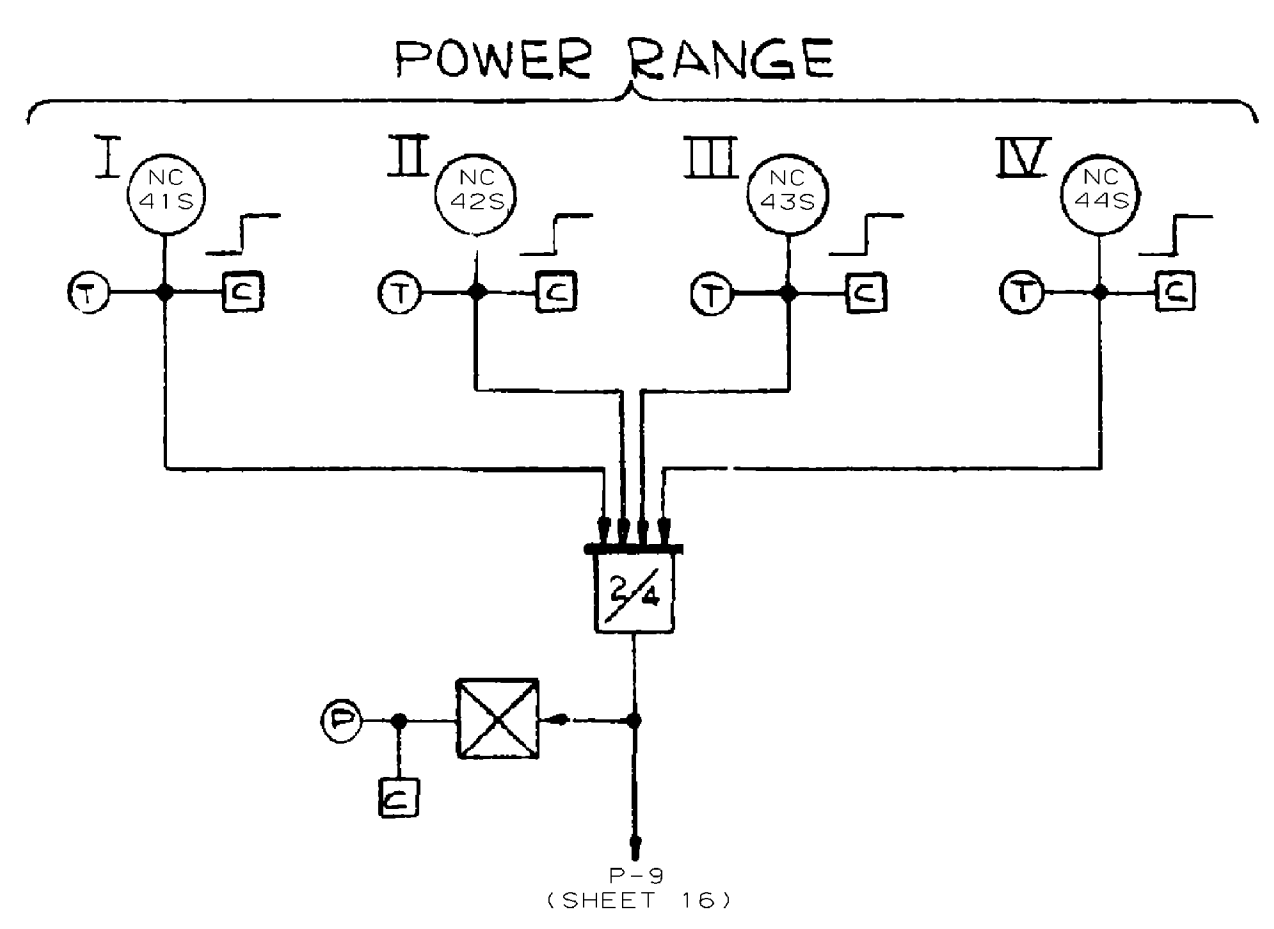

P-9 (SHEET 16)

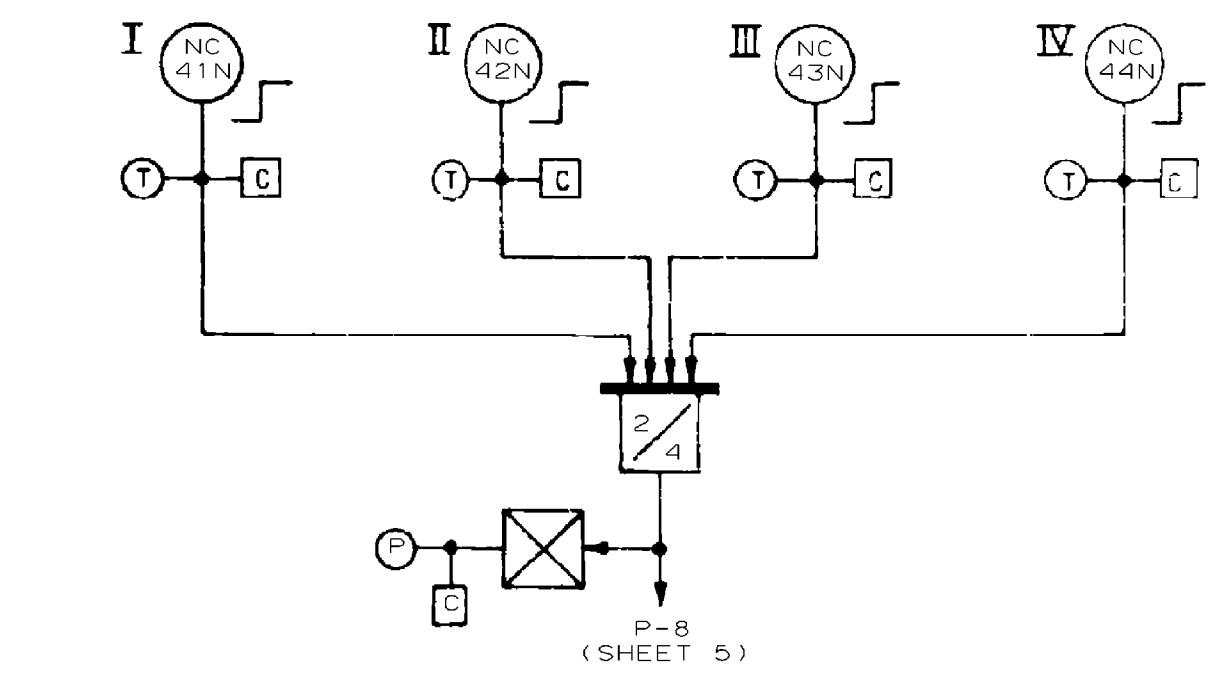

P-8 (SHEET 5)

NOTES:

- THE BYPASS SIGNALS ARE MADE UP BY MEANS OF TWO THREE-POSITION SWITCHES ON A NIS RACK. SWITCH I/N 49A BYPASSES EITHER NC-41L OR NC-43L. SWITCH I/N 49B BYPASSES EITHER NC-42L OR NC-44L.
- THE TWO P-6 BISTABLES NO. NC-35D AND NC-36D ARE "ENERGIZED TO ACTUATE" SUCH THAT A LOGIC 1 SIGNAL IS DEFINED TO BE PRESENT WHEN THE BISTABLE OUTPUT VOLTAGE IS ON.

8.0

NO. SAE/SBE-300	1
D 306526/306527	
CHANGE	
SAE/GBE-300	2
ECN-3124Z	
REV'S CIRCLED	
WEARS 7-13-76	
to file by the 7-27-76	
W. J. H. H.	
11-27-77	


DESIGNED BY	P. HEARN	DATE	11/04/09
CHK'D			
DES. ENG.			
MFG. ENG.			
APP. BY			
APP. DATE			
DVTG. SUPV.			
Westinghouse Electric Corporation		NUCLEAR ENERGY SYSTEMS, PITTSBURGH, PA., U.S.A.	
TITLE: GEORGIA POWER CO.		ALVIN W. VOGTLE UNITS 1 & 2	
FUNCTIONAL DIAGRAMS		NUCLEAR INSTR. PERMISSIVES & BLOCKS	
DRAWING NO.		7243D07	
SHEET - 4		SUB 2	
SCALE		DO NOT SCALE	
DIMENSIONS IN INCHES			

THIS DWG. IS REFERENCED IN VENDOR MANUAL:	N/A		
TAB/SECT.	N/A		
PAGE	N/A		
FIGURE	N/A		
VERSION	8.0		
DATE	11/04/09		
REVISED BY	SNC PER ABN-V01192, VER. 2.0.		
SEE MICROFILM FOR PREVIOUS REV. SIGNATURES.			
BY	CHK'D	APPR.1	APPR.2
CYN	RKF	PML	
VENDOR: WESTINGHOUSE		P.O. #:	
DRAWING NO. 1X6AA02-00228		SIZE D	

CAD MICROSTATION CYN 02 1X6AA02-00228.DGN

Southern Nuclear Operating Company, Inc.  
FOR  
VOGTLE ELECTRIC GENERATING PLANT  
UNIT NO. 1

TITLE:  
FUNCTIONAL DIAGRAMS  
NUCLEAR INSTRUMENT PERMISSIVES  
& BLOCKS

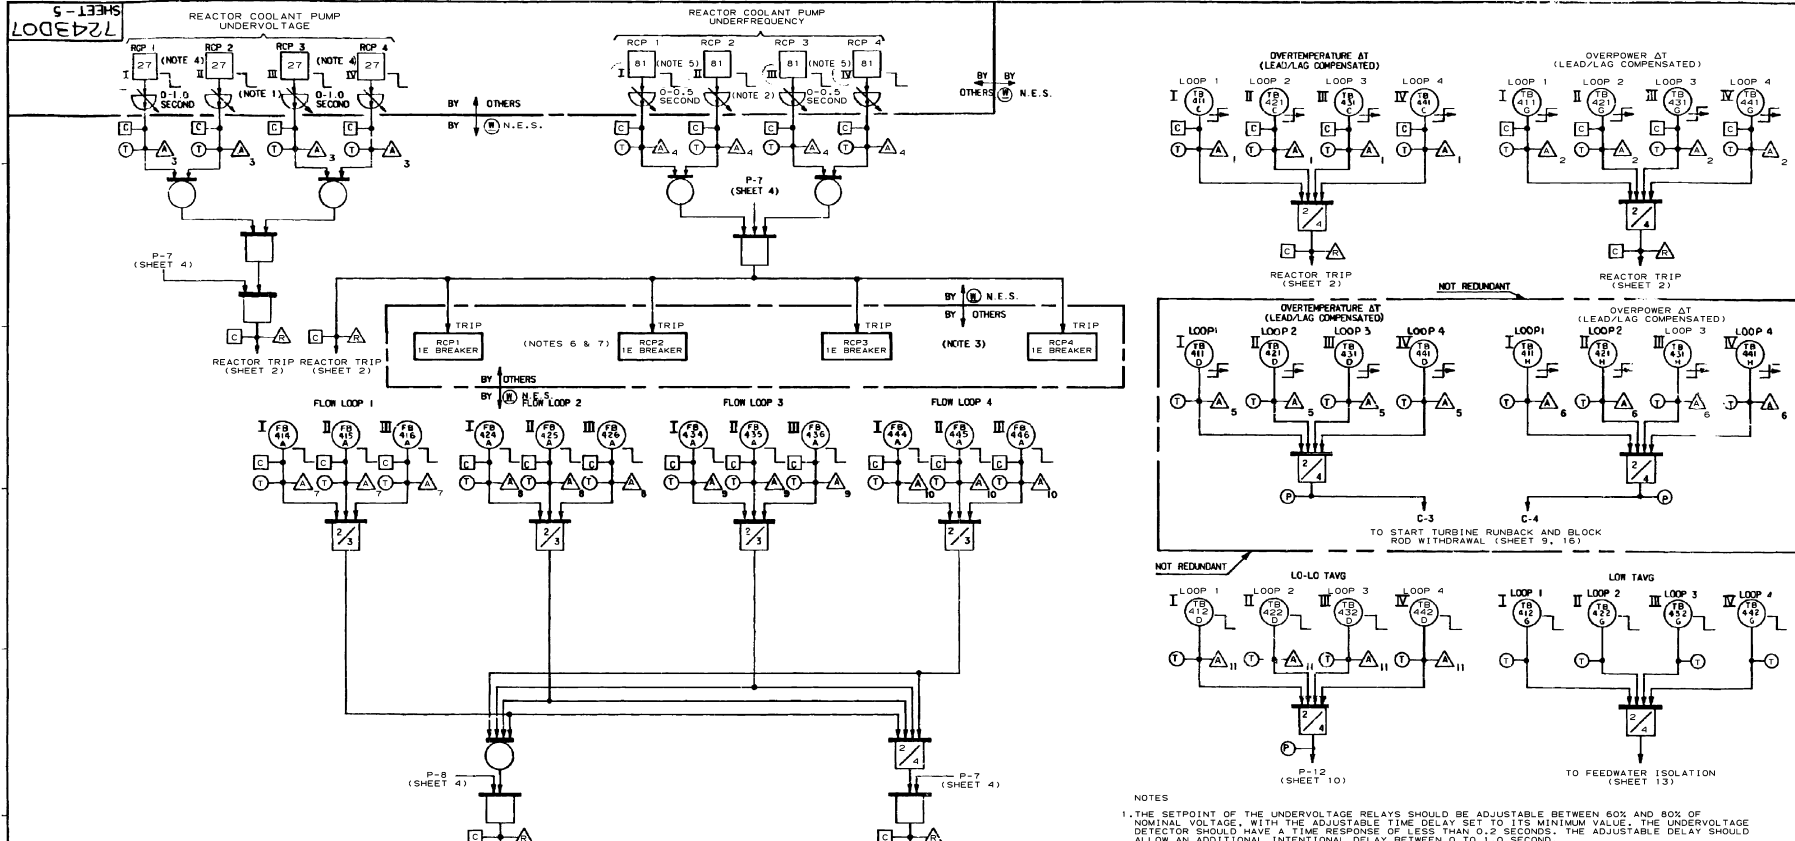


- NOTES
1. THE SETPOINT OF THE UNDERVOLTAGE RELAYS SHOULD BE ADJUSTABLE BETWEEN 80% AND 80% OF NOMINAL VOLTAGE, WITH THE ADJUSTABLE TIME DELAY SET TO ITS MINIMUM VALUE. THE UNDERVOLTAGE DETECTOR SHOULD HAVE A TIME RESPONSE OF LESS THAN 0.2 SECONDS. THE ADJUSTABLE DELAY SHOULD ALLOW AN ADDITIONAL INTENTIONAL DELAY BETWEEN 0 TO 1.0 SECOND.
  2. THE SETPOINT OF THE UNDERFREQUENCY RELAYS SHOULD BE ADJUSTABLE BETWEEN 54 HZ AND 59 HZ, WITH THE ADJUSTABLE TIME DELAY SET TO ITS MINIMUM VALUE. THE UNDERFREQUENCY DETECTOR SHOULD HAVE A TIME RESPONSE OF LESS THAN 0.1 SECONDS. THE ADJUSTABLE DELAY SHOULD ALLOW AN ADDITIONAL INTENTIONAL DELAY BETWEEN 0 TO 0.5 SECONDS.
  3. THE MAXIMUM ALLOWABLE RCP BREAKER TRIP TIME DELAY IS 0.1 SECONDS.
  4. THE UNDERVOLTAGE SENSORS (POTENTIAL TRANSFORMERS) MUST BE LOCATED ON THE MOTOR SIDE OF THE RCP CIRCUIT BREAKERS TO DETECT THE TRIP OF THE RCP CIRCUIT BREAKERS IN ADDITION TO BUS UNDERVOLTAGE.
  5. THE UNDERFREQUENCY SENSORS MAY BE LOCATED ON THE MOTOR SIDE OF THE RCP CIRCUIT BREAKERS.
  6. REACTOR COOLANT PUMPS NUMBER 1 AND 3 MUST BE ON BUS INAA. REACTOR COOLANT PUMPS NUMBER 2 AND 4 MUST BE ON BUS INAB.
  7. REFER TO BECHTEL DRAWING SK-3-619 FOR DETAILED LOGIC FOR RCP BREAKERS.

DATE: 08-30-00	BY: J. W. HARRIS	CHK: J. W. HARRIS
DESIGN: J. W. HARRIS	CHK: J. W. HARRIS	APP: J. W. HARRIS
REVISION: 1	DATE: 08-30-00	BY: J. W. HARRIS
REVISION: 2	DATE: 09-17-01	BY: J. W. HARRIS
REVISION: 3	DATE: 09-17-01	BY: J. W. HARRIS
REVISION: 4	DATE: 09-17-01	BY: J. W. HARRIS
REVISION: 5	DATE: 09-17-01	BY: J. W. HARRIS
REVISION: 6	DATE: 09-17-01	BY: J. W. HARRIS
REVISION: 7	DATE: 09-17-01	BY: J. W. HARRIS
REVISION: 8	DATE: 09-17-01	BY: J. W. HARRIS
REVISION: 9	DATE: 09-17-01	BY: J. W. HARRIS
REVISION: 10	DATE: 09-17-01	BY: J. W. HARRIS
REVISION: 11	DATE: 09-17-01	BY: J. W. HARRIS
REVISION: 12	DATE: 09-17-01	BY: J. W. HARRIS
REVISION: 13	DATE: 09-17-01	BY: J. W. HARRIS
REVISION: 14	DATE: 09-17-01	BY: J. W. HARRIS
REVISION: 15	DATE: 09-17-01	BY: J. W. HARRIS

Westinghouse Electric Corporation  
 NUCLEAR ENERGY SYSTEMS, PITTSBURGH, PA., U.S.A.  
 TITLE: GEORGIA POWER CO.  
 ALVIN W. VOGTLE UNITS (1 & 2)  
 FUNCTIONAL DIAGRAMS  
 PRIMARY COOLANT SYSTEM TRIP SIGNALS  
 SCALE: AS SHOWN  
 SHEET 5 OF 5  
 DRAWING NO. 1X6AA02-00229

THIS DWG. IS REFERENCED IN VENDOR MANUAL:	N/A
TAB/SECT.	N/A
PAGE	N/A
FIGURE	N/A
VERSION 11.0	DATE 3-4-11
REVISED BY SNC PER ABN-V02456, VER. 1.0	TITLE: FUNCTIONAL DIAGRAMS PRIMARY COOLANT SYSTEM TRIP SIGNALS
BY: LPM	CHK: MLH
APPR. 1: AAN	APPR. 2: X
VENDOR: WESTINGHOUSE	P.O.#:
DRAWING NO. 1X6AA02-00229	SIZE D

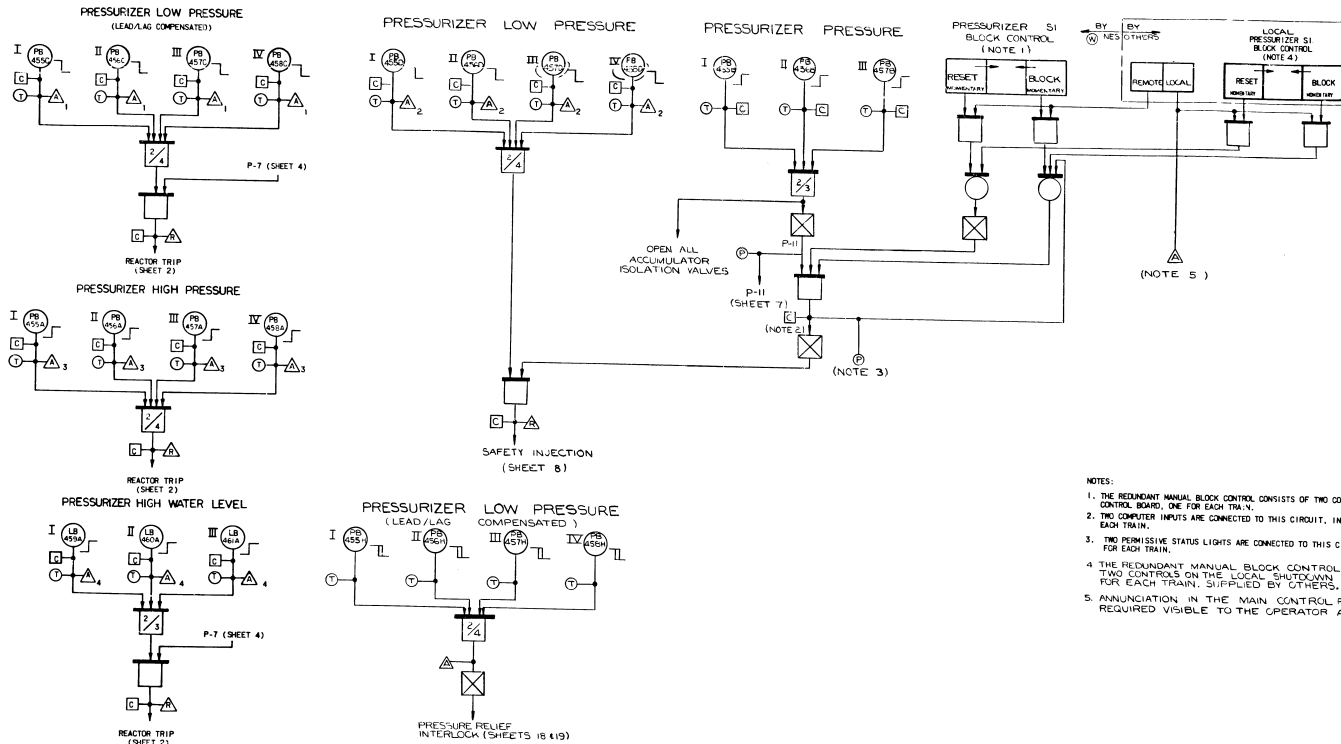


- NOTES:
1. THE REDUNDANT MANUAL BLOCK CONTROL CONSISTS OF TWO CONTROLS ON THE CONTROL BOARD, ONE FOR EACH TRAIN.
  2. TWO COMPUTER INPUTS ARE CONNECTED TO THIS CIRCUIT, INDIVIDUAL FOR EACH TRAIN.
  3. TWO PERMISSIVE STATUS LIGHTS ARE CONNECTED TO THIS CIRCUIT, INDIVIDUAL FOR EACH TRAIN.
  4. THE REDUNDANT MANUAL BLOCK CONTROL CONSISTS OF TWO CONTROLS ON THE LOCAL SHUTDOWN PANEL, ONE FOR EACH TRAIN, SUPPLIED BY OTHERS.
  5. ANNUNCIATION IN THE MAIN CONTROL ROOM IS REQUIRED VISIBLE TO THE OPERATOR AT MCB.

11	10	9	8	7	6	5	4	3	2	1
GEORGIA POWER COMPANY PLANT: ALVIN W. VOGTLE NUCLEAR PLANT UNITS: 1 & 2 SYSTEM: SAFETY STATUS: APPROVED CERTIFICATION LTR. NO. GP-9146 AUTHORITY: J. L. VOTA ENGR. LTR. NO. EP/SA-L7348										

DESIGNED BY	DATE	SCALE	BY
BY P. HEARN	7/2	AS SHOWN	BY P. HEARN
CHECKED BY	DATE	SCALE	BY
BY J. L. VOTA	7/2	AS SHOWN	BY J. L. VOTA
WESTINGHOUSE ELECTRIC CORPORATION NUCLEAR ENERGY SYSTEMS DIVISION, P.O. BOX 318 PITTSBURGH, PA. 15230 TITLE: GEORGIA POWER CO. ALVIN W. VOGTLE UNITS 1 & 2 FUNCTIONAL DIAGRAMS PRESSURIZER TRIP SIGNALS SHEET - 6 7243D07			

VOGTLE ELECTRIC GENERATING PLANT		JOB NO. 9510
EQUIPMENT TAG NO. <i>V-1000</i>		
STARTUP DESIGNATION NO. <i>Various</i>		
ACTIVITY NO. <i>Various</i>		
SYSTEM NO. <i>Various</i>		
CATEGORY NO. <i>100</i>		
RETOFITTING REQUIRED <input type="checkbox"/> YES <input checked="" type="checkbox"/> NO		
DISTRIBUTION TO: FOR REVIEW INFO		
<input type="checkbox"/> MECHANICAL	<input type="checkbox"/>	<input type="checkbox"/>
<input type="checkbox"/> HVAC	<input type="checkbox"/>	<input type="checkbox"/>
<input type="checkbox"/> NSSS	<input type="checkbox"/>	<input type="checkbox"/>
<input type="checkbox"/> BOP	<input type="checkbox"/>	<input type="checkbox"/>
<input type="checkbox"/> CONTROL SYSTEMS	<input checked="" type="checkbox"/>	<input type="checkbox"/>
<input type="checkbox"/> ELECTRICAL	<input checked="" type="checkbox"/>	<input type="checkbox"/>
<input type="checkbox"/> WIRING	<input type="checkbox"/>	<input type="checkbox"/>
<input type="checkbox"/> CONDUIT	<input type="checkbox"/>	<input type="checkbox"/>
<input type="checkbox"/> HAZARDS	<input type="checkbox"/>	<input type="checkbox"/>
<input type="checkbox"/> CIVIL/STRUCTURAL	<input type="checkbox"/>	<input type="checkbox"/>
<input type="checkbox"/> NUCLEAR	<input type="checkbox"/>	<input type="checkbox"/>
<input type="checkbox"/> STRESS/PLANT DESIGN	<input type="checkbox"/>	<input type="checkbox"/>
<input type="checkbox"/> CODES AND STANDARDS	<input type="checkbox"/>	<input type="checkbox"/>
<input type="checkbox"/> ARCHITECTURAL	<input type="checkbox"/>	<input type="checkbox"/>
<input type="checkbox"/> STARTUP	<input type="checkbox"/>	<input type="checkbox"/>
<input type="checkbox"/> CONSTRUCTION	<input type="checkbox"/>	<input type="checkbox"/>
<input type="checkbox"/> NOT REQ'D BY ENGRG.	<input type="checkbox"/>	<input type="checkbox"/>
<input type="checkbox"/> CLIENT	<input type="checkbox"/>	<input type="checkbox"/>
<input type="checkbox"/> EQUIP. QUALIFICATION	<input type="checkbox"/>	<input type="checkbox"/>
<input type="checkbox"/> M & OS	<input type="checkbox"/>	<input type="checkbox"/>
<input type="checkbox"/> WESTINGHOUSE	<input type="checkbox"/>	<input type="checkbox"/>
IDENTIFYING TITLE OF THIS DOCUMENT: <i>Functional Diag.</i>		
Bechtel Log No. <i>KA002-230-8</i>		
IMPORTANT Permission to proceed does not constitute acceptance or approval of design details, calculations, analyses, test methods or materials developed or selected by the supplier and does not relieve supplier from full compliance with contractual obligations.		
DATE RECEIVED <i>2-14-85</i>	SIGNED <i>[Signature]</i>	DATE <i>5/2/85</i>
DOCUMENT STATUS <input checked="" type="checkbox"/> WORK MAY PROCEED <input type="checkbox"/> CHANGE AND RESUBMIT WORK MAY PROCEED SUBJECT TO MODIFICATION OF CHANGES INDICATED <input type="checkbox"/> REVISION AND RESUBMIT WORK MAY NOT PROCEED <input type="checkbox"/> INFORMATION ONLY - DISTRIBUTION RESTRICTED <input type="checkbox"/> RESUBMIT - NOT ACCEPTABLE FOR MICROFILM, WHICH MAY PROCEED		

I CERTIFY THAT THE DRAWING CONTAINED ON THIS FRAME WAS MADE IN THE NORMAL AND REGULAR COURSE OF BUSINESS AT BIRMINGHAM, ALABAMA, AND THAT IT IS AN ACCURATE REPRODUCTION OF THE DOCUMENT SUBMITTED TO MICROGRAPHICS.  
 104188 DATE  
 Frank R. Poff  
 CAMERA OPERATOR  
 4/26/68  
 SECTION SUPERVISOR

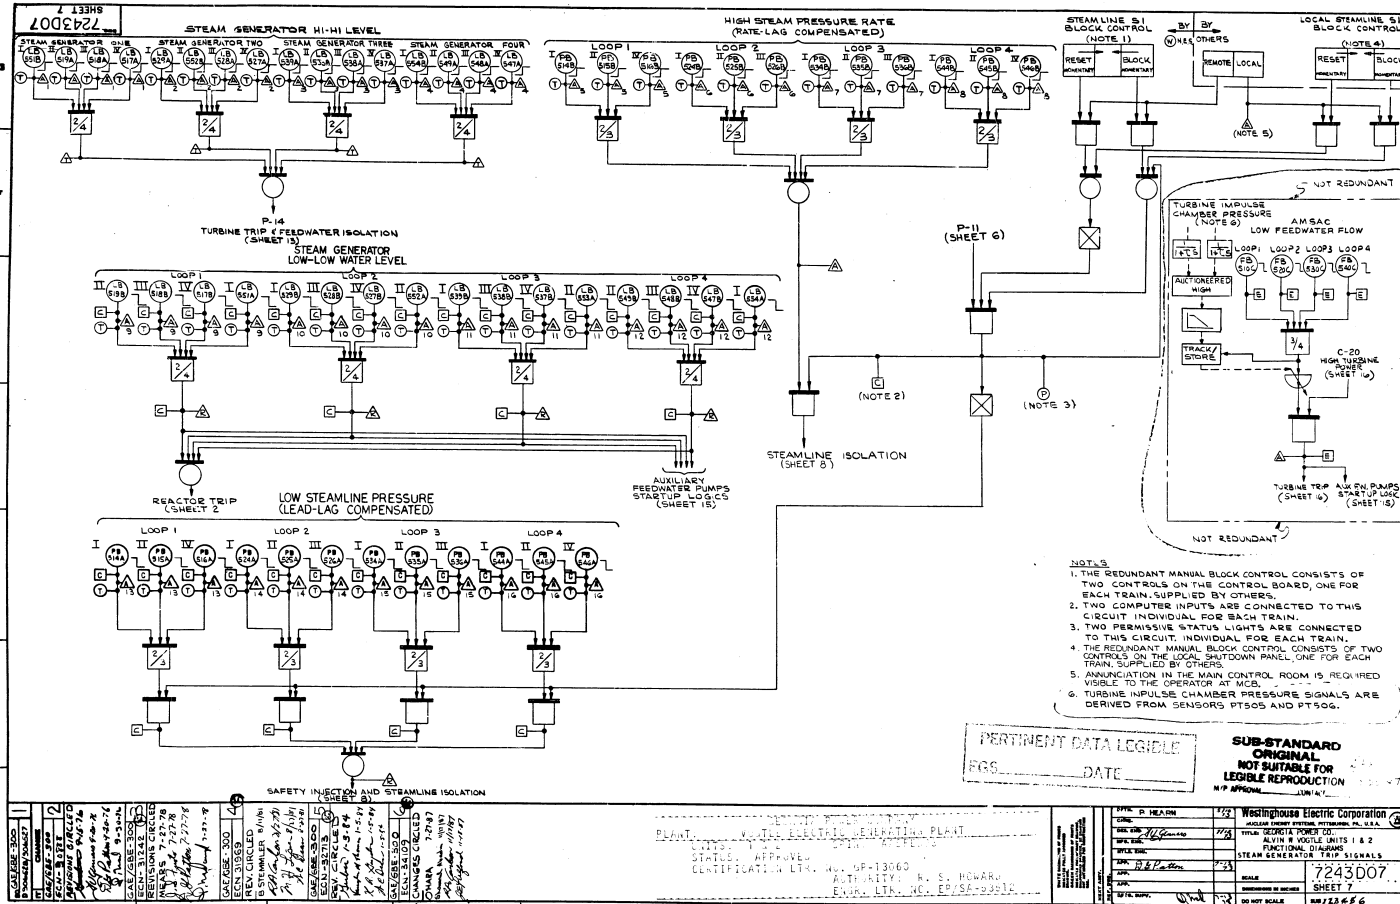

- NOTES
1. THE REDUNDANT MANUAL BLOCK CONTROL CONSISTS OF TWO CONTROLS ON THE CONTROL BOARD, ONE FOR EACH TRAIN, SUPPLIED BY OTHERS.
  2. TWO COMPUTER INPUTS ARE CONNECTED TO THIS CIRCUIT, INDIVIDUAL FOR EACH TRAIN.
  3. TWO PERSISIVE STATUS LIGHTS ARE CONNECTED TO THIS CIRCUIT, INDIVIDUAL FOR EACH TRAIN.
  4. THE REDUNDANT MANUAL BLOCK CONTROL CONSISTS OF TWO CONTROLS ON THE LOCAL SHUTDOWN PANEL, ONE FOR EACH TRAIN, SUPPLIED BY OTHERS.
  5. ANNUNCIATION IN THE MAIN CONTROL ROOM IS REQUIRED VISIBLE TO THE OPERATOR AT MCB.
  6. TURBINE IMPULSE CHAMBER PRESSURE SIGNALS ARE DERIVED FROM SENSORS PT505 AND PT506.


PERTINENT DATA LEGIBLE  
 FOR \_\_\_\_\_ DATE \_\_\_\_\_

**SUB-STANDARD ORIGINAL**  
 NOT SUITABLE FOR LEGIBLE REPRODUCTION  
 W.P. APPROVAL: \_\_\_\_\_

RECHECK NOTE (APPLICABLE TO UNIT 1 ONLY):  
 THIS DRAWING DESCRIBES PHYSICAL WORK TO BE ACCOMPLISHED BY THE CONTRACTOR. THE DRAWING IS TO BE USED IN CONJUNCTION WITH THE REFERENCED DOCUMENT. THE WORK IS TO BE IMPLEMENTED BY PROJECT DOCUMENT O.C.P. 5-11-68.

VOGTLE ELECTRIC GENERATING PLANT		JOB NO. 8510
EQUIPMENT TAG NO. 7243007		
STARTUP DESIGNATION NO. 600		
ACTIVITY NO. 600		
SYSTEM NO. 600		
CATEGORY NO. 600		
RETOFITTING REQUIRED <input type="checkbox"/> YES <input checked="" type="checkbox"/> NO		
DISTRIBUTION TO: FOR: REVIEW INFO		
<ul style="list-style-type: none"> <li>MECHANICAL</li> <li>HVAC</li> <li>EQUIPMENT</li> <li>PROCESS</li> <li>CONTROL SYSTEMS 50, 80</li> <li>ELECTRICAL 10, 20</li> <li>WIRING</li> <li>CONDUIT</li> <li>HAZARDS</li> <li>CIVIL/STRUCTURAL</li> <li>NUCLEAR 60, 80</li> <li>STRESS/PLANT DESIGN</li> <li>CODES AND STANDARDS</li> <li>ARCHITECTURAL</li> <li>STARTUP</li> <li>CONSTRUCTION</li> <li>NOT REQ'D BY ENGRG.</li> <li>CLIENT</li> <li>EQUIP. QUALIFICATION</li> <li>M &amp; OS</li> <li>WESTINGHOUSE</li> </ul>		
IDENTIFYING TITLE OF THIS DOCUMENT Feedwater Control System		
Recheck Log No. 7243007-231-6		
<b>IMPORTANT</b> Permission to proceed does not constitute acceptance or approval of design details, calculations, analyses, test methods or materials developed or selected by the supplier and does not relieve supplier from full compliance with contractual obligations.		
DATE RECEIVED 2-9-87	SIGNED	
DOCUMENT STATUS	WORK MAY PROCEED	DATE 12-27-97
1. REVIEW AND RECOMMEND	2. REVIEW AND RECOMMEND	3. REVIEW AND RECOMMEND
4. INFORMATION ONLY	5. INFORMATION ONLY	6. INFORMATION ONLY
7. DISTRIBUTION REQUIRED	8. DISTRIBUTION REQUIRED	9. DISTRIBUTION REQUIRED
10. REQUISITE - NOT ACCEPTABLE FOR MICROFILM, WORK MAY PROCEED		
PP-5997 (10/1) 12/82		

16X

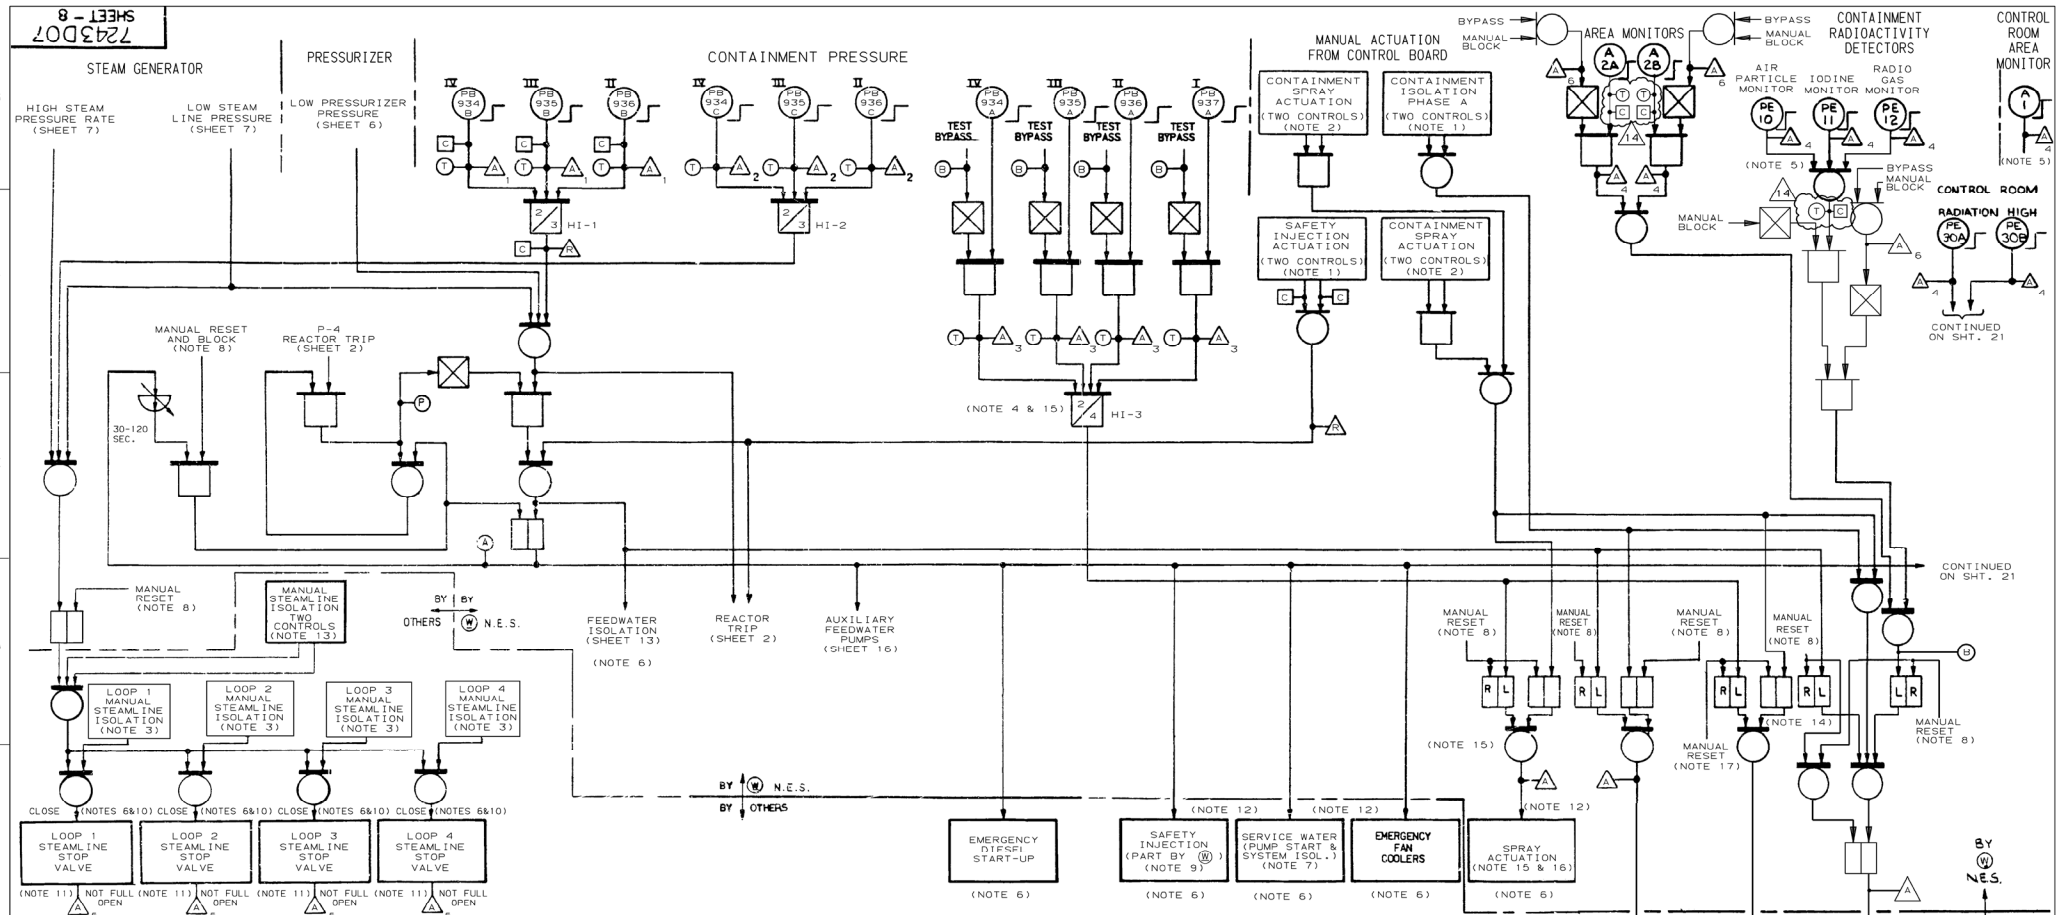

- NOTES:
1. TWO MOMENTARY CONTROLS ON THE CONTROL BOARD, OPERATING EITHER CONTROL WILL ACTUATE.
  2. THE MANUAL SPRAY ACTUATION CONSISTS OF FOUR MOMENTARY CONTROLS. ACTUATION WILL OCCUR ONLY IF TWO ASSOCIATED CONTROLS ARE OPERATED SIMULTANEOUSLY.
  3. ONE CONTROL PER LOOP ON THE CONTROL BOARD.
  4. CONTAINMENT PRESSURE BISTABLES FOR SPRAY ACTUATION ARE ENERGIZE-TO-ACTUATE (OTHER BISTABLES ARE DE-ENERGIZE-TO-ACTUATE).
  5. CIRCUITRY IS NOT PART OF THE SAFEGUARDS SYSTEM, AND IS NOT SAFETY RELATED, HOWEVER, CIRCUITRY IS INPUT TO THE SAFEGUARDS SYSTEM THEREFORE ISOLATION MUST BE PROVIDED.
  6. COMPONENTS ARE ALL INDIVIDUALLY SEALED IN (LATCHED), SO THAT LOSS OF THE ACTUATION SIGNAL WILL NOT CAUSE THESE COMPONENTS TO RETURN TO THE CONDITION HELD PRIOR TO THE ADVENT OF THE ACTUATION SIGNAL.
  7. SERVICE WATER SYSTEM ISOLATION IS USED ONLY IF REQUIRED.
  8. THE REDUNDANT MANUAL RESET CONSISTS OF TWO MOMENTARY CONTROLS ON THE CONTROL BOARD, ONE FOR EACH TRAIN.
  9. SAFETY INJECTION SEQUENCE REQUIREMENTS (IF SEQUENCING IS NECESSARY) ARE SPECIFIED BY (N) NUCLEAR ENERGY SYSTEMS.

10. ALSO CLOSES THE BYPASS VALVE IN PARALLEL WITH THE ASSOCIATED STEAM LINE STOP VALVE.
11. LIGHTS SHOULD BE PROVIDED IN THE CONTROL ROOM FOR EACH STEAM LINE STOP VALVE TO INDICATE WHEN THE VALVE IS FULLY CLOSED OR FULLY OPEN.
12. THE ACTUATION MAY BE DELAYED AND SEQUENCED IF THE EMERGENCY DIESEL POWER CAPABILITY IS LESS THAN THE TOTAL LOAD WITH ALL SYSTEMS STARTING. THE TIME DELAYS, IF USED, MAY NOT EXCEED THE MAXIMUM STARTING TIME REQUIREMENTS FOR EACH SYSTEM.
13. TWO CONTROLS ON THE CONTROL BOARD, OPERATING EITHER CONTROL WILL ACTUATE.
14. SOME ENGINEERED SAFEGUARDS FUNCTIONS ARE NOT WITHIN THE FUNCTIONAL DESIGN SCOPE OF (N) NUCLEAR ENERGY SYSTEMS BUT ONLY SHOWN ON THIS SHEET AS THE FUNCTIONS ARE BUILT IN THE (N) SUPPLIED EQUIPMENT.
15. THE 2 OUT OF 4 COINCIDENCE, MEMORY, AND (N) LOGIC ARE DUPLICATED WITHIN EACH TRAIN. SEPARATE OUTPUT RELAYS ARE ALSO PROVIDED IN EACH TRAIN. TO MINIMIZE FALSE CONTAINMENT SPRAY ONE OUTPUT RELAY SHOULD START THE PUMPS WHILE ANOTHER SHOULD OPEN THE SYSTEM VALVES.
16. THE SEQUENCE TO LOAD THE CONTAINMENT SPRAY SYSTEM ON THE EMERGENCY DIESEL POWER SHOULD BE INDEPENDENT OF THE SEQUENCE TO LOAD THE SAFETY INJECTION SYSTEM. IF THE CONDITIONS OF NOTE 12 APPLY THE SEQUENCE INTERLOCK SHOULD BE SUCH THAT SPRAY WILL START WITHIN THE REQUIRED TIME INDEPENDENT OF THE SAFETY INJECTION SIGNAL STATUS.

17. CONTAINMENT ISOLATION PHASE B IS NOT USED. THE INITIATION LOGIC AND MANUAL RESET ACTION FOR CONTAINMENT ISOLATION PHASE B SHOWN ON THIS SHEET IS FOR INFORMATION ONLY.

NO.	REVISIONS	DATE	DR	CHK	APPV
14	INCORPORATED PER DCP 97-V100087	11-16-00	ELC	TSL	GLB
SCS REVISIONS					


DOCUMENT STATUS CODE 1

1X6AA02-00232-17

**WESTINGHOUSE PROPRIETARY DATA**

THIS DOCUMENT CONTAINS PROPRIETARY INFORMATION OF THE WESTINGHOUSE ELECTRIC CORPORATION WATER REACTOR DIVISIONS. IT IS TRANSMITTED TO YOU IN CONFIDENCE AND TRUST, AND IS TO BE RETURNED UPON REQUEST. ITS CONTENTS MAY NOT BE DISCLOSED IN WHOLE OR IN PART TO OTHERS OR USED FOR OTHER THAN THE PURPOSE FOR WHICH TRANSMITTED WITHOUT THE PRIOR WRITTEN PERMISSION OF THE WESTINGHOUSE WATER REACTOR DIVISIONS.

<p>WESTINGHOUSE PROPRIETARY DATA</p> <p>DATE: 11-16-00</p> <p>BY: ELC</p> <p>APPV: TSL</p> <p>SCALE: AS SHOWN</p> <p>DO NOT SCALE</p>	<p>WESTINGHOUSE ELECTRIC CORPORATION</p> <p>NUCLEAR ENERGY SYSTEMS DIVISION, P.O. BOX 217, PITTSBURGH, PA. U.S.A.</p> <p>TITLE: GEORGIA POWER CO. ALVIN W. VOGTLE UNITS 1 &amp; 2</p> <p>FUNCTIONAL DIAGRAM SAFEGUARD ACTUATION SYSTEM</p> <p>7243D07</p> <p>SHEET - 8</p> <p>SUB 13</p>
---	--

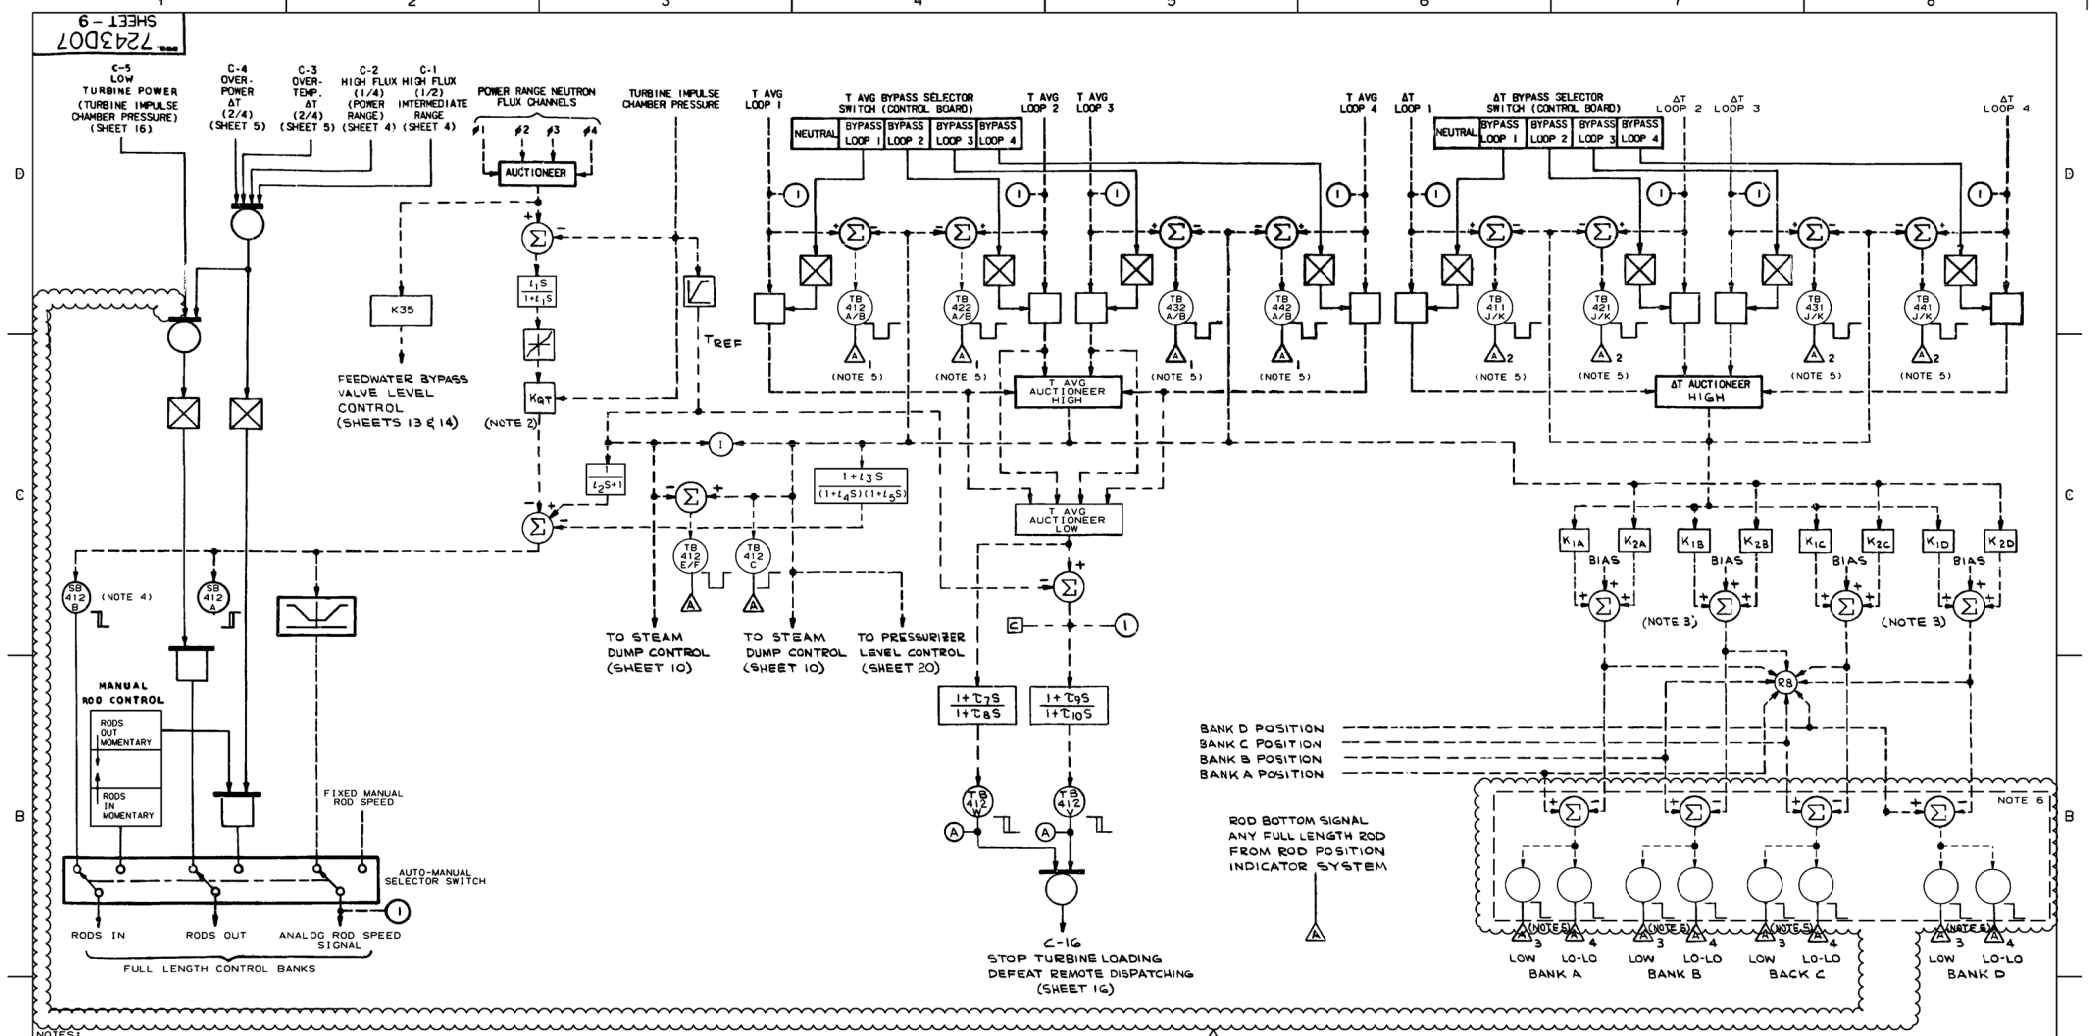


- NOTES:**
1. ALL CIRCUITS ON THIS SHEET ARE NOT REDUNDANT.
  2. KOT MAY VARY INVERSELY PROPORTIONAL TO LOAD WITH A FIXED LIMIT OR MAY VARY IN TWO DISCRETE STEPS WITH BREAK POINTS AT 30 TO 50% AND 80 TO 90% TURBINE LOAD.
  3. THE SUMMER OUTPUTS HAVE FIXED MANUALLY ADJUSTABLE UPPER LIMITS.
  4. THE ROD DIRECTION BISTABLES NO. SB-412A AND SB-412B ARE "ENERGIZED TO ACTUATE". SB-412A (RODS OUT) OUTPUT IS NOT USED.
  5. ALARM 1, ALARM 2, ALARM 3 AND ALARM 4 MUST HAVE REFLASH CAPABILITY.
  6. COMPUTER ALGORITHM IS USED FOR COMPARATOR NETWORK.

NO.	DATE	BY	CHK'D	APP'R.	REVISION
1	7-18-74	R. HEARN			DESIGN
2	7-24-78	S. HOLLERAN			REVISION CIRCLED
3	7-27-78	S. HOLLERAN			REVISION CIRCLED
4	1-20-80	S. HOLLERAN			REVISION CIRCLED

NO.	DATE	BY	CHK'D	APP'R.	REVISION
5	1-20-80	S. HOLLERAN			REVISION CIRCLED
6	1-20-80	S. HOLLERAN			REVISION CIRCLED

DESIGNED BY: R. HEARN CHECKED BY: S. HOLLERAN APPROVED BY: S. HOLLERAN DATE: 7/18/74	<b>Westinghouse Electric Corporation</b> NUCLEAR ENERGY SYSTEMS, PITTSBURGH, PA., U.S.A. TITLE: GEORGIA POWER CO. ALVIN W. VODTLE UNITS 1 & 2 FUNCTIONAL DIAGRAM ROD CONTROLS & ROD STOPS SHEET - 9 SUB # 248 67
---	---

THIS DWG. IS REFERENCED IN VENDOR MANUAL: N/A	MICROSTATION JLO/02 1X6AA02-00233.DGN
FAB/SECT.: N/A PAGE: N/A FIGURE: N/A	SOUTHERN NUCLEAR OPERATING COMPANY, INC. FOR VOLTAGE ELECTRIC GENERATING PLANT UNIT NO. 1
VERSION: 2.0 DATE: 9/18/14 REVISED BY: SNC PER ASN 1081846201J240, VER. 1.0	TITLE: FUNCTIONAL DIAGRAM ROD CONTROLS & ROD STOPS
BY: JLO CHK'D: CYN APP'R. 1: TSL APP'R. 2: X	VENDOR: WESTINGHOUSE ELEC P.O. #: DRAWING NO.: 1X6AA02-00233

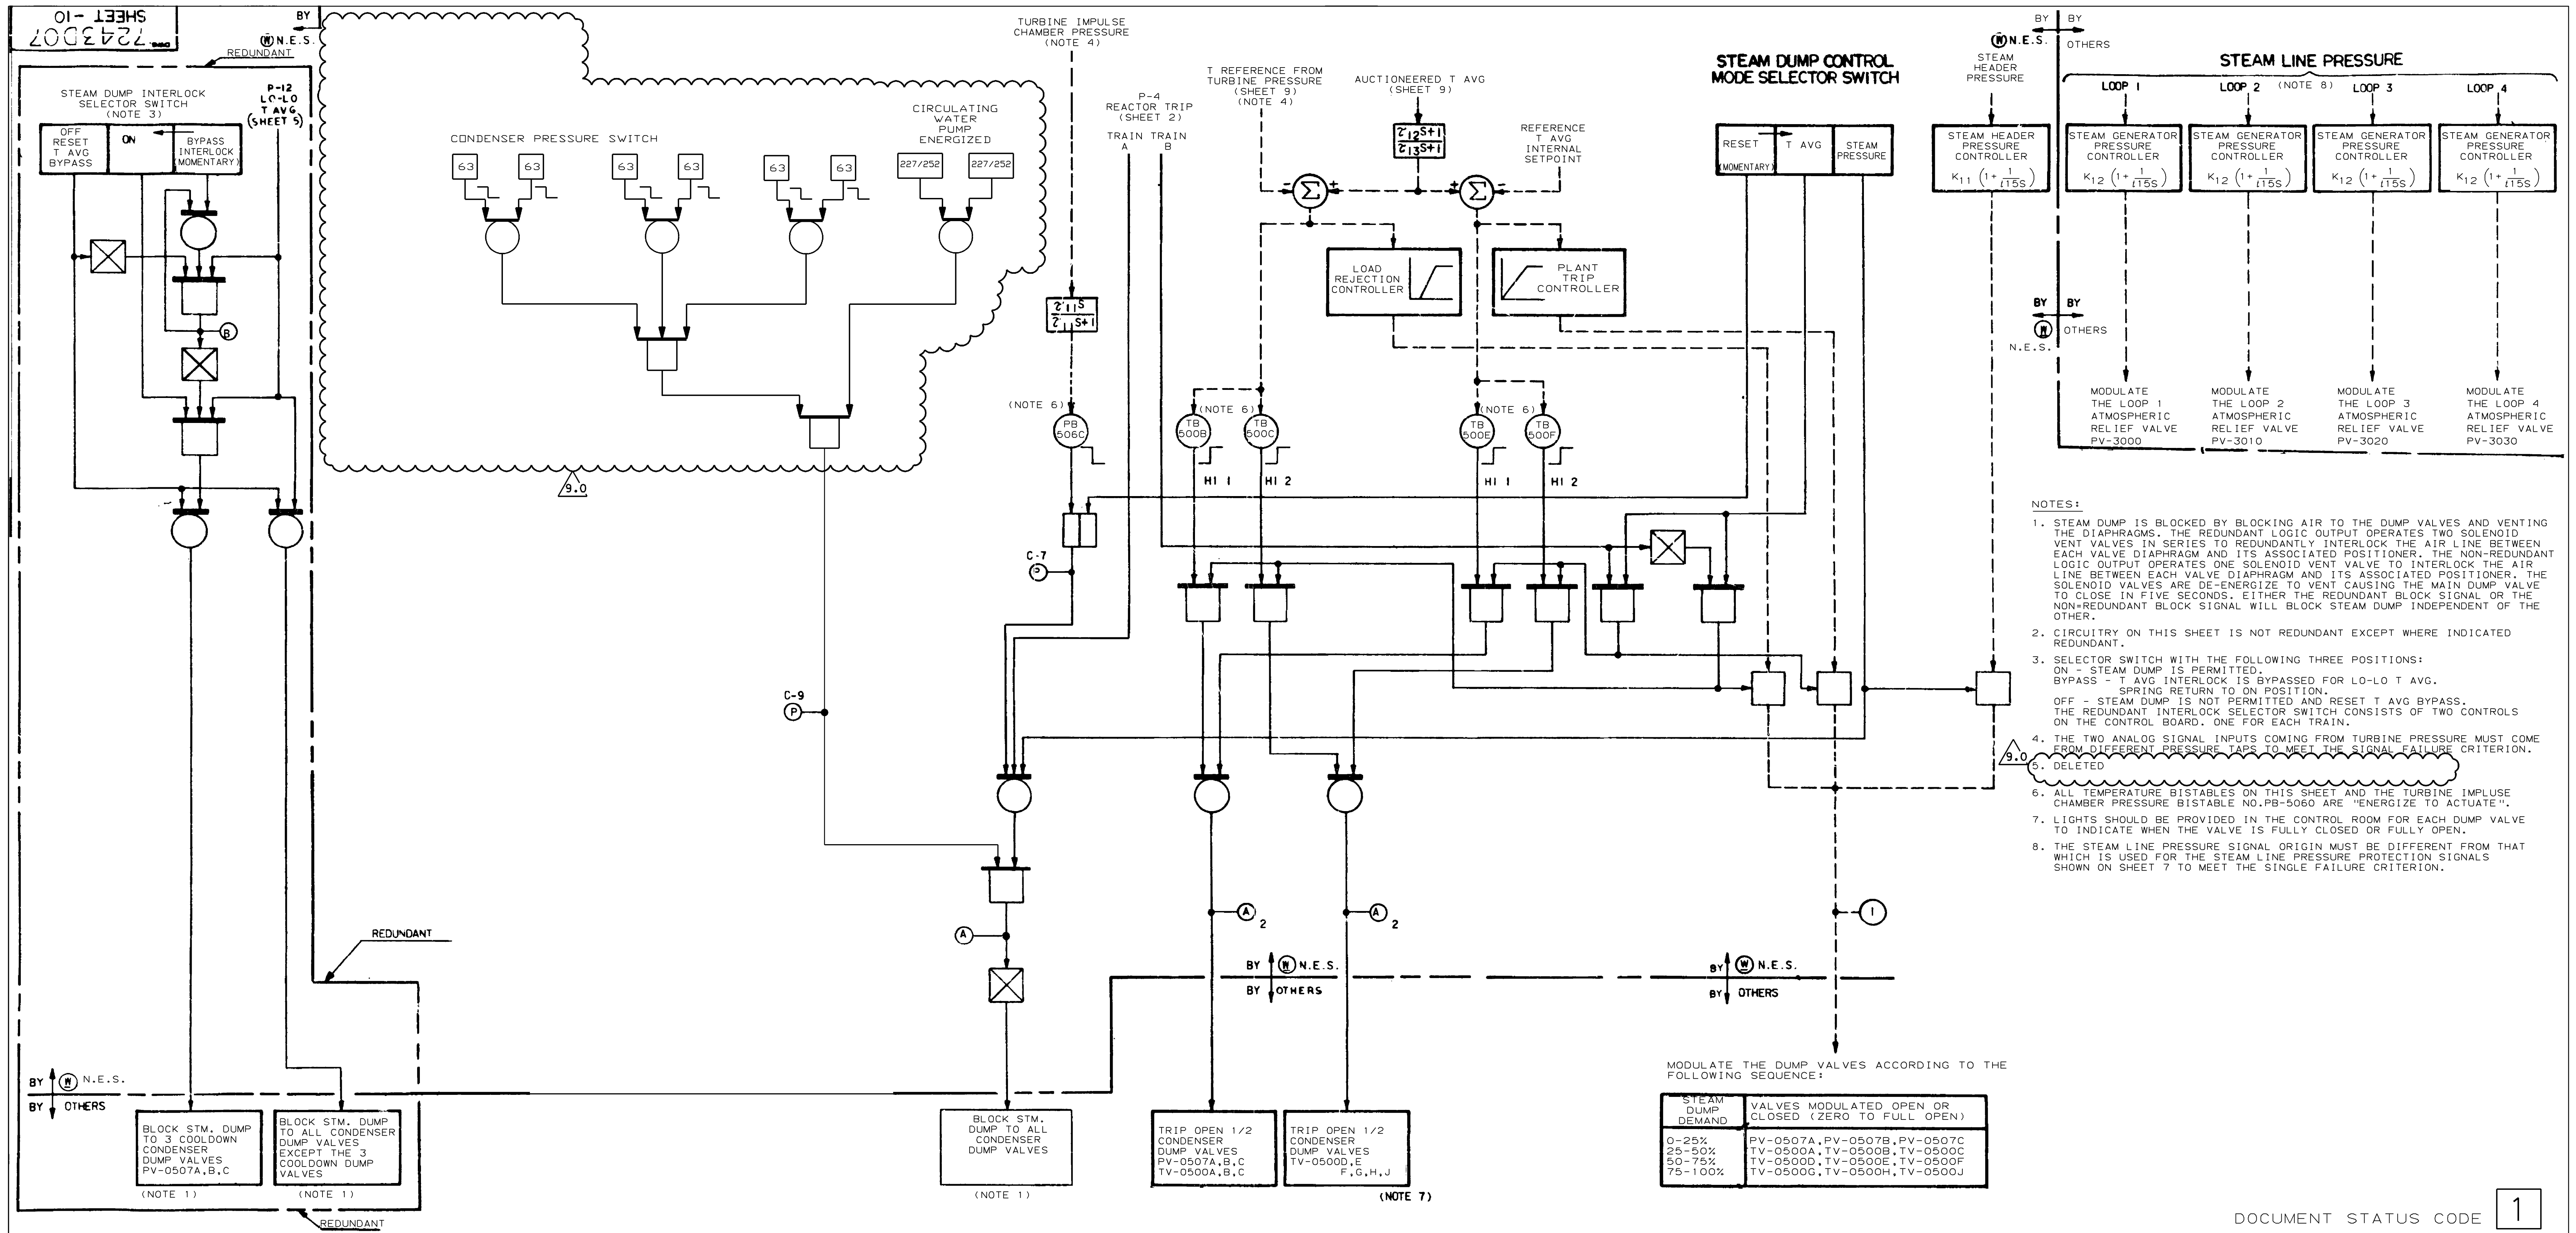

- NOTES:**
- STEAM DUMP IS BLOCKED BY BLOCKING AIR TO THE DUMP VALVES AND VENTING THE DIAPHRAGMS. THE REDUNDANT LOGIC OUTPUT OPERATES TWO SOLENOID VENT VALVES IN SERIES TO REDUNDANTLY INTERLOCK THE AIR LINE BETWEEN EACH VALVE DIAPHRAGM AND ITS ASSOCIATED POSITIONER. THE NON-REDUNDANT LOGIC OUTPUT OPERATES ONE SOLENOID VENT VALVE TO INTERLOCK THE AIR LINE BETWEEN EACH VALVE DIAPHRAGM AND ITS ASSOCIATED POSITIONER. THE SOLENOID VALVES ARE DE-ENERGIZED TO VENT CAUSING THE MAIN DUMP VALVE TO CLOSE IN FIVE SECONDS. EITHER THE REDUNDANT BLOCK SIGNAL OR THE NON-REDUNDANT BLOCK SIGNAL WILL BLOCK STEAM DUMP INDEPENDENT OF THE OTHER.
  - CIRCUITRY ON THIS SHEET IS NOT REDUNDANT EXCEPT WHERE INDICATED REDUNDANT.
  - SELECTOR SWITCH WITH THE FOLLOWING THREE POSITIONS:  
ON - STEAM DUMP IS PERMITTED.  
BYPASS - T AVG INTERLOCK IS BYPASSED FOR LO-LO T AVG. SPRING RETURN TO ON POSITION.  
OFF - STEAM DUMP IS NOT PERMITTED AND RESET T AVG BYPASS. THE REDUNDANT INTERLOCK SELECTOR SWITCH CONSISTS OF TWO CONTROLS ON THE CONTROL BOARD, ONE FOR EACH TRAIN.
  - THE TWO ANALOG SIGNAL INPUTS COMING FROM TURBINE PRESSURE MUST COME FROM DIFFERENT PRESSURE TAPS TO MEET THE SIGNAL FAILURE CRITERION.
  - DELETED
  - ALL TEMPERATURE BISTABLES ON THIS SHEET AND THE TURBINE IMPULSE CHAMBER PRESSURE BISTABLE NO. PB-5060 ARE "ENERGIZE TO ACTUATE".
  - LIGHTS SHOULD BE PROVIDED IN THE CONTROL ROOM FOR EACH DUMP VALVE TO INDICATE WHEN THE VALVE IS FULLY CLOSED OR FULLY OPEN.
  - THE STEAM LINE PRESSURE SIGNAL ORIGIN MUST BE DIFFERENT FROM THAT WHICH IS USED FOR THE STEAM LINE PRESSURE PROTECTION SIGNALS SHOWN ON SHEET 7 TO MEET THE SINGLE FAILURE CRITERION.

MODULATE THE DUMP VALVES ACCORDING TO THE FOLLOWING SEQUENCE:


STEAM DUMP DEMAND	VALVES MODULATED OPEN OR CLOSED (ZERO TO FULL OPEN)
0-25%	PV-0507A, PV-0507B, PV-0507C
25-50%	TV-0500A, TV-0500B, TV-0500C
50-75%	TV-0500D, TV-0500E, TV-0500F
75-100%	TV-0500G, TV-0500H, TV-0500J

DOCUMENT STATUS CODE 1

DATE	DESIGNER	DESIGNED BY	APP. BY	APP. DATE	SCALE	<b>Westinghouse Electric Corporation</b> NUCLEAR ENERGY SYSTEMS, PITTSBURGH, PA., U.S.A. TITLE: GEORGIA POWER CO. ALVIN R VOISLE UNITS 1 & 2 FUNCTIONAL DIAGRAMS STEAM DUMP CONTROL 7243D07 SHEET - 10 DIMENSIONS IN INCHES DO NOT SCALE
7/13	P HEARN	WJL	WJL	7-73	N/A	

THIS DWG. IS REFERENCED IN VENDOR MANUAL:		MICROSTATION DFW/01		1X6AA02-00234.DGN	
N/A		Southern Nuclear Operating Company, Inc.		FOR	
TAB/SECT. N/A		VOGTLE ELECTRIC GENERATING PLANT		UNIT NO. 1	
PAGE N/A		TITLE:		FUNCTIONAL DIAGRAMS	
FIGURE N/A		REVISION 9.0 DATE 10-14-05		STEAM DUMP CONTROL	
REVISOR ABN-80649, VER. 1.0		SEE MICROFILM FOR PREVIOUS VER. SIGNATURES:			
BY	CHK'D	APPR. 1	APPR. 2	VENDOR: WESTINGHOUSE ELEC	P.O. #
DFV	WBJ	ASK	x	DRAWING NO.	1X6AA02-00234



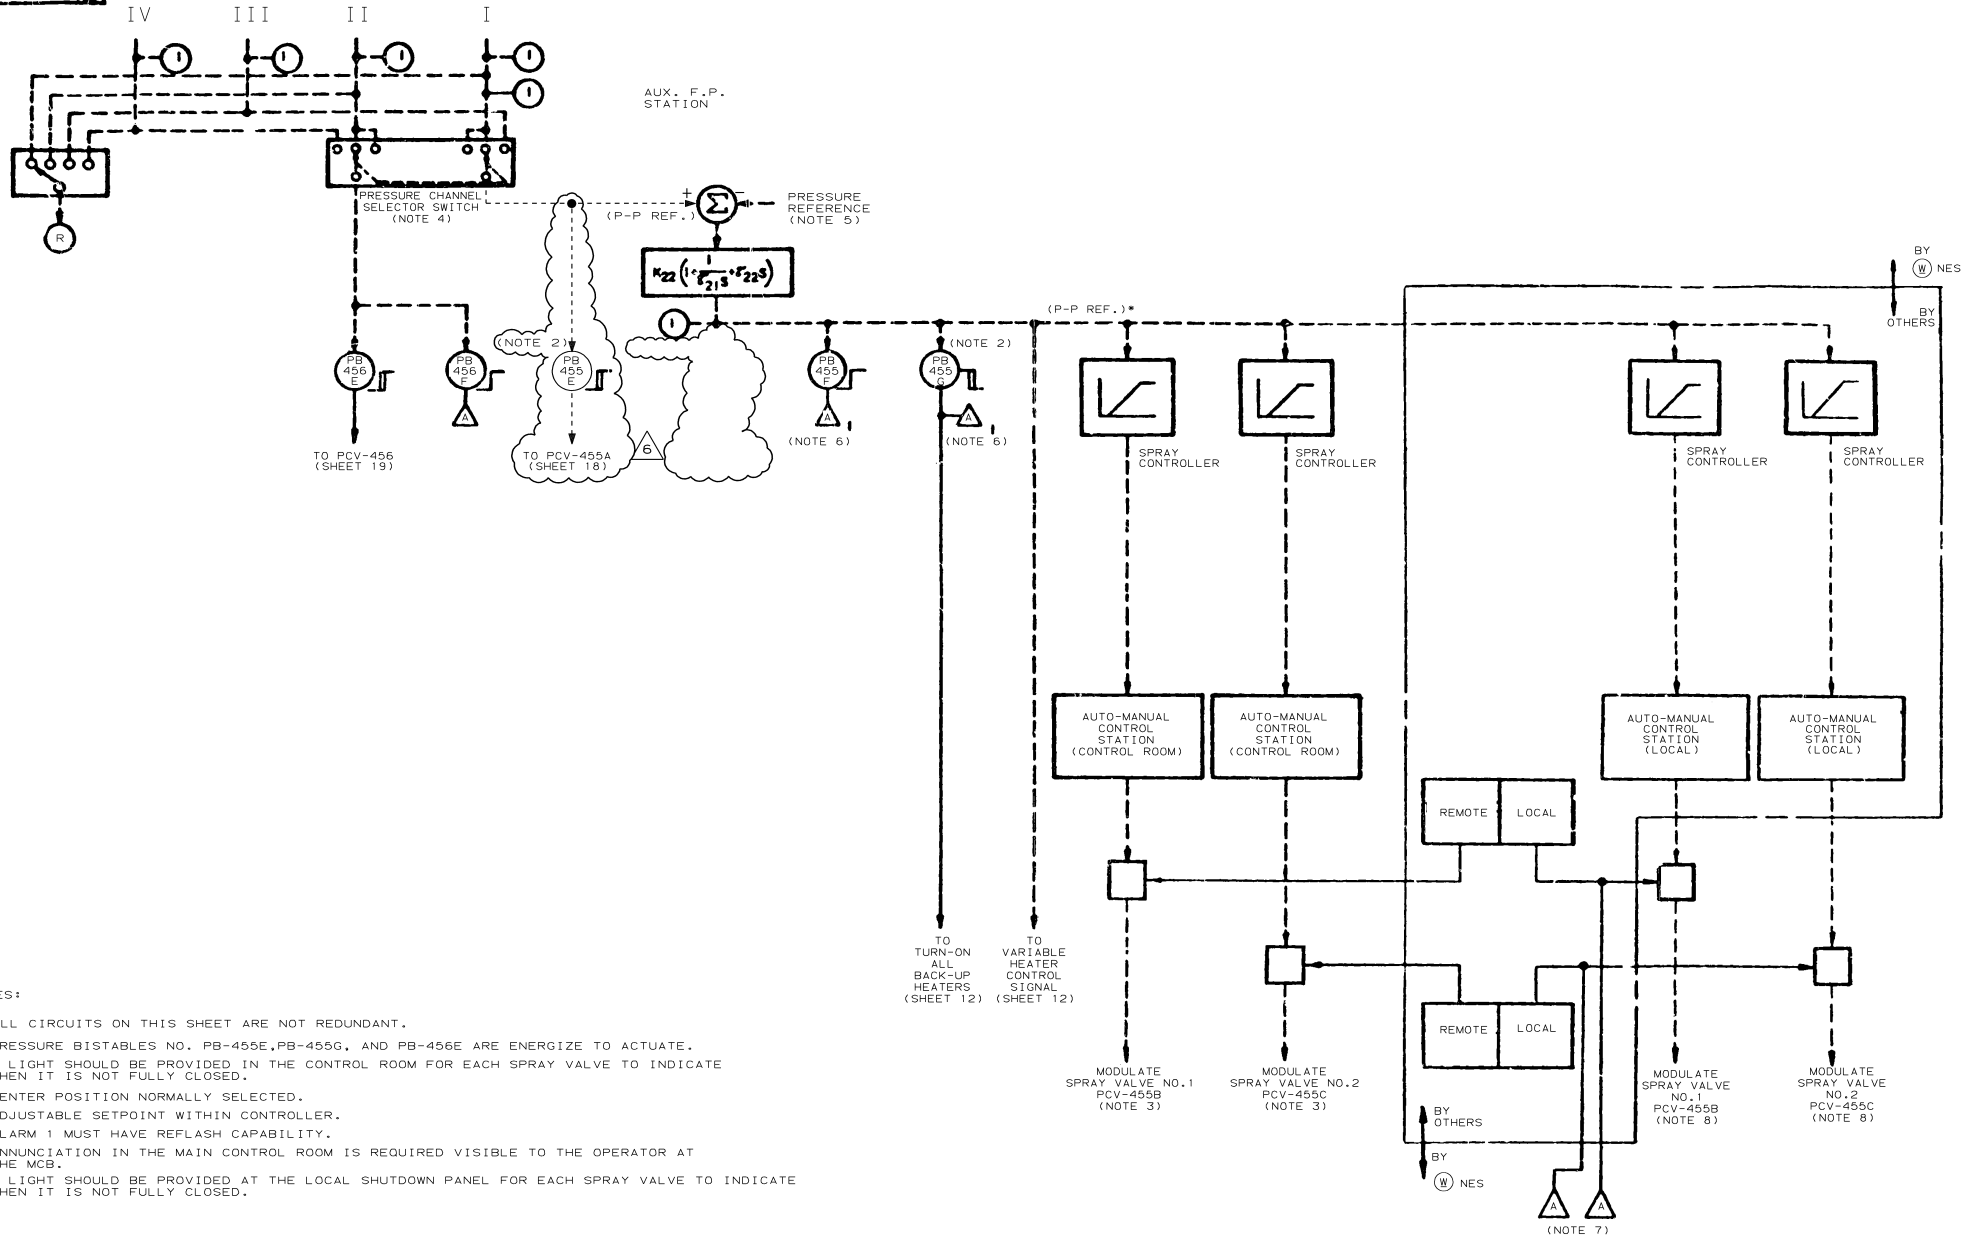

NOTES:

1. ALL CIRCUITS ON THIS SHEET ARE NOT REDUNDANT.
2. PRESSURE BISTABLES NO. PB-455E, PB-455G, AND PB-455F ARE ENERGIZE TO ACTUATE.
3. A LIGHT SHOULD BE PROVIDED IN THE CONTROL ROOM FOR EACH SPRAY VALVE TO INDICATE WHEN IT IS NOT FULLY CLOSED.
4. CENTER POSITION NORMALLY SELECTED.
5. ADJUSTABLE SETPOINT WITHIN CONTROLLER.
6. ALARM 1 MUST HAVE REFLASH CAPABILITY.
7. ANNUNCIATION IN THE MAIN CONTROL ROOM IS REQUIRED VISIBLE TO THE OPERATOR AT THE MCB.
8. A LIGHT SHOULD BE PROVIDED AT THE LOCAL SHUTDOWN PANEL FOR EACH SPRAY VALVE TO INDICATE WHEN IT IS NOT FULLY CLOSED.

CAE/GBE-300 ECN 31969	CAE/GBE-300 ECN 31969	CAE/GBE-300 ECN 31969	CAE/GBE-300 ECN 31969	CAE/GBE-300 ECN 31969
REVISIONS CIRCLED	REVISIONS CIRCLED	REVISIONS CIRCLED	REVISIONS CIRCLED	REVISIONS CIRCLED
OTHER REV CIRCLED	OTHER REV CIRCLED	OTHER REV CIRCLED	OTHER REV CIRCLED	OTHER REV CIRCLED

NO.	REVISIONS	DATE	DR	CHK	APPV
6	INC. PER DCP 98-VIN0061	11-06-00	CD	EOG	MWD

SCS REVISIONS


DOCUMENT STATUS CODE 1

1X6AA02-00235-9

DATE OF HEARD	7/23	Westinghouse Electric Corporation MILWAUKEE DIVISION, PITTSBURGH, PA., U.S.A.
DATE OF ISSUE	7/78	
DATE OF REV.	7/78	GEORGIA POWER CO. ALVIN W. VOGTLE UNITS 1 & 2 FUNCTIONAL DIAGRAMS PRESSURIZER PRESSURE CONTROL
DATE OF REV.	7/78	
DATE OF REV.	7/78	7243D07 SHEET-11
DATE OF REV.	7/78	
DATE OF REV.	7/78	SUB 7243D07-6

7243007  
SHEET - 12

G  
F  
E  
D  
C  
B  
A

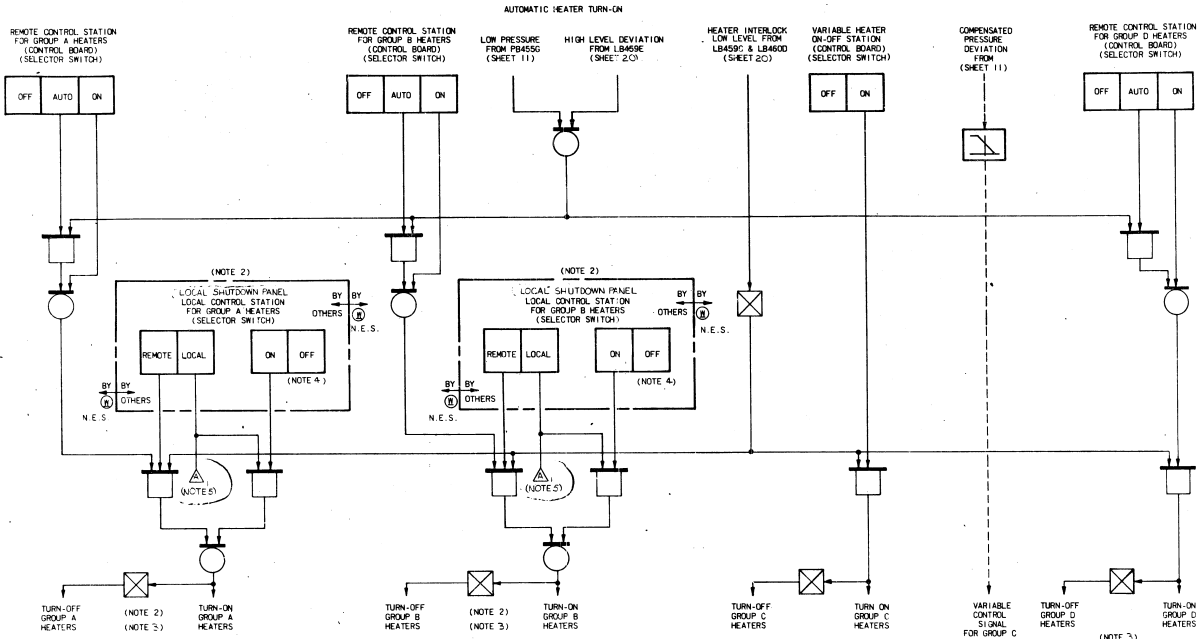

- NOTES:
1. ALL CIRCUITS ON THIS SHEET ARE NOT REDUNDANT.
  2. GROUP A AND GROUP B HEATERS MUST BE ON SEPARATE VITAL POWER SUPPLIES WITH THE LOCAL CONTROL SEPARATED SO THAT ANY SINGLE FAILURE DOES NOT DEFEAT BOTH.
  3. BACK UP HEATER STATUS INDICATION IN CONTROL ROOM.
  4. PRECAUTIONS SHOULD BE TAKEN TO AVOID MANUAL HEATER OPERATION, WHICH WOULD CAUSE HEATER DAMAGE, IF THE WATER LEVEL UNCOVERS THE HEATERS.
  5. AN INDICATOR IN THE MAIN CONTROL ROOM IS REQUIRED TO BE VISIBLE TO THE OPERATOR AT THE MAIN CONTROL BOARD.

GEORGIA POWER COMPANY  
PLANT: ALVIN W. MOORE NUCLEAR PLANT  
UNIT: 1 & 2  
STATUS: APPROVED  
CERTIFICATION LTR. NO. GP-5709  
ACTIVITY: J. L. VOTA  
RSCR. LTR. NO. GP/EA-38110

MODIFIED  
QUALITY  
ACCEPTABLE

DISTRIBUTION TO: FOR REVIEWING	
MECHANICAL	
BALANCE OF PLANT	
BOILERNESS	
PLANT UTILITIES	
PLANT DESIGN	
CONTROL SYSTEMS	
ELECTRICAL	
INSULATION	
CONDUIT	
WELD.	
PAINTING & COATINGS	
CIVIL/STRUCTURAL	
PIPELINES	
STRESS	
MECHANICAL	
STARTUP	
CONSTRUCTION	
AS-BUILT BY ENDING	
CLIENT	
IDENTIFYING TITLE OF THIS DOCUMENT	

Resub for micro film quality

Revised Log No. 1

NO.	DATE	BY	REVISION
1	11/11/68	J. L. VOTA	ISSUED FOR CONSTRUCTION
2	11/11/68	J. L. VOTA	ISSUED FOR CONSTRUCTION
3	11/11/68	J. L. VOTA	ISSUED FOR CONSTRUCTION
4	11/11/68	J. L. VOTA	ISSUED FOR CONSTRUCTION
5	11/11/68	J. L. VOTA	ISSUED FOR CONSTRUCTION

DATE: 11/11/68	SCALE: 7243007
BY: J. L. VOTA	SHEET - 12
CHKD: J. L. VOTA	DO NOT SCALE
APP: J. L. VOTA	REV: 22
DATE: 11/11/68	


DATE: 11/11/68	SCALE: 7243007
BY: J. L. VOTA	SHEET - 12
CHKD: J. L. VOTA	DO NOT SCALE
APP: J. L. VOTA	REV: 22

I CERTIFY THAT THE WORK CONTAINED ON THIS DRAWING WAS MADE IN THE NORMAL AND REGULAR COURSE OF BUSINESS, ON THE DATE STATED BELOW AND THAT IT IS AN ACCURATE REPRESENTATION OF THE WORK SUBMITTED TO MICROFILMING.

DATE: 11/11/68  
BY: J. L. VOTA  
TITLE: SECTION SUPERVISOR

18  
17  
16  
74X

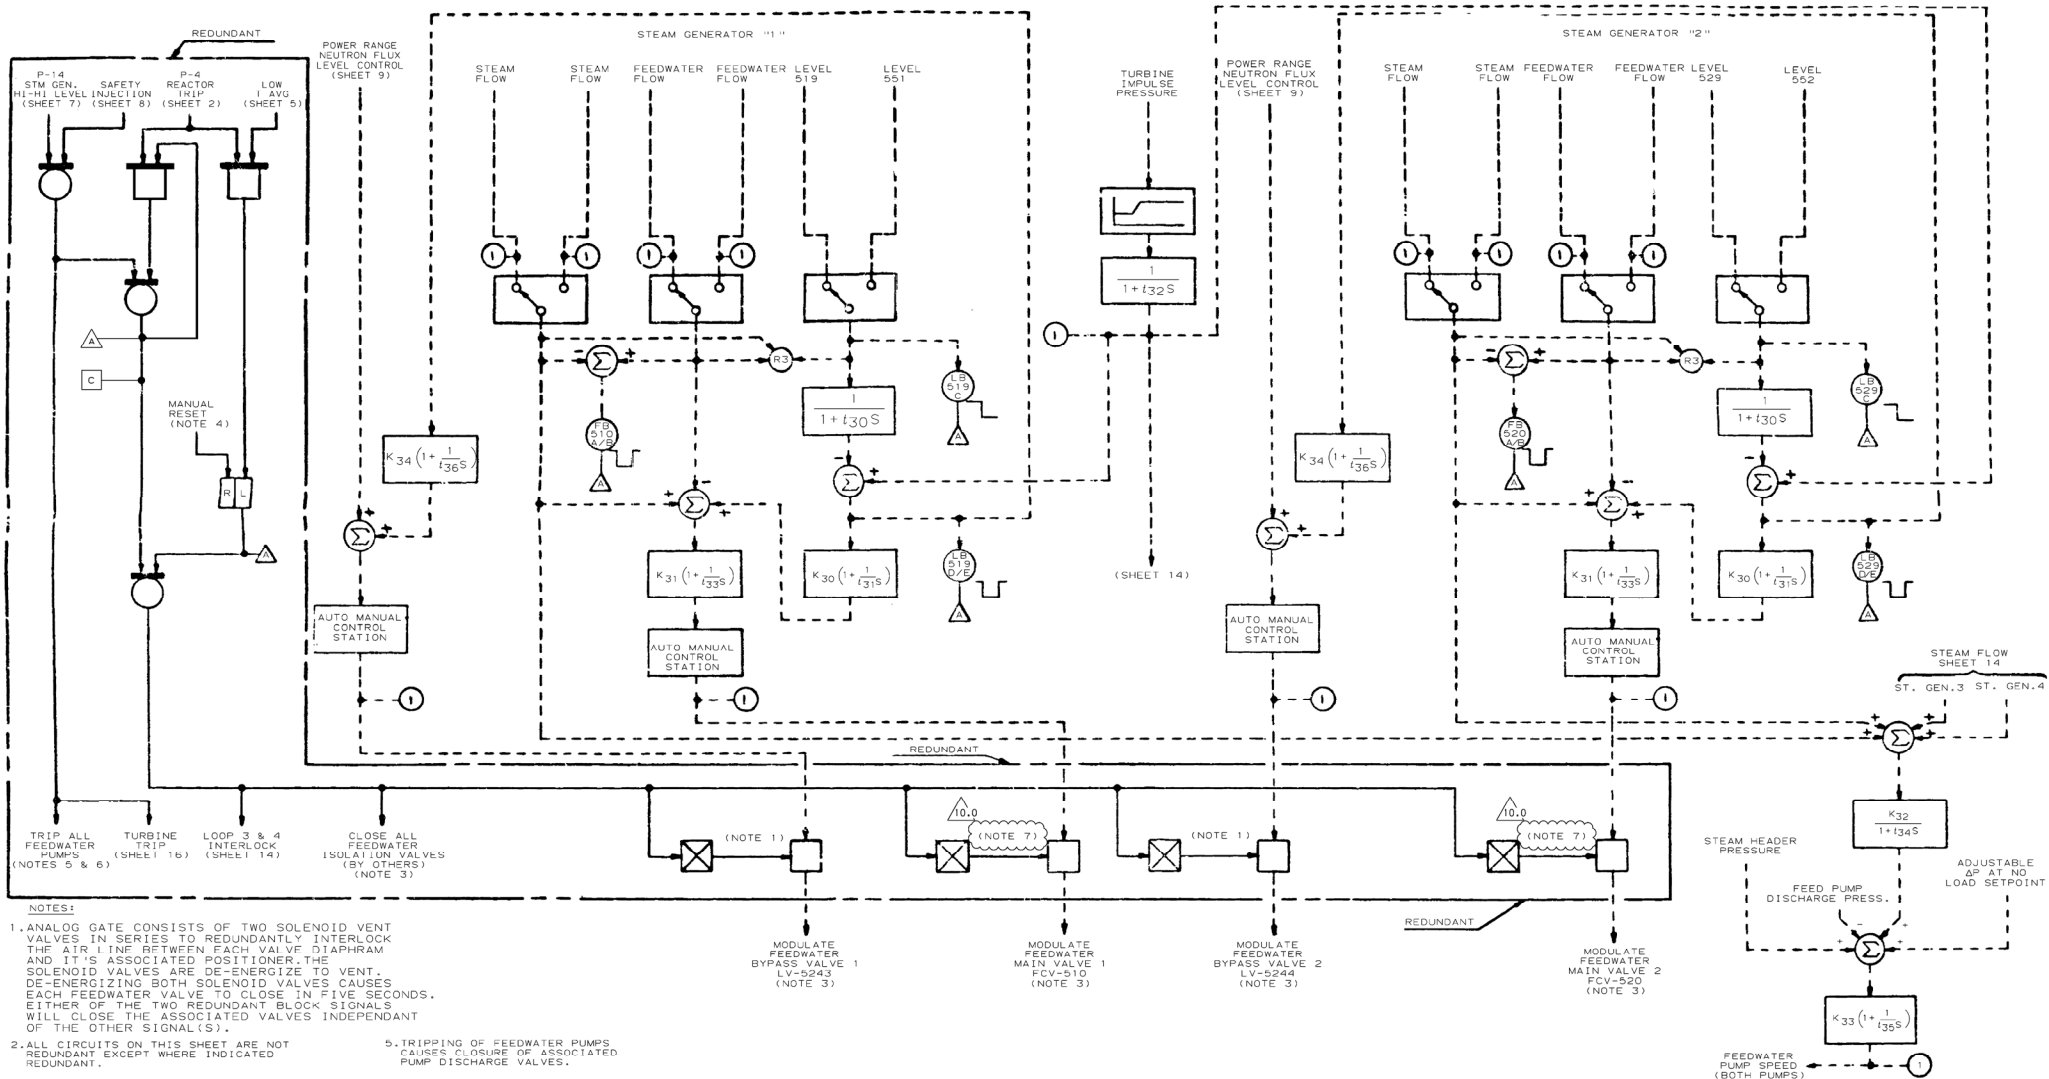

NOTES:


1. ANALOG GATE CONSISTS OF TWO SOLENOID VENT VALVES IN SERIES TO REDUNDANTLY INTERLOCK THE AIR LINE BETWEEN EACH VALVE DIAPHRAM AND ITS ASSOCIATED POSITIONER. THE SOLENOID VALVES ARE DE-ENERGIZE TO VENT. DE-ENERGIZING BOTH SOLENOID VALVES CAUSES EACH FEEDWATER VALVE TO CLOSE IN FIVE SECONDS. EITHER OF THE TWO REDUNDANT BLOCK SIGNALS WILL CLOSE THE ASSOCIATED VALVES INDEPENDENT OF THE OTHER SIGNAL(S).
2. ALL CIRCUITS ON THIS SHEET ARE NOT REDUNDANT EXCEPT WHERE INDICATED REDUNDANT.
3. OPEN/SHUT INDICATION FOR EACH FEEDWATER VALVE IN CONTROL ROOM.
4. THE REDUNDANT MANUAL RESET CONSISTS OF TWO MOMENTARY CONTROLS ON THE CONTROL BOARD, ONE FOR EACH TRAIN.

5. TRIPPING OF FEEDWATER PUMPS CAUSES CLOSURE OF ASSOCIATED PUMP DISCHARGE VALVES.

6. THE FEEDWATER PUMPS AND PUMP DISCHARGE VALVES ARE SUPPLIED BY OTHERS.

7. ANALOG GATE CONSISTS OF TWO SOLENOID VALVES. THE SOLENOID VALVES ARE DE-ENERGIZE TO VENT. DE-ENERGIZING BOTH SOLENOID VALVES CAUSES EACH FEEDWATER VALVE TO CLOSE IN FIVE SECONDS.

THIS DWG. IS REFERENCED IN VENDOR MANUAL:		MICROSTATION TSL/01		1X6AA02-00237.DGN	
FAB/SECT. N/A		Southern Nuclear Operating Company, Inc.		Zak	
PAGE N/A		VOGTLE ELECTRIC GENERATING PLANT UNIT NO. 1			
FIGURE N/A		FUNCTIONAL DIAGRAM FEEDWATER CONTROL & ISOLATION			
VENSIUN10.0	DATE 01/11/08	TITLE:			
REVISED BY SNC PER ABN-V00442, VER.3.0					
SEE MICROFILM FOR PREVIOUS REV. SIGNATURES:					
BY	CHK'D	APPR.1	APPR.2	VENDOR: WESTINGHOUSE	P.O. # PAV-00370
TSL	RBH	JMR		DRAWING NO. 1X6AA02 00237	
				2	1
SIZE D					

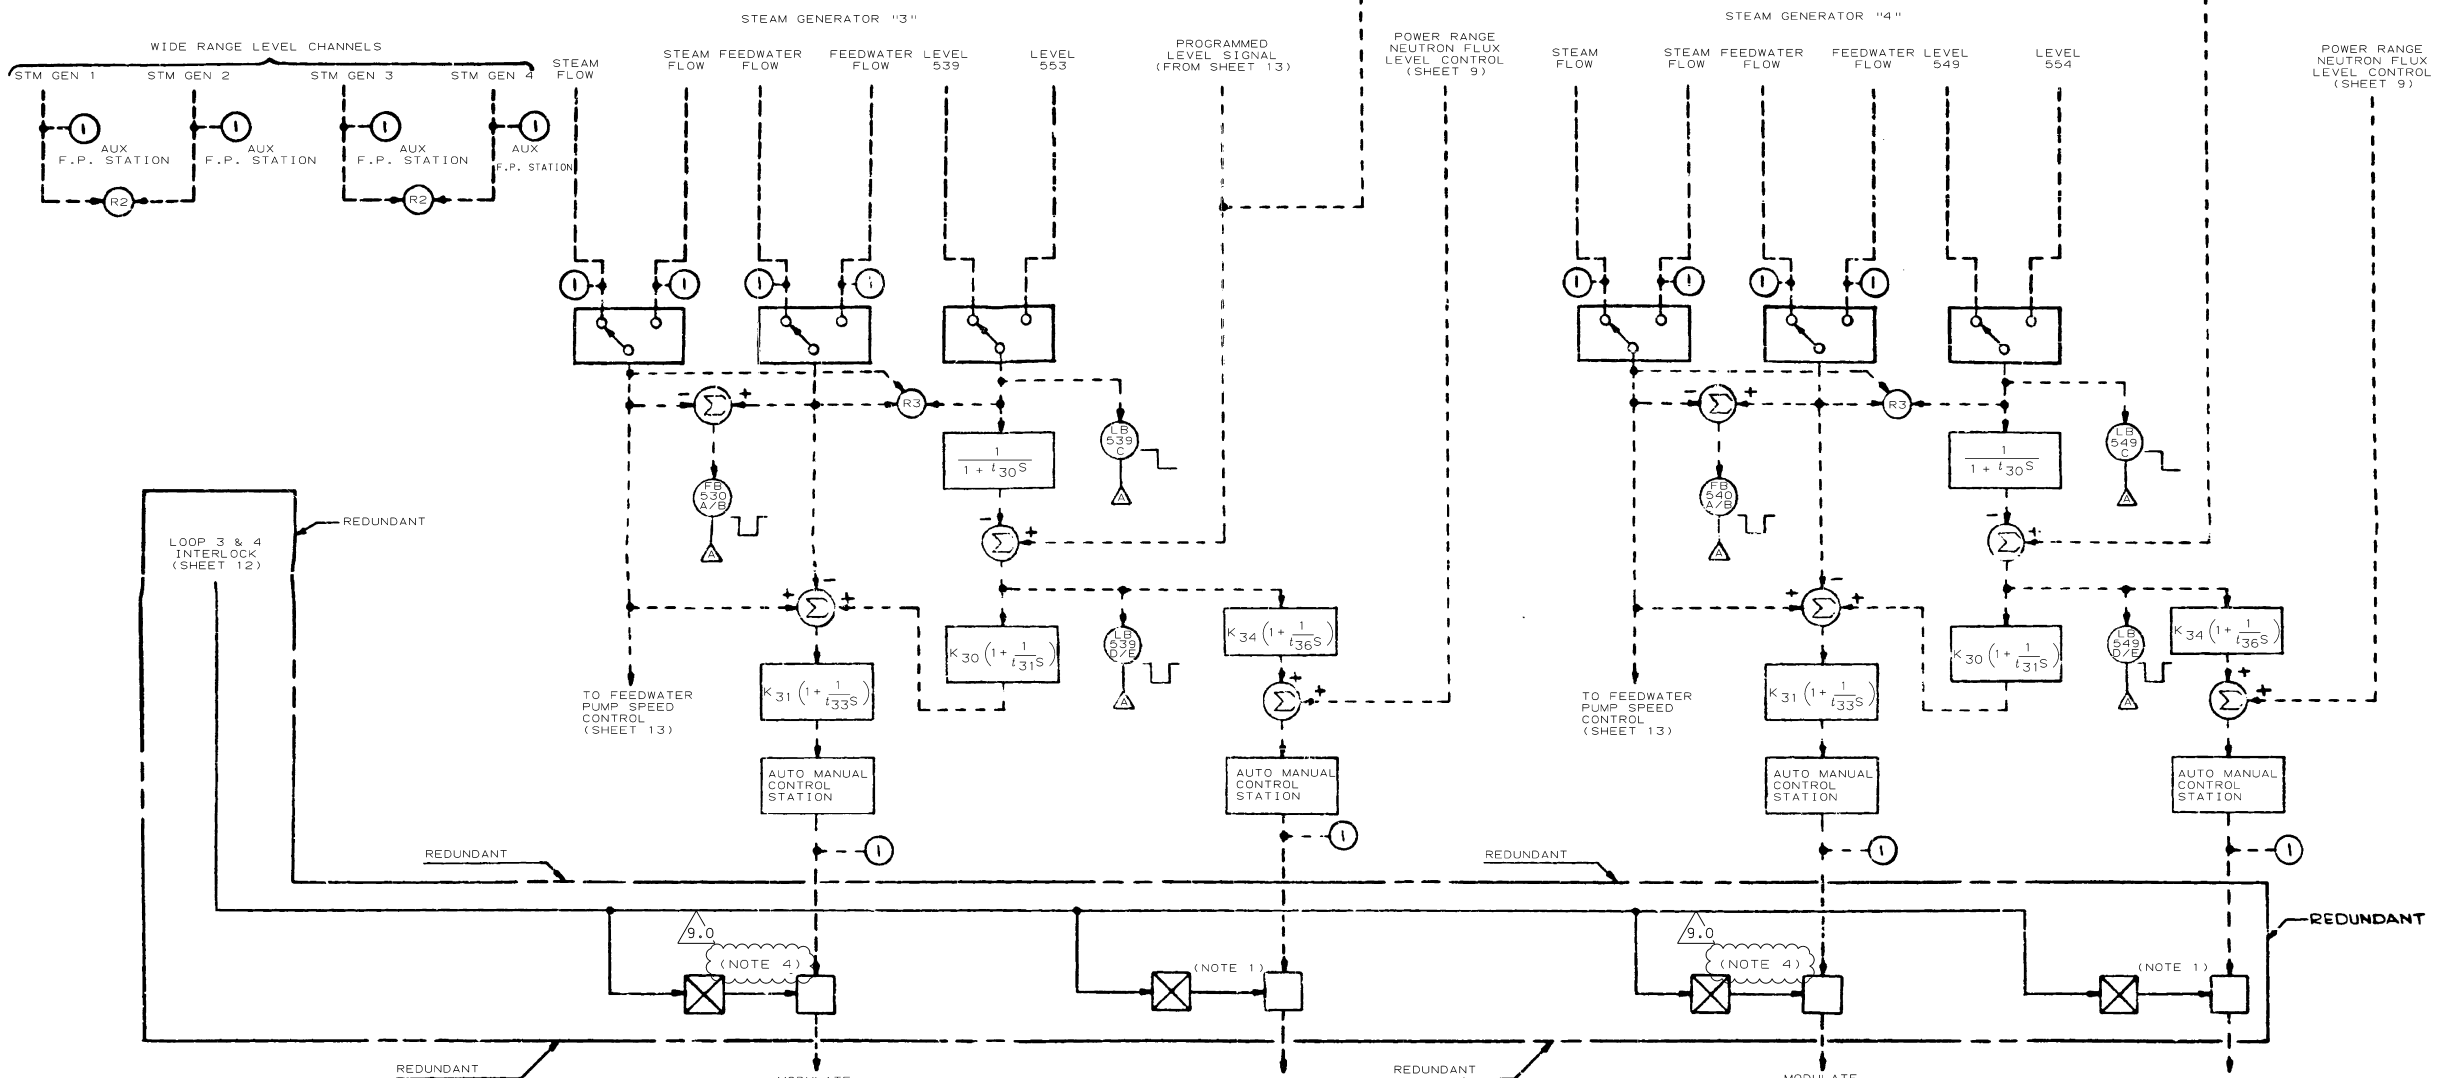

1. ANALOG GATE CONSISTS OF TWO SOLENOID VENT VALVES IN SERIES TO REDUNDANTLY INTERLOCK THE AIR LINE BETWEEN EACH VALVE DIAPHRAM AND IT'S ASSOCIATED POSITIONER. THE SOLENOID VALVES ARE DE-ENERGIZE TO VENT. DE-ENERGIZING BOTH SOLENOID VALVES CAUSES EACH FEEDWATER VALVE TO CLOSE IN FIVE SECONDS. EITHER OF THE TWO REDUNDANT BLOCK SIGNALS WILL CLOSE THE ASSOCIATED VALVES INDEPENDANT OF THE OTHER SIGNAL(S).

2. ALL CIRCUITS ON THIS SHEET ARE NOT REDUNDANT, EXCEPT WHERE INDICATED "REDUNDANT"

3. OPEN/SHUT INDICATION FOR EACH FEEDWATER VALVE IN CONTROL ROOM

4. ANALOG GATE CONSISTS OF TWO SOLENOID VALVES. THE SOLENOID VALVES ARE DE-ENERGIZE TO VENT. DE-ENERGIZING BOTH SOLENOID VALVES CAUSES EACH FEEDWATER VALVE TO CLOSE IN FIVE SECONDS.

FOR INFORMATION ONLY

THIS DWG. IS REFERENCED IN VENDOR MANUAL: N/A				MICROSTATION TSL/01		1X6AA02-00238.DGN	
TAB/SECT.: N/A				Southern Nuclear Operating Company, Inc.			
PAGE: N/A				FOR			
FIGURE: N/A				VOGTLE ELECTRIC GENERATING PLANT			
				UNIT NO. 1			
VERSION: 9.0   DATE: 01/11/08				TITLE: FUNCTIONAL DIAGRAM FEEDWATER CONTROL & ISOLATION			
REVISED BY SNC PER ABN-V00442, VER.3.0							
SEE MICROFILM FOR PREVIOUS REV. SIGNATURES.							
BY: TSL	CHK'D: RBH	APPR.1: JMR	APPR.2: [Signature]	VENDOR: WESTINGHOUSE		P.O.#: PAV-00370	
				DRAWING NO. 1X6AA02-00238			